





STATE OF NEW HAMPSHIRE
DEPARTMENT OF TRANSPORTATION
CONSTRUCTION PLANS
FEDERAL AID PROJECT

X-A003(751)
N.H. PROJECT NO. 28435
MAIN STREET

DESIGN DATA	
AVERAGE DAILY TRAFFIC 20 12	15000 VPD
AVERAGE DAILY TRAFFIC 20 32	22200 VPD
PERCENT OF TRUCKS	4%
DESIGN SPEED	30 MPH
LENGTH OF PROJECT	0.32 MILES

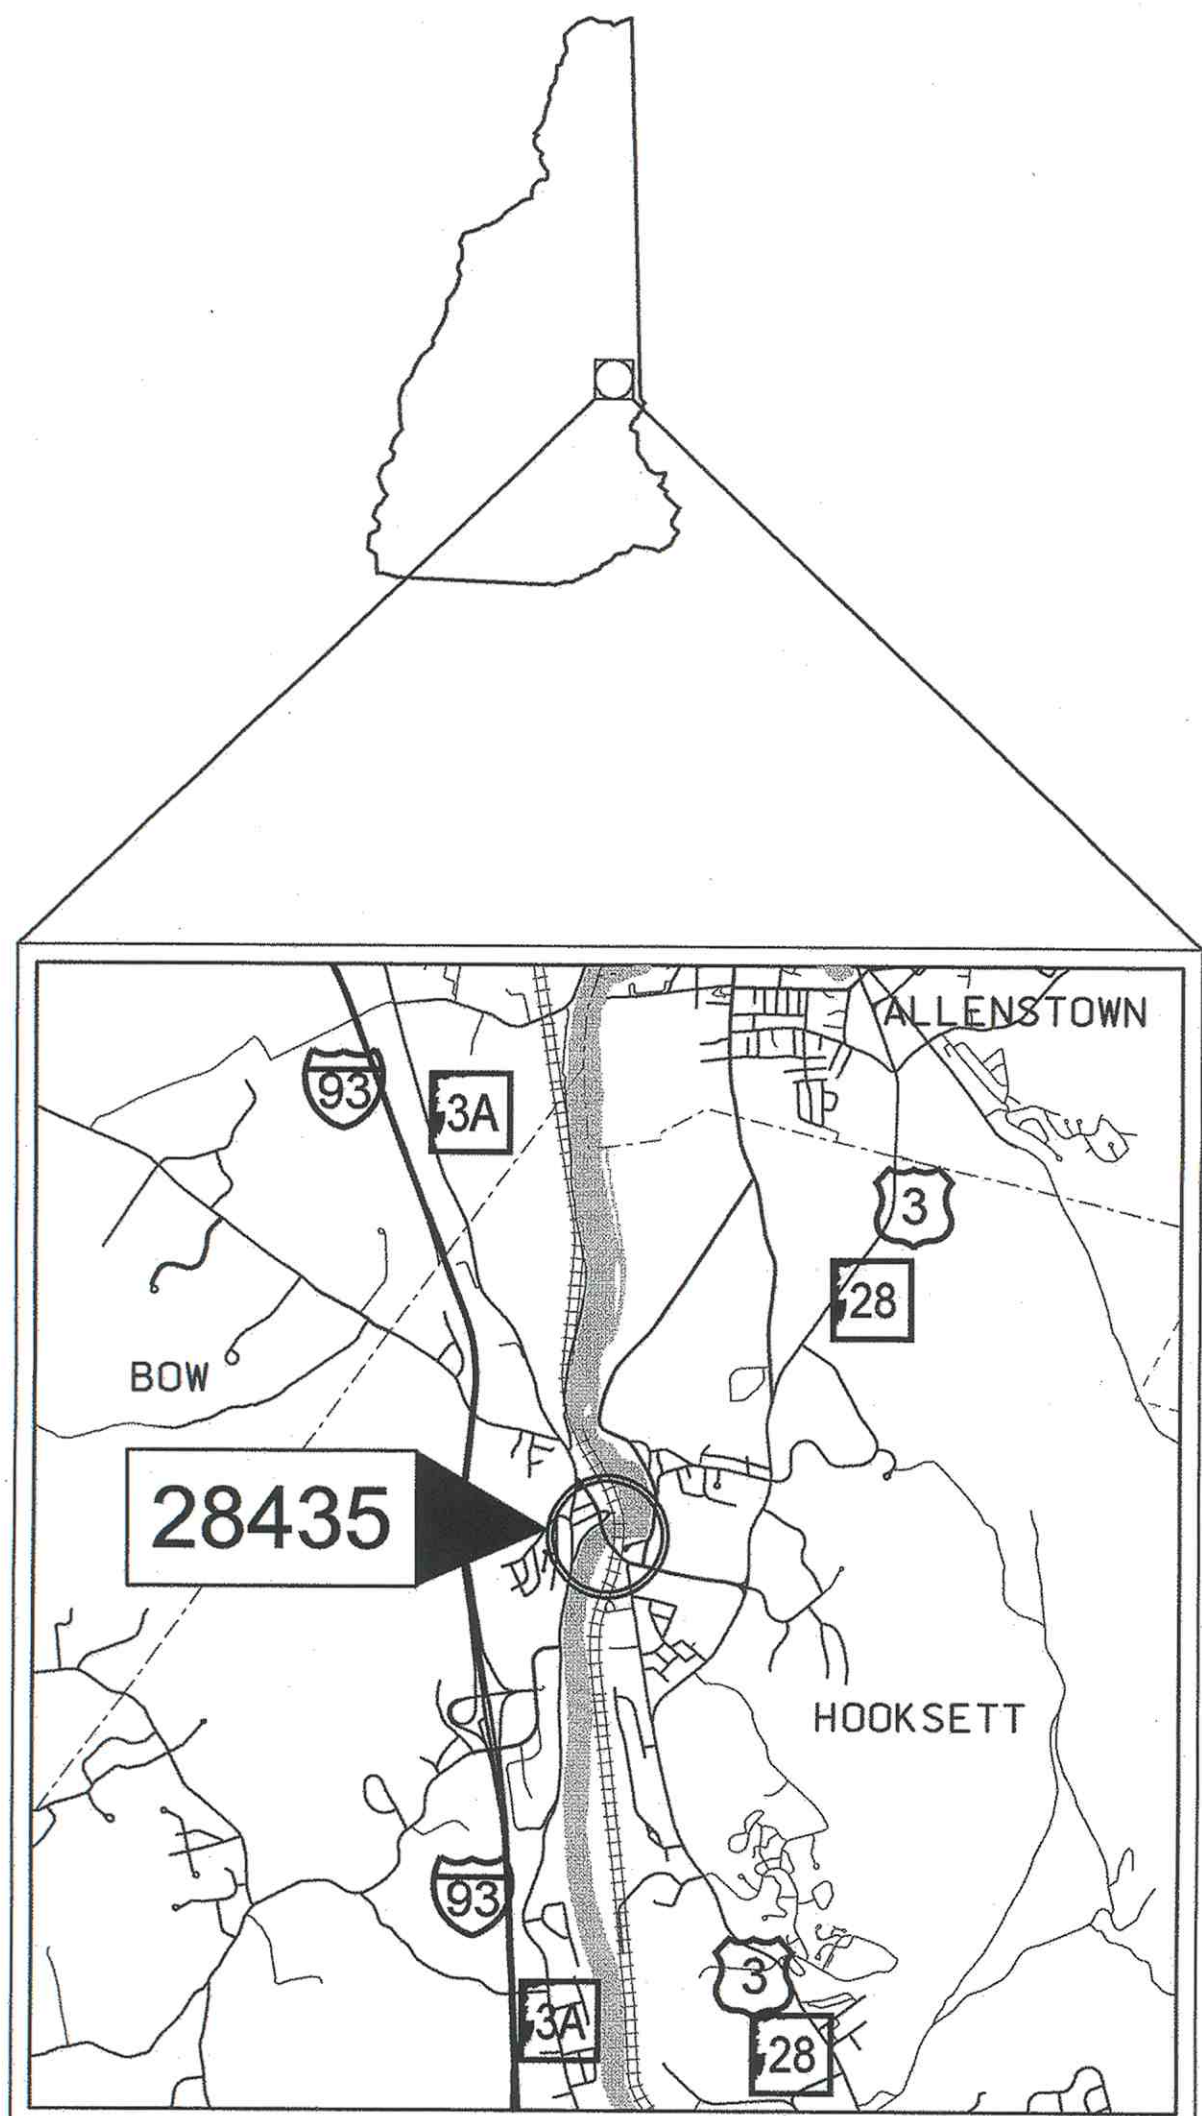

LOCATION MAP

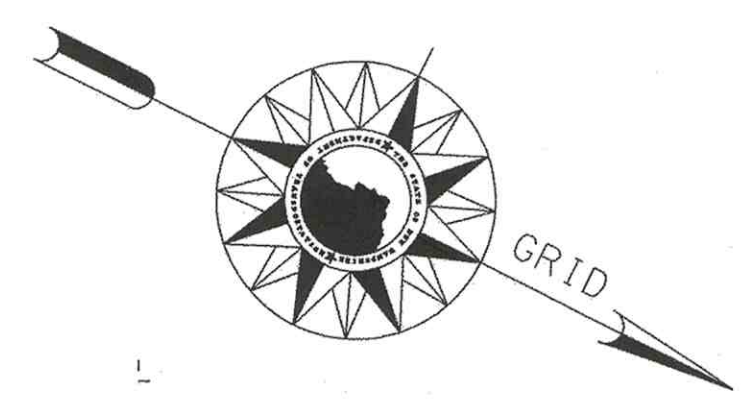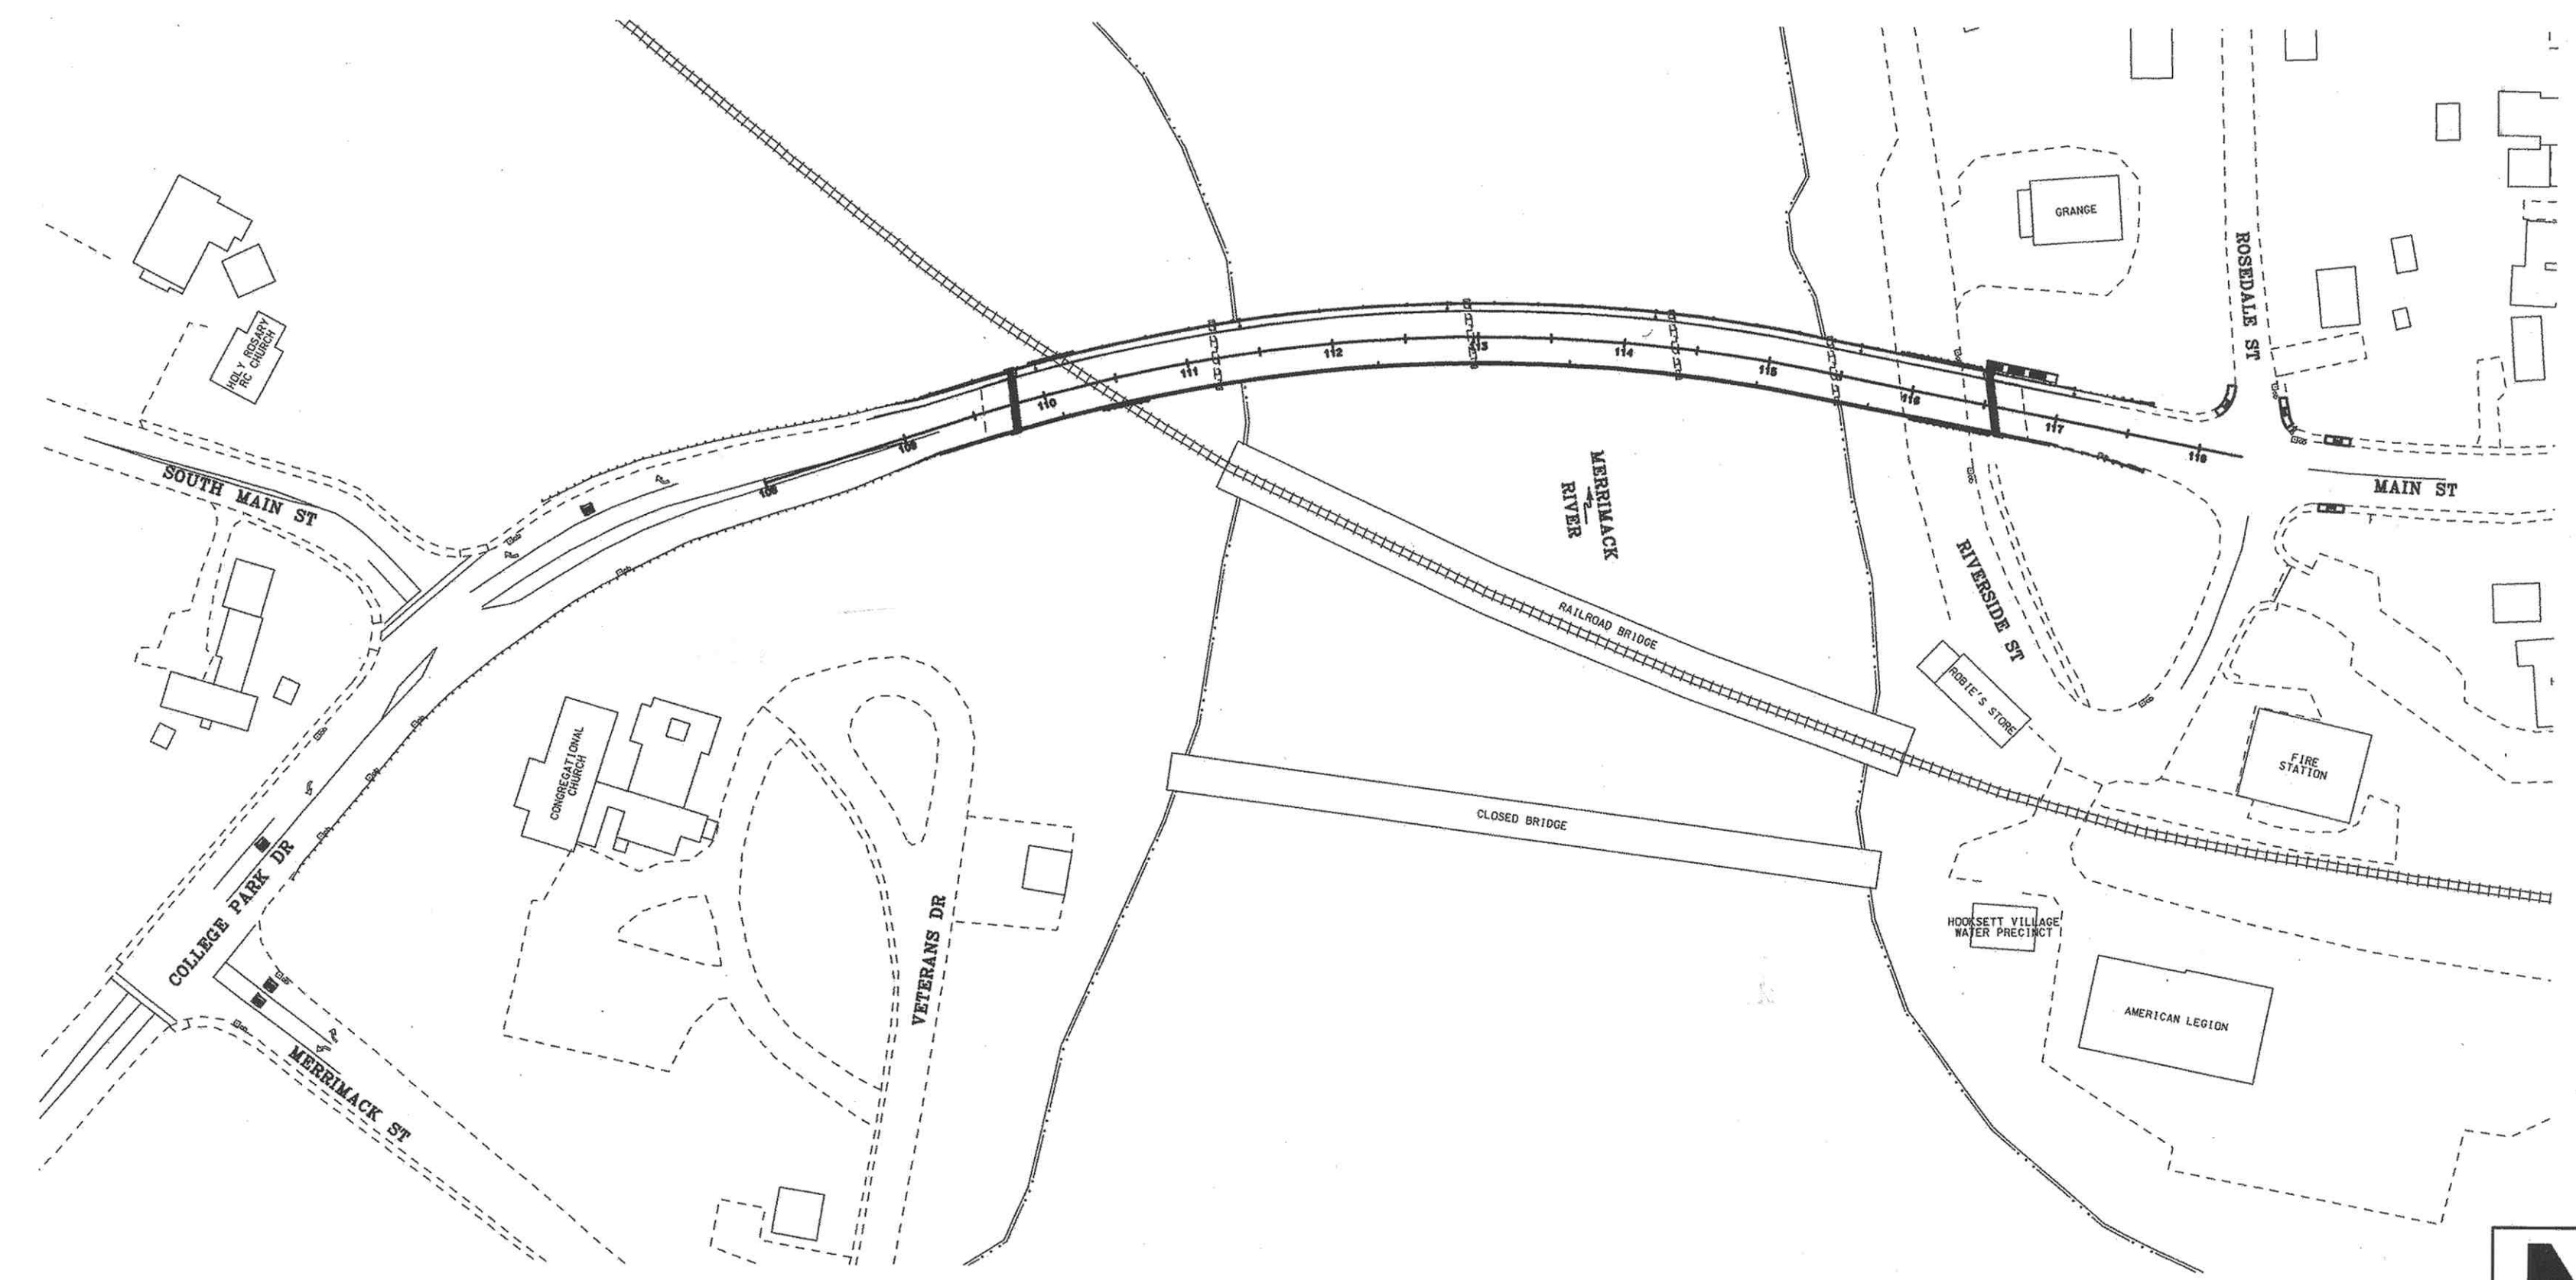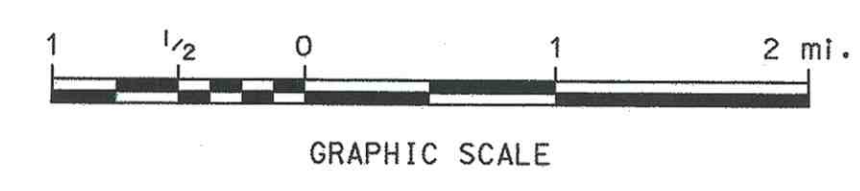

AS-BUILT PLANS

DATE 10/04/2016

As-Built Plans

TOWN OF HOOKSETT
COUNTY OF MERRIMACK

SCALE: 1" = 100'-0"

DRAWN BY SMG
CHECKED BY JAT
DATE 6/14
DATE 6/14



NHDOT THE STATE OF NEW HAMPSHIRE DEPARTMENT OF TRANSPORTATION			
RECOMMENDED FOR APPROVAL <i>William Carr</i> DIRECTOR OF PROJECT DEVELOPMENT	9/29/14 DATE		
APPROVED: <i>Daryl Miller</i> ASSISTANT COMMISSIONER AND CHIEF ENGINEER	9/25/14 DATE		
U. S. DEPARTMENT OF TRANSPORTATION FEDERAL HIGHWAY ADMINISTRATION			
APPROVED: _____ DIVISION ADMINISTRATOR	_____ DATE		
FEDERAL PROJECT NO. X-A003(751)	STATE PROJECT NO. 28435	SHEET NO. 1	TOTAL SHEETS 42

Construction
Record Plans
Hooksett
28435
SC 000 7/24/2014 8:32:11 AM 11/16/00

GENERAL NOTES



- ① FOR STANDARD PLANS, SEE "STANDARD PLANS FOR ROAD CONSTRUCTION" DATED 2010 (A BOUND BOOK).
- ② HIGH TENSION OVERHEAD TRANSMISSION LINES ARE LOCATED THROUGHOUT THE PROJECT WITH CROSSINGS AT VARIOUS LOCATIONS AND RUNNING ALONG THE ROAD THROUGHOUT THE PROJECT EVEN ON REGULAR POLES. THE CONTRACTOR IS ADVISED THAT EXTREME CAUTION WILL BE REQUIRED IN THE OPERATION OF EQUIPMENT, ESPECIALLY CRANES AND PILE DRIVING EQUIPMENT.
- ③ MODIFY SUPERELEVATION ON EXISTING CURVES BY THE USE OF A LEVELING COURSE TO THE RATES INDICATED ON THE PLANS OR AS ORDERED.
- ④ EXISTING DELINEATORS AND WITNESS MARKERS THAT ARE REMOVED AND DETERMINED BY THE ENGINEER TO BE IN ACCEPTABLE CONDITION SHALL BE RESET (SUBSIDIARY). ADDITIONAL DELINEATORS AND WITNESS MARKERS ORDERED WILL BE PAID UNDER THE APPROPRIATE ITEMS OF THE CONTRACT.
- ⑤ NO EXISTING MONUMENTS, BOUNDS, OR BENCHMARKS SHALL BE DISTURBED WITHOUT FIRST MAKING PROVISIONS FOR RELOCATION.
- ⑥ PERFORM ALL WORK WITHIN THE EXISTING RIGHT-OF-WAY, UNLESS OTHERWISE SHOWN ON THE PLANS OR AS ORDERED BY THE ENGINEER.
- ⑦ REMOVE UNPROTECTED PROJECT MARKERS (SUBSIDIARY).
- ⑧ SURVEY DATA FOR THIS PROJECT WAS COLLECTED BY SDR AND THE FIELD NOTES CAN BE FOUND IN THE FIELD BOOK(S). COORDINATES ARE NEW HAMPSHIRE STATE PLANE COORDINATES OF NAD83, 1986 ADJUSTMENT AND THE BEARINGS ARE GRID. ELEVATIONS ARE REFERENCED TO NGVD 1929.
- ⑨ QUANTITIES FOR EMBANKMENT AND EXCAVATION FOR SLOPE ROUNDINGS AS SHOWN ON THE TYPICALS HAVE NOT BEEN CALCULATED AND ARE NOT INCLUDED IN THE QUANTITY SUMMARIES, AND ARE CONSIDERED SUBSIDIARY TO THE APPROPRIATE 203 ITEMS.

THE FOLLOWING GENERAL NOTES WILL BE USED ON THIS PROJECT:											
①	○	○	④	⑤	⑥	○	○	○	○	○	○
○	○	○	○	○	○	○	○	○	○	○	○


SHEET NO.	DESCRIPTION
1	TITLE PAGE
2	INDEX OF SHEETS AND GENERAL NOTES
3.4	STANDARD SYMBOLS
BRIDGE PLANS	
5-22	BRIDGE NUMBER 080/148
SPECIAL USE PLANS	
23	TERMINAL UNIT DELINEATION
24	SIDEWALK CURB RAMPS WITH DETECTABLE WARNINGS
ROADWAY PLANS	
25	PAVEMENT MARKING & PERMANENT SIGNING
26-27	TRAFFIC CONTROL
28	CONSTRUCTION SIGNAL PLAN
29	CONSTRUCTION/CONTINGENCY SIGNING
30-32	PERMANENT CONSTRUCTION SIGNING
33	CHANGEABLE MESSAGE SIGN (CMS) BOARDS
34	CONTINGENCY PHASING PLAN
35	CONTINGENCY SIGNAL PLAN
36	CONTINGENCY PLAN DETOUR SIGNS
37	SIGN TEXT LAYOUT
38-40	CONST. SIGN TEXT LAYOUT
41-42	CONST. SIGN TEXT SHEET (CONTINGENCY PLAN)

STATE OF NEW HAMPSHIRE				
DEPARTMENT OF TRANSPORTATION • BUREAU OF HIGHWAY DESIGN				
<i>INDEX OF SHEETS AND GENERAL NOTES</i>				
REVISION DATE	DGN	STATE PROJECT NO.	SHEET NO.	TOTAL SHEETS
1/20/11	index_sheet	28435	2	42


GENERAL

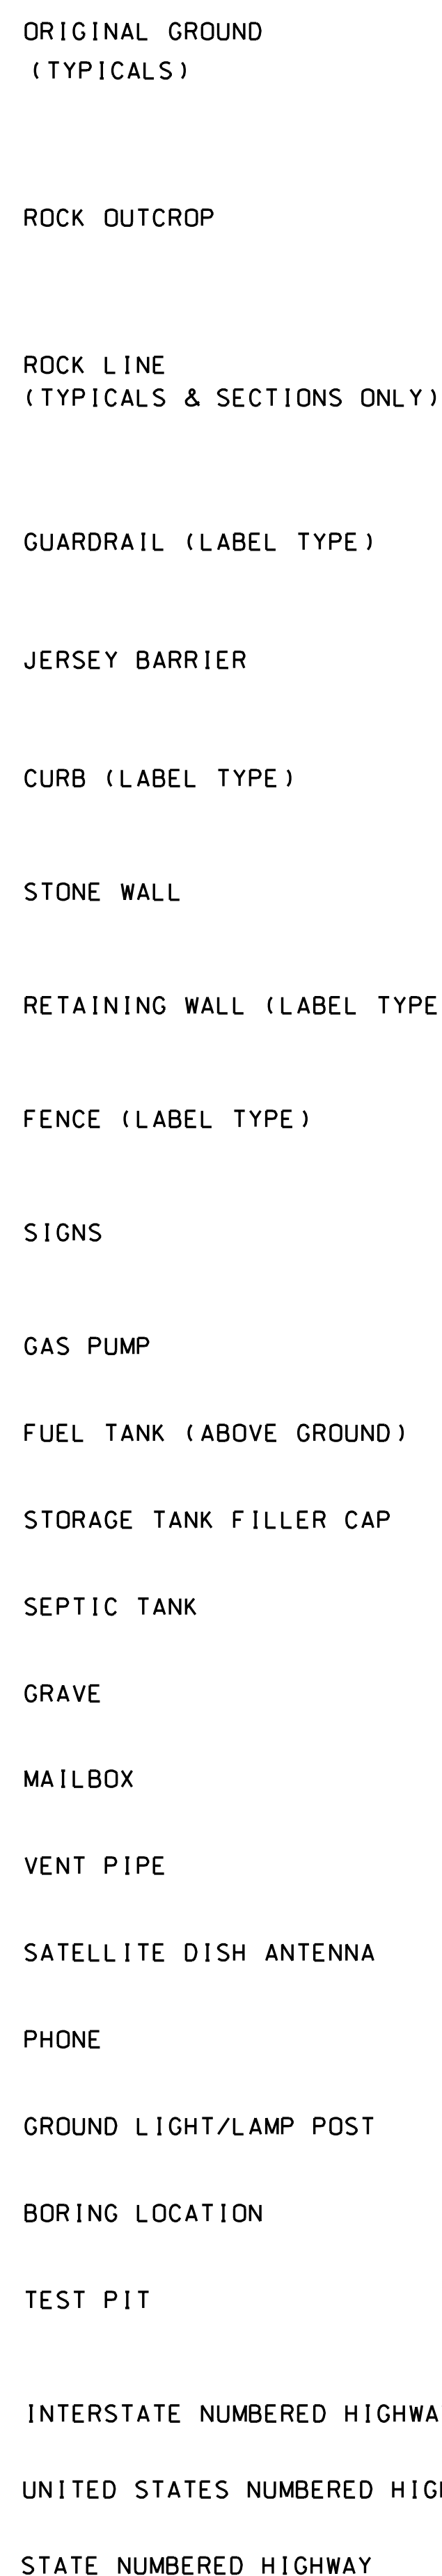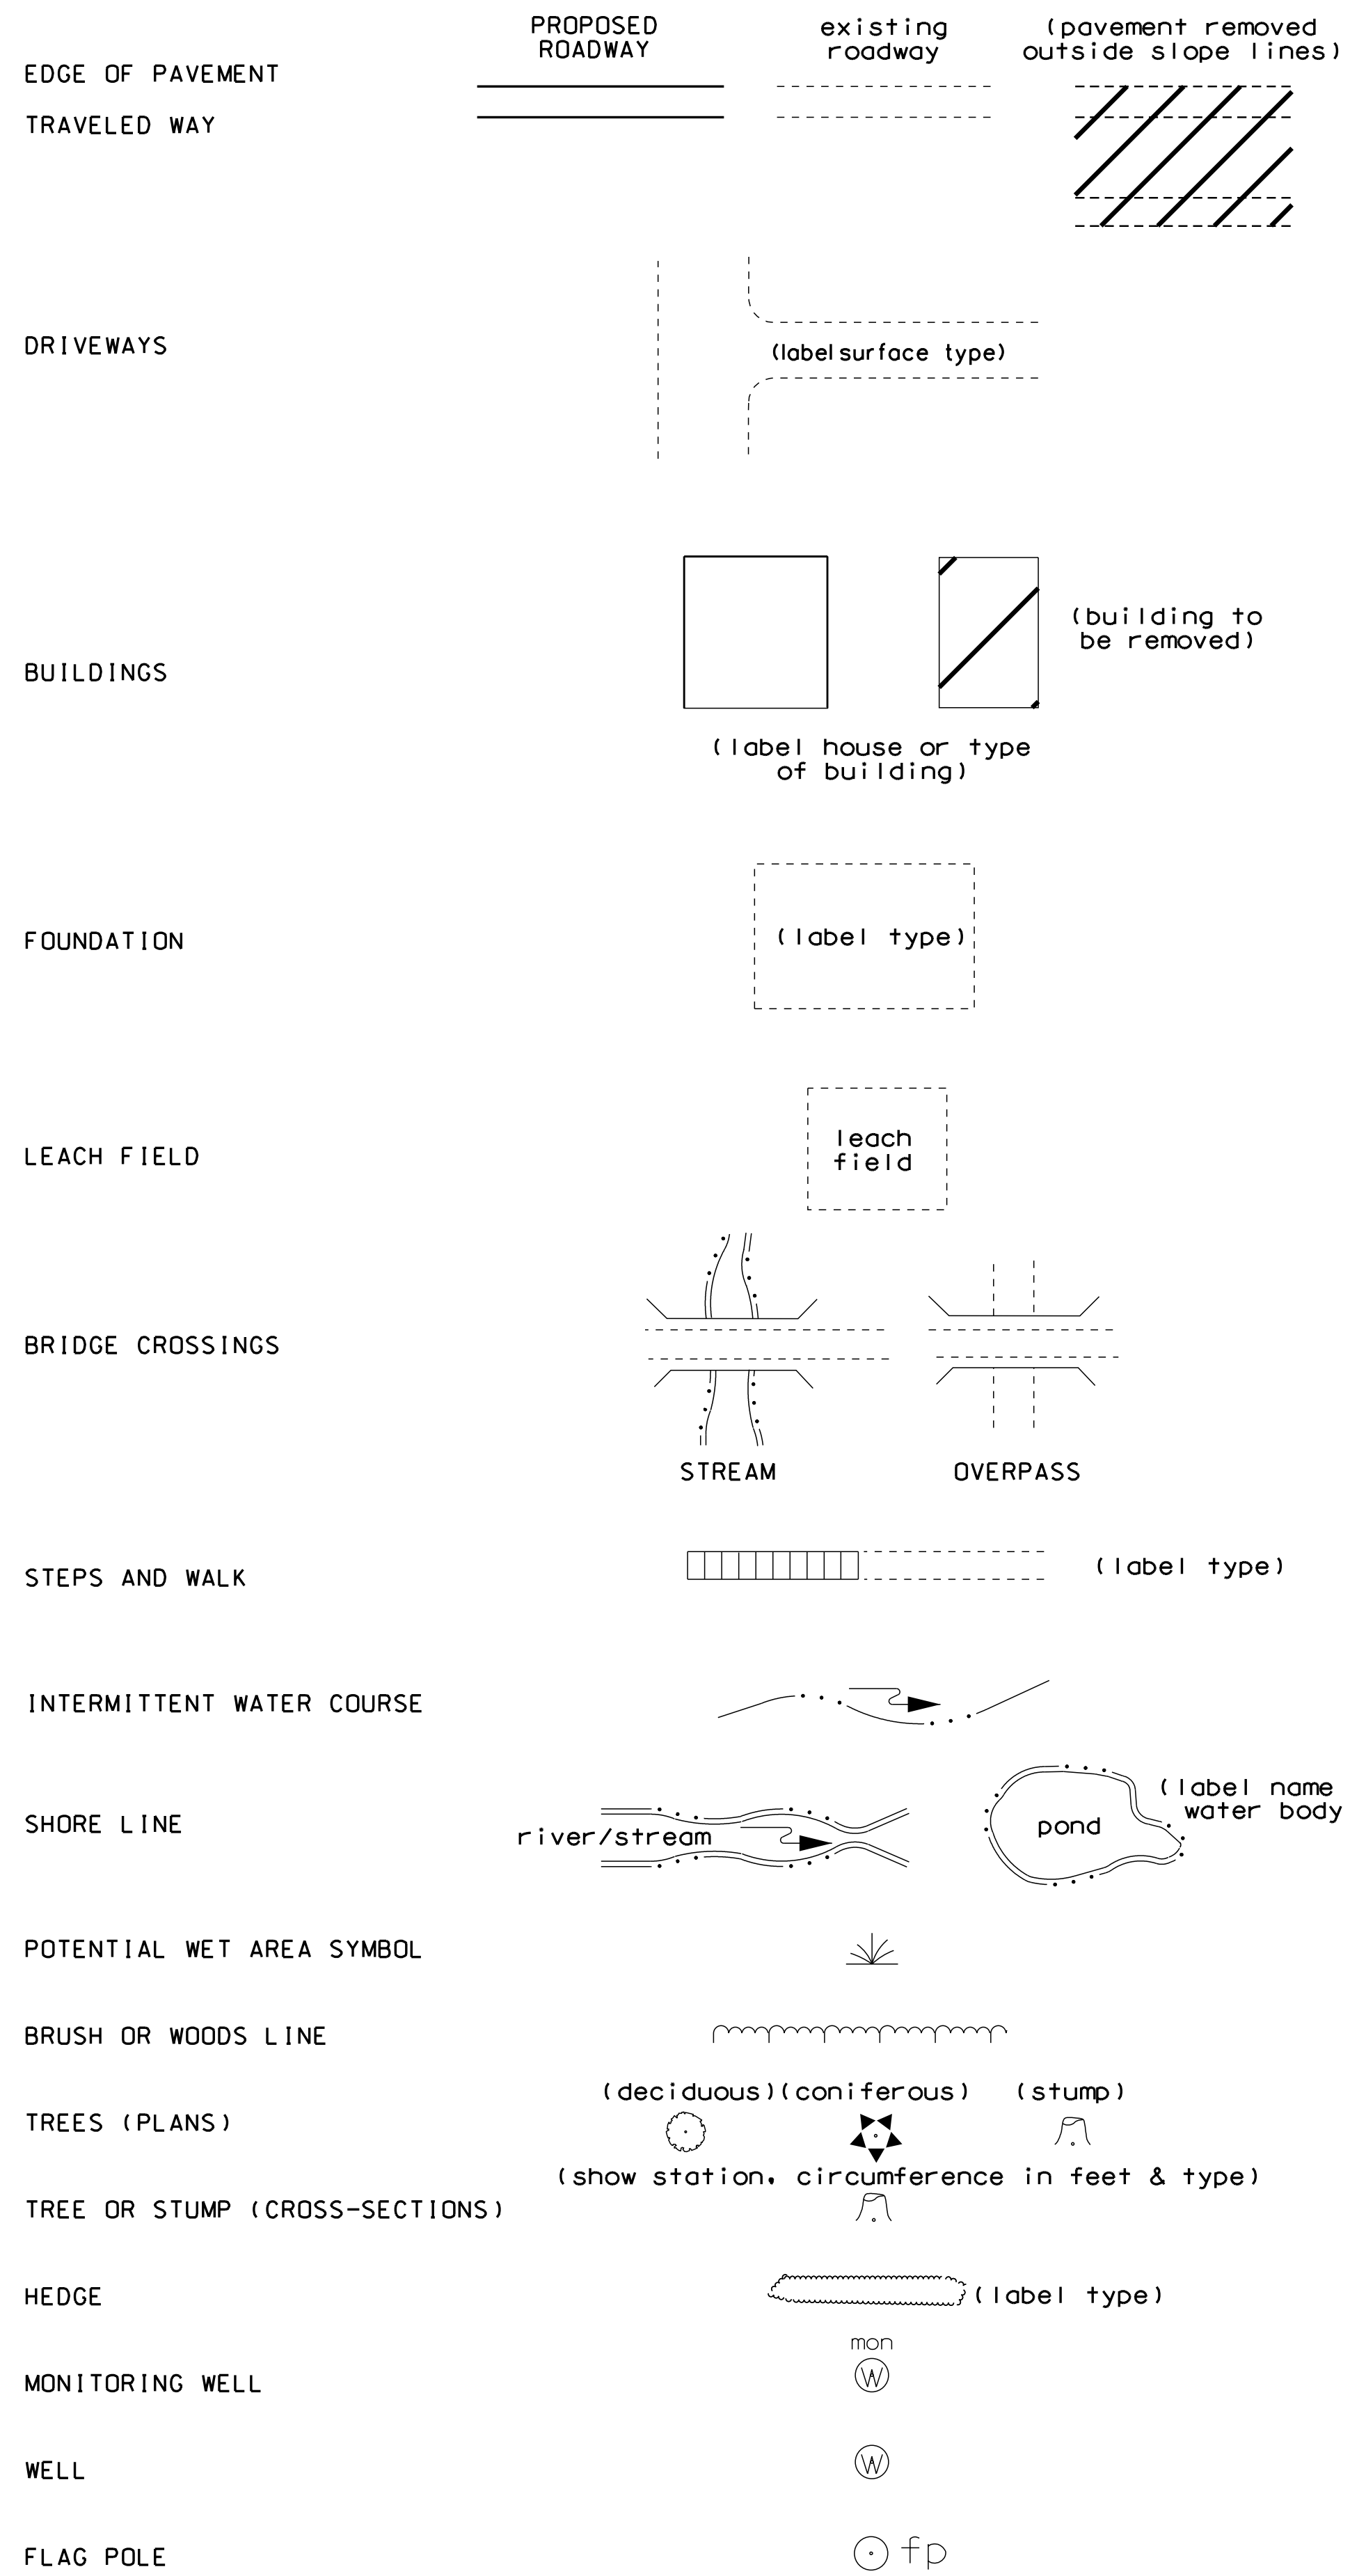


WETLANDS

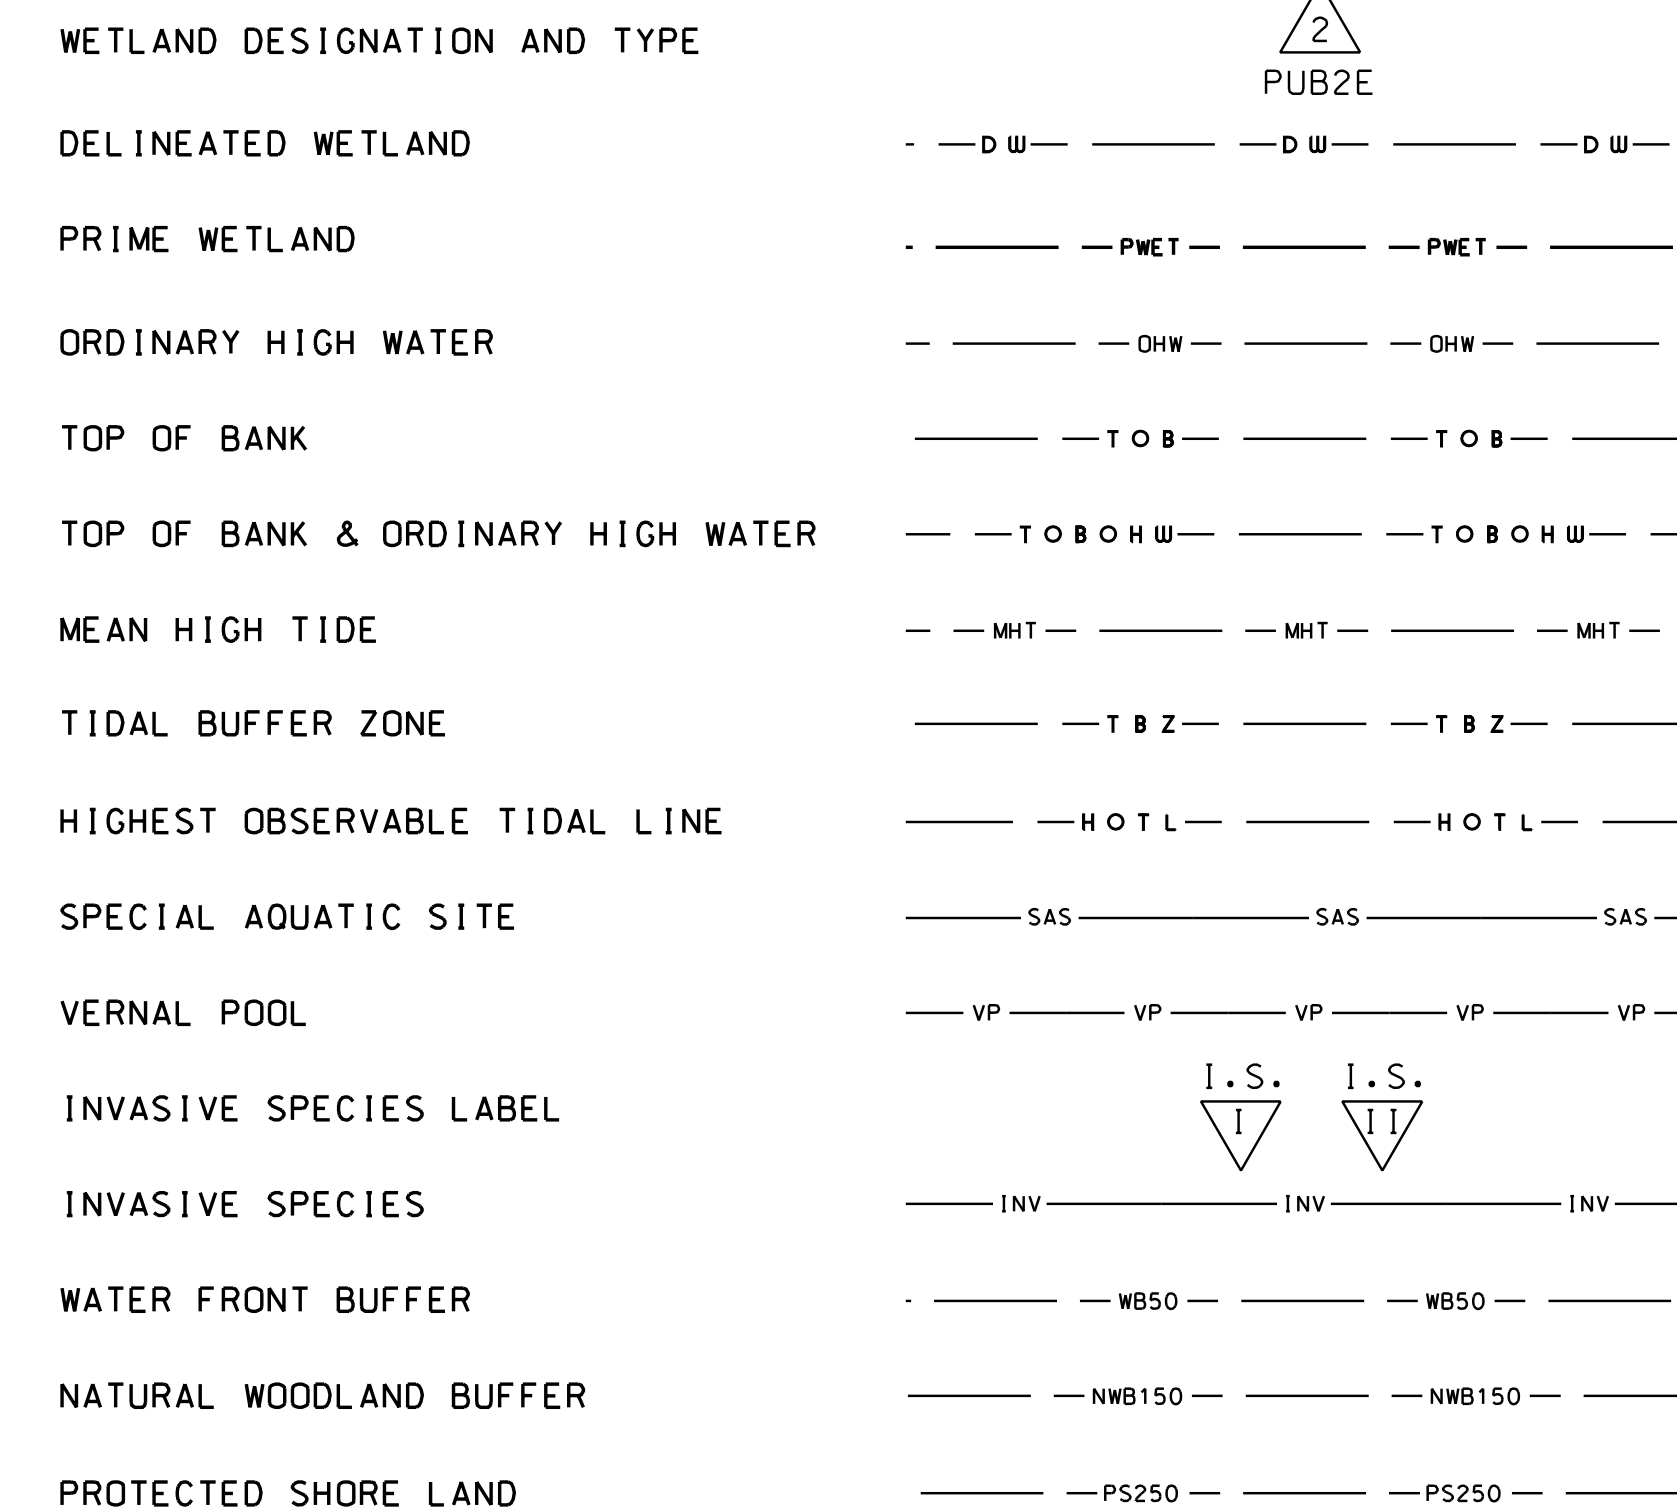

FLOODPLAIN / FLOODWAY

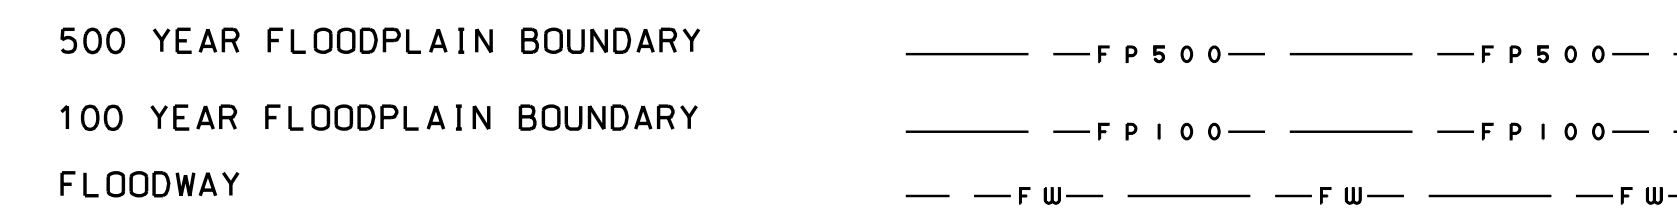


ENGINEERING

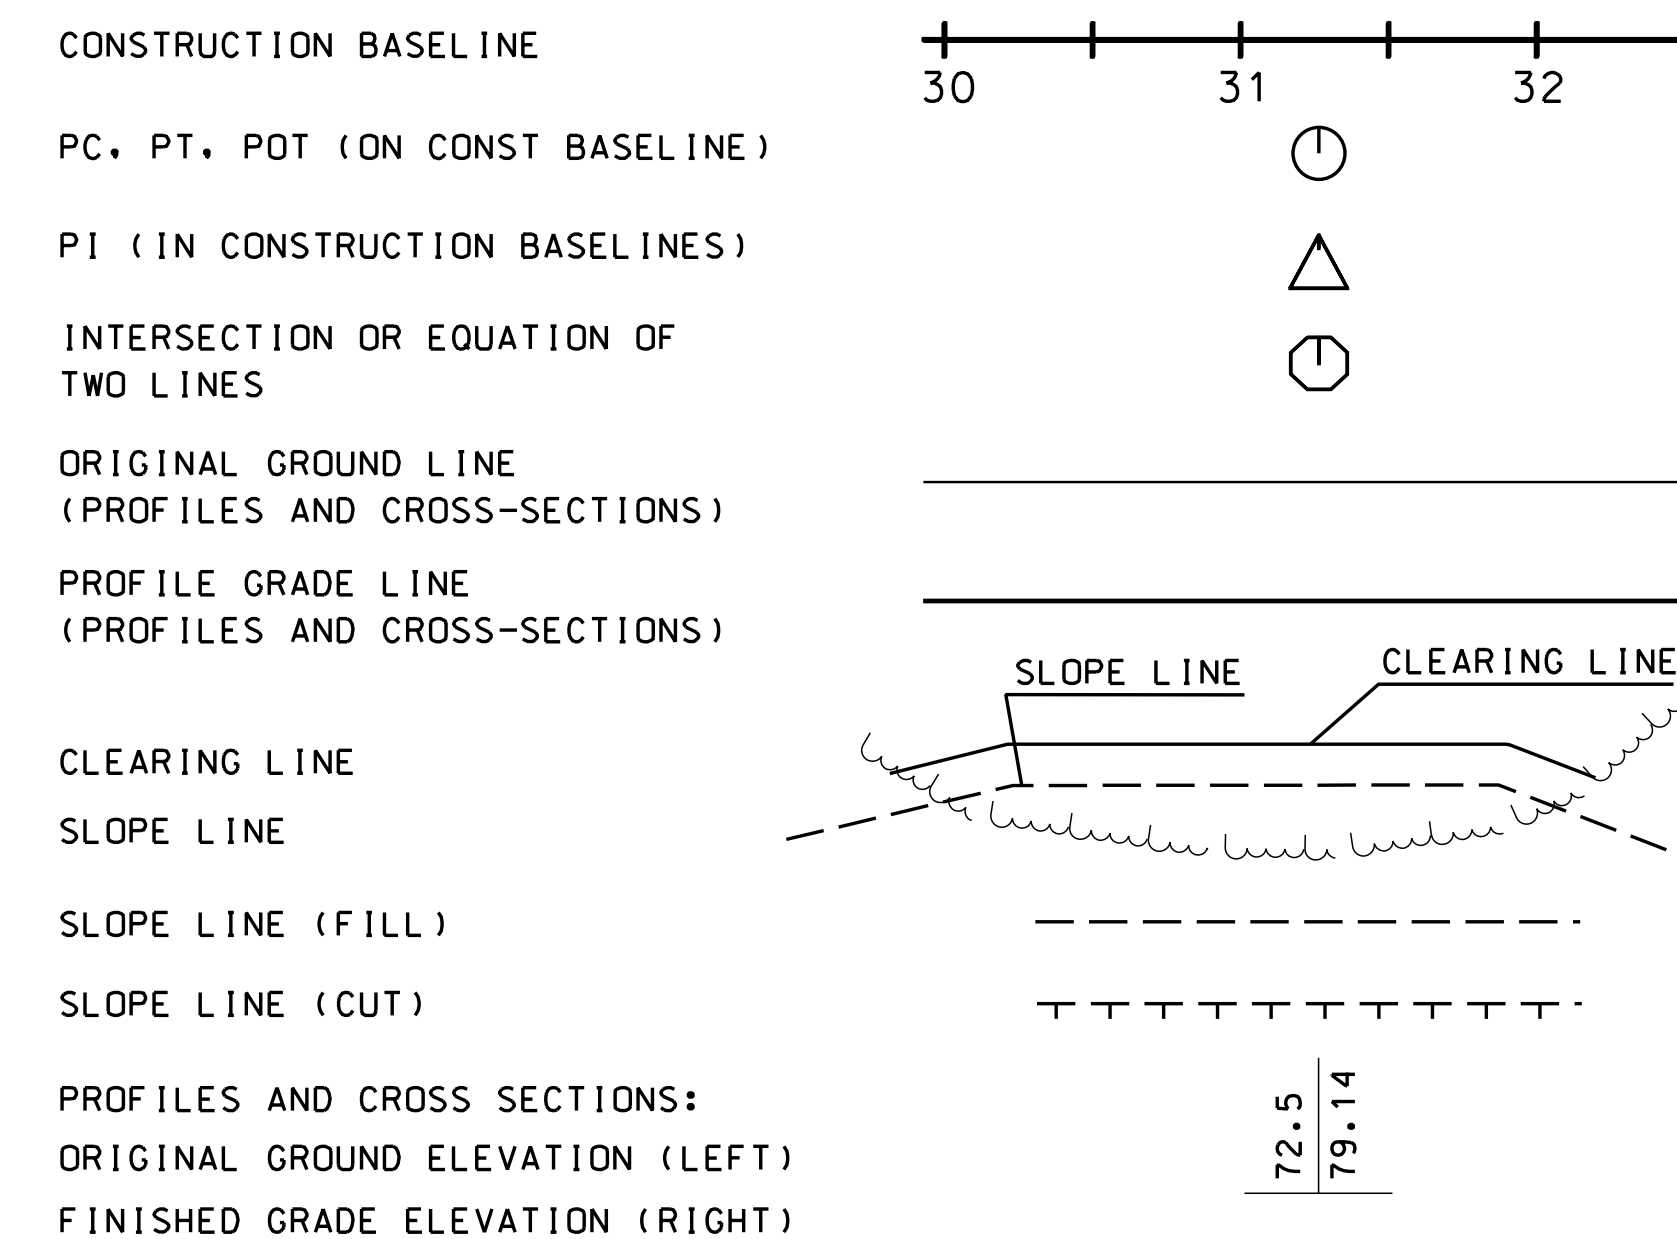


STATE OF NEW HAMPSHIRE
DEPARTMENT OF TRANSPORTATION • BUREAU OF HIGHWAY DESIGN
STANDARD SYMBOLS

REVISION DATE	DGN	STATE PROJECT NO.	SHEET NO.	TOTAL SHEETS
3-15-13	stdsymbol_2	28435	3	42


DRAINAGE

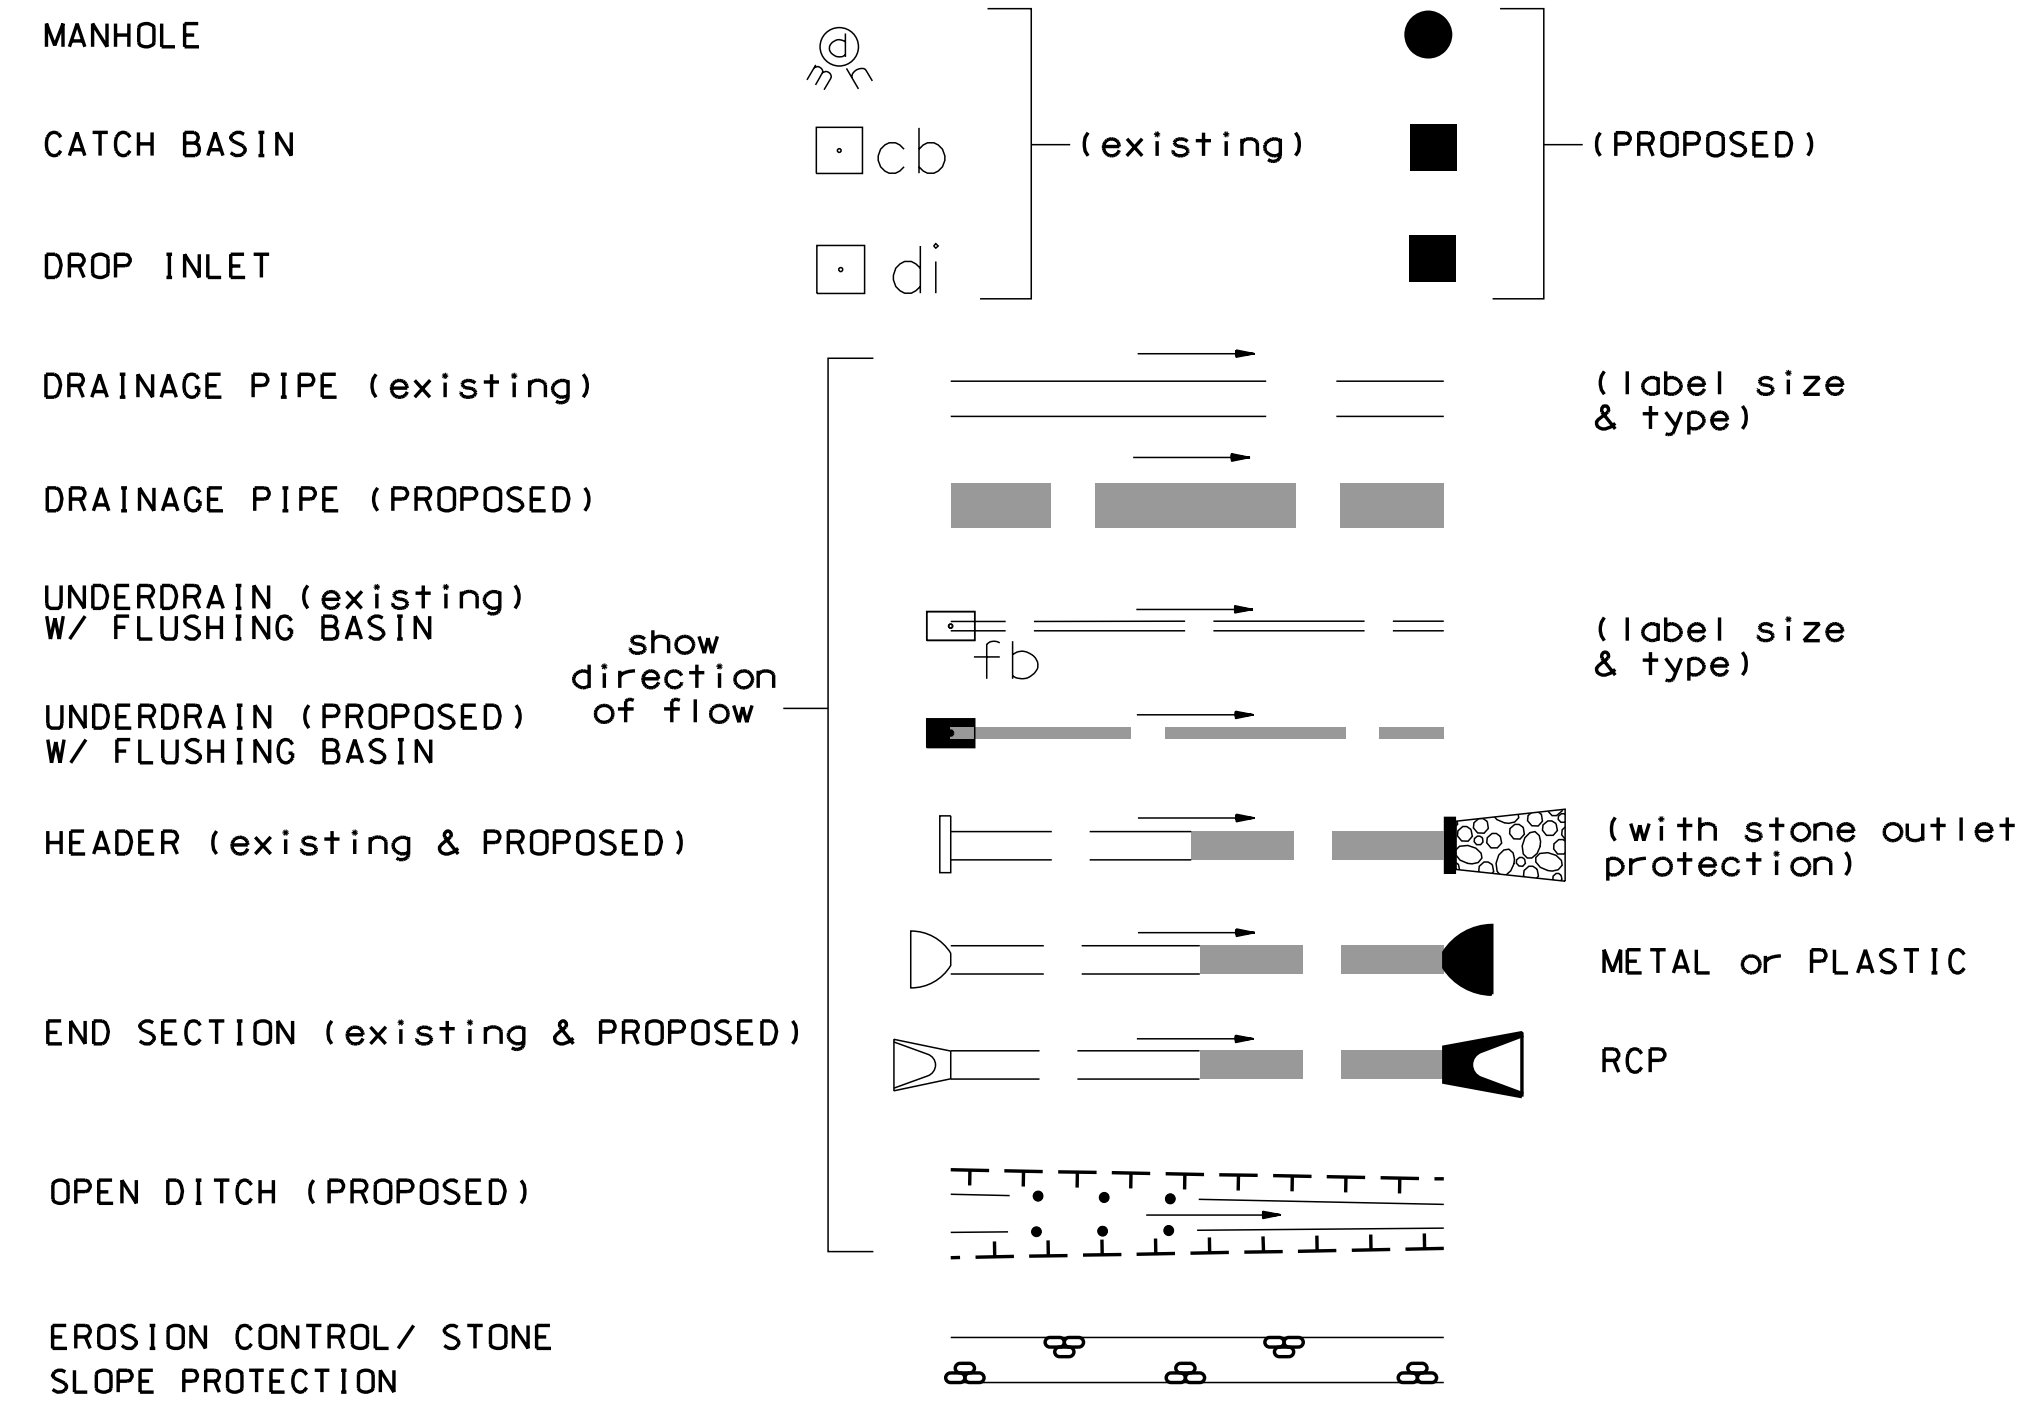


BOUNDARIES / RIGHT-OF-WAY

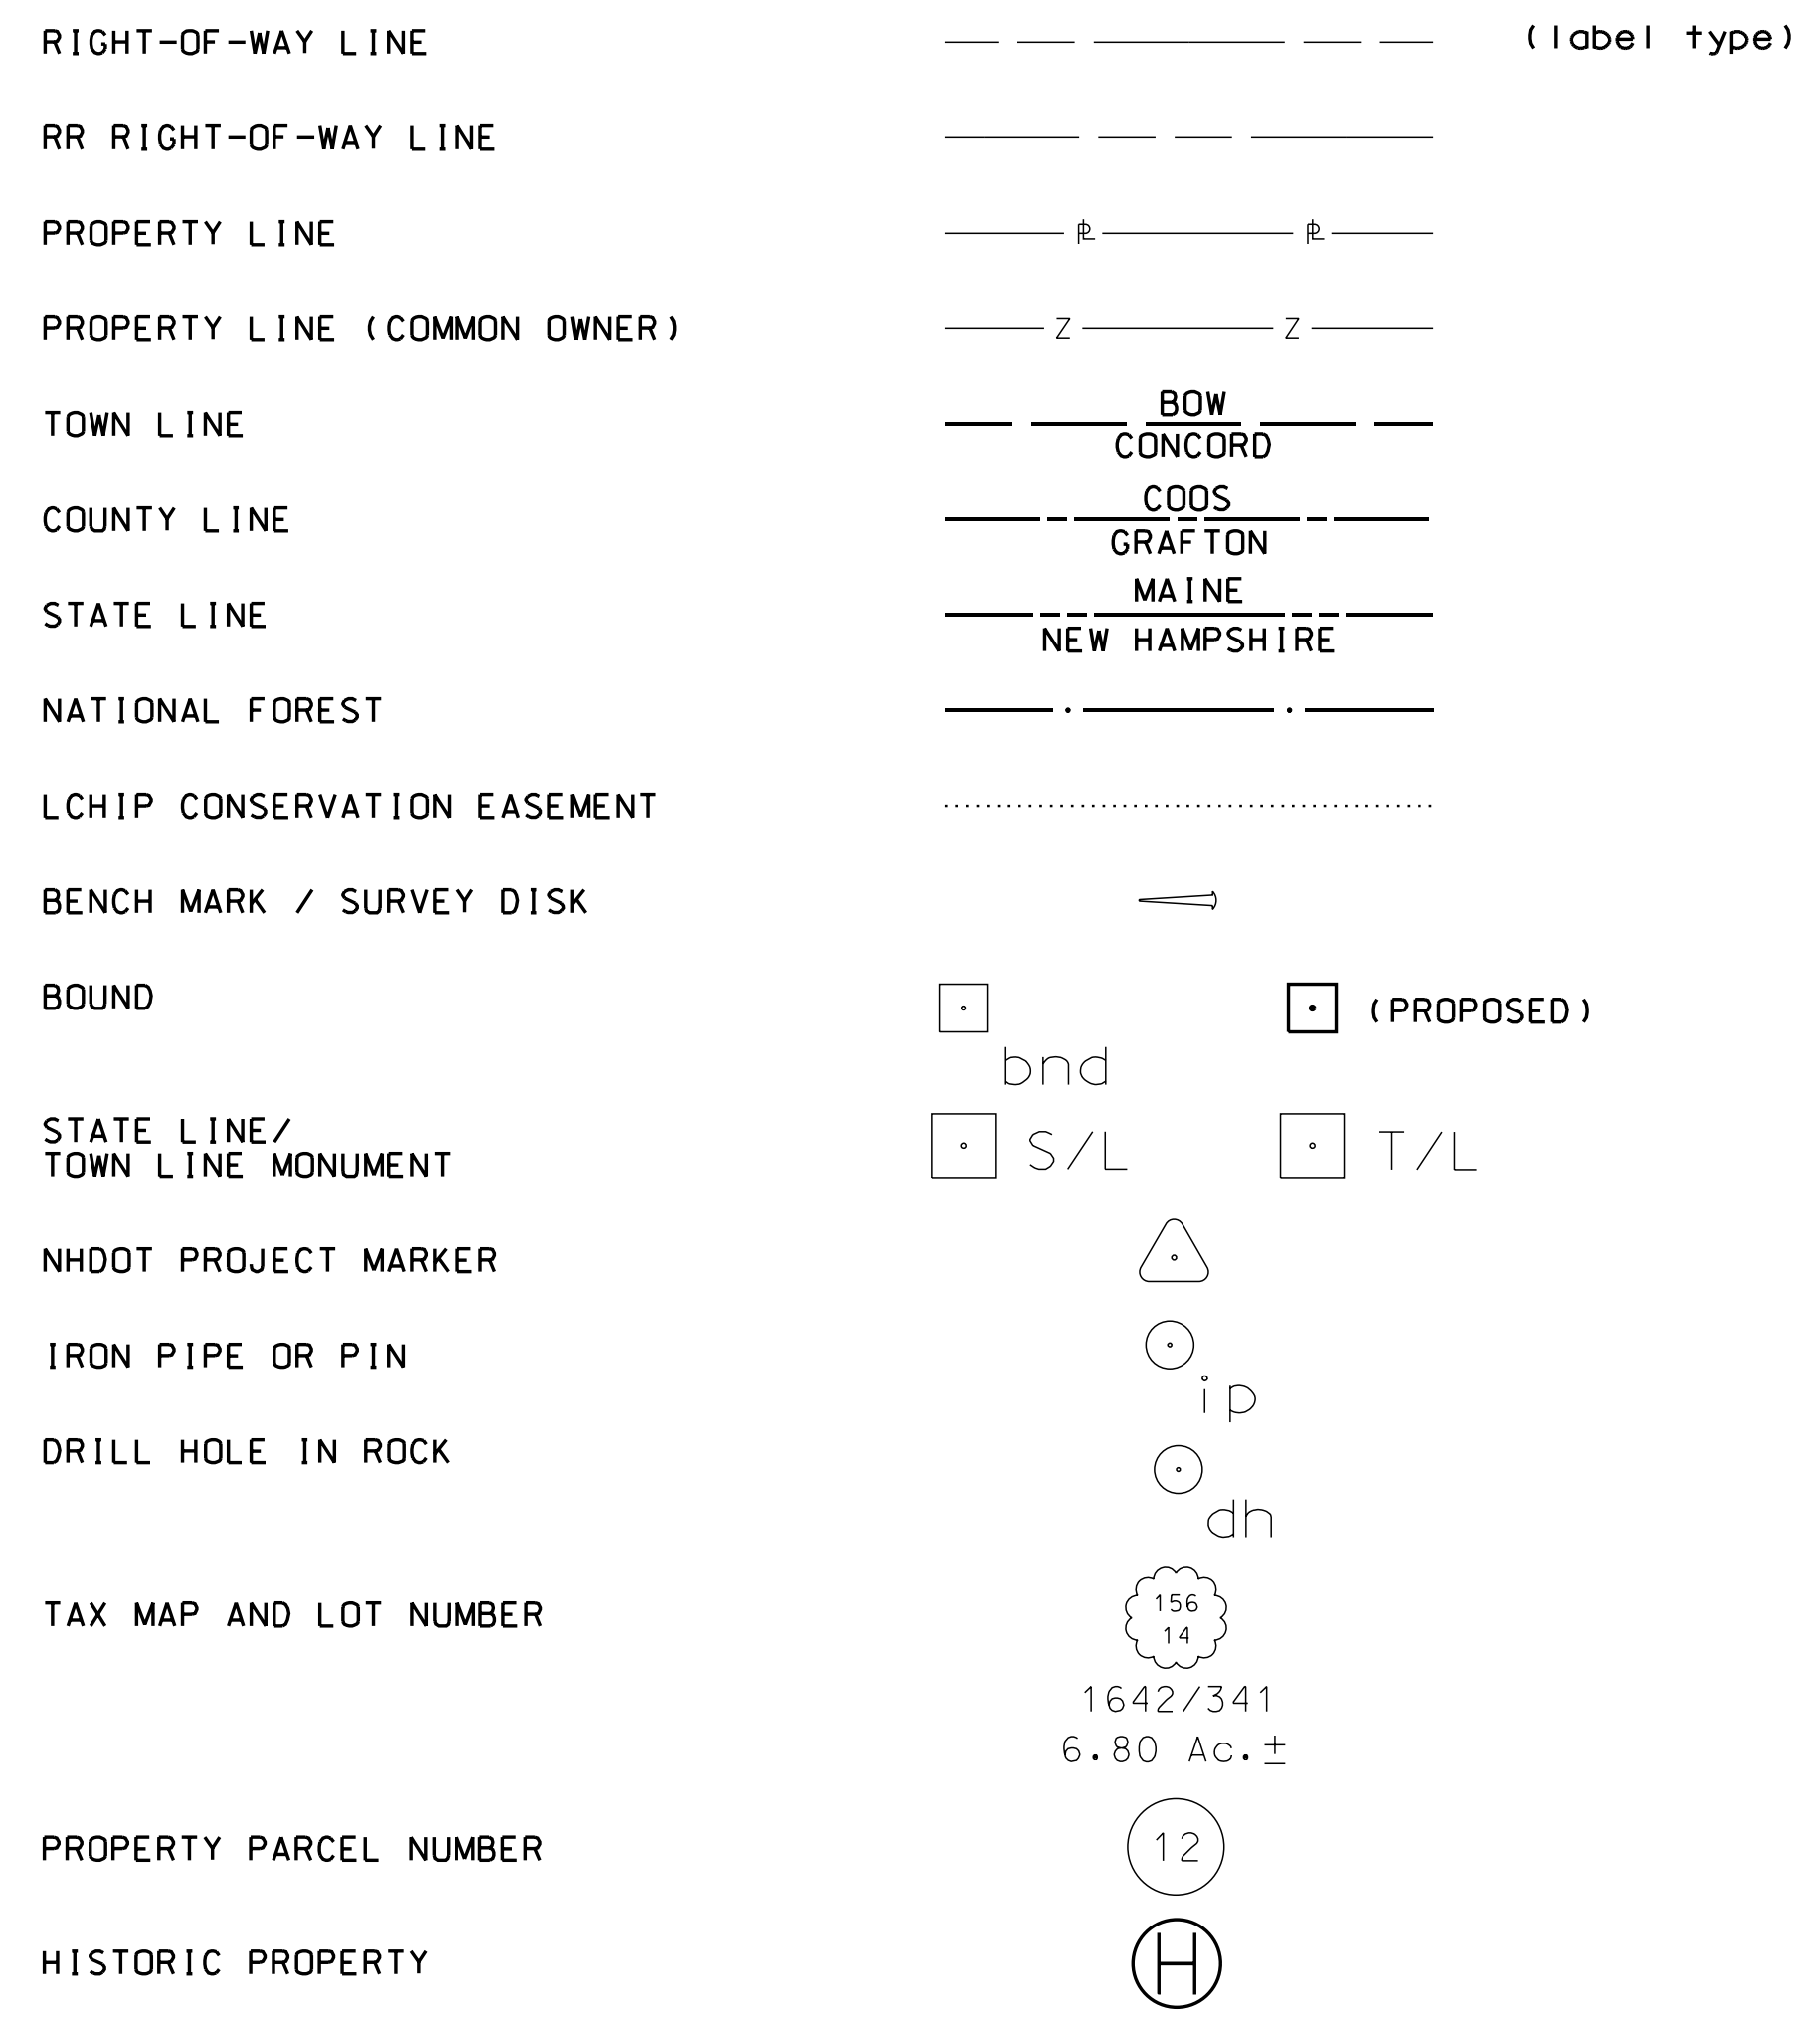


UTILITIES

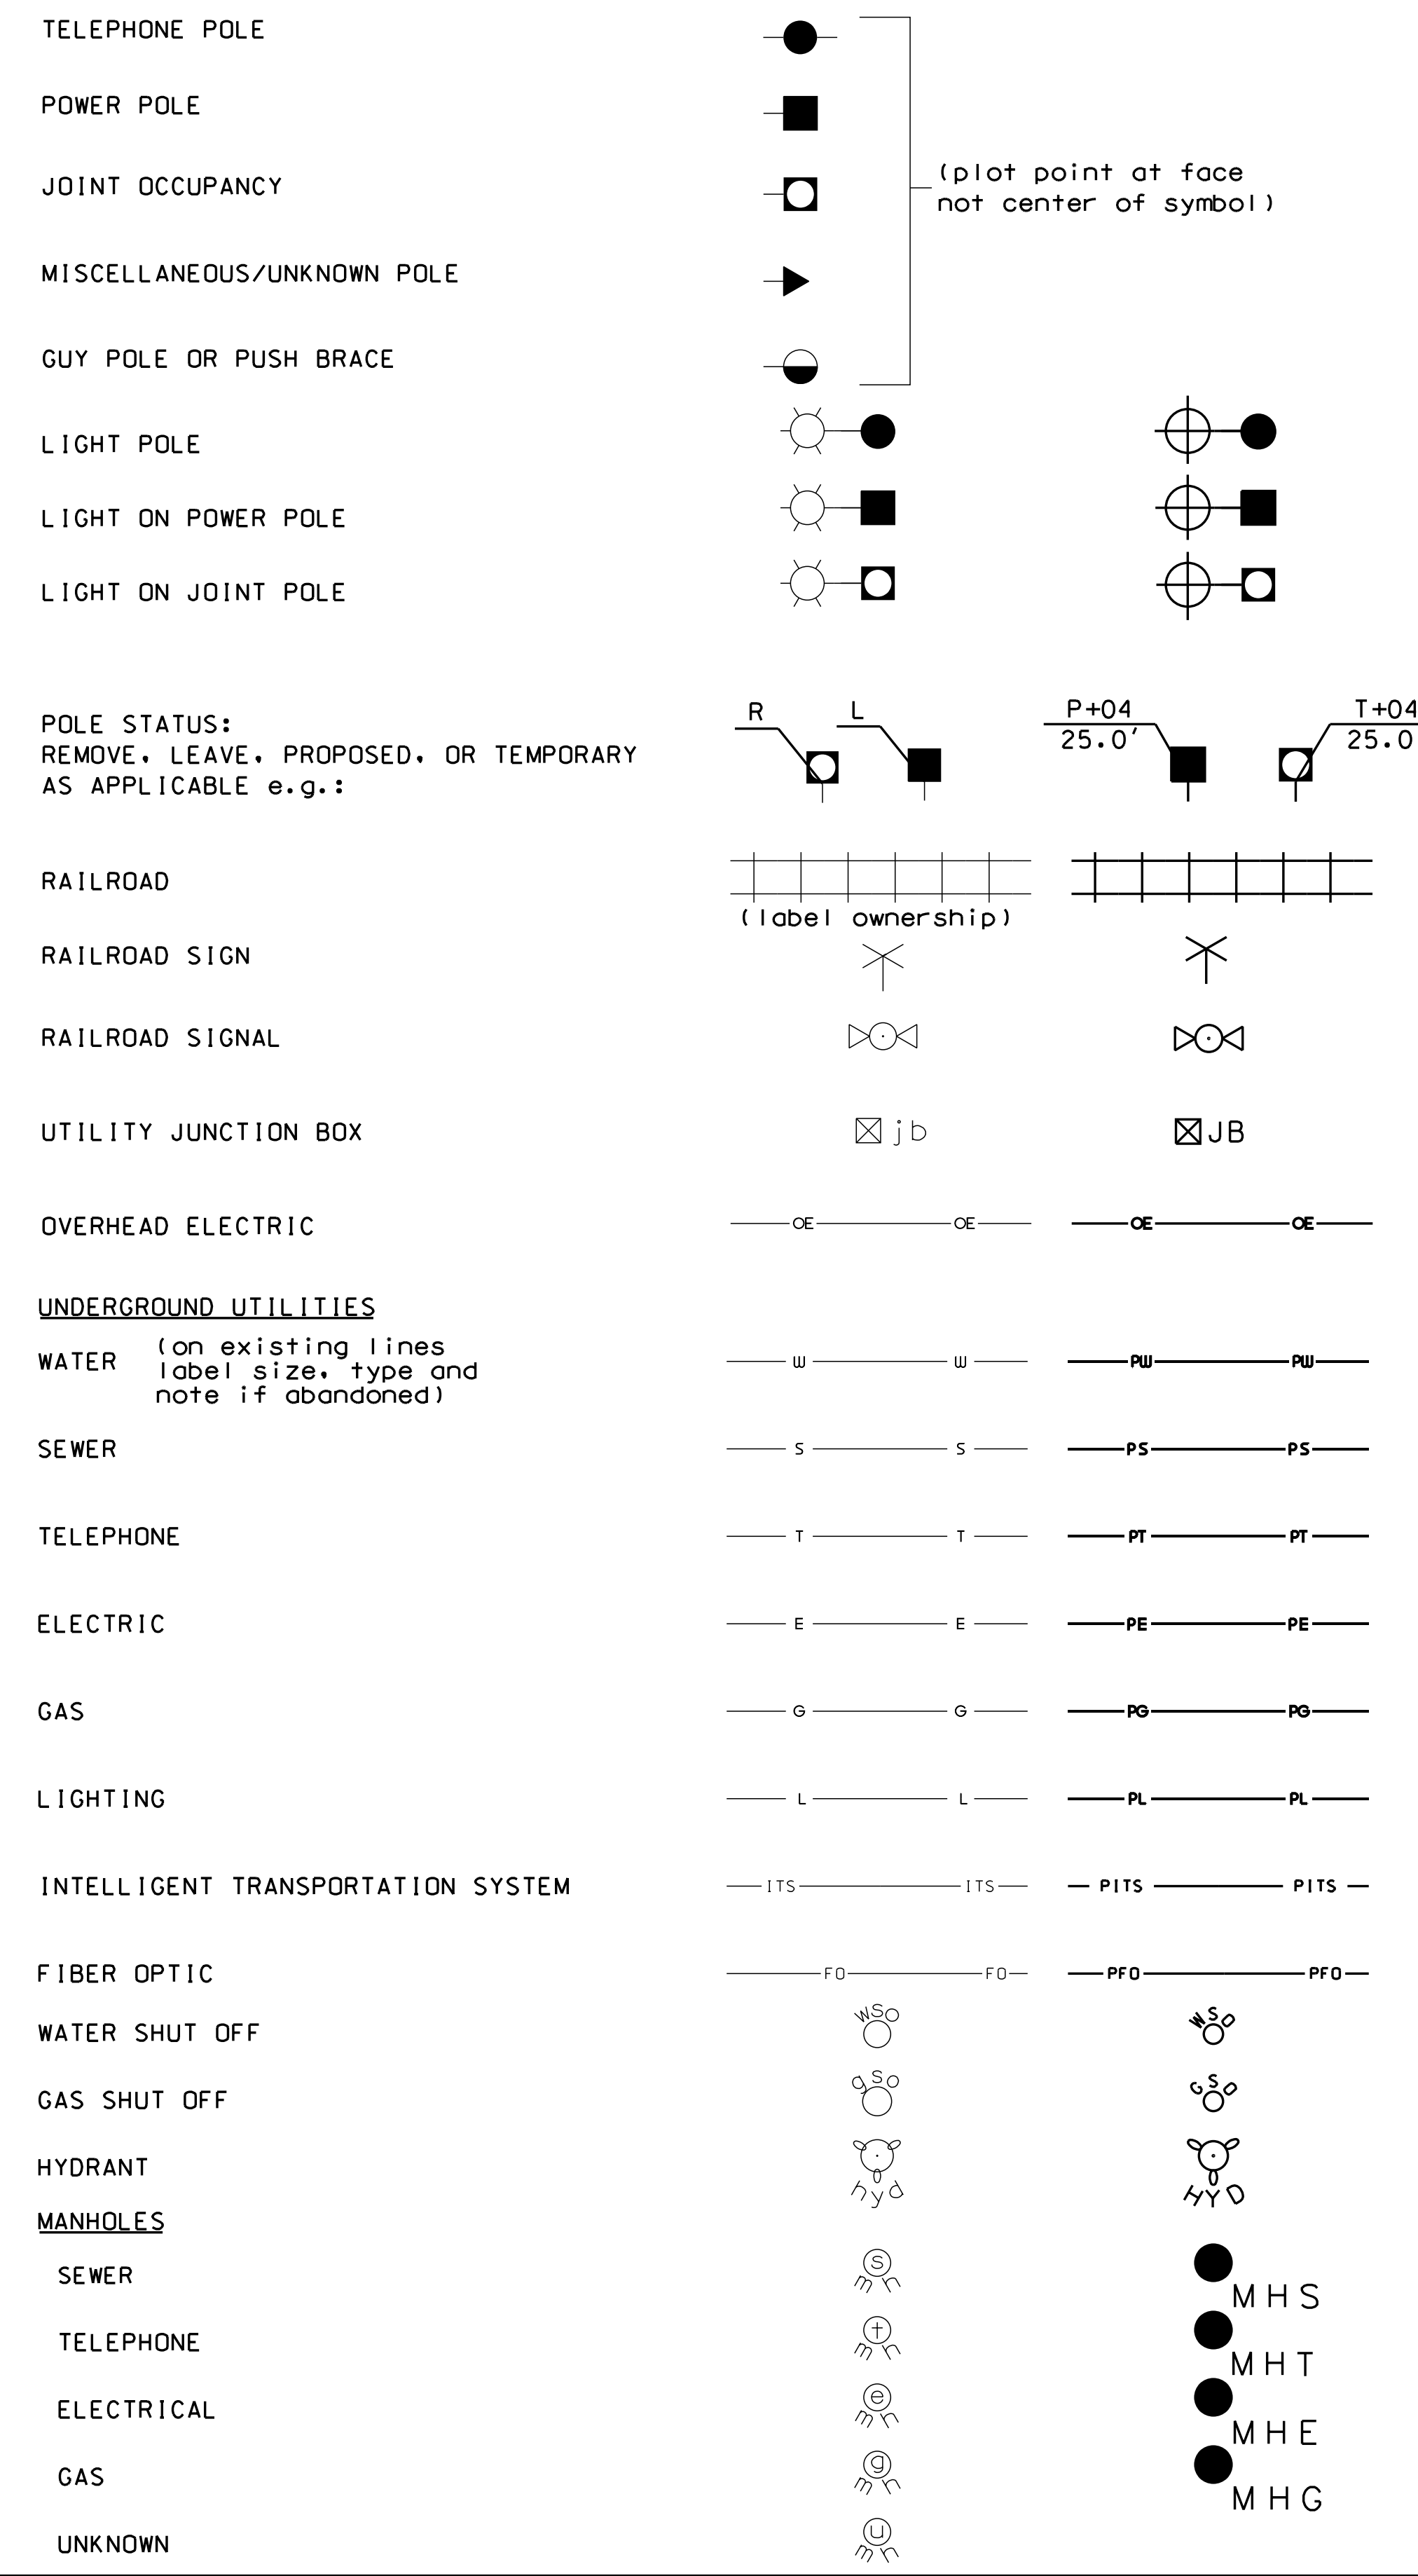

TRAFFIC SIGNALS / ITS

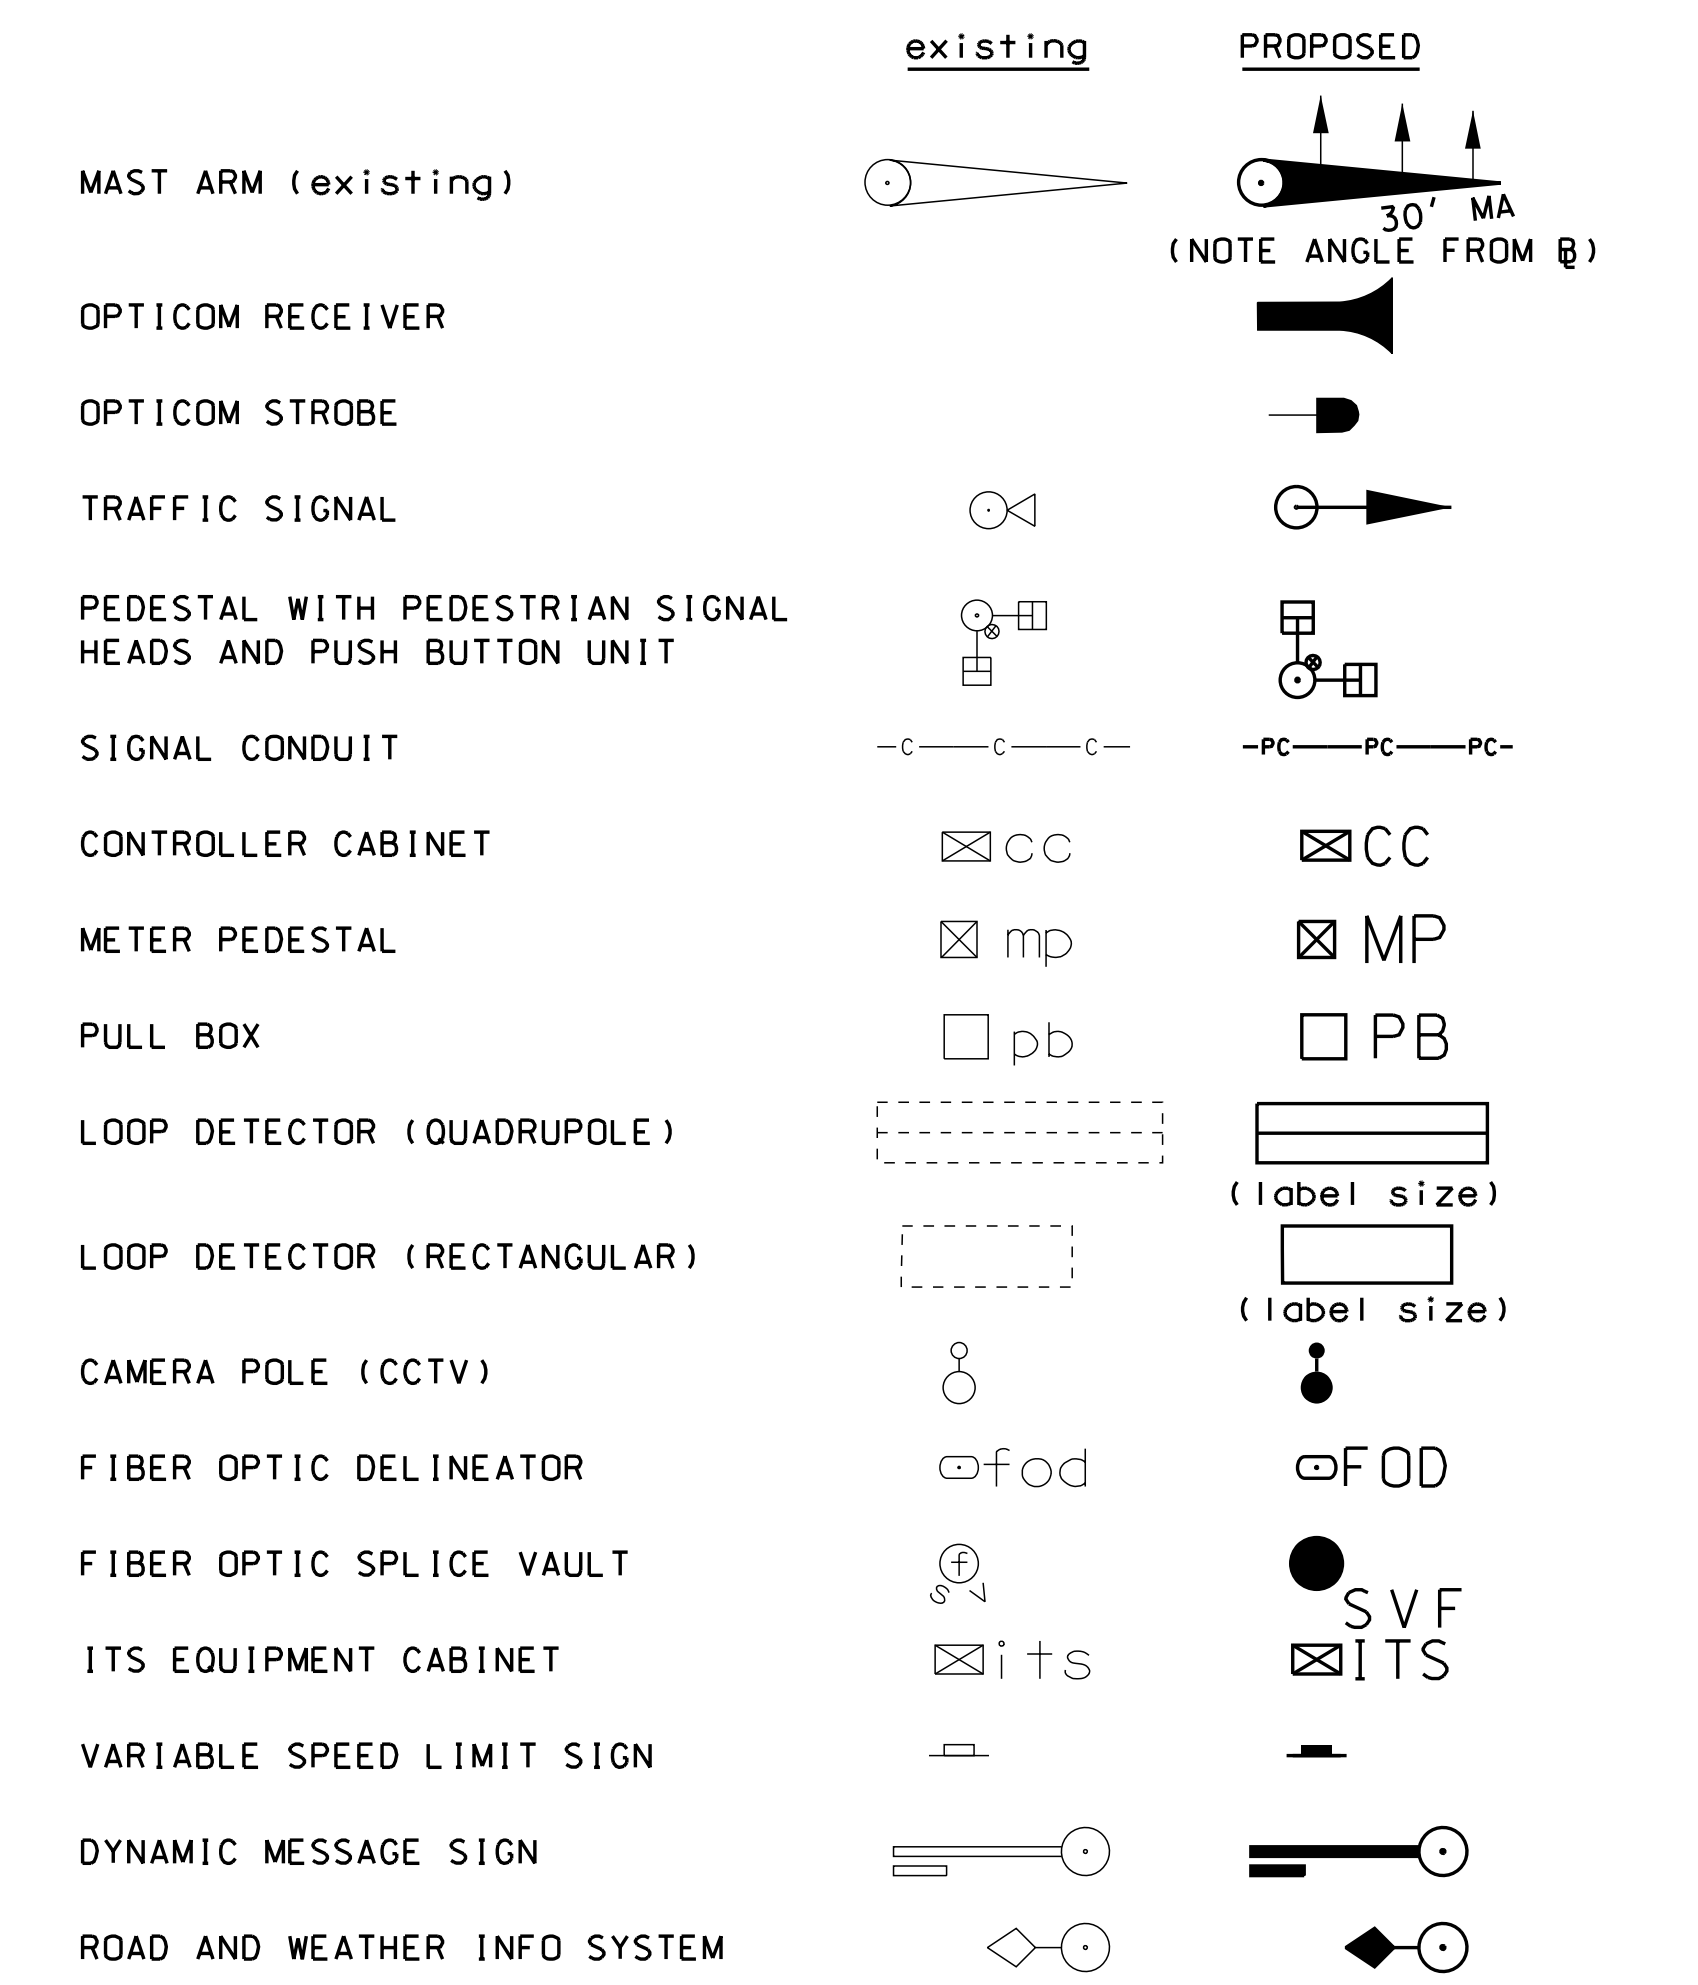


CONSTRUCTION NOTES

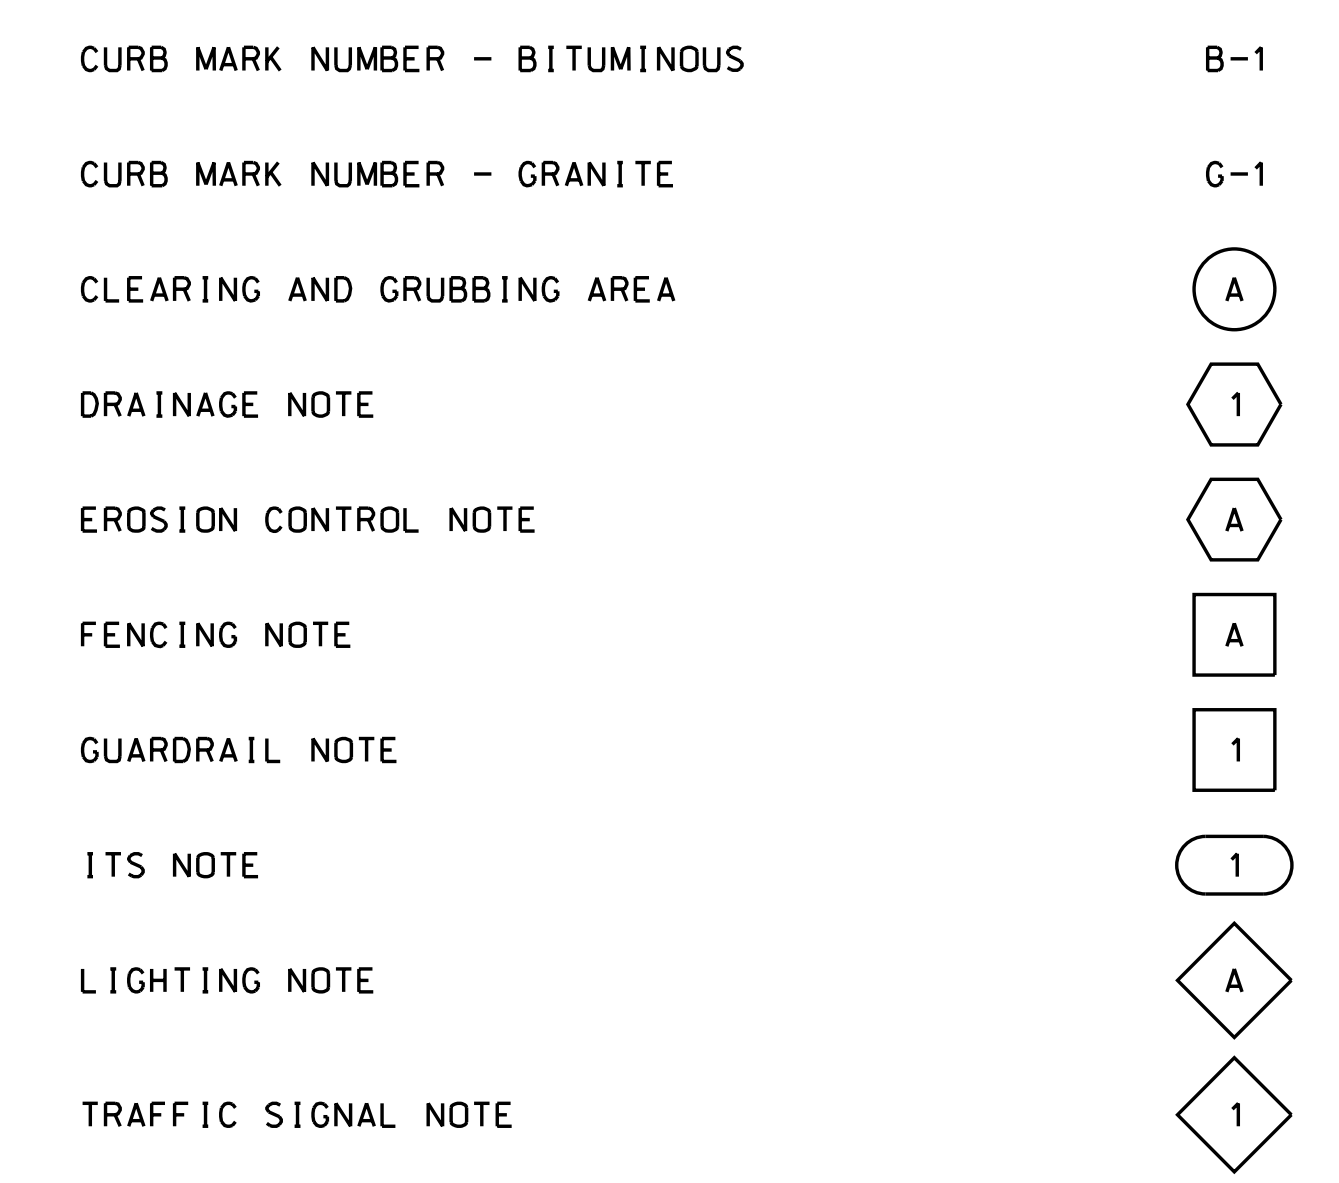

SHEET 2 OF 2

STATE OF NEW HAMPSHIRE
DEPARTMENT OF TRANSPORTATION • BUREAU OF HIGHWAY DESIGN
STANDARD SYMBOLS

REVISION DATE	DGN	STATE PROJECT NO.	SHEET NO.	TOTAL SHEETS
3-15-13	stdsymbol1_2	28435	4	42

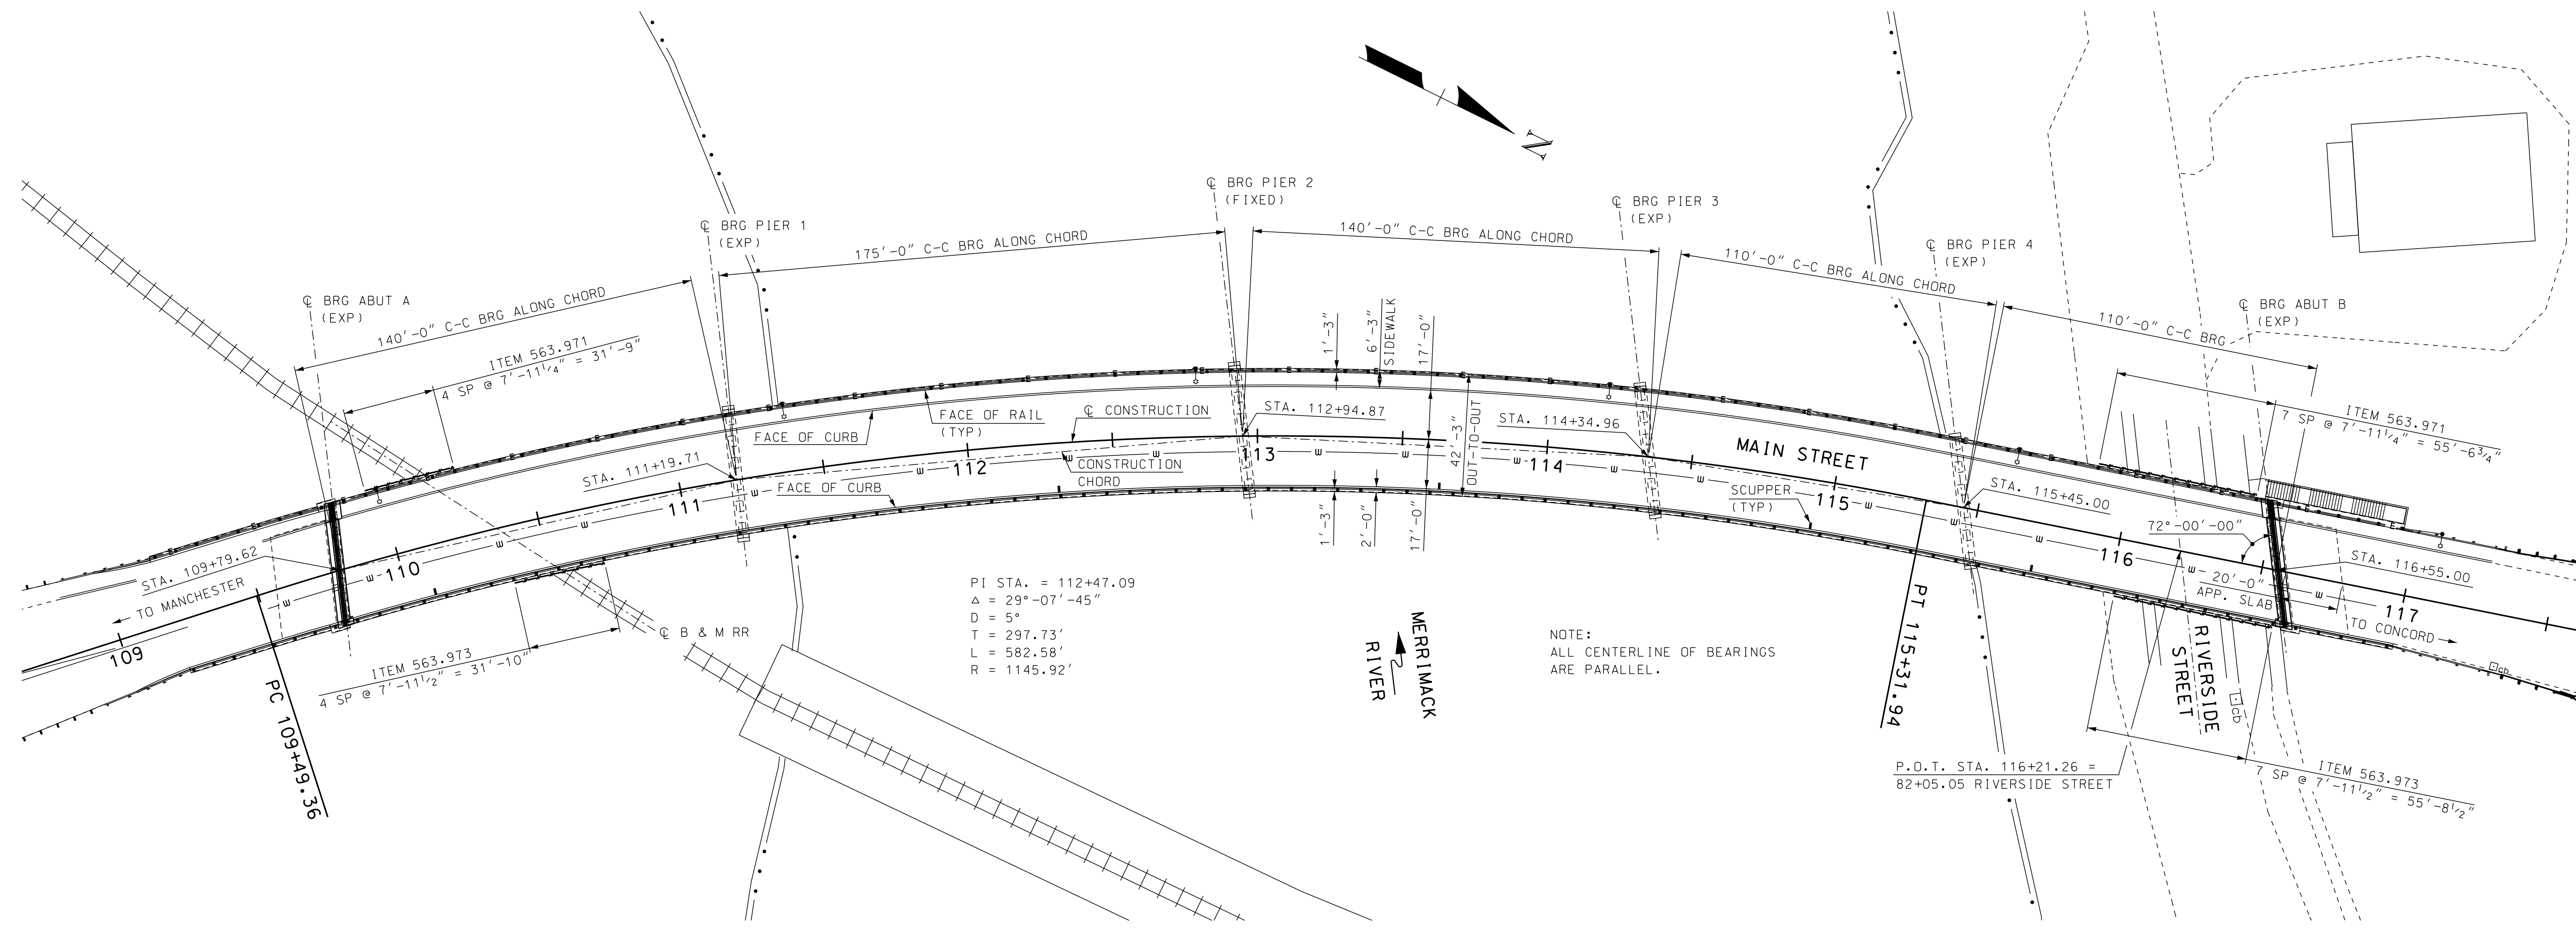


PI STA. = 112+47.09
 $\Delta = 29^{\circ}-07'-45''$
 $D = 5^{\circ}$
 $T = 297.73'$
 $L = 582.58'$
 $R = 1145.92'$

NOTE:
 ALL CENTERLINE OF BEARINGS
 ARE PARALLEL.

PLAN

SCALE: 1" = 30'-0"

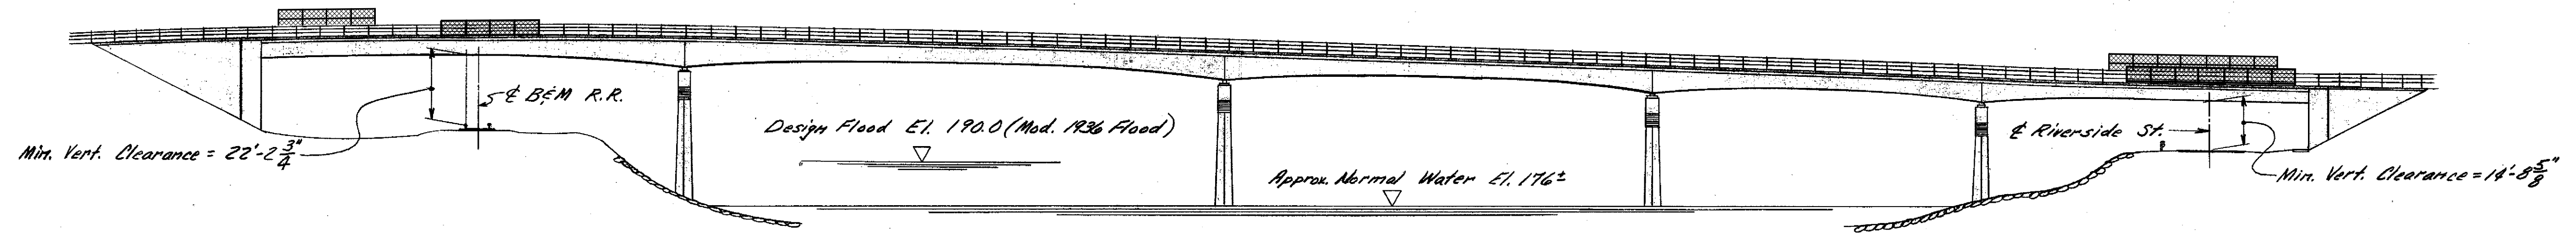

ELEVATION

SCALE: 1" = 30'-0"

STATE OF NEW HAMPSHIRE									
DEPARTMENT OF TRANSPORTATION * BUREAU OF BRIDGE DESIGN									
TOWN	HOOKSETT	BRIDGE NO.	080/148	STATE PROJECT	28435				
LOCATION MAIN STREET over B&M RR, MERRIMACK RIVER, & RIVERSIDE STREET									
GENERAL PLAN								BRIDGE SHEET	1 OF 18
DESIGNED	JAT	11/13	CHECKED	SMG	8/14	BY	DATE	FILE NUMBER	126-1-1
DRAWN	SMG	11/13	CHECKED	JAT	8/14	ISSUE DATE	FEDERAL PROJECT NO.	SHEET NO.	TOTAL SHEETS
QUANTITIES	SMG	9/14	CHECKED	JAT	9/14	REV. DATE	-----	5	42

SUBDIRECTORY	DGN LOCATOR	SHEET SCALE
BRC\	28435 Genplan	AS NOTED

SCOPE OF WORK

- BR. NO. 080/048 MAIN STREET over B&M RR, MERRIMACK RIVER, & RIVERSIDE STREET:
- REMOVE AND REPLACE DECK PAVEMENT AND MEMBRANE
 - PARTIAL & FULL DEPTH CONCRETE DECK REPAIRS
 - REPLACE MODULAR JOINT AT ABUTMENTS A & B
 - REPLACE EXISTING BEARINGS AT ABUTMENTS A & B
 - INSTALL PROTECTIVE SCREENING ON SIDEWALK SIDE (WEST)
 - INSTALL SNOW SCREENING ON COPING SIDE (EAST)
 - REPLACE GUARDRAIL APPROACH AND END UNITS ON NORTHERN APPROACHES (NW & NE CORNERS)
 - CONSTRUCT SIDEWALK TIP-DOWNS NORTH OF BRIDGE

MATERIALS AND SPECIFICATIONS

1. SPECIFICATIONS: NHDOT 2010 STANDARD SPECIFICATIONS FOR ROAD AND BRIDGE CONSTRUCTION, AS AMENDED
WELDING PER AASHTO/AWS D1.5-08 (INCLUDING ALL REVISIONS PUBLISHED BY AASHTO AS OF THE BID OPENING DATE)
2. REINFORCING STEEL: AASHTO M31 (ASTM A 615) GRADE 60
3. CONCRETE: PARTIAL DEPTH DECK REPAIRS AND CONCRETE REPAIRS
CLASS II = 4000 psi
ITEM 520.01, CONCRETE CLASS AA
FULL DEPTH DECK REPAIRS, END OF DECK, AND BACKWALL RECONSTRUCTIONS = 4000 psi
ITEM 520.0201, CONCRETE CLASS AA, ABOVE FOOTINGS

BENCHMARK NOTE

ALL EXISTING DISCS REPRESENTING STATE BENCHMARKS OR SURVEY TRIANGULATION POINTS MUST NOT BE DISTURBED. WHEN THE PROPOSED WORK INVOLVES DISTURBING ONE OF THESE DISCS, THE CONTRACTOR SHALL NOTIFY THE CONTRACT ADMINISTRATOR SUFFICIENTLY IN ADVANCE OF THE WORK TO PERMIT THE STATE TO TEMPORARILY RELOCATE THE AFFECTED MARKER.

TO THE CONTRACTOR

THE CONTRACTOR SHOULD BE AWARE THAT EXISTING STRUCTURE DIMENSIONS AND ELEVATIONS SHOWN ON THESE PLANS WERE TAKEN FROM ORIGINAL BRIDGE PLANS AND DO NOT NECESSARILY REPRESENT "AS BUILT" DIMENSIONS AND ELEVATIONS. THE CONTRACTOR SHALL FIELD VERIFY ALL DIMENSIONS AND ELEVATIONS OF THE EXISTING STRUCTURES AND BE PREPARED TO MAKE ANY ADJUSTMENTS REQUIRED TO PROPERLY REHABILITATE THE BRIDGE. ANY DISCREPANCIES IN DIMENSIONS, CHARACTER, OR EXTENT OF THE EXISTING FEATURES SHALL BE BROUGHT TO THE ATTENTION OF THE ENGINEER PRIOR TO ADVANCING THE WORK. THE EXISTING PLANS MAY BE VIEWED AT THE NHDOT, BUREAU OF BRIDGE DESIGN OFFICE DURING THE BIDDING PERIOD. AFTER THE CONTRACT IS AWARDED, A COMPLETE SET OF THE EXISTING PLANS WILL BE FORWARDED TO THE CONTRACTOR UPON REQUEST. THE FILE NUMBER FOR THIS BRIDGE IS 4-4-2-1.

REMOVAL NOTES

1. THE CONTRACTOR SHALL SUBMIT, FOR DOCUMENTATION IN ACCORDANCE WITH SECTION 105.02, A DETAILED OUTLINE OR PLAN OF THE PROPOSED METHOD FOR ITEM 502. PRIOR TO COMMENCEMENT OF ANY REMOVAL WORK.
2. EXISTING DECK PAVEMENT AND MEMBRANE SHALL BE REMOVED, HANDLED, AND DISPOSED OF UNDER ITEM 1009.32. REMOVAL AND DISPOSAL OF ASBESTOS CONTAINING MATERIAL (ACM).

GENERAL CONSTRUCTION NOTES

1. PORTABLE CONCRETE BARRIER AND TEMPORARY SIGNALS SHALL BE IN PLACE BEFORE REMOVAL OPERATIONS BEGIN FOR EACH CONSTRUCTION PHASE.
2. THE CONTRACTOR SHALL TAKE ALL NECESSARY MEASURES TO INSURE THAT DEBRIS DOES NOT FALL INTO THE WATERWAY OR ONTO THE RAILROAD TRACKS OR ROADWAY BELOW EXISTING STRUCTURES. ALL COSTS SHALL BE PAID UNDER ITEM 502, AND SHALL INCLUDE THE ERECTION, MAINTENANCE, AND REMOVAL OF TEMPORARY STRUCTURES OR OTHER SUCH METHODS AS APPROVED.
3. NO SCAFFOLDS SHALL BE ERECTED OR OPERATIONS CONDUCTED IN THE ROADWAY, UNLESS APPROVED BY THE CONTRACT ADMINISTRATOR.
4. THE WELDING OF ATTACHMENTS TO GIRDERS FOR CONSTRUCTION PURPOSES SHALL NOT BE PERMITTED UNLESS APPROVED BY THE NHDOT, BUREAU OF BRIDGE DESIGN.
5. DURING ALL REMOVAL AND REPAIR OPERATIONS EXTREME CARE SHALL BE TAKEN NOT TO DAMAGE EXISTING DECK REINFORCEMENT. ANY DAMAGE SHALL BE IMMEDIATELY REPORTED TO THE BUREAU OF BRIDGE DESIGN AND REPAIRED AS DIRECTED, AT THE CONTRACTOR'S EXPENSE.
6. DURING CONCRETE END OF DECK REMOVAL OPERATIONS, EXTREME CARE SHALL BE TAKEN NOT TO DAMAGE TOP FLANGES OF EXISTING GIRDERS. ANY DAMAGE SHALL BE IMMEDIATELY REPORTED TO THE BUREAU OF BRIDGE DESIGN AND REPAIRED AS DIRECTED, AT THE CONTRACTOR'S EXPENSE.
7. TO ACCOMPLISH THE PROPOSED EXPANSION JOINT REPAIRS, THE EXISTING DECK AND BACKWALL SHALL BE REMOVED TO LIMITS SHOWN IN THE PLANS UNDER ITEM 502. REMOVAL OF EXISTING BRIDGE STRUCTURE. ALL EXPOSED CONCRETE SURFACES OF THE DECK AND BACKWALL SHALL BE SAWCUT 1" DEEP TO PROVIDE CLEAN REMOVAL LINES (ALL COSTS INCLUDED IN ITEM 502.). NEW DECK END AND BACKWALL SHALL BE RECONSTRUCTED WITH ITEM 520.0201, CONCRETE CLASS AA, ABOVE FOOTINGS. PRIOR TO PLACING NEW CONCRETE, THE REMOVAL SURFACES SHALL BE BLAST CLEANED AND SATURATED SURFACE DRY (ALL COSTS INCLUDED IN ITEM 520.0201).
8. THE CONTRACTOR SHALL TAKE ALL NECESSARY MEASURES TO PROTECT EXISTING UTILITY INSTALLATIONS FROM DAMAGE DURING DECK REMOVAL AND JACKING OPERATIONS. A PROTECTION PLAN SHALL BE SUBMITTED FOR APPROVAL. ALL COSTS PAID FOR UNDER ITEM 502.
9. AFTER REMOVAL OF EXISTING PAVEMENT AND MEMBRANE, THE EXISTING CONCRETE BRIDGE DECKS SHALL BE "SOUNDED" TO DETERMINE AREAS REQUIRING PARTIAL AND FULL DEPTH DECK REPAIRS. ALL COSTS TO BE INCLUDED IN ITEM 511.02 OR ITEM 511.03.

10. DETERIORATED AREAS OF DECK SHALL BE PATCHED WITH CONCRETE CLASS AA. PRIOR TO PLACING NEW CONCRETE, THE PREPARED AREAS SHALL BE BLAST CLEANED AND SATURATED SURFACE DRY (ALL COSTS SUBSIDIARY TO ITEM 520.01 OR 520.0201).
11. ALL EXPOSED EDGES OF CONCRETE SHALL BE CHAMFERED 3/4", UNLESS OTHERWISE NOTED.
12. ITEM 538.6, BARRIER MEMBRANE, HEAT WELDED - MACHINE METHOD (F) SHALL BE OVERLAPPED PER MANUFACTURER'S REQUIREMENTS. AT DECK ENDS, WHERE THE MEMBRANE WILL NOT OVERLAP NEW OR EXISTING MEMBRANE, A SEALANT/REPAIR MASTIC COMPATIBLE WITH ITEM 538.6 SHALL BRIDGE ANY GAP BETWEEN THE EXISTING MEMBRANE AND NEW MEMBRANE OR BETWEEN THE NEW MEMBRANE AND THE END OF DECK WHEN THERE IS NO EXISTING MEMBRANE. ALL COSTS SHALL BE SUBSIDIARY TO ITEM 538.6.
13. PROFILE ADJUSTMENTS IN THE VICINITY OF THE REHABILITATED BRIDGE SHALL BE MADE AS REQUIRED OR AS DIRECTED TO ACCOUNT FOR VARIATIONS IN THE BRIDGE DECK CROSS SLOPES. ALL COSTS SHALL BE INCLUDED IN THE APPROPRIATE ITEMS.
14. REMOVE ANY EXISTING LOOSE OR FLAKING EPOXY COATING FROM THE BACKWALL AND SEATS AS DIRECTED. COSTS PAID UNDER ITEM 502.
15. EXISTING BRIDGE DECK COPINGS, WINGS, SIDEWALKS, STAIRS ALONG NW WING, BACKWALLS, AND ABUTMENT BRIDGE SEATS SHALL BE WASHED, SUBSIDIARY TO ITEM 534.3, IN SUCH A MANNER THAT OVERSPRAY INTO SURFACE WATERS IS KEPT TO A MINIMUM. IF THE WATER BEADS, NO COATING NEEDS TO BE APPLIED. IF THE WATER DOES NOT BEAD COAT THE SURFACE WITH ITEM 534.3, WATER REPELLENT (SILANE-SILOXANE). APPLICATION RATE = 150 SF/GAL.
16. UNLESS OTHERWISE NOTED, HOLES DRILLED INTO EXISTING CONCRETE SHALL BE DRILLED 1/2" DIAMETER LARGER THAN THE BAR DIAMETER AND GROUTED WITH AN APPROVED HIGH STRENGTH, NON-SHRINK CEMENTITIOUS GROUT. ALL COSTS FOR DRILLING AND GROUTING SHALL BE PAID FOR UNDER ITEM 520.0201.
17. WHERE THE EXISTING GRANITE CURB HAS SEPERATED OR BEEN DISPLACED FROM THE CONCRETE BRUSH CURB, THE GRANITE CURB SHALL BE REMOVED AND RESET AS DIRECTED BY THE ENGINEER. ALL COSTS INCLUDED IN ITEM 609.55, RESET GRANITE CURB (BRIDGE), EXCEPT AS SHOWN IN THE PLANS.
18. RESET GRANITE APPROACH CURB AS DIRECTED, ITEM 609.5.
19. ITEM 562.1, SILICONE JOINT SEALANT (F), SHALL BE PLACED AS SHOWN ON THE BRIDGE EXPANSION JOINT SHEETS. A 1/2"x 1/2" STRIP SHALL ALSO BE PLACED IN THE JOINT BETWEEN THE WINGS AND PILASTERS. REMOVAL OF ANY EXISTING SEALANT AND CLEANING OF THE JOINT IS SUBSIDIARY TO ITEM 562.1.
20. JACKING SHALL BE REQUIRED TO REMOVE AND REPLACE BRIDGE SHOES AS OUTLINED IN THE PLANS AND SPECIAL PROVISIONS. THE PROPOSED JACKING METHOD SHALL BE SUBMITTED TO THE ENGINEER FOR DOCUMENTATION. THE MAXIMUM ALLOWABLE DIFFERENCE BETWEEN ADJACENT JACKING POINTS SHALL BE 1/4". THE MAXIMUM AMOUNT THAT THE GIRDERS MAY BE JACKED (MEASURED AT THE BEARINGS) SHALL BE 1 1/4". TEMPORARY SHIMS OR BLOCKS SHALL BE PLACED BENEATH GIRDER FLANGES DURING THE TIME THAT JACKS ARE SUPPORTING THE LOADS. ALL COSTS SHALL BE INCLUDED IN ITEM 550.191, TEMPORARY GIRDER SUPPORT SYSTEM. ALL BEARINGS SHALL BE REPLACED IN ONE JACKING OPERATION AND NOT ACCORDING TO THE PHASED CONSTRUCTION SHOWN ON THE PLANS.
21. EROSION HOLE AND CATCH BASIN LOCATED ALONG NE APPROACH RAIL SHALL BE REPAIRED UNDER ITEM 604.4, RECONSTRUCTING/ADJUSTING CATCH BASIN & DROP INLET. EXCAVATION AND BACKFILL SHALL CONFORM TO 206.3 AND SHALL BE SUBSIDIARY TO ITEM 604.4.
22. ITEM 604.0007, POLYETHYLENE LINER, SHALL BE INSTALLED IN ALL CATCH BASINS LOCATED WITHIN THE PAVING LIMITS.
23. ITEM 606.691, HANDRAIL REPAIR, SHALL BE USED TO REPAIR THE HANDRAIL ALONG THE STAIRS AT THE NW WING. ACCORDING TO EXISTING BRIDGE PLANS, THE HANDRAIL SHALL BE 1 1/2" I.P.S. SCHED. 80 ALUMINUM TUBING (ALL CONNECTIONS SHALL BE WELDED). ALL DIMENSIONS AND BENDS SHALL BE MEASURED IN THE FIELD FOR PROPER FIT.
24. PRIOR TO BEGINNING CONSTRUCTION, THE CONTRACTOR SHALL MAKE A RECORD OF THE EXISTING PAINT PAVEMENT MARKINGS. UPON COMPLETION OF THE BRIDGE WORK, THE PAVEMENT MARKINGS SHALL BE REPLACED IN KIND AS SHOWN ON BRIDGE SHEET XX.
25. ITEM 403.99, TEMPORARY BITUMINOUS PAVEMENT, SHALL BE PLACED TO TRANSITION FROM THE DECK ARMORING TO THE BASE COURSE ON THE DECK DURING PHASED CONSTRUCTION AS REQUIRED. THE TEMPORARY PAVEMENT SHALL BE REMOVED PRIOR TO THE PLACEMENT OF FINAL ROADWAY WEARING COURSE (ALL COSTS FOR REMOVAL SHALL BE SUBSIDIARY TO ITEM 403.99).
26. ITEMS 646.31 AND 647.1 SHALL BE USED TO REPAIR DISTURBED AREAS AS DIRECTED BY THE ENGINEER.
27. ITEM 538.2, BARRIER MEMBRANE, PEEL AND STICK - VERTICAL SURFACES (F), SHALL BE PLACED OVER THE BACKWALL RECONSTRUCTION JOINTS AS OUTLINED IN THE PLANS.
28. EXISTING ABUTMENTS, WINGWALLS, AND PIERS SHALL BE INSPECTED FOR DETERIORATED CONCRETE JOINTLY BY THE CONTRACT ADMINISTRATOR AND CONTRACTOR. ALL DETERIORATED CONCRETE SHALL BE REMOVED. CONCRETE SURFACES OF THE REMOVAL LIMITS SHALL BE SAWCUT TO 1" DEPTH TO PROVIDE CLEAN REMOVAL LINES. ALL INSPECTION, REMOVAL, AND CLEANING SHALL BE AS SPECIFIED IN SECTION 512 AND PAID FOR UNDER ITEM 512.0201. NEW CONCRETE PLACED IN THESE AREAS SHALL BE PAID UNDER ITEM 520.0201.
29. NO STRUCTURAL REPAIRS ARE ANTICIPATED. STRUCTURAL STEEL SHALL BE INSPECTED FOR STRUCTURAL DEFICIENCIES (e.g. SIGNIFICANT STEEL LOSS, CRACKS, MISSING BOLTS, ETC.) JOINTLY BY THE CONTRACT ADMINISTRATOR AND CONTRACTOR. ANY REPAIRS REQUIRED BY THE DEPARTMENT SHALL BE PERFORMED BY THE CONTRACTOR AND PAID UNDER ITEM 1002.1, REPAIRS OR REPLACEMENTS AS NEEDED - BRIDGE STRUCTURES.
30. PRIOR TO PLACING NEW CONCRETE AGAINST EXISTING CONCRETE SURFACES, THE EXISTING CONCRETE SURFACES SHALL BE BLAST CLEANED AND PREPARED TO A SATURATED SURFACE-DRY CONDITION. ALL COSTS SHALL BE SUBSIDIARY TO THE CONCRETE ITEM TO BE PLACED.
31. ADA COMPLIANT TIP-DOWNS SHALL BE CONSTRUCTED AT THE CORNERS OF ROSEDALE STREET AND ACROSS MAIN STREET AS SHOWN IN THE PLANS.

UTILITY NOTES

1. THE FOLLOWING UTILITIES ARE CARRIED ACROSS THE BRIDGE:
 - ELECTRICAL CONDUIT
 - WATER MAIN

SUMMARY OF QUANTITIES


ITEM NO.	ITEM DESCRIPTION	QUANTITY	UNIT
202.7	REMOVAL OF GUARDRAIL	121.13	LF
203.1	COMMON EXCAVATION	106.6	CY
203.55261	INSTALLATION AND REMOVAL OF SWZ-PORTABLE QUEUE TRAILER PLATFORM	2.0	U
203.55551	GUARDRAIL 25' EAGRT PLATFORM ALTERNATE	2.0	U
206.19	COMMON STRUCTURE EXCAVATION-EXPLORATORY	5.0	CY
304.201	GRAVEL	54.4	CY
304.3	CRUSHED GRAVEL (F)	1019.2	CY
403.1109	HOT BITUMINOUS PAVEMENT, MACHINE METHOD, HIGH STRENGTH	735.19	63 T
403.12	HOT BITUMINOUS PAVEMENT, HAND METHOD	829.5	T
403.6	PAVEMENT JOINT ADHESIVE	13200.41	43 LF
403.911	HOT BITUMINOUS BRIDGE PAVEMENT, 1" BASE COURSE	146.163	12 T
403.99	TEMPORARY BITUMINOUS PAVEMENT	17.01	T
417.	COLD PLANING BITUMINOUS SURFACES	6100.63	2 SY
502.	REMOVAL OF EXISTING BRIDGE STRUCTURE	1	U
504.1	COMMON BRIDGE EXCAVATION (F)	13	CY
511.02	PREPARATION FOR PARTIAL DEPTH CONCRETE BRIDGE DECK REPAIRS	130.256	83 SY
511.03	PREPARATION FOR FULL DEPTH CONCRETE BRIDGE DECK REPAIRS	80.616	SY
512.0201	PREPARATION FOR CONCRETE REPAIRS, CLASS II	106.16	SY
520.01	CONCRETE CLASS AA	1534.01	CY
520.0201	CONCRETE CLASS AA, ABOVE FOOTINGS	4230.35	CY
534.3	WATER REPELLENT (SILANE-SILOXANE)	10089.5	GAL
538.2	BARRIER MEMBRANE, PEEL AND STICK - VERTICAL SURFACES (F)	27	SY
538.6	BARRIER MEMBRANE, HEAT WELDED - MACHINE METHOD (F)	2541	SY
541.5	PVC WATERSTOPS, NH TYPE 5 (F)	80	LF
544.	REINFORCING STEEL (F)	1746	LB
544.11	REINFORCING STEEL - MECHANICAL CONNECTORS (F)	152	LB
550.191	TEMPORARY GIRDER SUPPORT SYSTEM	1	U
550.2	BRIDGE SHOES (F)	12	EA
561.2001	PREFABRICATED MODULAR BRIDGE JOINT SYSTEM (F)	43	43 LF
561.2002	PREFABRICATED MODULAR BRIDGE JOINT SYSTEM (F)	45	LF
562.1	SILICONE JOINT SEALANT (F)	119.182	LF
563.971	PROTECTIVE SCREENING FOR OVERPASS STRUCTURES RAIL F	88	LF
563.973	SNOW SCREENING FOR OVERPASS STRUCTURES RAIL F	88	96 LF
565.733	BRIDGE APPROACH RAIL F (3-BAR) (MODIFIED)	2	U
604.0007	POLYETHYLENE LINER	84	EA
604.4	RECONSTRUCTING/ADJUSTING CATCH BASIN & DROP INLET	2	LF
606.120	BEAM GUARDRAIL (STANDARD SECTION) (STEEL POST)	14	LF
606.1255	BEAM GUARDRAIL (TERM. UNIT TYPE EAGRT 25 FT.) (STEEL POST)	2	U
606.417	PORTABLE CONCRETE BARRIER FOR TRAFFIC CONTROL	4050	100 LF
606.691	REPAIR HANDRAIL	6	LF
606.9513	TEMP. IMPACT ATTENUATION DEVICE (REDIRECTIVE), TEST LEVEL 3	2	U
608.2401	4" CONCRETE SIDEWALK	1589.8	SY
608.54	DETECTABLE WARNING DEVICES, CAST IRON	12.6	SY
609.5	RESET GRANITE CURB	130	77 LF
609.55	RESET GRANITE CURB (BRIDGE)	40	15.3 LF
615.03	TRAFFIC SIGN TYPE C (F)	32	SF
615.06	TRAFFIC SIGN TYPE CC (F)	8	SF
616.161	TRAFFIC SIGNALS (TEMP)	1	U
616.191	ALTERATIONS TO TRAFFIC SIGNALS	1	U
616.192	ALTERATIONS TO TRAFFIC SIGNALS	10	7 U
618.61	UNIFORMED OFFICERS WITH VEHICLE	*	\$
618.7	FLAGGERS	1500	277 HR
619.1	MAINTENANCE OF TRAFFIC	1	U
619.25	PORTABLE CHANGEABLE MESSAGE SIGN	8	6 U
619.503	SMART WORK ZONE OPERATIONAL COST (SUMMER)	6	MON
619.51	PORTABLE QUEUE TRAILER/SENSOR (POT)	54	49.9 MON
619.52	PORTABLE CHANGEABLE MESSAGE SIGN (PCMS)	50	87.93 MON
619.91	RELOCATE SMART WORK ZONE DEVICE	1	0 U
621.31	SINGLE DELINEATOR WITH POST	1	0 EA
621.32	DOUBLE DELINEATOR WITH POST	1	0 EA
624.1	RAILROAD PROTECTION - FLAGGING SERVICE	220	431.5 HR
628.2	SAWED BITUMINOUS PAVEMENT	475	20 LF
628.22	SAWED BITUMINOUS PAVEMENT (BRIDGE)	80	LF
632.0104	RETROREFLECTIVE PAINT PAVE. MARKING, 4" LINE	18000	1923.7 F
632.0112	RETROREFLECTIVE PAINT PAVE. MARKING, 12" LINE	90	65 LF
632.02	RETROREFLECTIVE PAINT PAVEMENT MARKING, SYMBOL OR WORD	265	56.3 SF
632.3104	RETROREFLECT. THERMOPLAS. PAVE. MARKING, 4" LINE	360	274 LF
632.3106	RETROREFLECT. THERMOPLAS. PAVE. MARKING, 6" LINE	450	246 LF
632.3118	RETROREFLECT. THERMOPLAS. PAVE. MARKING, 18" LINE	90	114 LF
632.911	OBLITERATE PAVE. MARKING LINE, 12" WIDE & UNDER	3400	246 LF
632.92	OBLITERATE PAVEMENT MARKING, SYMBOL OR WORD	79	39.3 SF
645.531	SILT FENCE	50	0 LF
646.31	TURF ESTABLISHMENT WITH MULCH AND TACKIFIERS	60	0 SY
647.1	HUMUS	8	12 CY
670.104	TEMPORARY PORTABLE LIGHTING	2	U
670.95	TEMPORARY SAFETY FENCE	1450	855 LF
692.	MOBILIZATION	1	U
697.31	PROJECT OPERATIONS PLAN	1	U
698.13	FIELD OFFICE TYPE C	10	13 MON
699.	MISCELLANEOUS TEMPORARY EROSION AND SEDIMENT CONTROL	*	\$
1002.1	REPAIRS OR REPLACEMENTS AS NEEDED - BRIDGE STRUCTURES	*	\$
1008.211	ALTS. & ADDS. AS NEEDED - TEMP. TRAFFIC CONTROL (SIGNS & PAVE. MARKINGS)	*	\$
1009.32	REMOVAL AND DISPOSAL OF ASBESTOS CONTAINING MATERIAL (ACM)	*	\$
1010.15	FUEL ADJUSTMENT	*	\$

* NOT A BID ITEM


STATE OF NEW HAMPSHIRE											
DEPARTMENT OF TRANSPORTATION * BUREAU OF BRIDGE DESIGN											
TOWN	HOOKSETT										
BRIDGE NO.	080\148										
STATE PROJECT	28435										
LOCATION	MAIN STREET over B&M RR, MERRIMACK RIVER, & RIVERSIDE STREET										
NOTES AND QUANTITY BOX											BRIDGE SHEET
REVISED	DATE	BY	DATE	CHECKED	DATE	FILE NUMBER					
DESIGNED	JAT	6/14	6/14	SMG	8/14	2 OF 18					
DRAWN	SMG	6/14	6/14	JAT	8/14	126-1-1					
QUANTITIES	SMG	9/14	9/14	JAT	9/14	TOTAL SHEETS					
ISSUE DATE	FEDERAL PROJECT NO.			SHEET NO.		TOTAL SHEETS					
REV. DATE	-----			6		42					

As-Built Plans


SUBDIRECTORY	.DGN LOCATOR	SHEET SCALE
BRCL	28435 Notes	AS NOTED

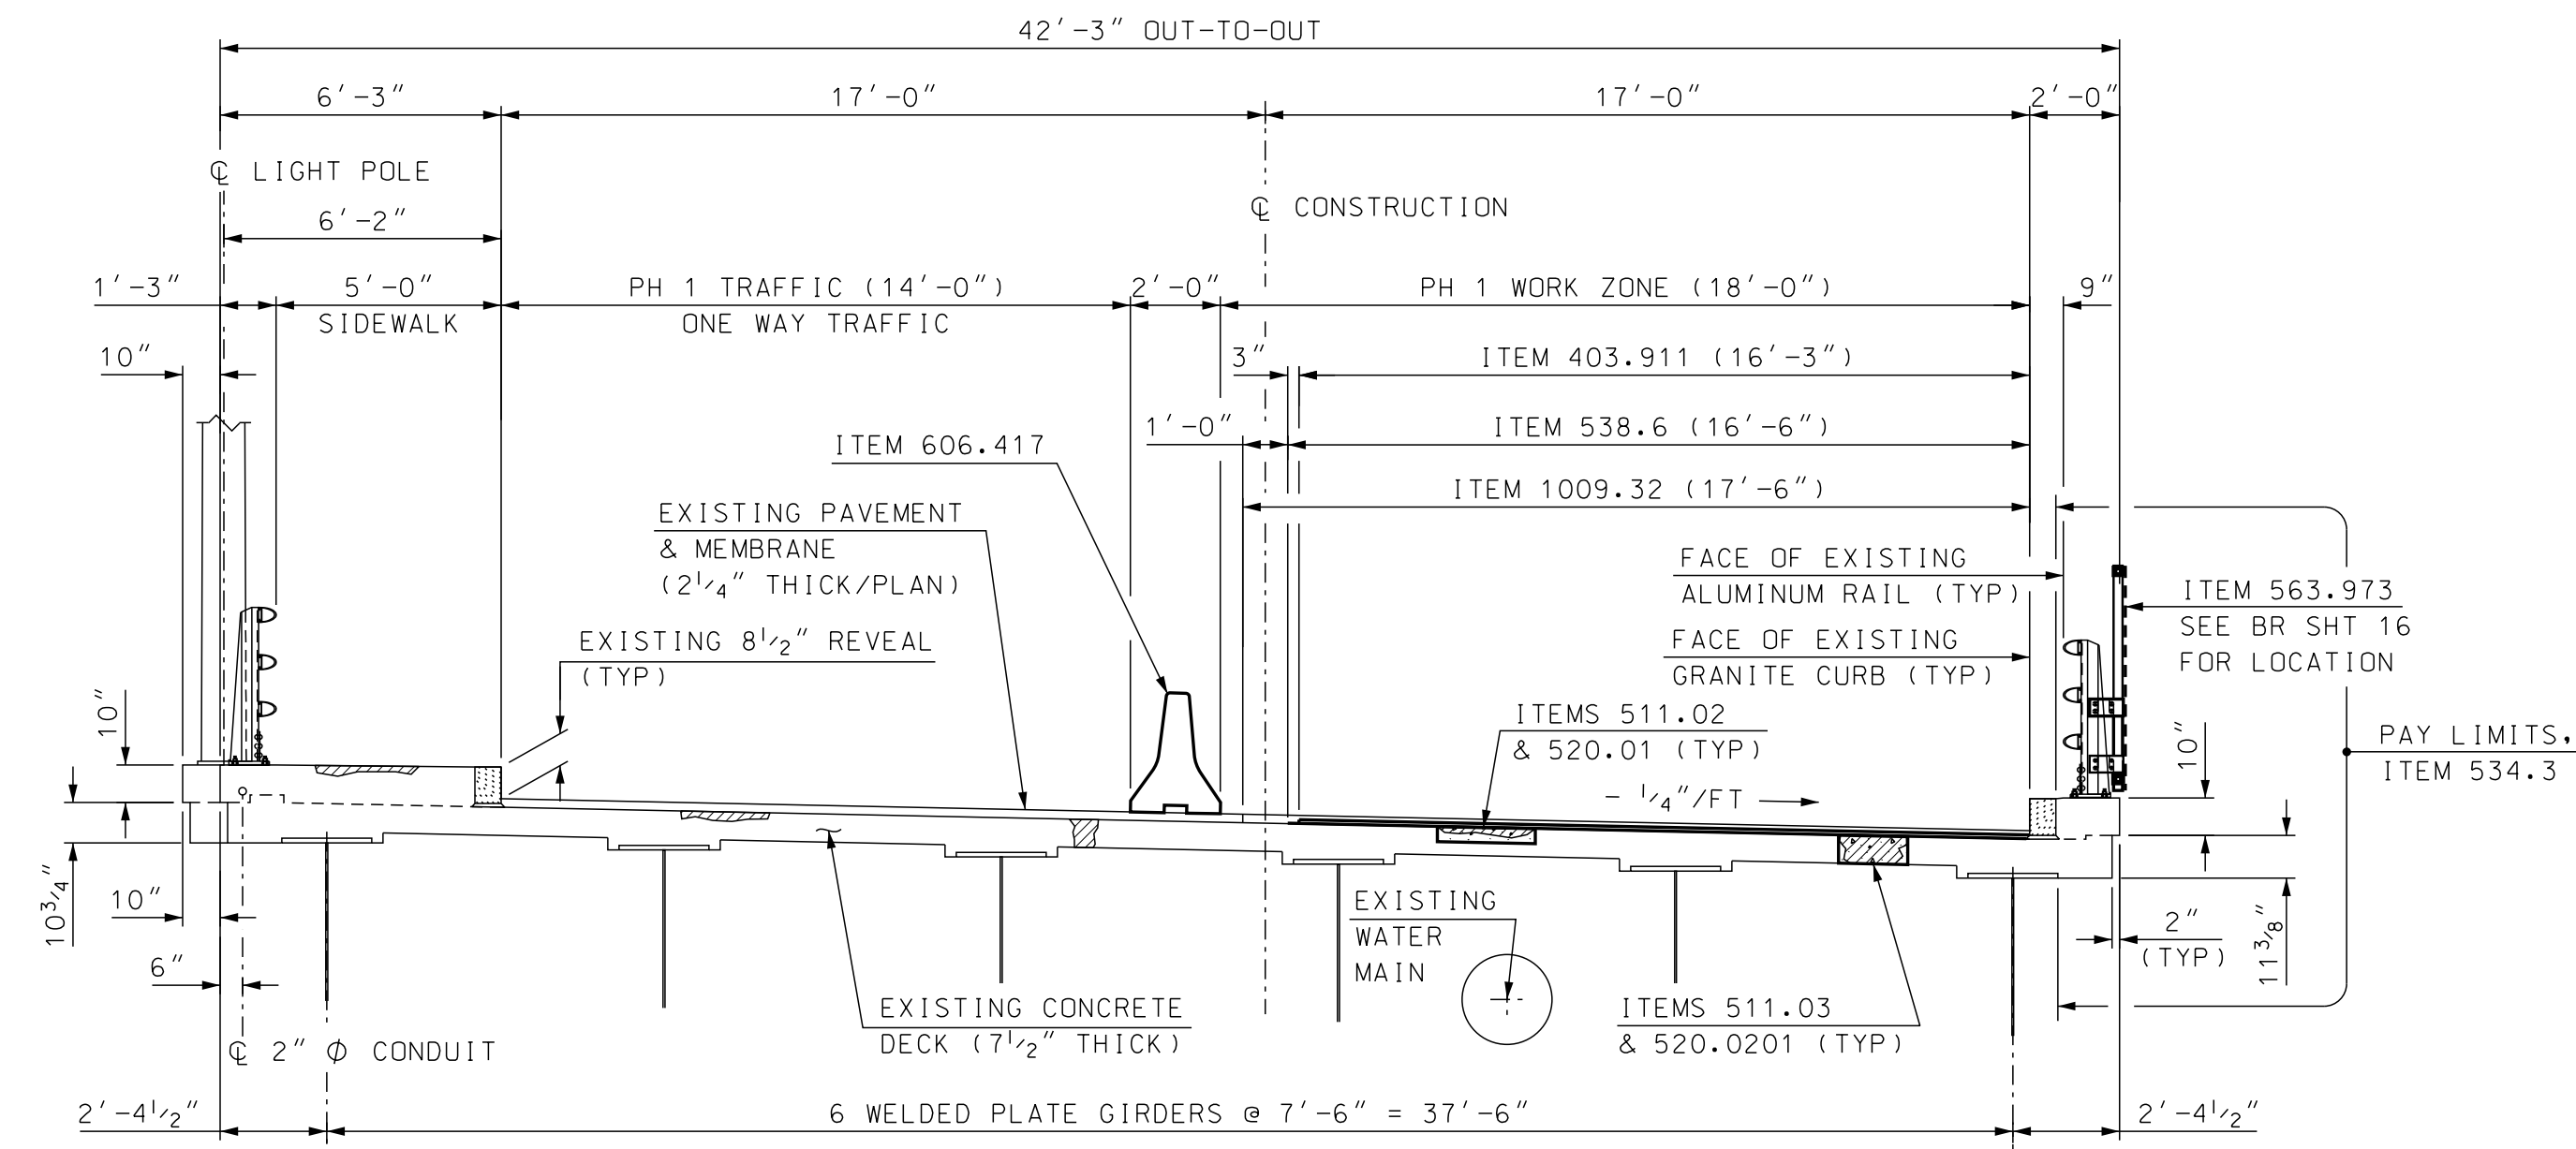


PHASE 1 CONSTRUCTION
SCALE: 1/4" = 1'-0"

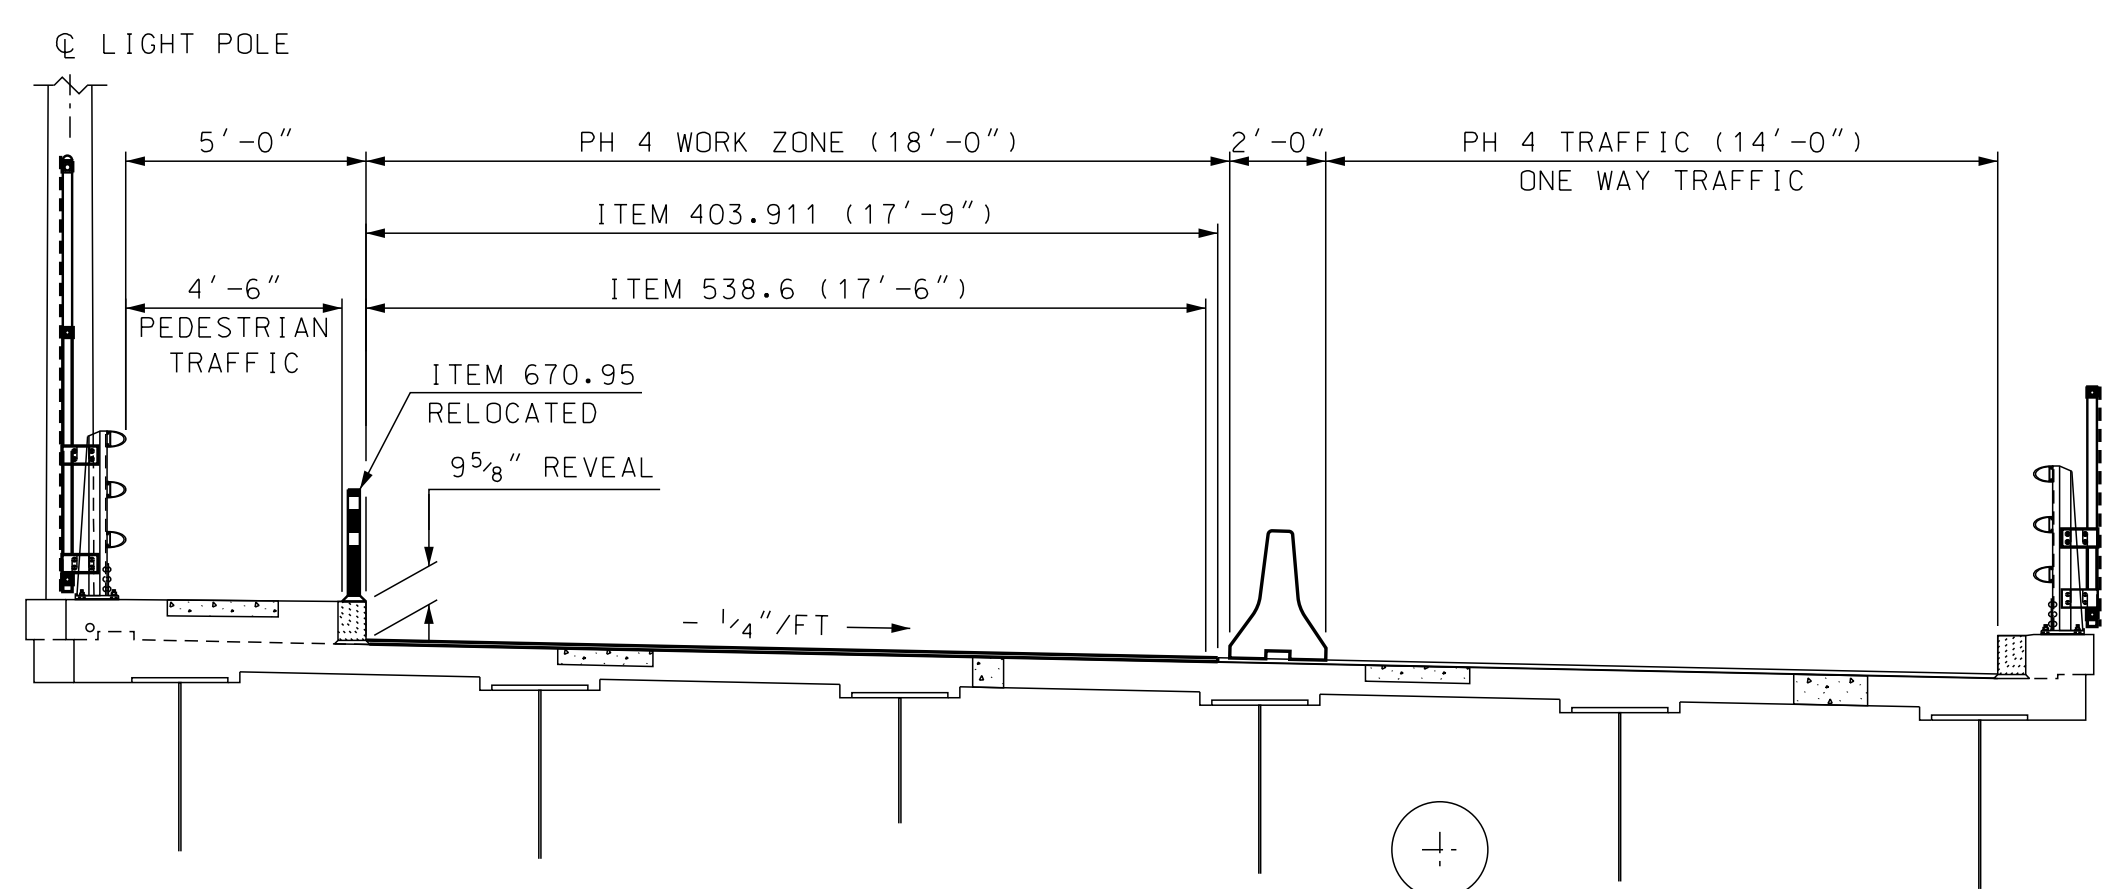

PHASE 4 CONSTRUCTION
SCALE: 1/4" = 1'-0"

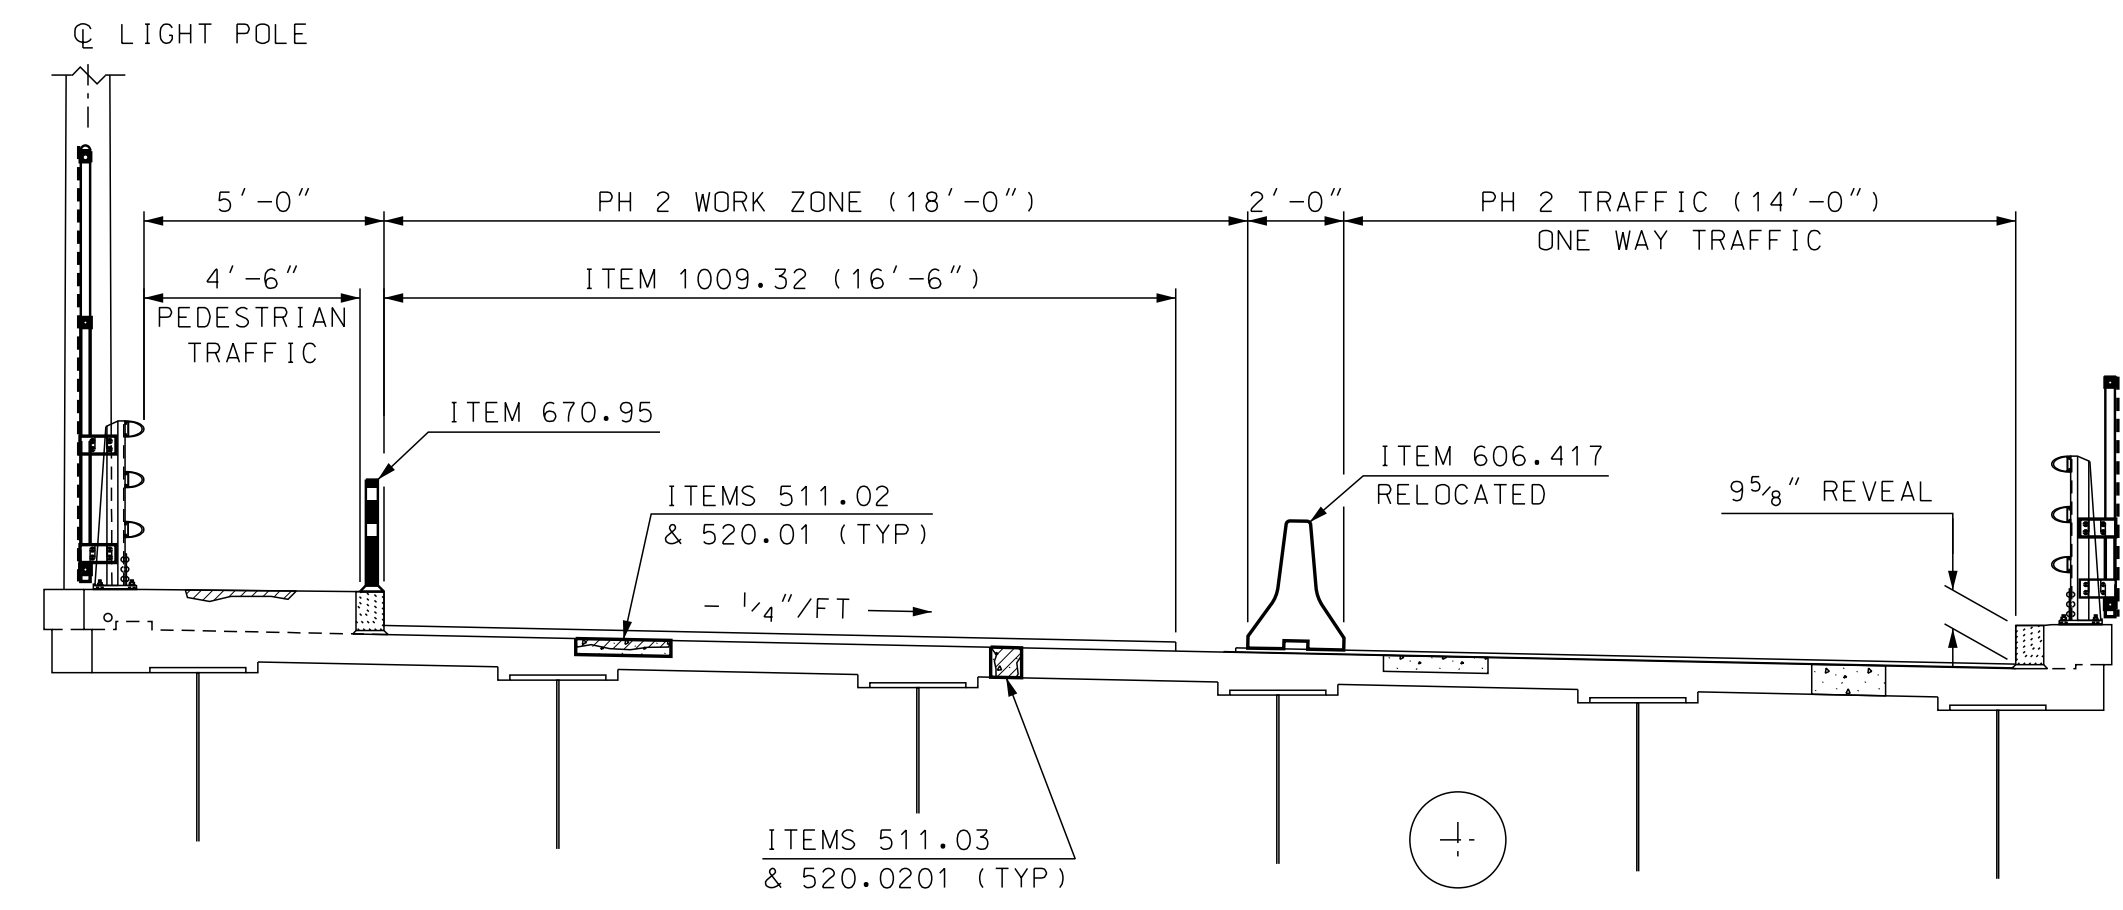


PHASE 2 CONSTRUCTION
SCALE: 1/4" = 1'-0"

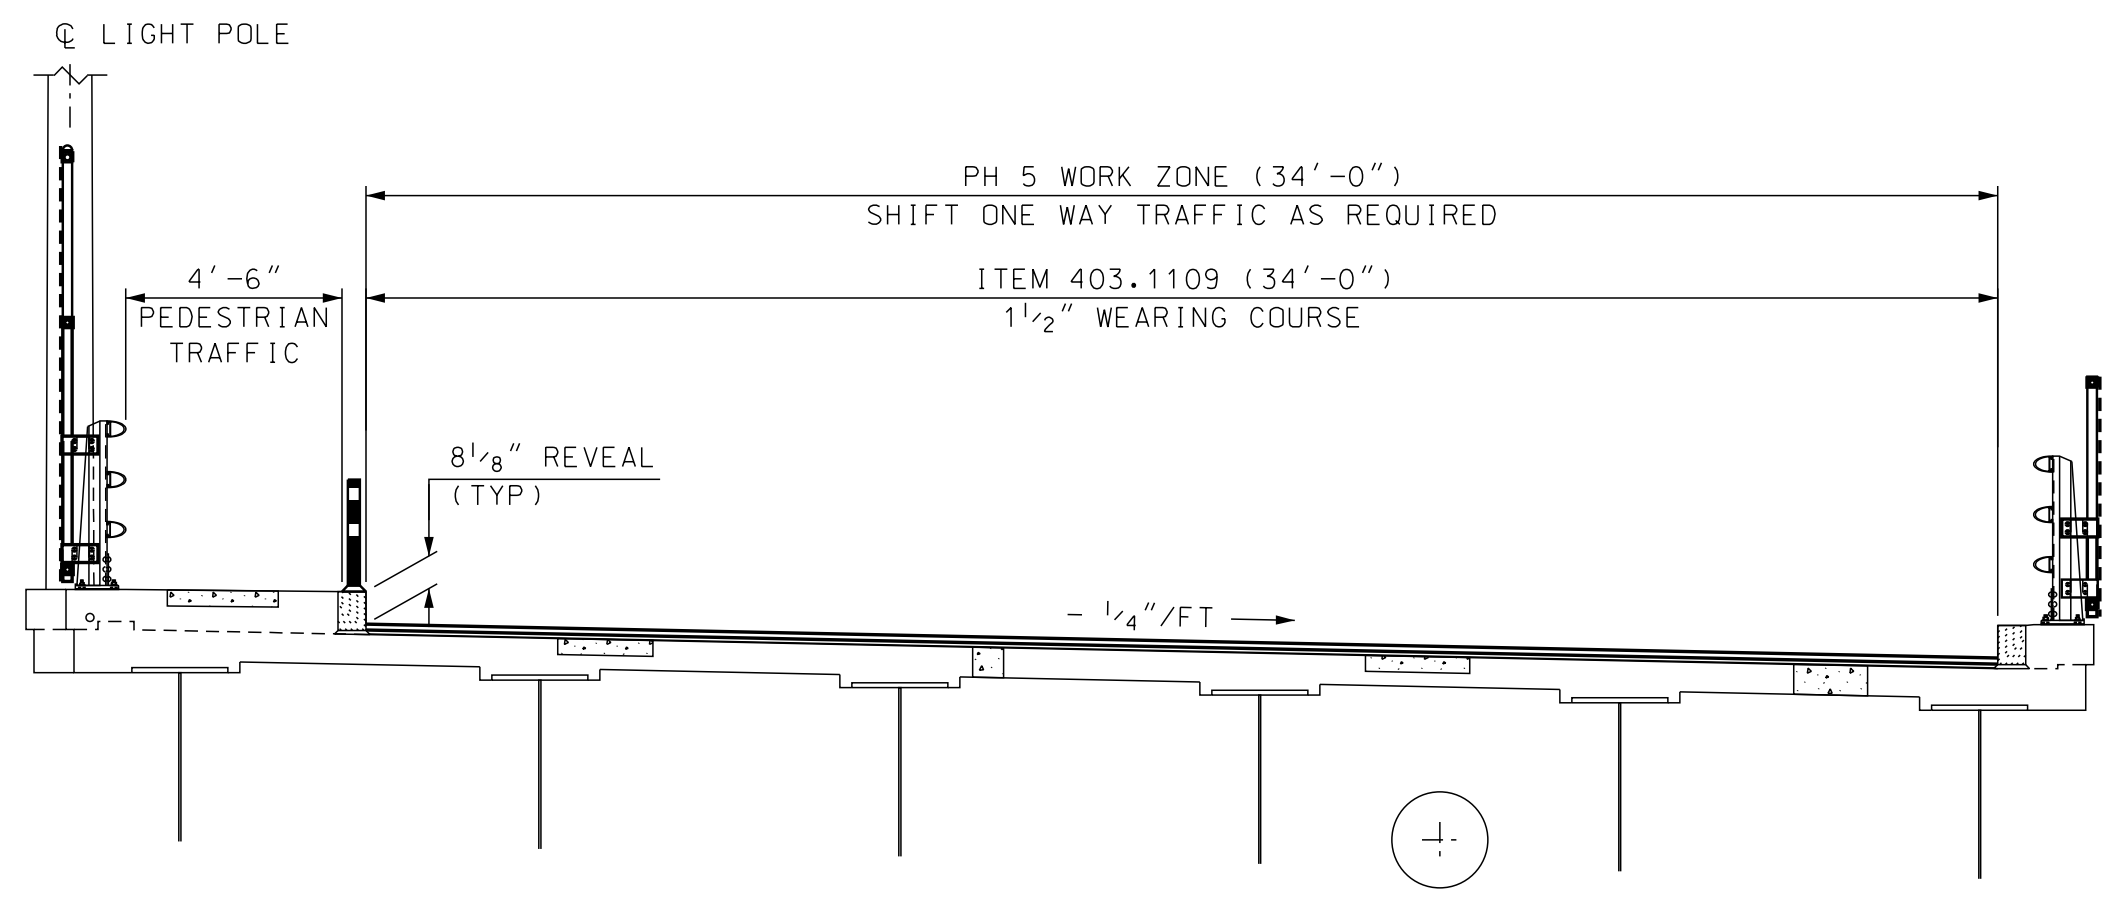


PHASE 5 CONSTRUCTION
SCALE: 1/4" = 1'-0"

NOTE:
ALL DIMENSIONS RADIAL
UNLESS NOTED OTHERWISE

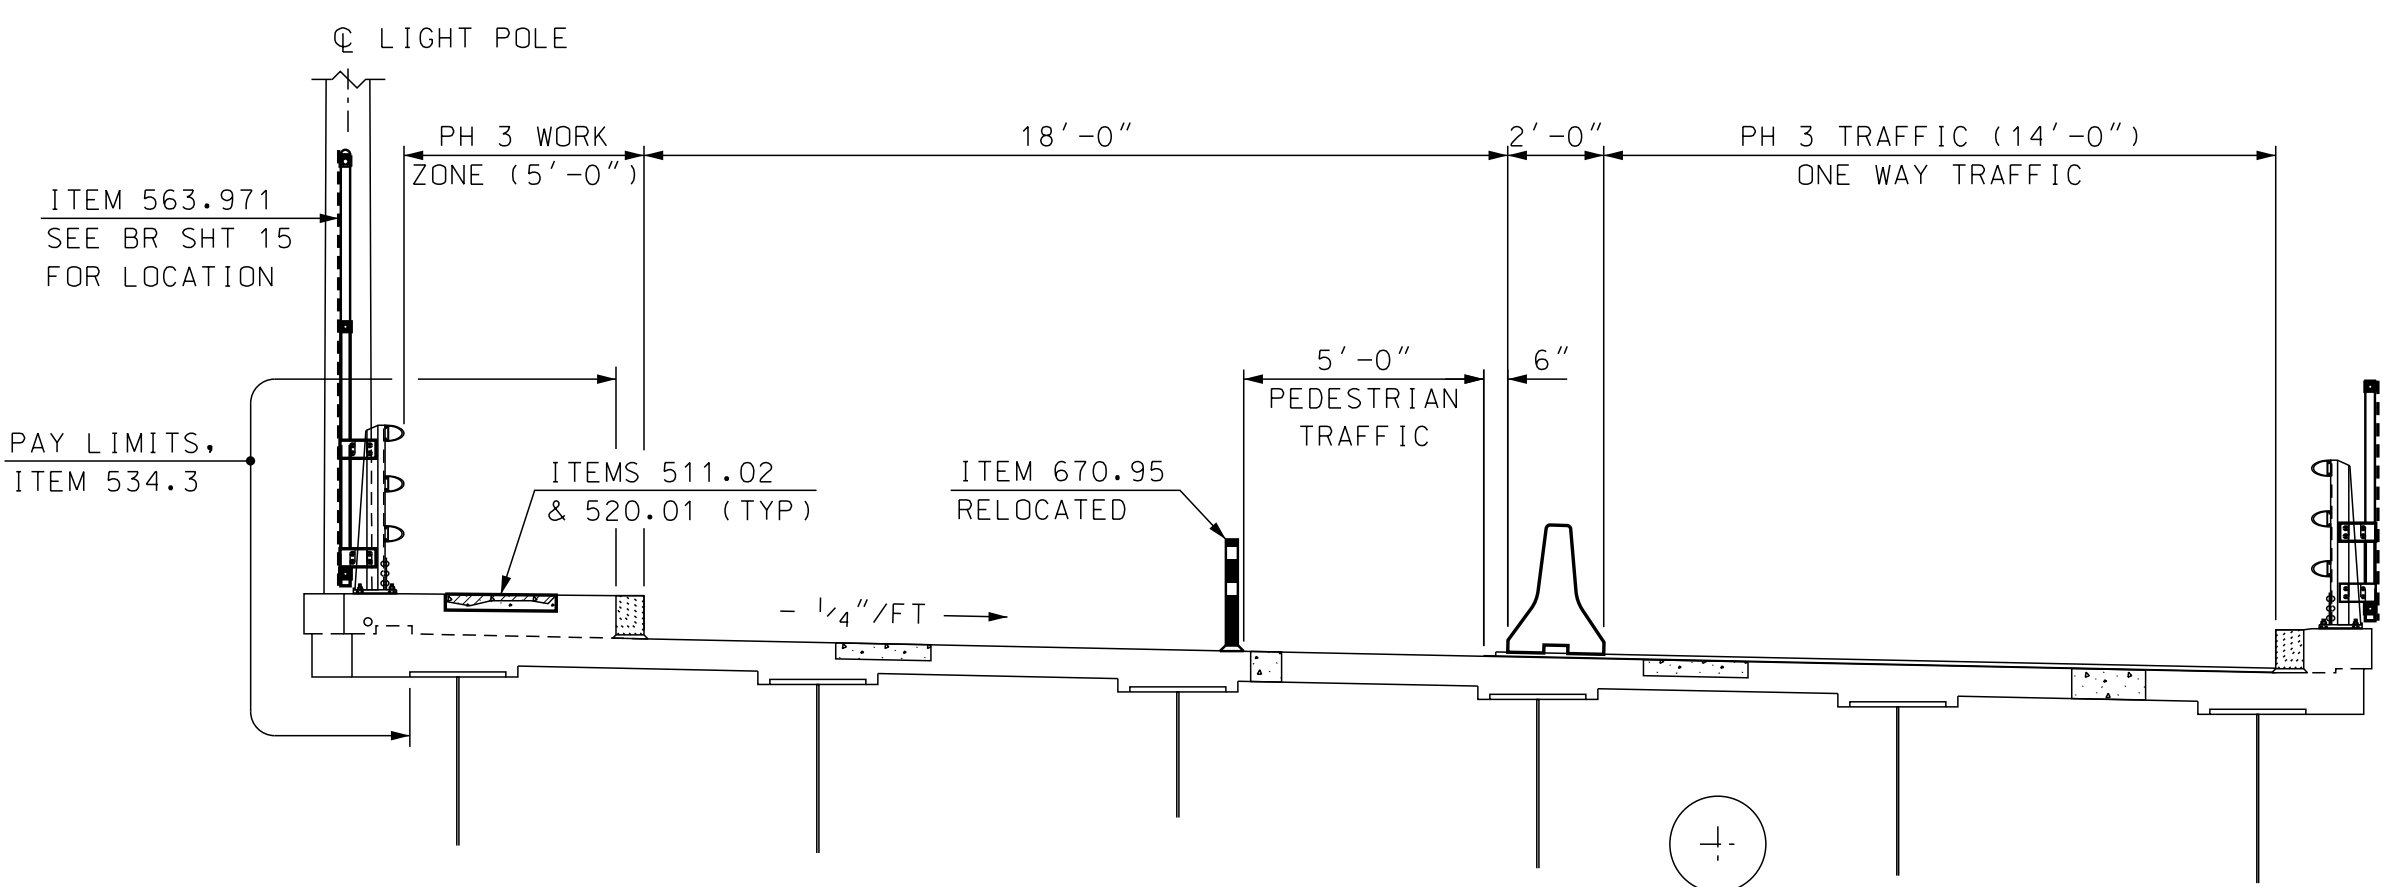


PHASE 3 CONSTRUCTION
SCALE: 1/4" = 1'-0"

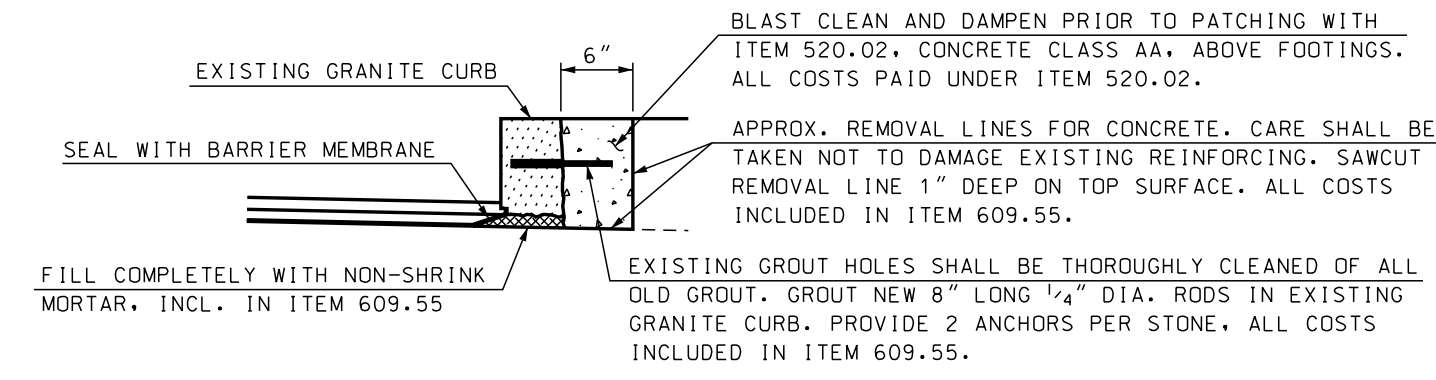

**** RESETTING GRANITE BRIDGE CURB DETAIL**
SCALE: 1" = 1'-0"


** WHERE EXISTING GRANITE BRIDGE CURB HAS PULLED AWAY FROM THE CONCRETE BRUSH CURB, THE GRANITE CURB SHALL BE REMOVED AND RESET AS DIRECTED BY THE ENGINEER. ALL COSTS INCLUDED IN ITEM 609.55, RESET GRANITE CURB (BRIDGE).

STATE OF NEW HAMPSHIRE DEPARTMENT OF TRANSPORTATION * BUREAU OF BRIDGE DESIGN									
TOWN	HOOKSETT	BRIDGE NO.	080/148	STATE PROJECT	28435				
LOCATION MAIN STREET over B&M RR, MERRIMACK RIVER, & RIVERSIDE STREET									
PHASING								BRIDGE SHEET	
REVISIONS AFTER PROPOSAL		BY	DATE	CHECKED	SMG	DATE	3 OF 18		
		JAT	5/14	JAT	8/14	FILE NUMBER			
		SMG	5/14	JAT	8/14	126-1-1			
		SMG	9/14	JAT	9/14	TOTAL SHEETS			
ISSUE DATE		FEDERAL PROJECT NO.			SHEET NO.		7		
REV. DATE		-----			7		42		
SUBDIRECTORY	DGN LOCATOR	SHEET SCALE							
BRC\	28435 Phasing	AS NOTED							

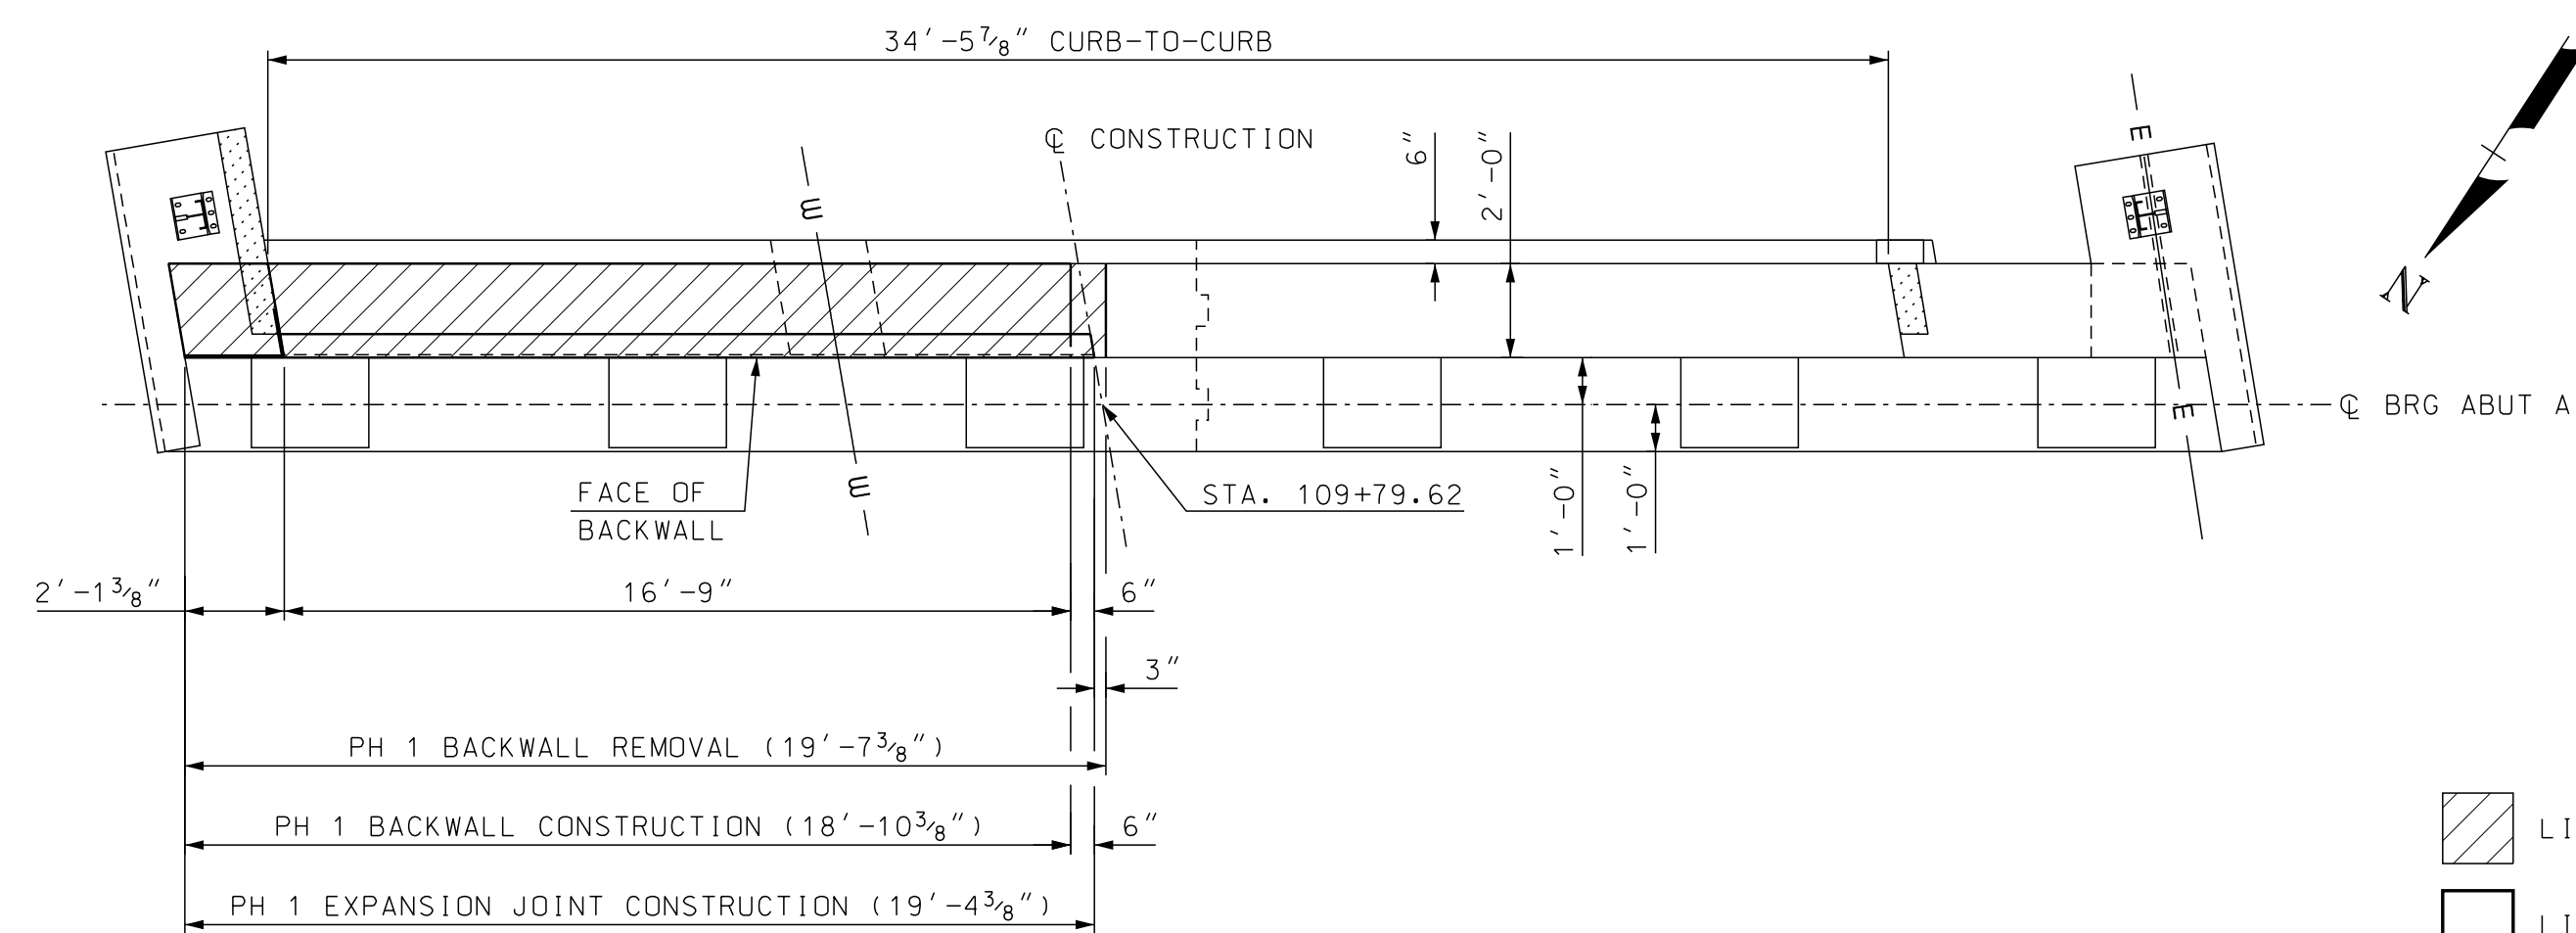


PHASE 1 PLAN

SCALE: 1/4" = 1'-0"

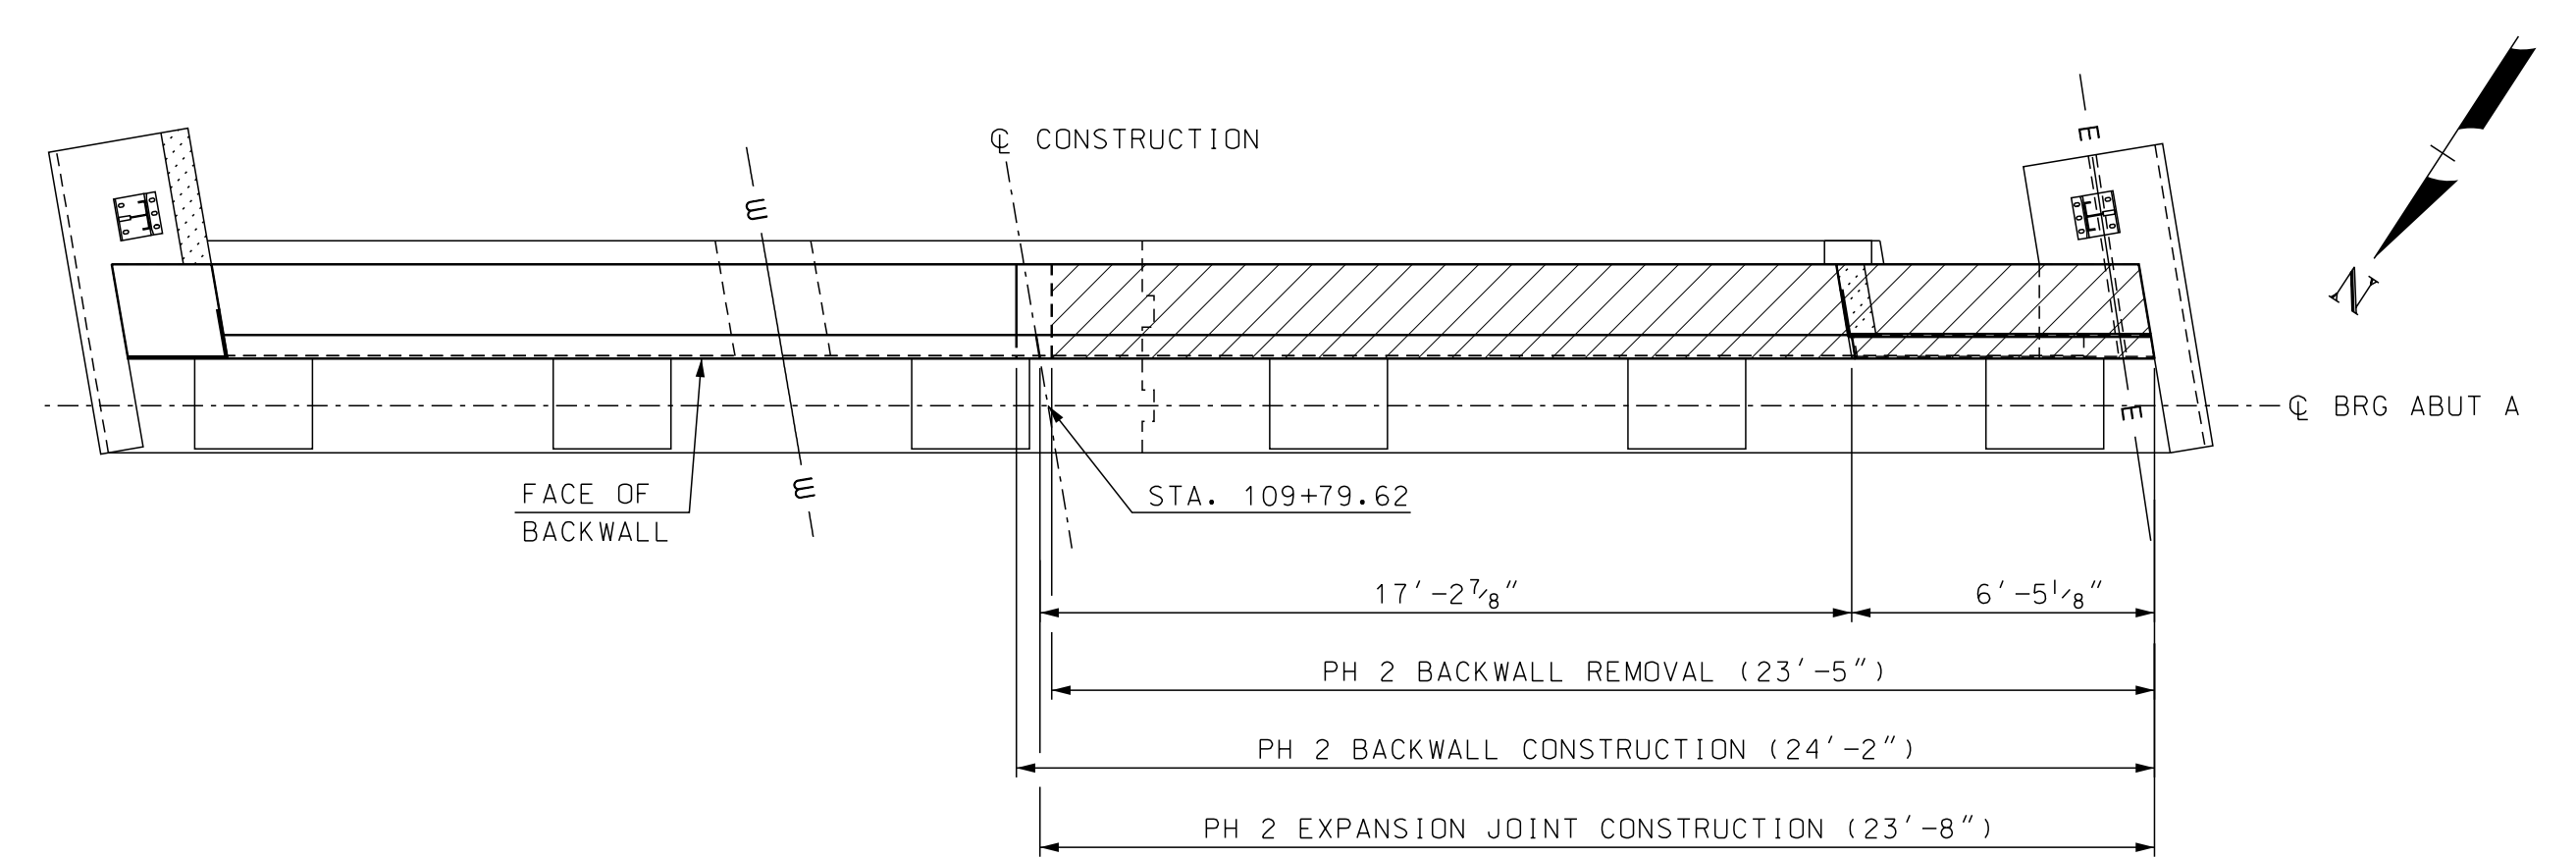


PHASE 2 PLAN

SCALE: 1/4" = 1'-0"

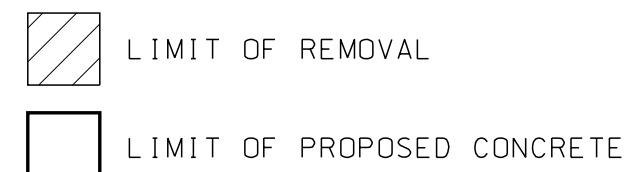

NOTES:


- SEE EXPANSION JOINT PLAN VIEW ON BRIDGE SHEET 6 AND SECTION A-A REMOVAL AND SECTION A-A CONSTRUCTION ON BRIDGE SHEET 7 FOR FURTHER DETAILS.
- DIMENSIONS ARE GIVEN FROM THE INTERSECTION OF @ CONSTRUCTION AND THE BACK OF BACKWALL.

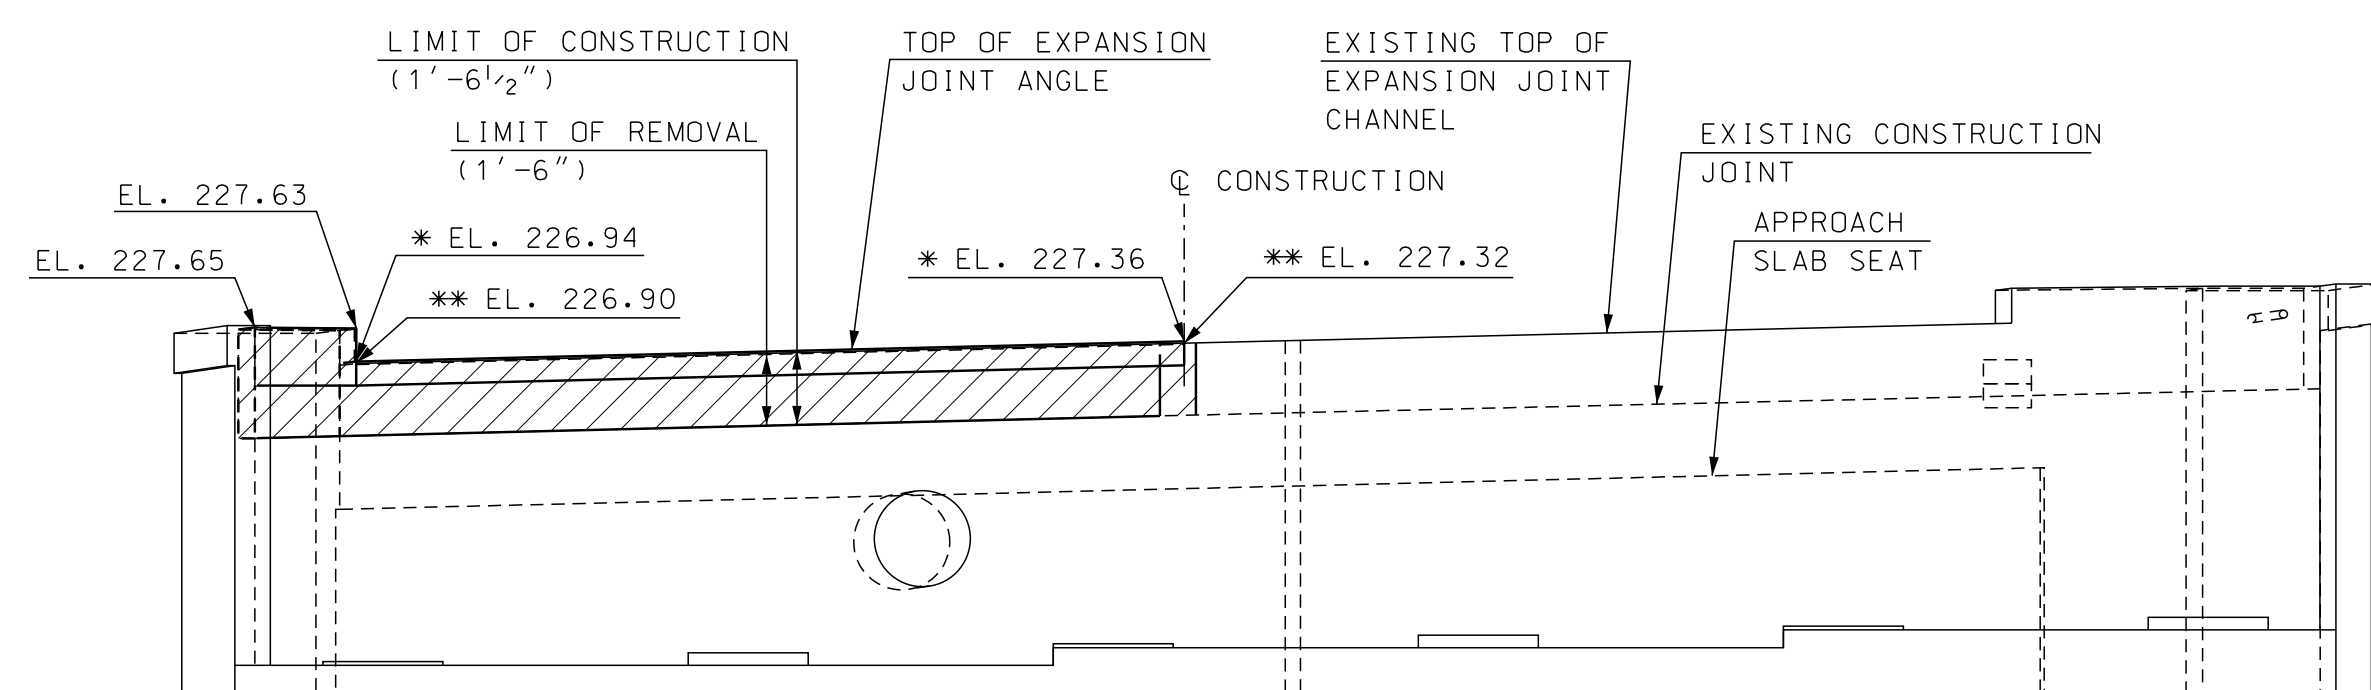

PHASE 1 ELEVATION

SCALE: 1/4" = 1'-0"


EL. XXX.XX = EXISTING AND PROPOSED ELEVATION
 * EL. XXX.XX = PROPOSED ELEVATION AT TOP OF EXPANSION JOINT ANGLE
 ** EL. XXX.XX = EXISTING ELEVATION AT TOP OF EXPANSION JOINT CHANNEL

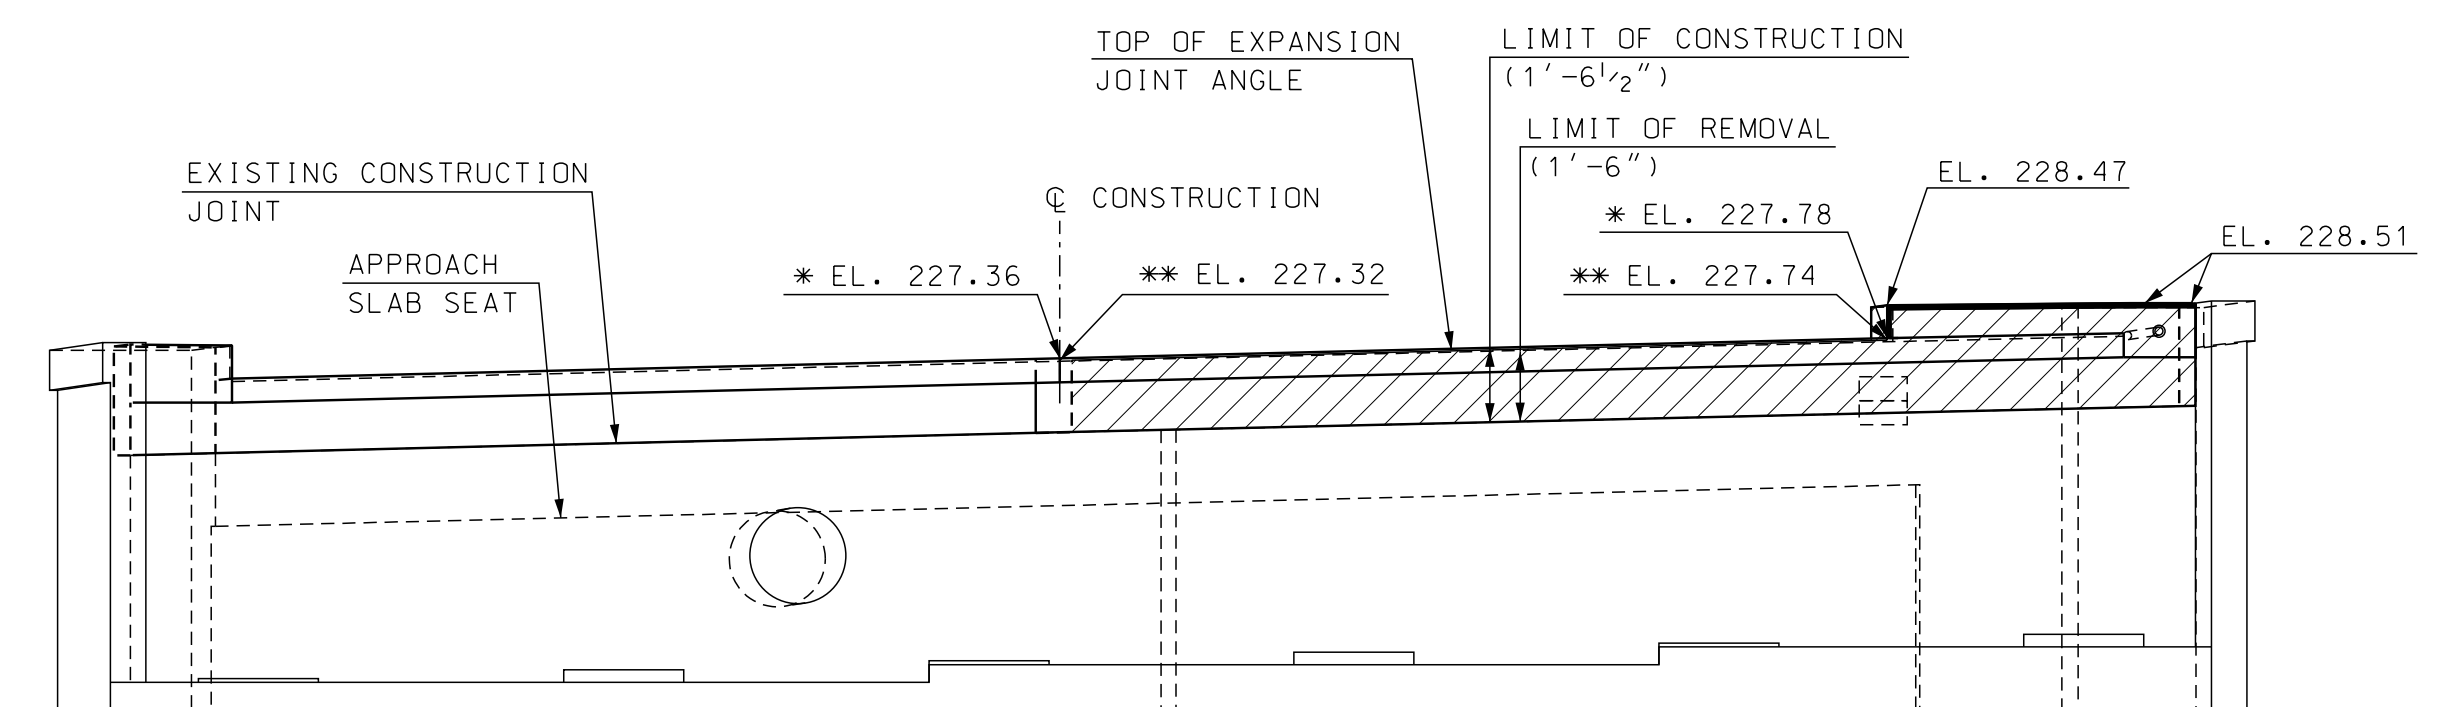

PHASE 2 ELEVATION


SCALE: 1/4" = 1'-0"

EL. XXX.XX = EXISTING AND PROPOSED ELEVATION
 * EL. XXX.XX = PROPOSED ELEVATION AT TOP OF EXPANSION JOINT ANGLE
 ** EL. XXX.XX = EXISTING ELEVATION AT TOP OF EXPANSION JOINT CHANNEL

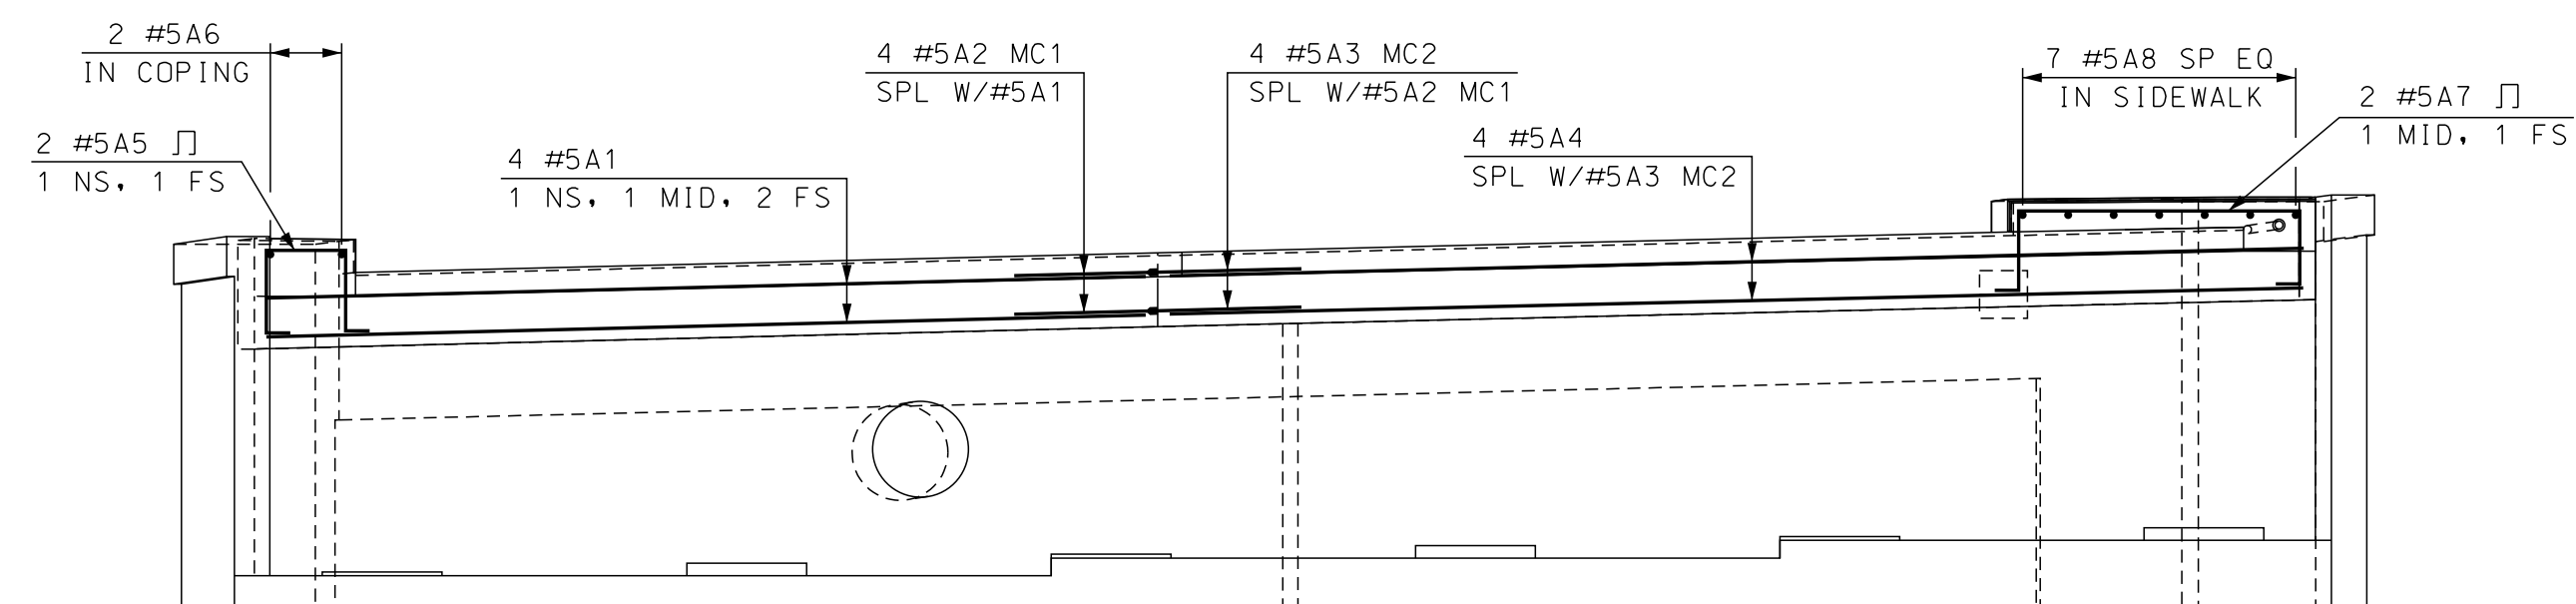


ABUTMENT A REINFORCEMENT ELEVATION

SCALE: 1/4" = 1'-0"

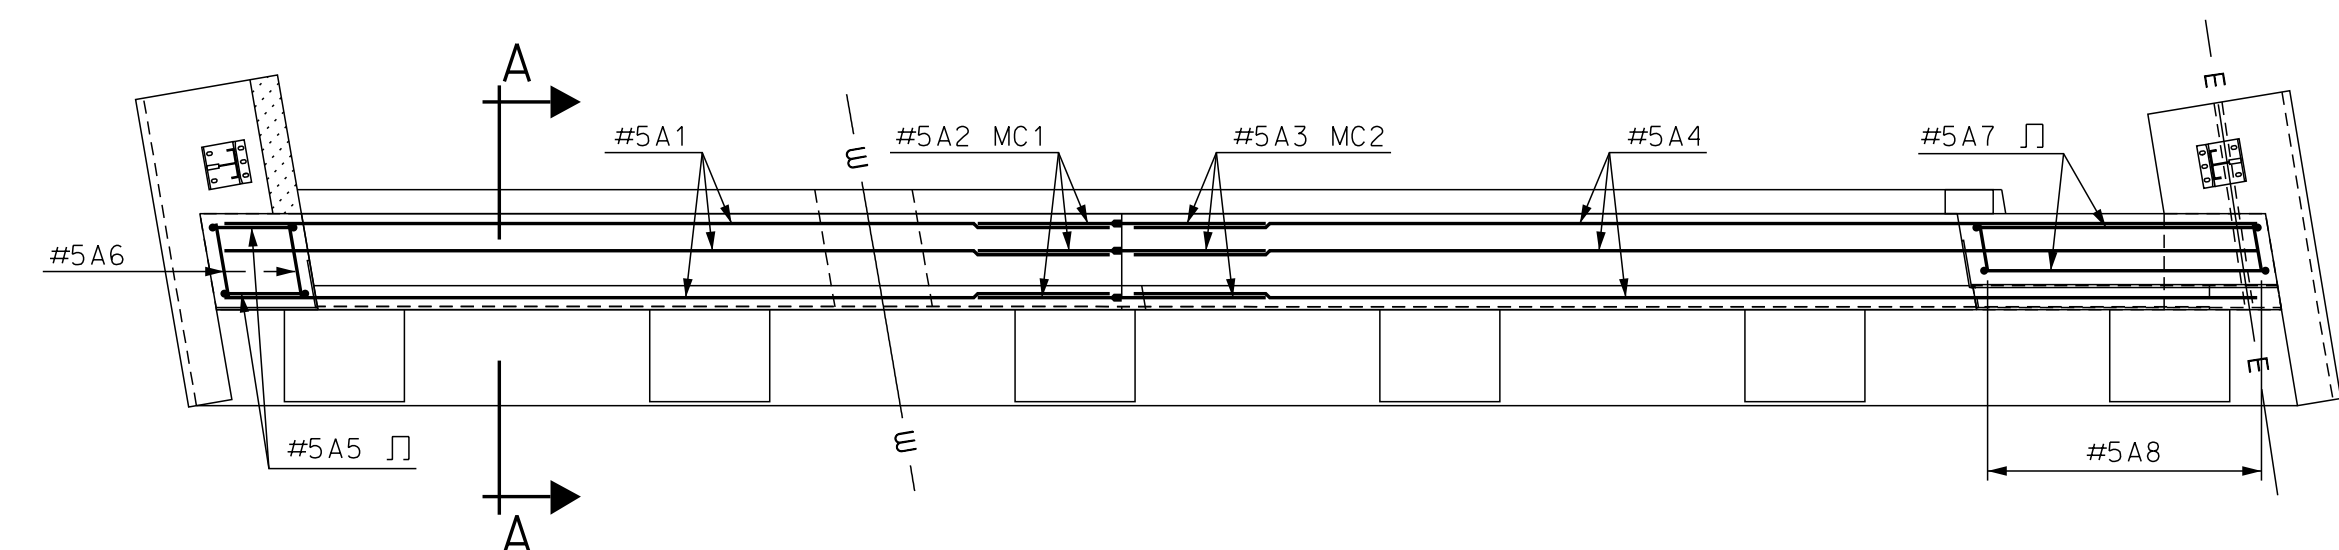

ABUTMENT A REINFORCEMENT PLAN

SCALE: 1/4" = 1'-0"

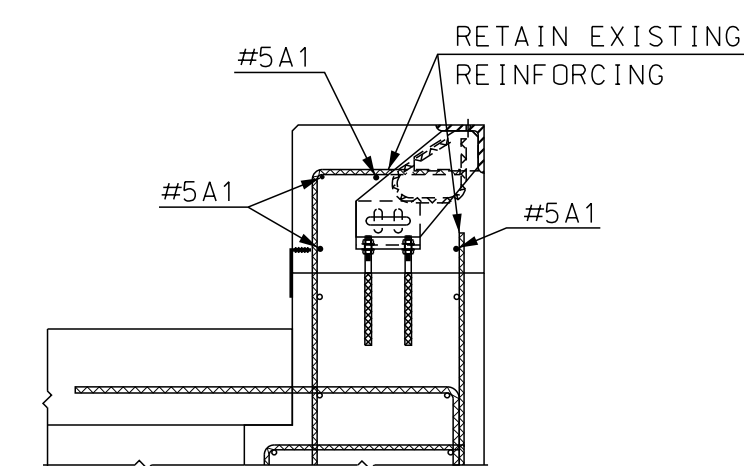


SECTION A-A

SCALE: 1/2" = 1'-0"


STATE OF NEW HAMPSHIRE					
DEPARTMENT OF TRANSPORTATION * BUREAU OF BRIDGE DESIGN					
TOWN	HOOKSETT	BRIDGE NO.	080/148	STATE PROJECT	28435
LOCATION MAIN STREET over B&M RR, MERRIMACK RIVER, & RIVERSIDE STREET					
ABUTMENT A PHASING					BRIDGE SHEET
REVISIONS AFTER PROPOSAL		BY	DATE	BY	DATE
		DESIGNED	JAT 6/14	CHECKED	SMG 8/14
		DRAWN	SMG 6/14	CHECKED	JAT 8/14
		QUANTITIES	SMG 9/14	CHECKED	JAT 9/14
ISSUE DATE		FEDERAL PROJECT NO.		SHEET NO.	TOTAL SHEETS
REV. DATE		-----		8	42

SUBDIRECTORY	DGN LOCATOR	SHEET SCALE
BRC\	28435 AbutA	AS NOTED

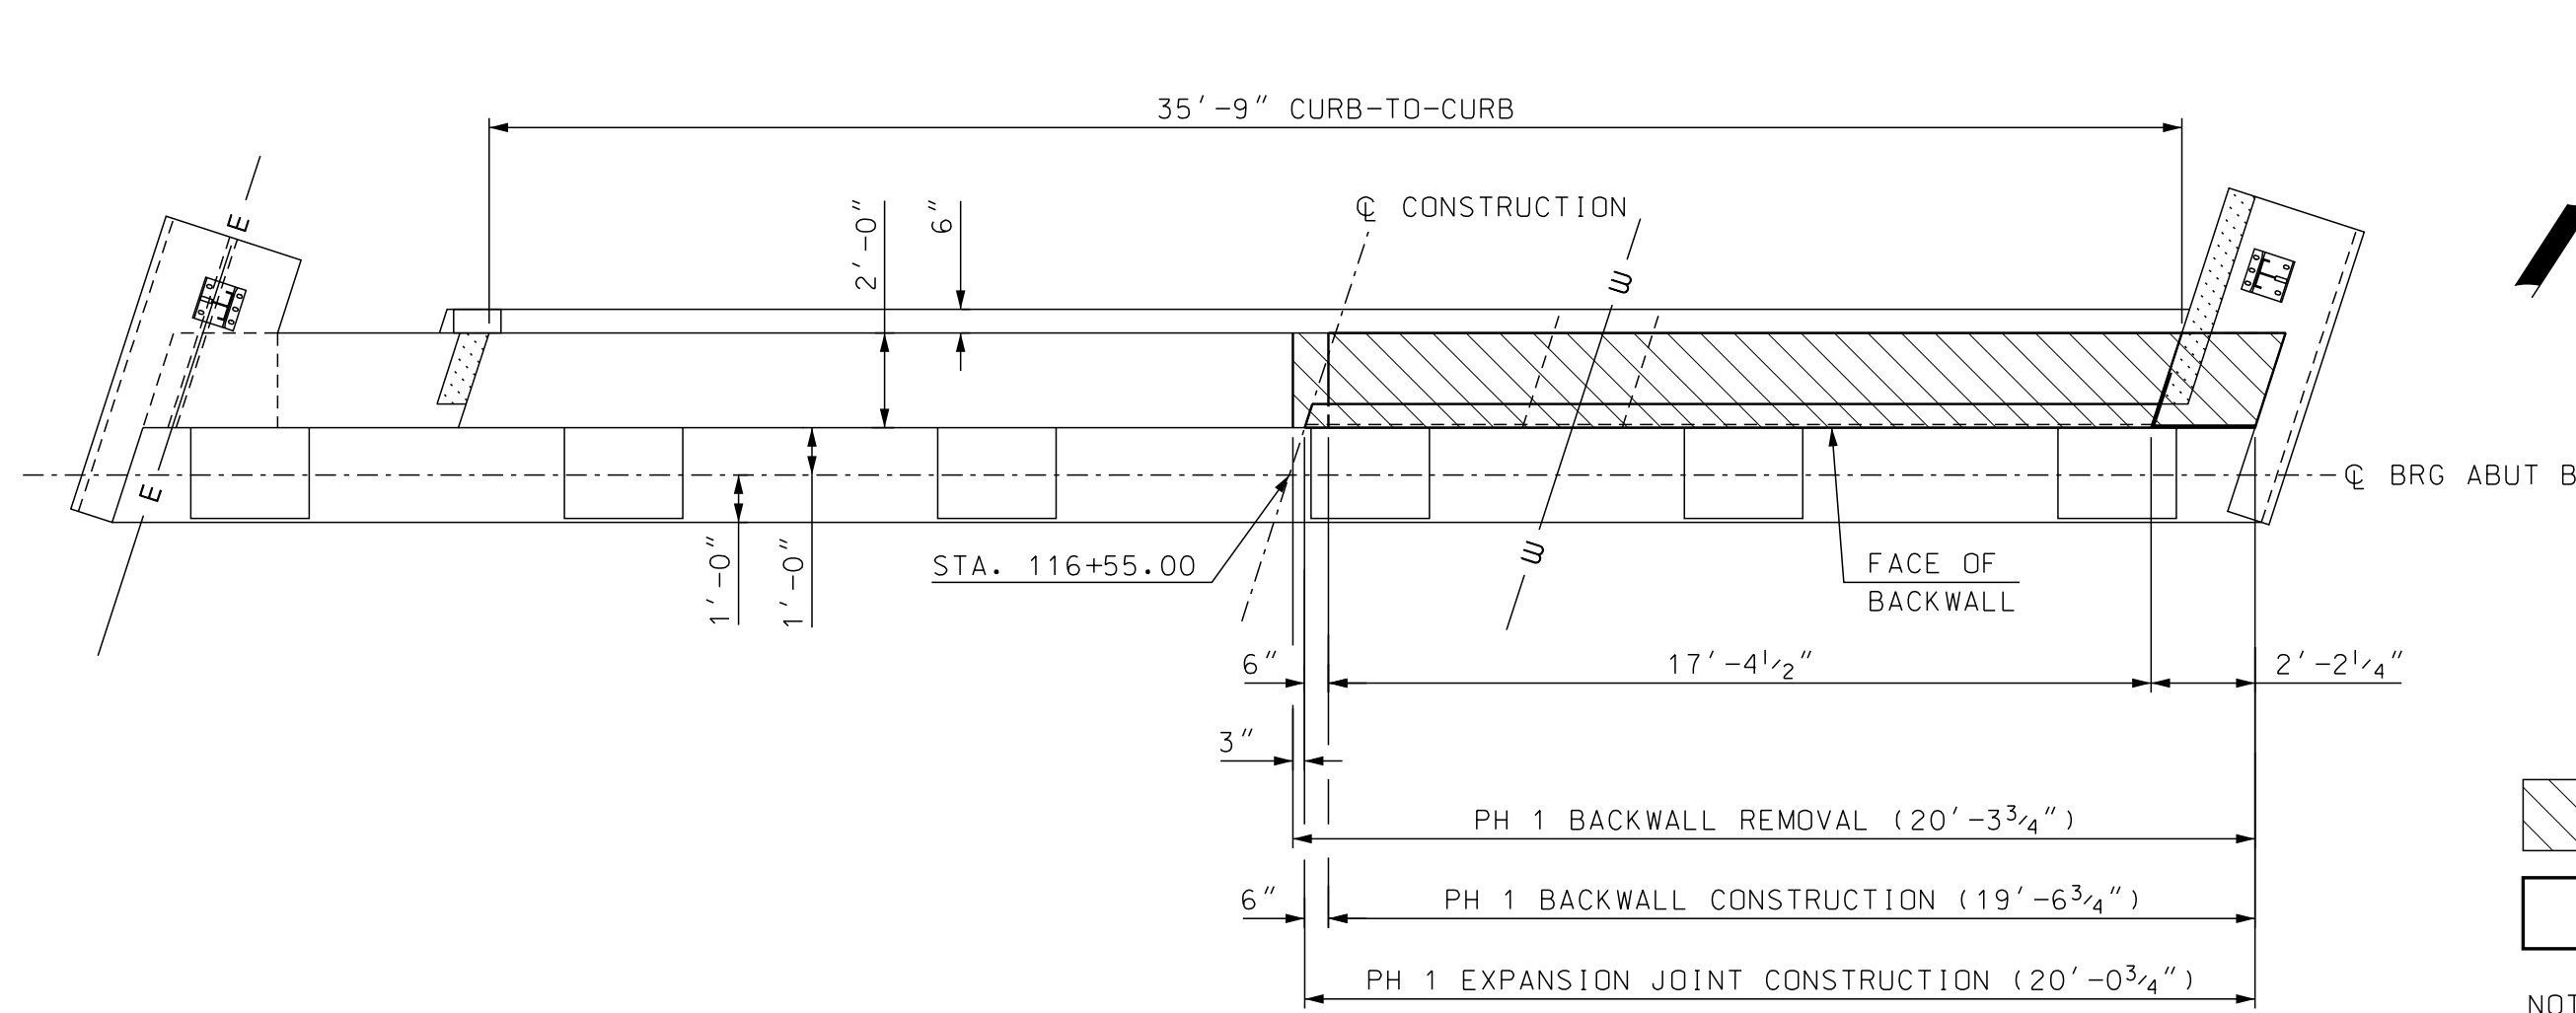

PHASE 1 PLAN

SCALE: 1/4" = 1'-0"

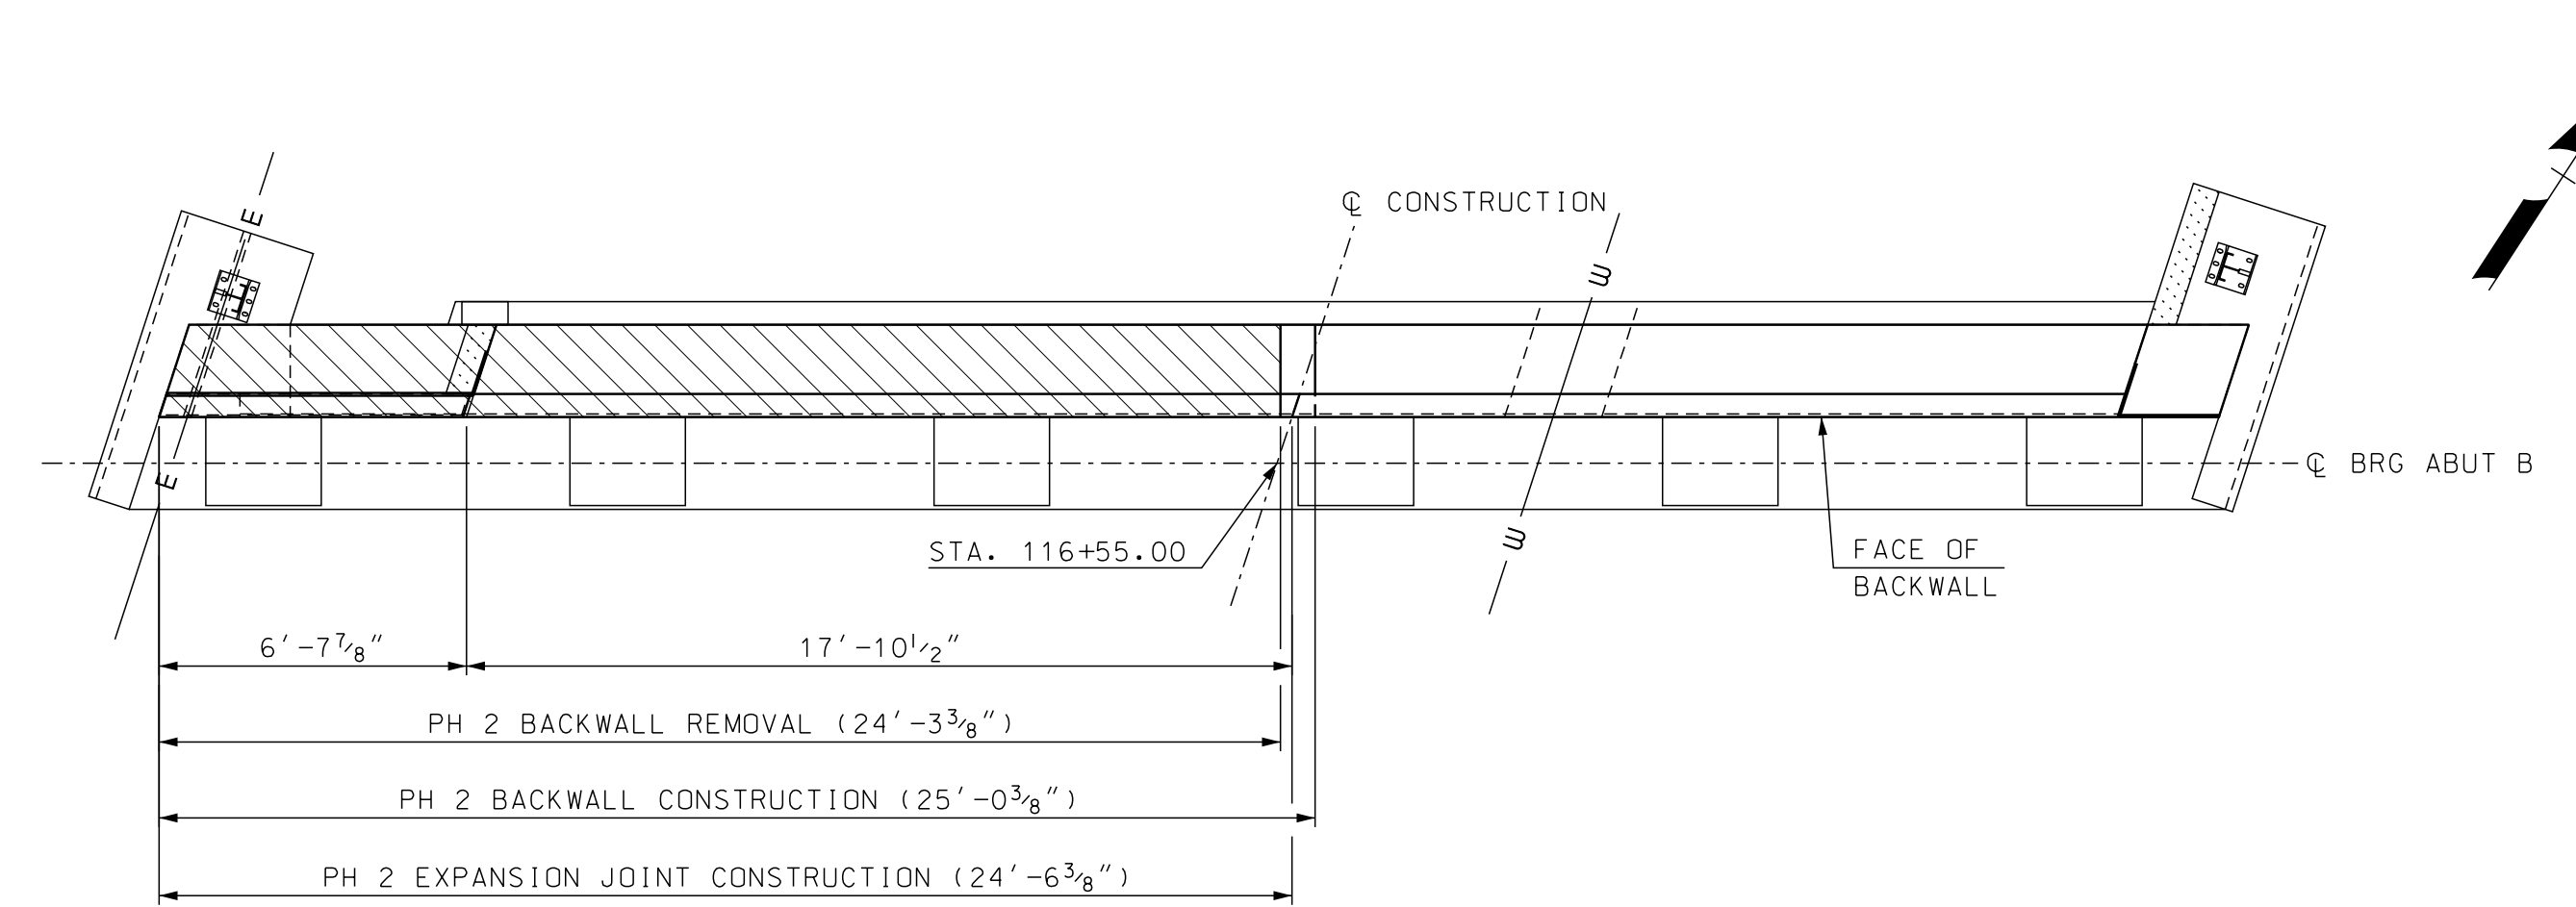


PHASE 2 PLAN

SCALE: 1/4" = 1'-0"

LIMIT OF REMOVAL
 LIMIT OF PROPOSED CONCRETE


- NOTES:
- SEE EXPANSION JOINT PLAN VIEW ON BRIDGE SHEET 9 AND SECTION A-A REMOVAL AND SECTION A-A CONSTRUCTION ON BRIDGE SHEET 10 FOR FURTHER DETAILS.
 - DIMENSIONS ARE GIVEN FROM THE INTERSECTION OF Q CONSTRUCTION AND THE BACK OF BACKWALL.

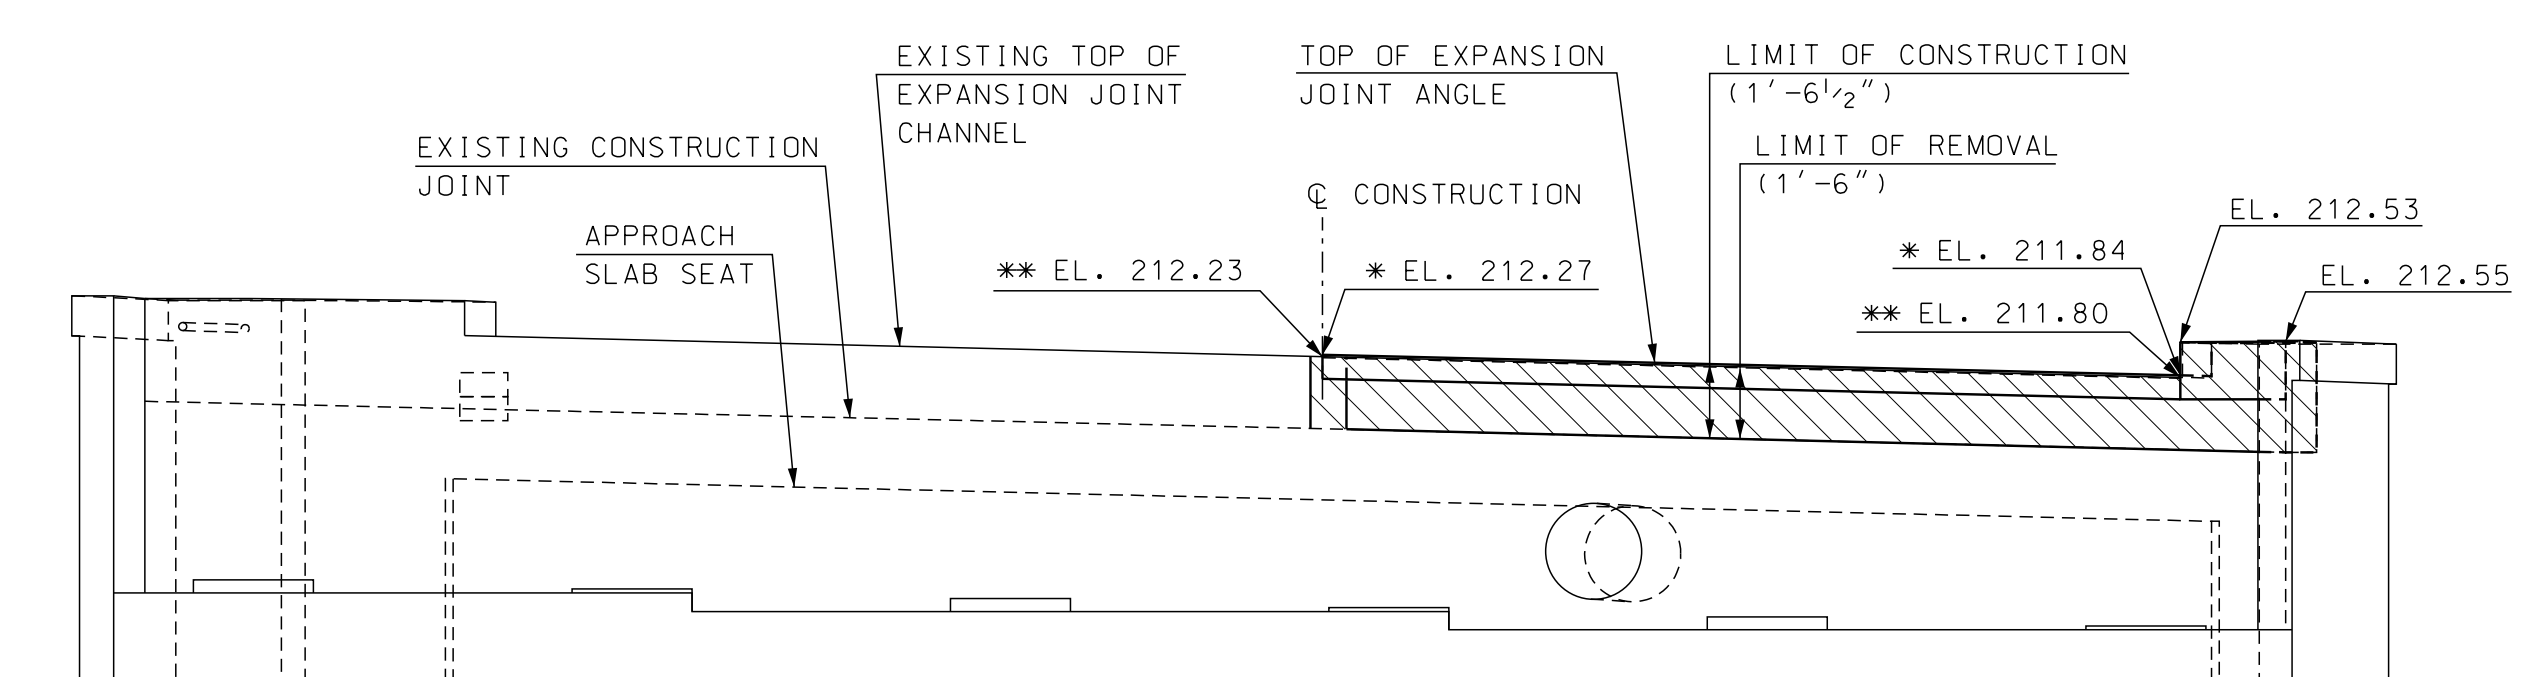

PHASE 1 ELEVATION

SCALE: 1/4" = 1'-0"


EL. XXX.XX = EXISTING AND PROPOSED ELEVATION
 * EL. XXX.XX = PROPOSED ELEVATION AT TOP OF EXPANSION JOINT ANGLE
 ** EL. XXX.XX = EXISTING ELEVATION AT TOP OF EXPANSION JOINT CHANNEL

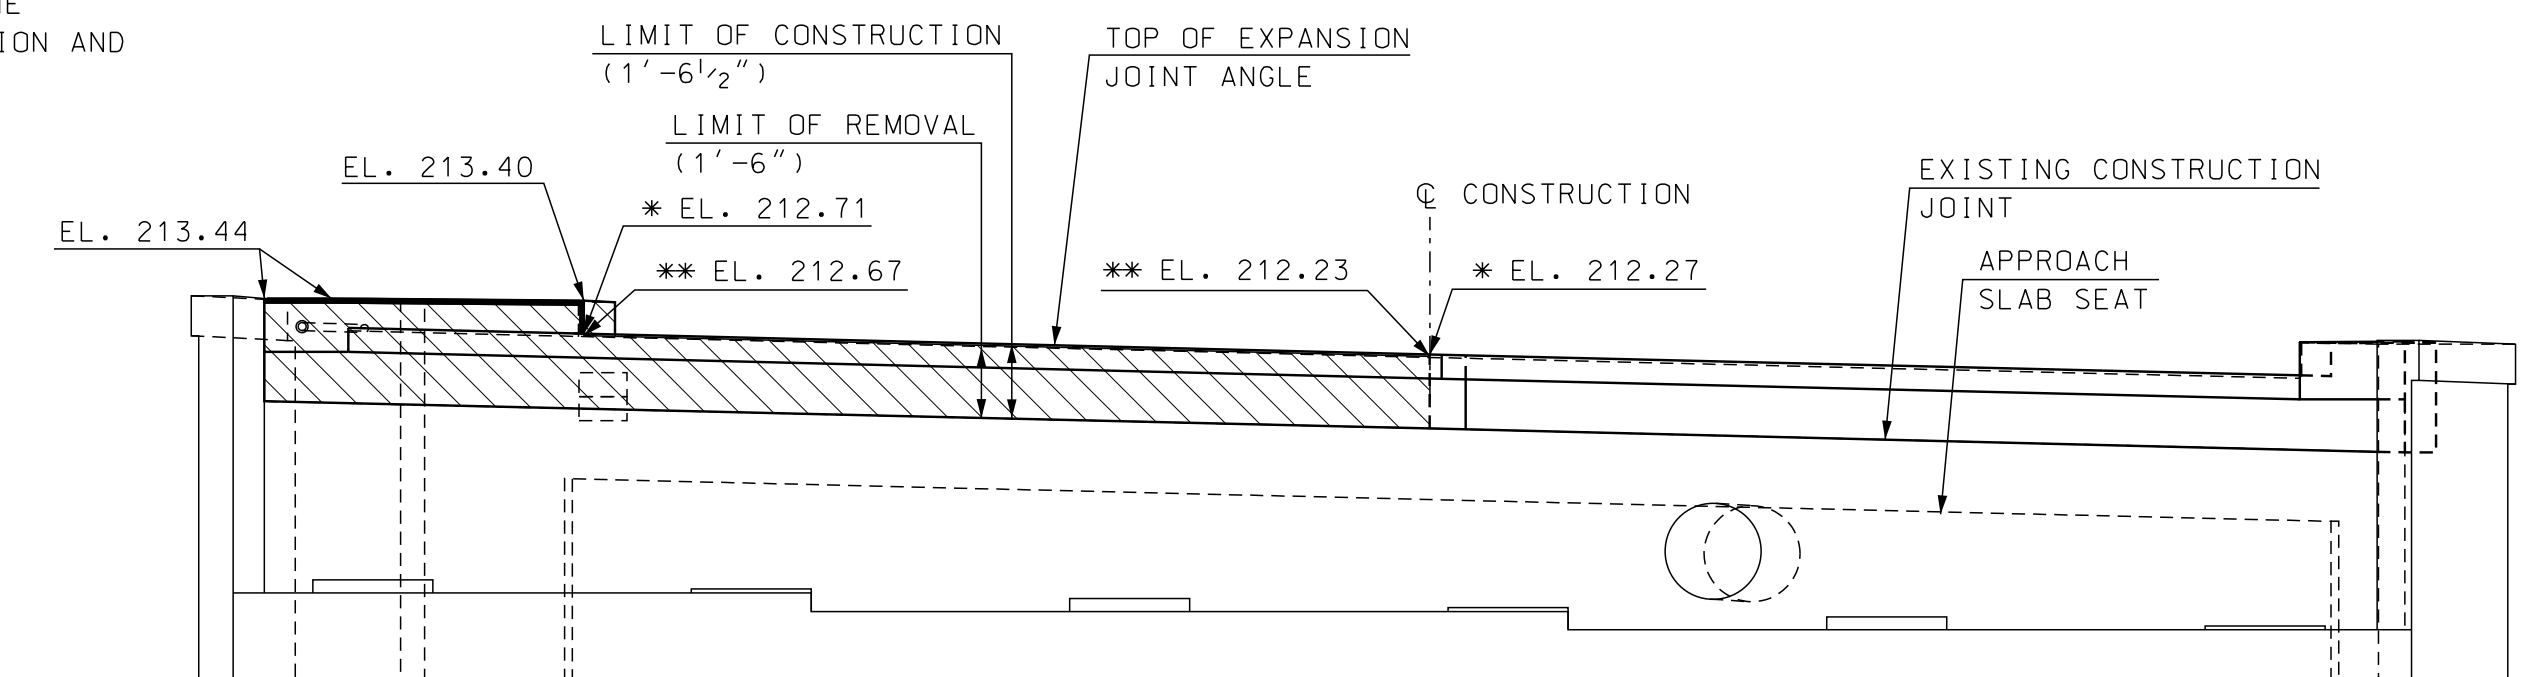

PHASE 2 ELEVATION


SCALE: 1/4" = 1'-0"

EL. XXX.XX = EXISTING AND PROPOSED ELEVATION
 * EL. XXX.XX = PROPOSED ELEVATION AT TOP OF EXPANSION JOINT ANGLE
 ** EL. XXX.XX = EXISTING ELEVATION AT TOP OF EXPANSION JOINT CHANNEL

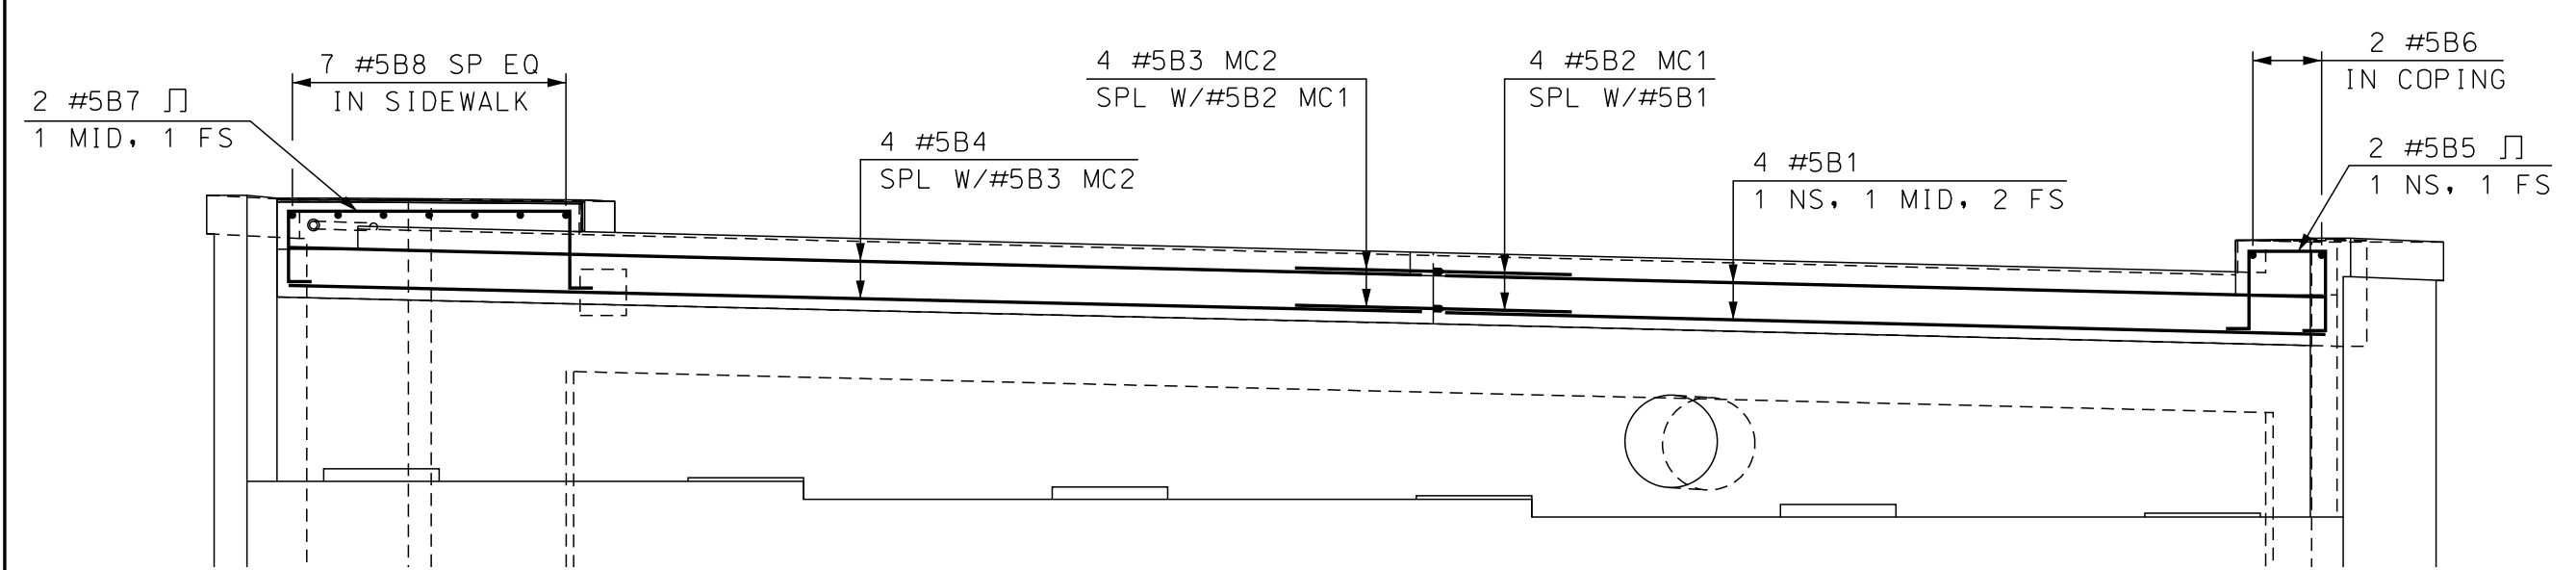


ABUTMENT B REINFORCEMENT ELEVATION

SCALE: 1/4" = 1'-0"

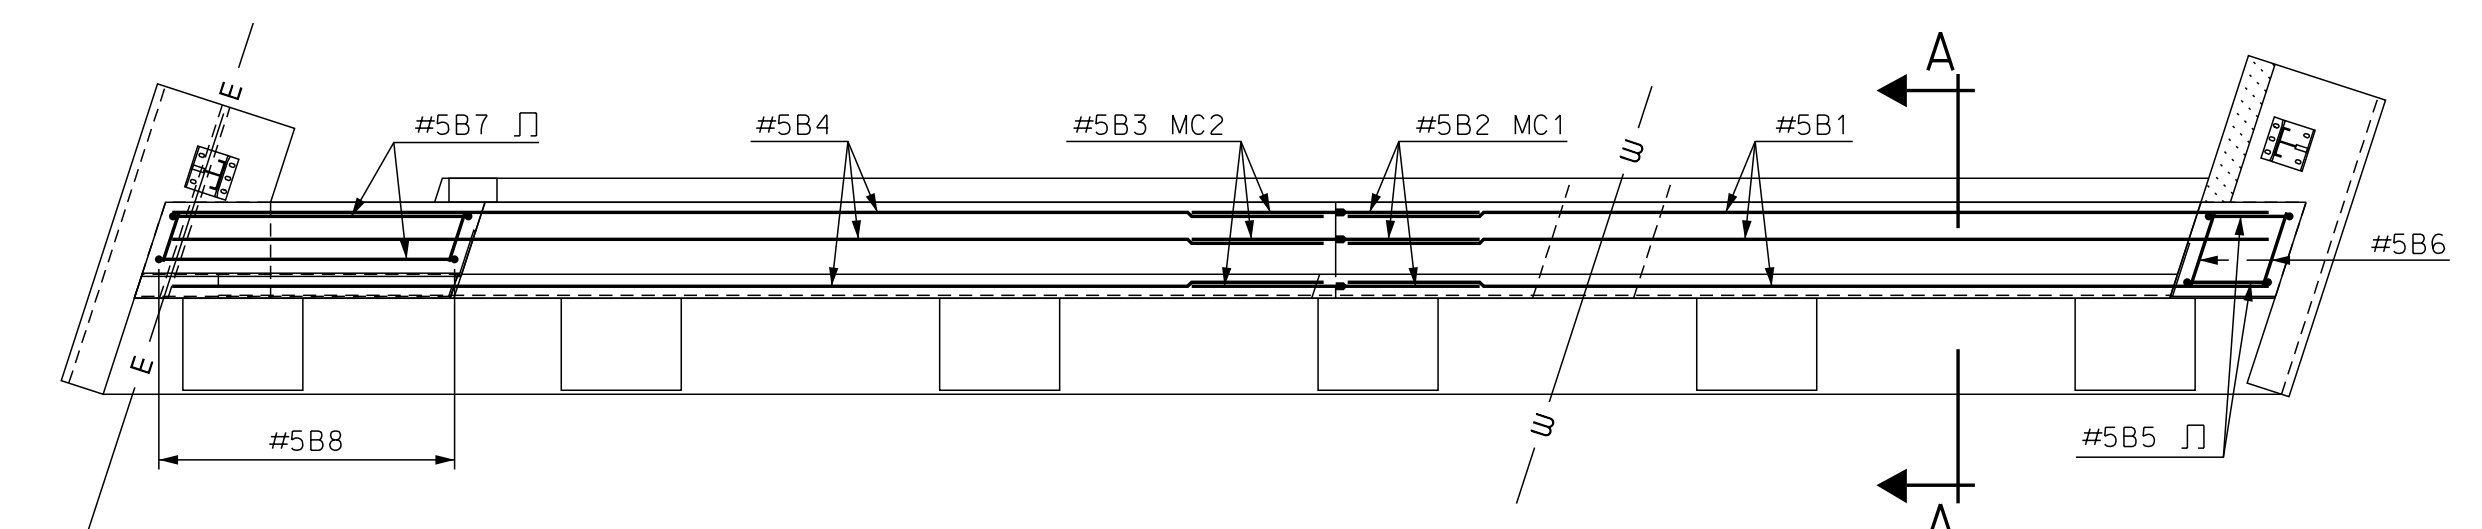

ABUTMENT B REINFORCEMENT PLAN


SCALE: 1/4" = 1'-0"

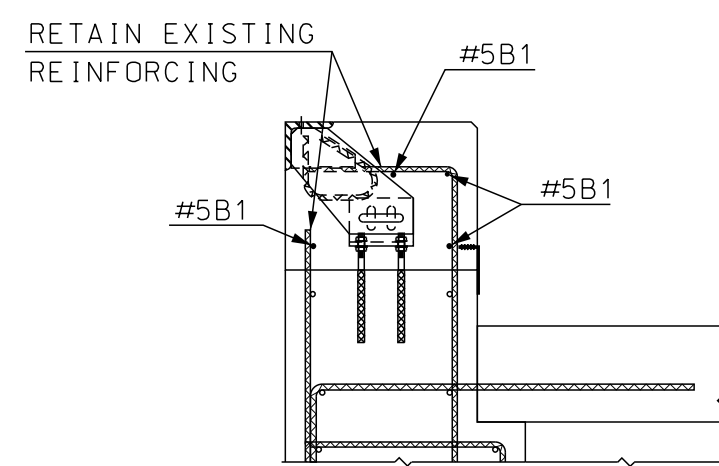







SECTION A-A

SCALE: 1/2" = 1'-0"






STATE OF NEW HAMPSHIRE						
DEPARTMENT OF TRANSPORTATION * BUREAU OF BRIDGE DESIGN						
TOWN	HOOKSETT	BRIDGE NO.	080/148	STATE PROJECT	28435	BRIDGE SHEET
LOCATION MAIN STREET over B&M RR, MERRIMACK RIVER, & RIVERSIDE STREET						5 OF 18
ABUTMENT B PHASING						FILE NUMBER
REVISIONS AFTER PROPOSAL	BY	DATE	CHECKED	SMG	DATE	126-1-1
	JAT	6/14	CHECKED	JAT	8/14	TOTAL SHEETS
	SMG	6/14	CHECKED	JAT	8/14	42
	SMG	9/14	CHECKED	JAT	9/14	
ISSUE DATE	FEDERAL PROJECT NO.			SHEET NO.		
REV. DATE	-----			9		
SUBDIRECTORY	DGN LOCATOR	SHEET SCALE				
BRC\	28435 AbutB	AS NOTED				

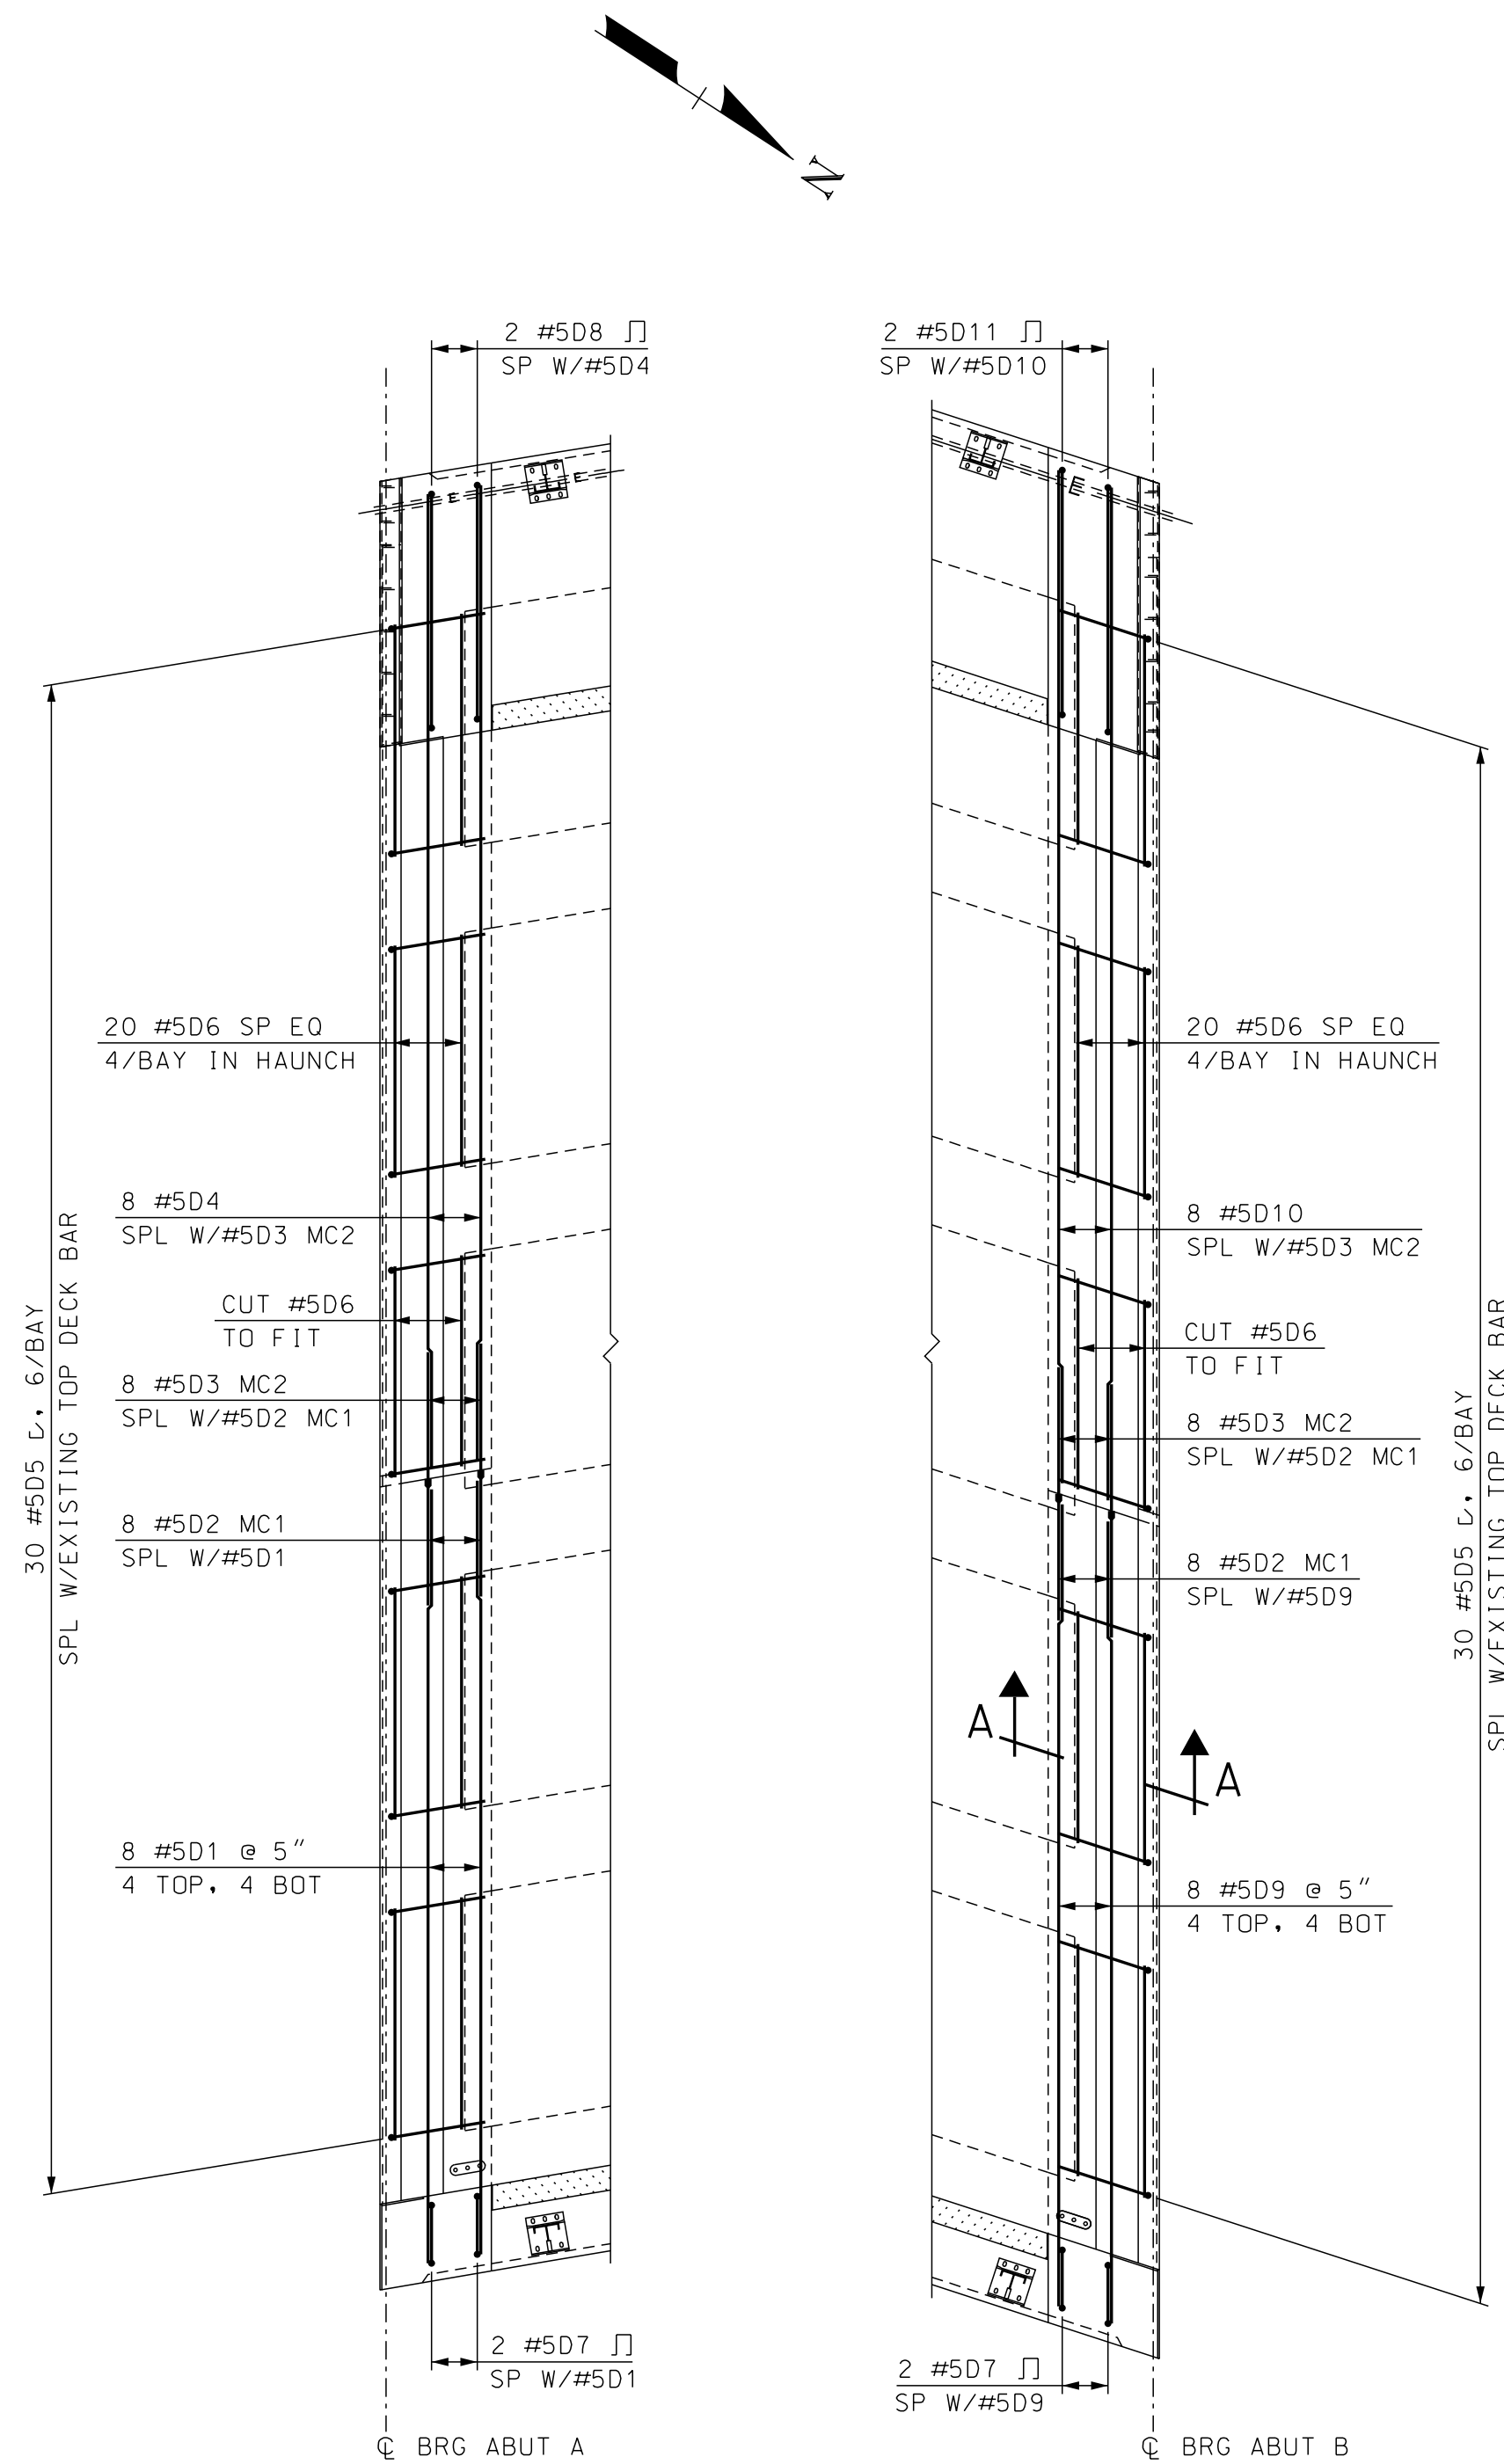

DECK REINFORCEMENT PLAN
SCALE: 1/4" = 1'-0"

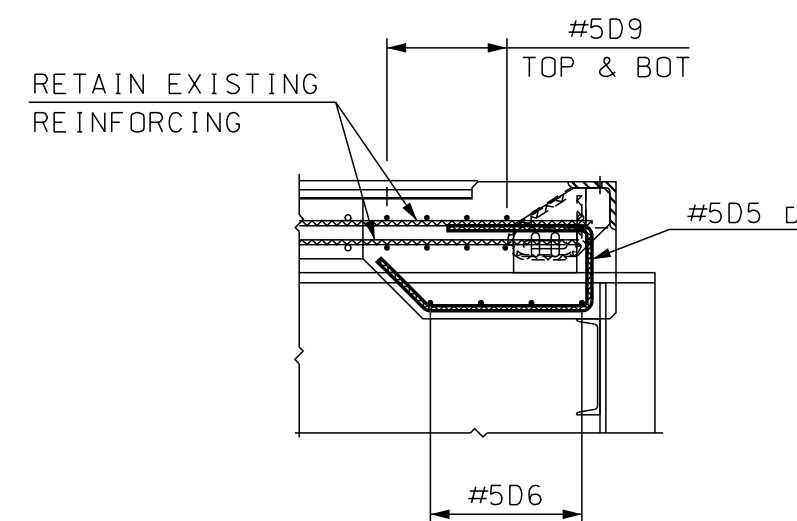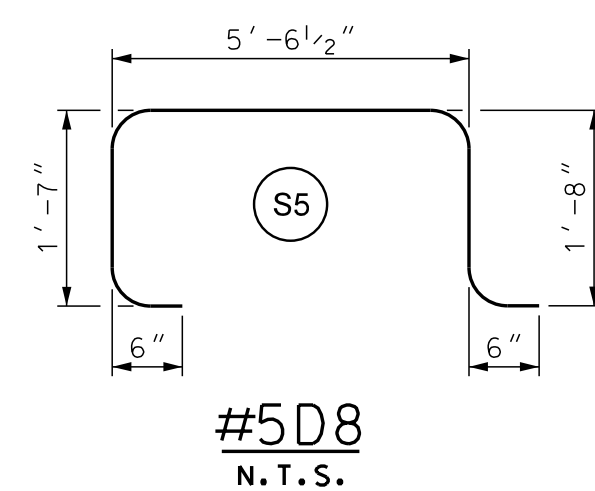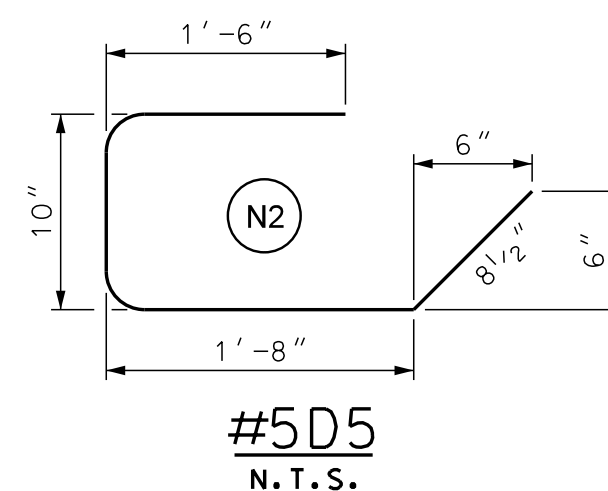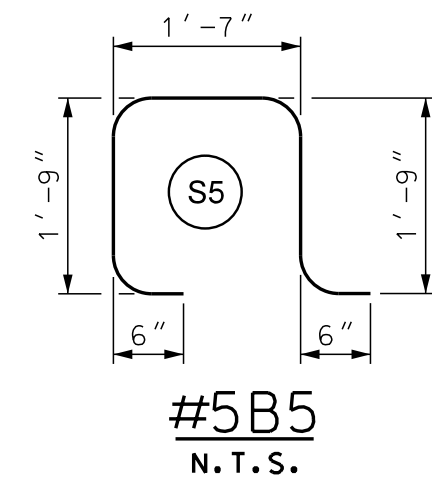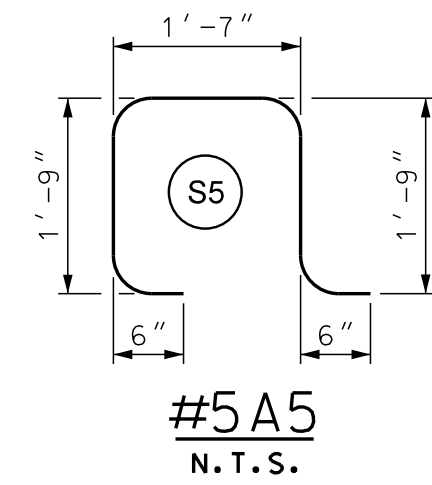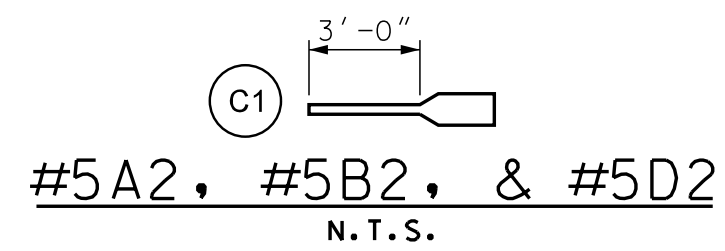

SECTION A-A
SCALE: 1/2" = 1'-0"

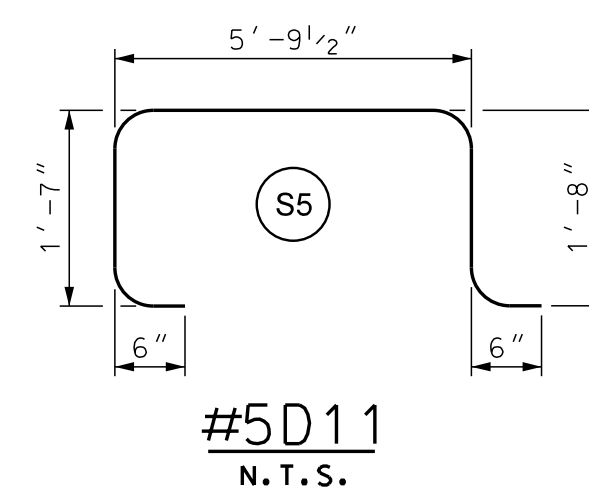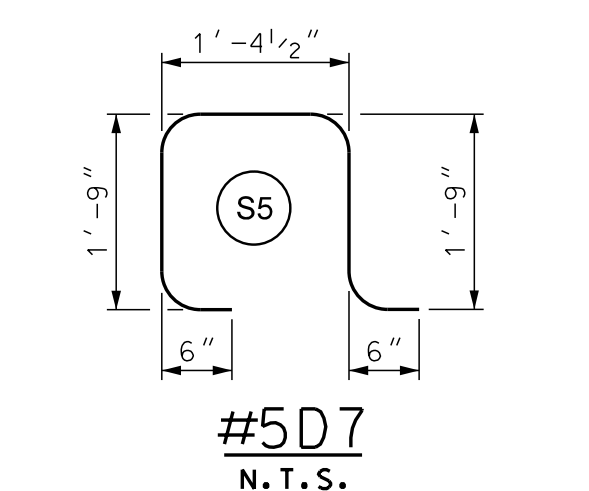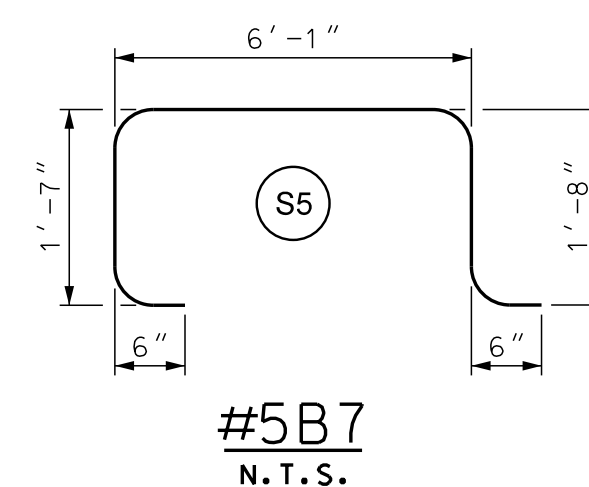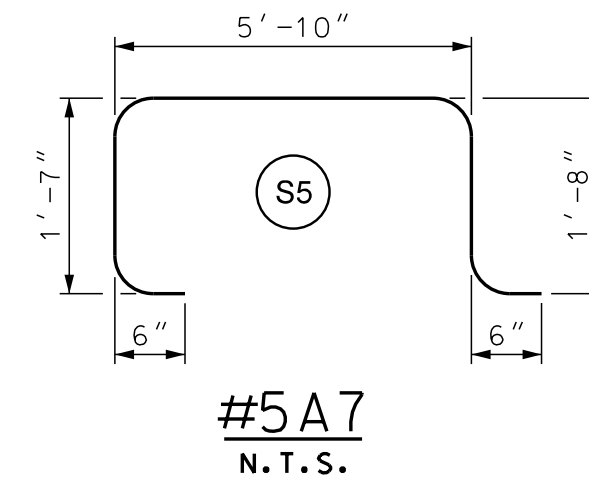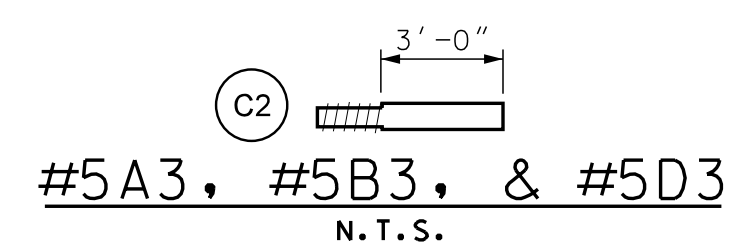


BR. NO. 080/148					
MARK	SIZE	LENGTH	TYPE	# PIECES	LBS
A1	#5	18'-5"	---	4	77
A2	#5	3'-0"	C1	4	13
A3	#5	3'-0"	C2	4	13
A4	#5	23'-5"	---	4	98
A5	#5	6'-1"	S5	2	13
A6	#5	1'-6 1/2"	---	2	4
A7	#5	10'-1"	S5	2	21
A8	#5	1'-0"	---	7	8
B1	#5	19'-2"	---	4	80
B2	#5	3'-0"	C1	4	13
B3	#5	3'-0"	C2	4	13
B4	#5	24'-0"	---	4	100
B5	#5	6'-1"	S5	2	13
B6	#5	1'-7"	---	2	4
B7	#5	10'-4"	S5	2	22
B8	#5	1'-1"	---	7	8
D1	#5	18'-4"	---	8	153
D2	#5	3'-0"	C1	16	50
D3	#5	3'-0"	C2	16	50
D4	#5	23'-1"	---	8	193
D5	#5	4'-8 1/2"	N2	60	295
D6	#5	5'-6"	---	40	230
D7	#5	5'-10 1/2"	S5	4	25
D8	#5	9'-9 1/2"	S5	2	21
D9	#5	19'-0"	---	8	159
D10	#5	24'-0"	---	8	201
D11	#5	10'-0 1/2"	S5	2	21
ITEM	DESCRIPTION				TOTAL
544.	REINFORCING STEEL (F)				1746
544.11	REINFORCING STEEL-MECHANICAL CONNECTORS (F)				152

REINFORCING NOTES


- UNLESS OTHERWISE DESIGNATED, ALL BAR REINFORCEMENT FOR CONCRETE SHALL CONFORM TO THE REQUIREMENTS OF THE "SPECIFICATIONS FOR DEFORMED BILLET - STEEL BARS FOR CONCRETE REINFORCEMENT", AASHTO M 31 (ASTM A615), GRADE 60, EPOXY COATED.
- FOR TYPICAL BENDING DETAILS, RECOMMENDED PIN DIAMETER "D" OF BENDS AND HOOKS AND OTHER STANDARD PRACTICE SEE CURRENT CONCRETE REINFORCING STEEL INSTITUTE "MANUAL OF STANDARD PRACTICE".
- EXISTING REINFORCING STEEL THAT IS TO REMAIN IN PLACE WITHIN THE REMOVAL AREAS SHALL BE CUT AS REQUIRED TO PROVIDE 2 1/2" MINIMUM CLEAR COVER FROM THE PROPOSED CONCRETE SURFACES, EXCEPT AS OTHERWISE NOTED. ALL COSTS INCLUDED IN ITEM 502. ALL NEW REINFORCING BARS SHALL HAVE A MINIMUM CLEAR COVER OF 2 1/2" FROM PROPOSED CONCRETE SURFACES.
- #5 BAR MIN LAP LENGTH = 2'-6".
- PLACE REINFORCING STEEL TO AVOID EXPANSION JOINT STEEL.

STATE OF NEW HAMPSHIRE					
DEPARTMENT OF TRANSPORTATION * BUREAU OF BRIDGE DESIGN					
TOWN	HOOKSETT	BRIDGE NO.	080/148	STATE PROJECT	28435
LOCATION MAIN STREET over B&M RR, MERRIMACK RIVER, & RIVERSIDE STREET					
DECK END REINFORCEMENT & BAR SCHEDULE					BRIDGE SHEET
REVISIONS AFTER PROPOSAL					6 OF 18
DESIGNED	JAT	DATE	6/14	CHECKED	SMG
DRAWN	SMG	DATE	6/14	CHECKED	JAT
QUANTITIES	SMG	DATE	9/14	CHECKED	JAT
ISSUE DATE		FEDERAL PROJECT NO.		SHEET NO.	
REV. DATE				10	42


SUBDIRECTORY	DGN LOCATOR	SHEET SCALE
BRC\	28435 Deckbars	AS NOTED

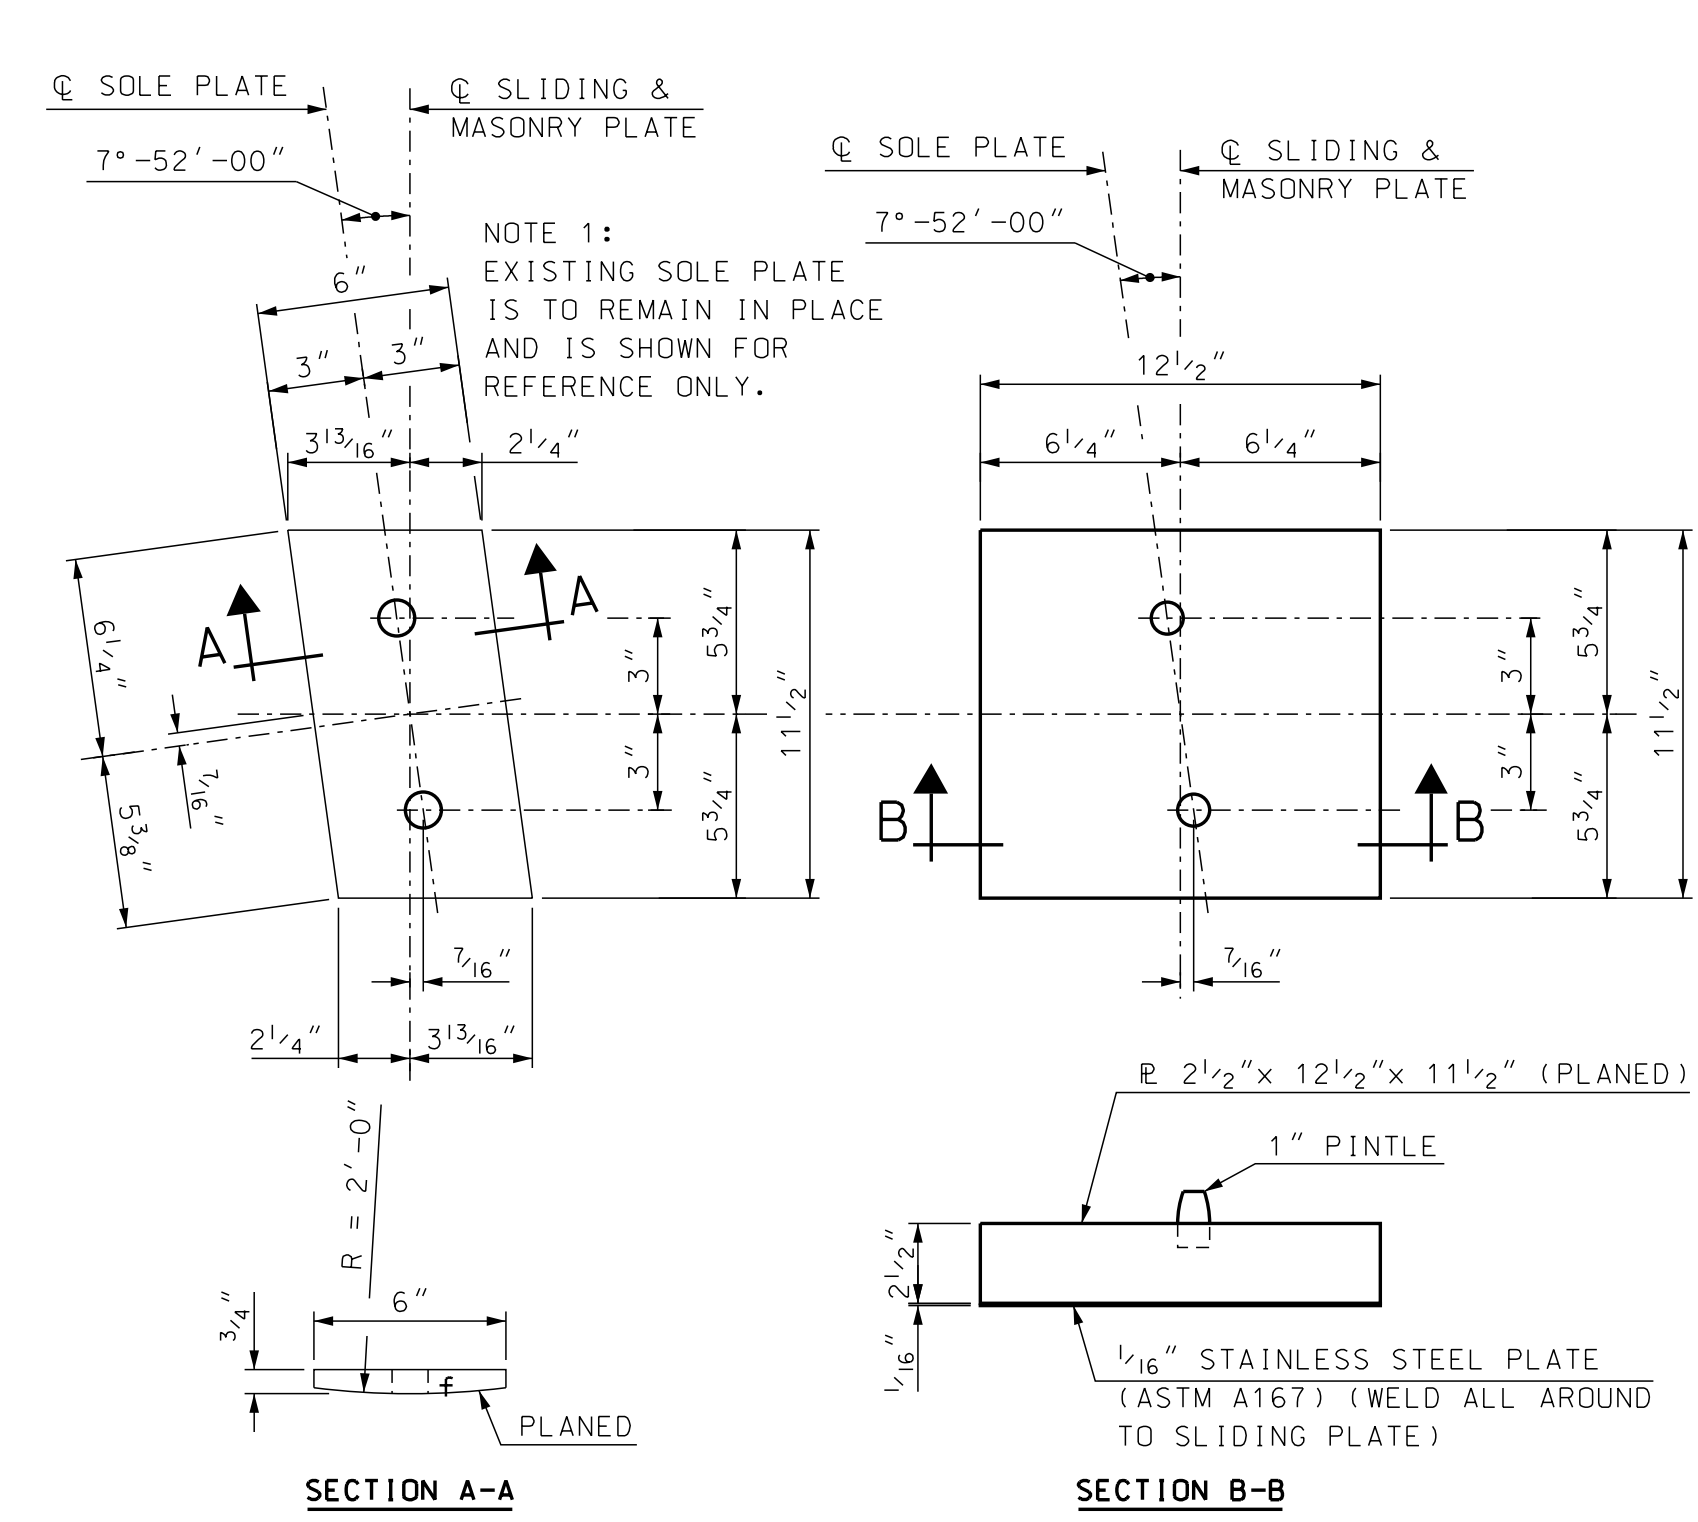


EXISTING SOLE PLATE TO REMAIN WELDED TO TIE-DOWN PLATE
SLIDING PLATE

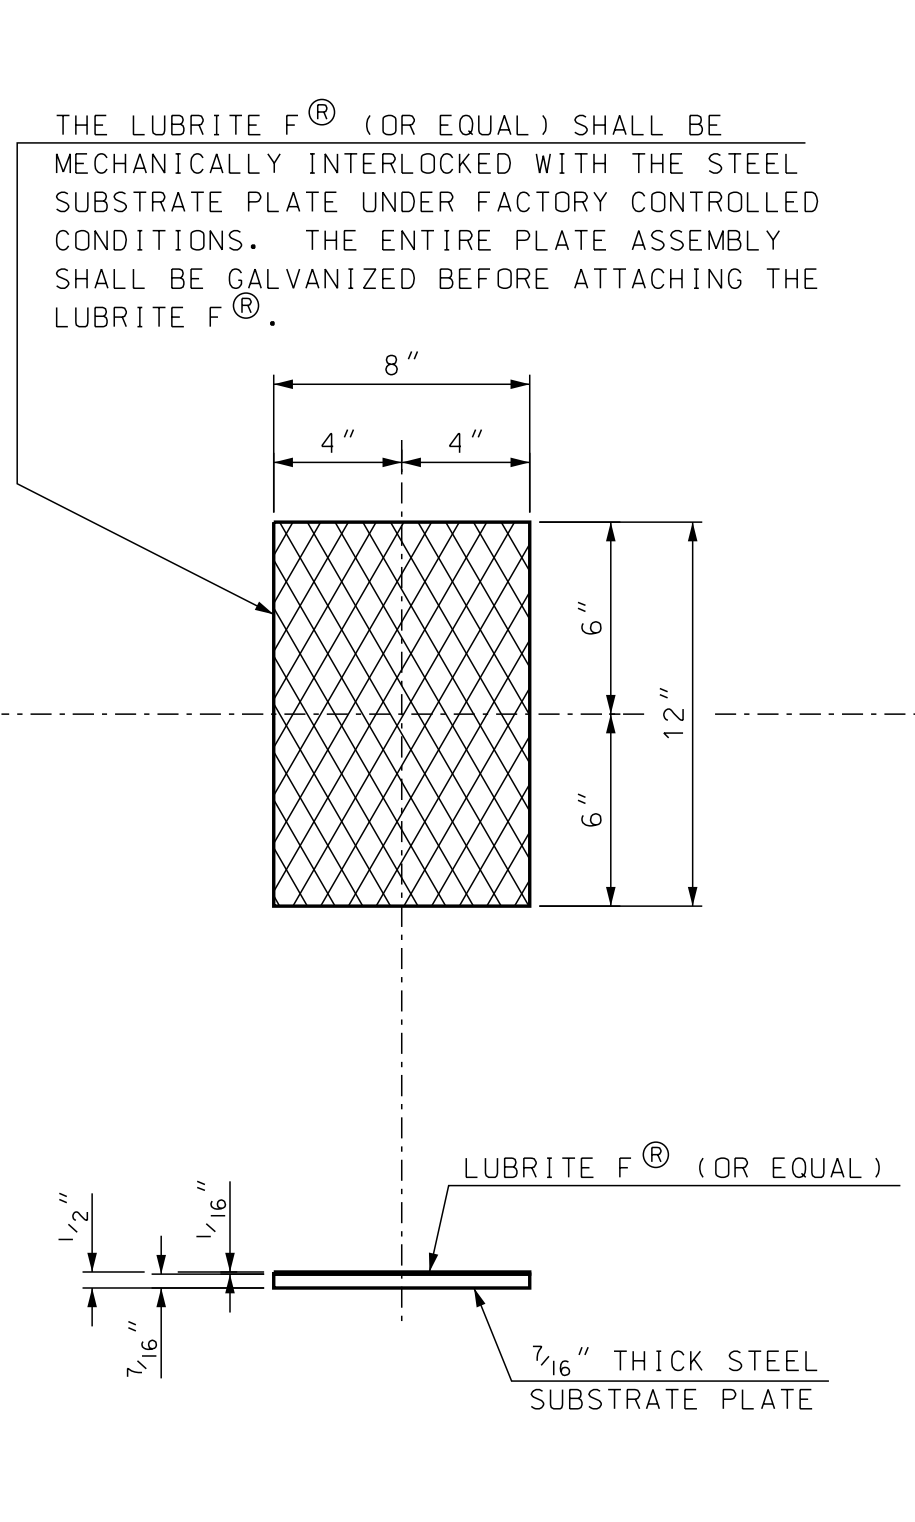


SUBSTRATE PLATE

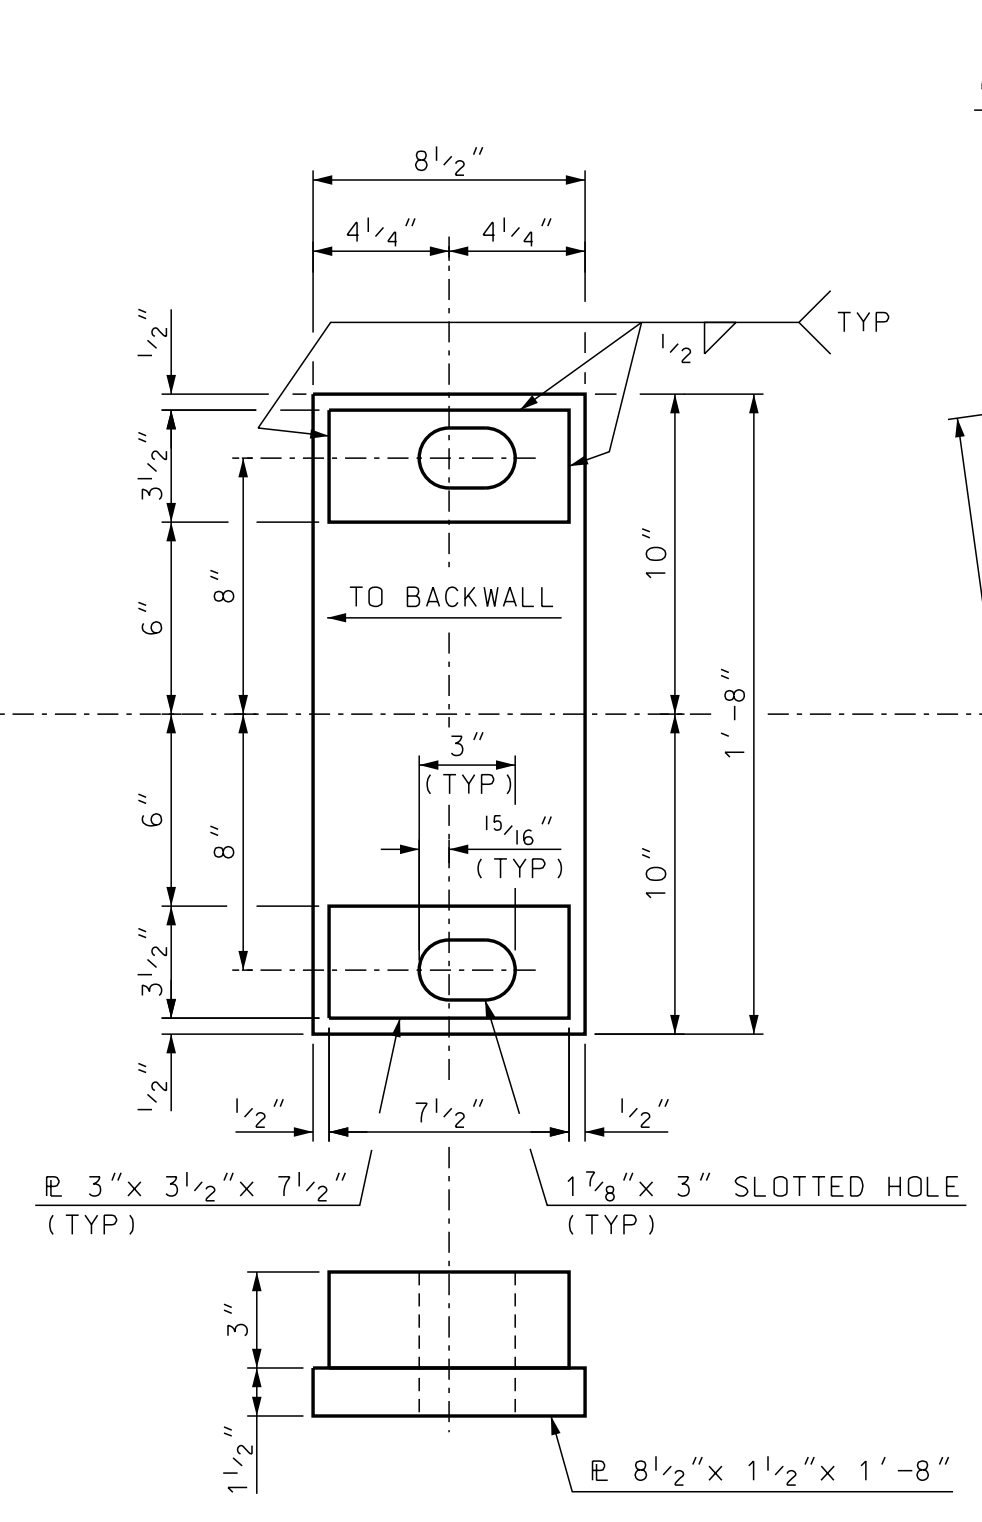


MASONRY PLATE

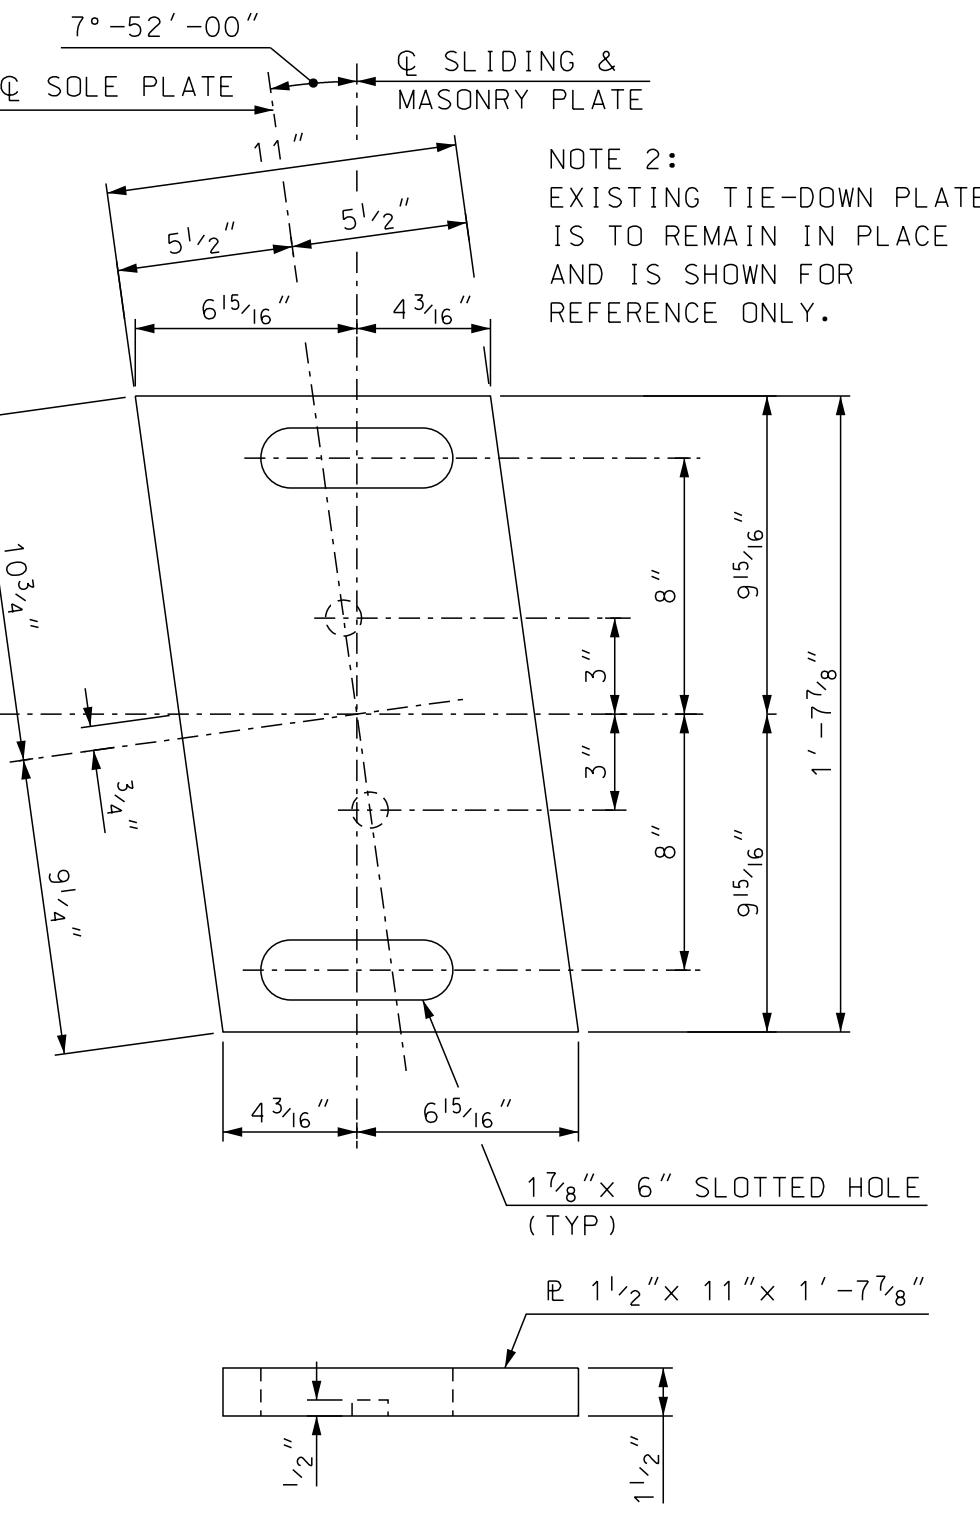


EXISTING TIE-DOWN PLATE TO REMAIN WELDED TO GIRDER

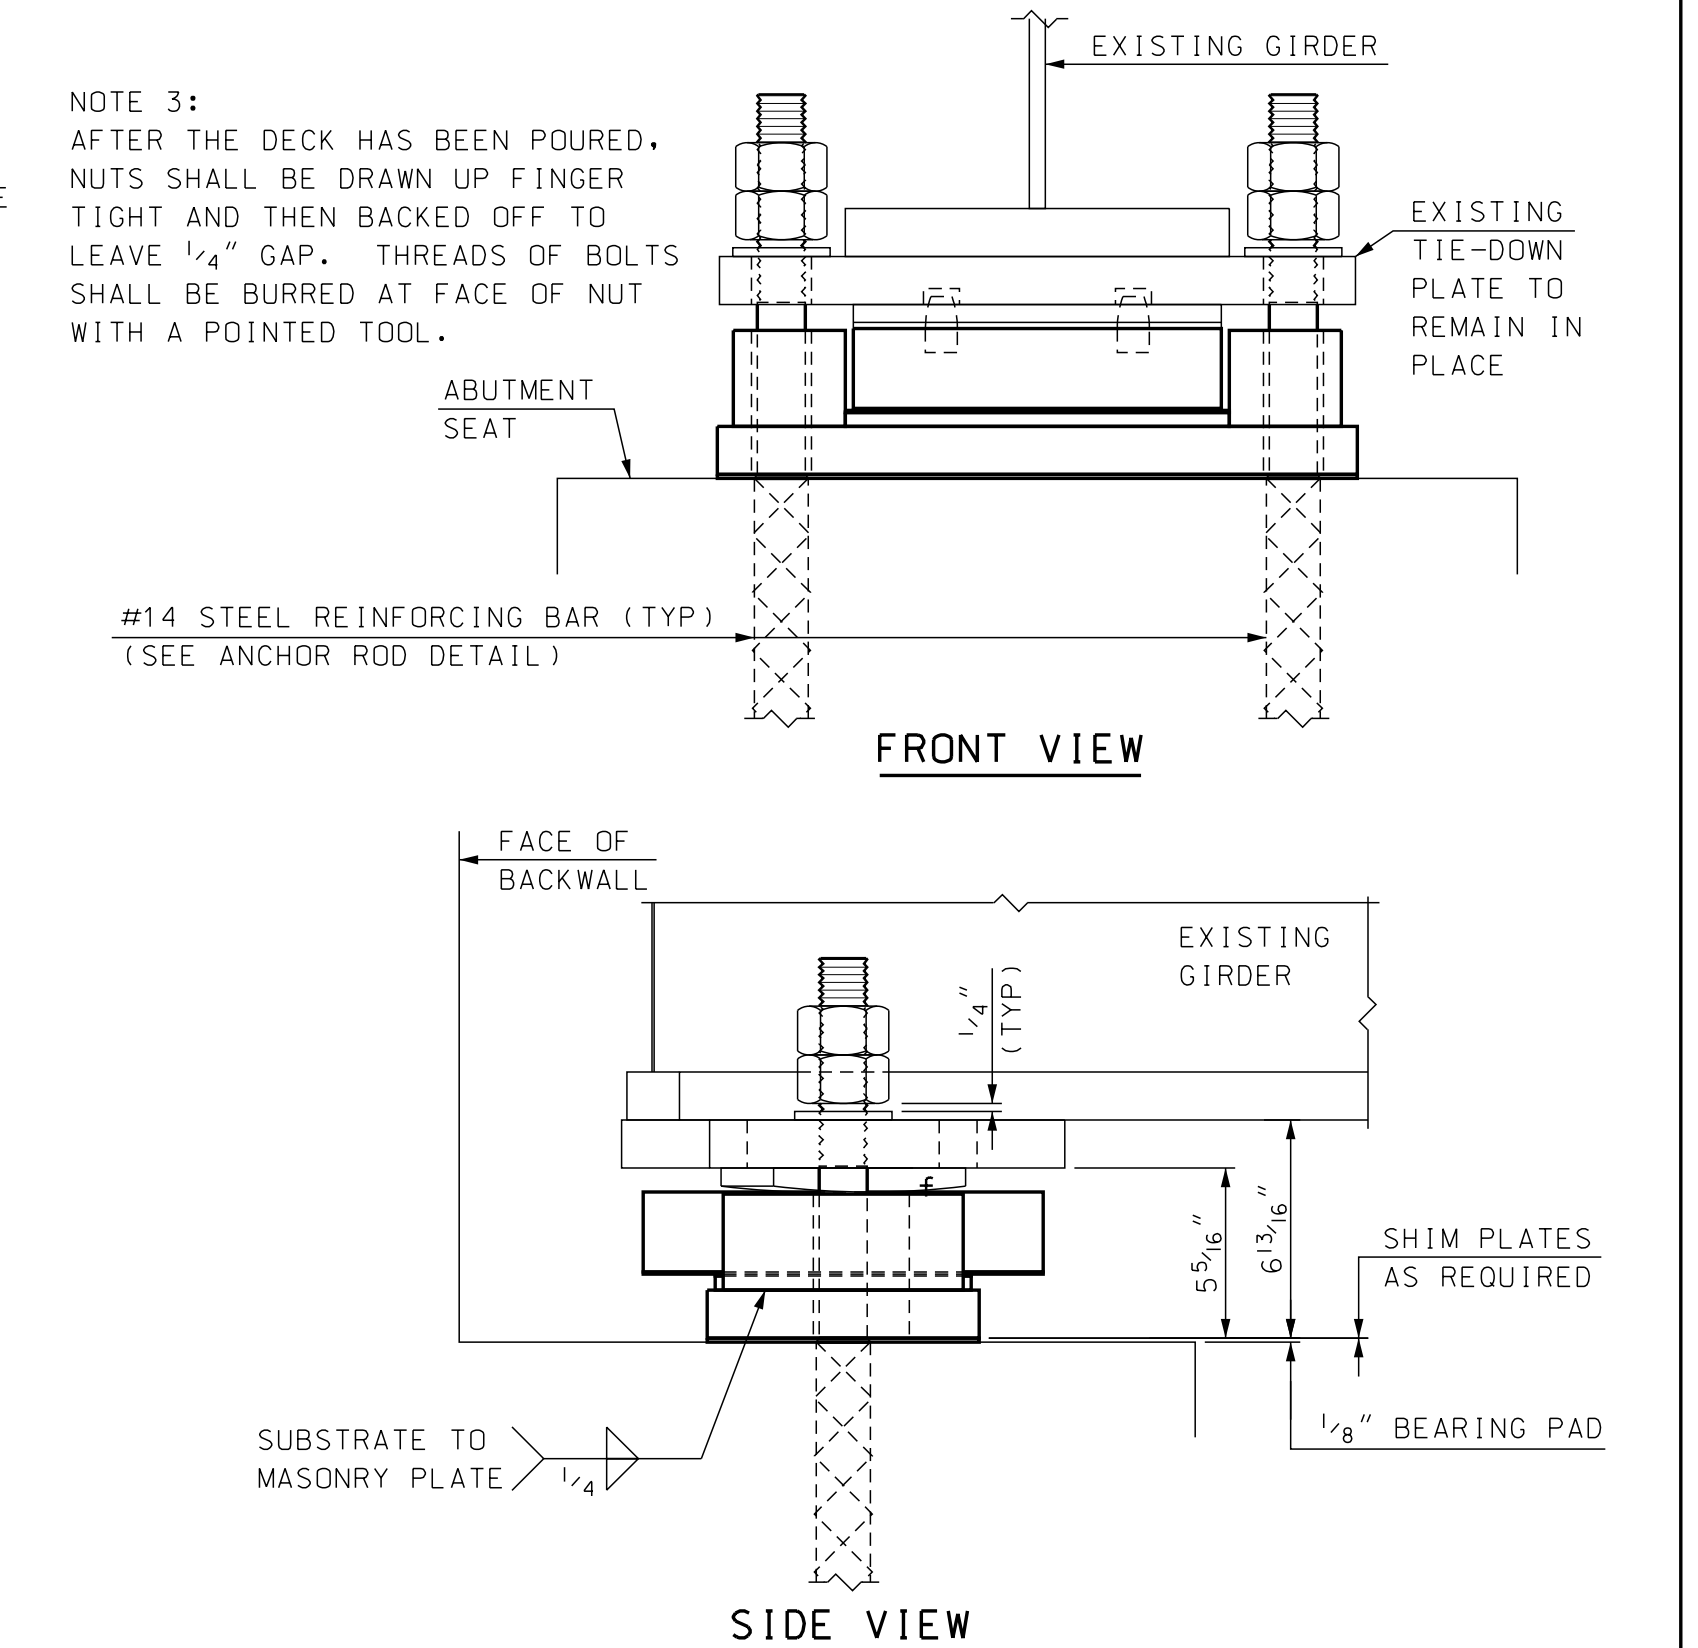


FRONT VIEW
SIDE VIEW

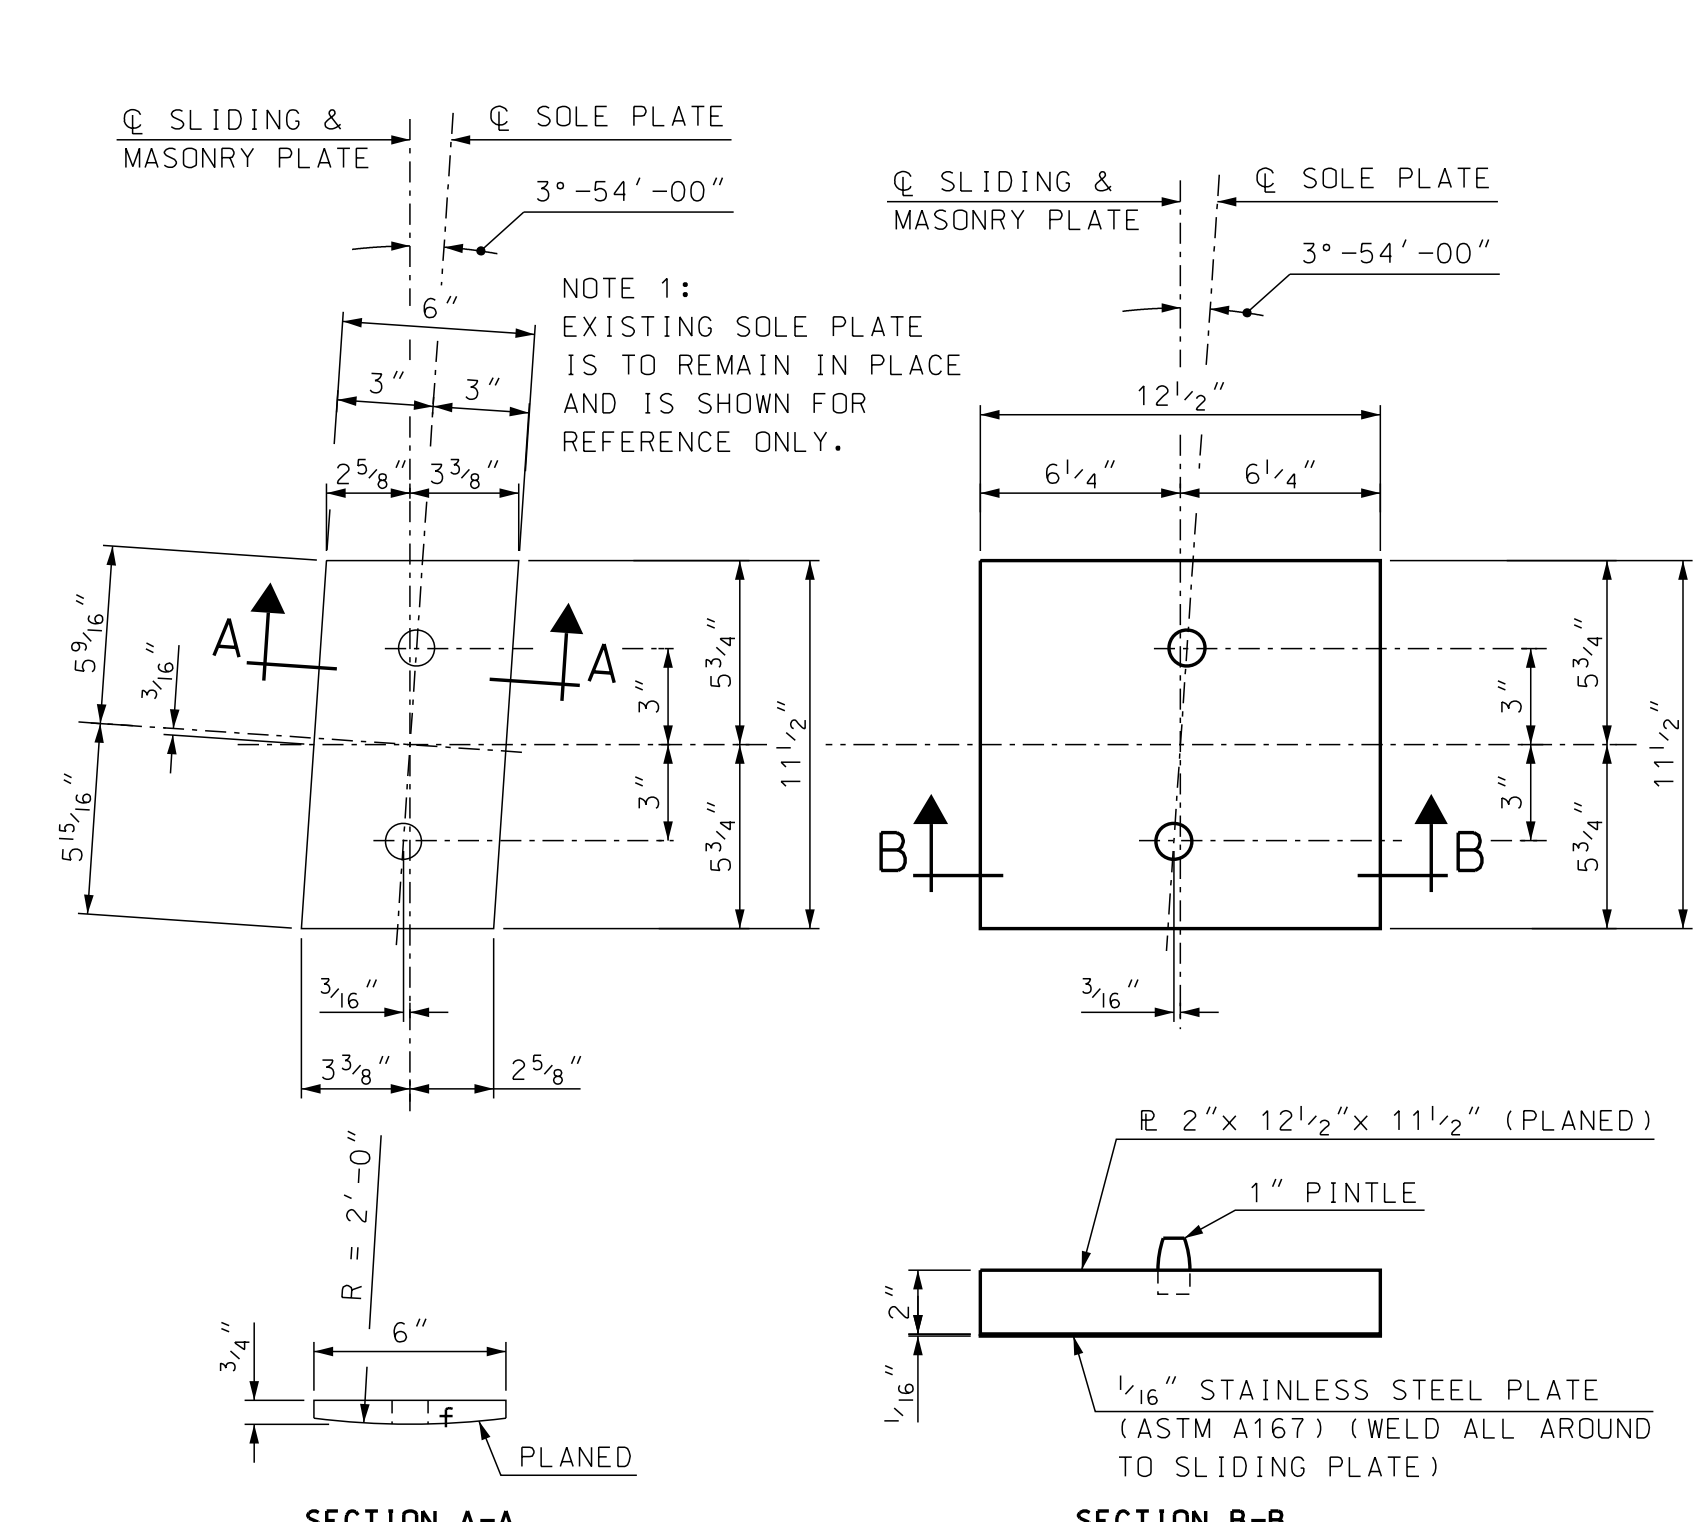


EXISTING SOLE PLATE TO REMAIN WELDED TO TIE-DOWN PLATE
SLIDING PLATE

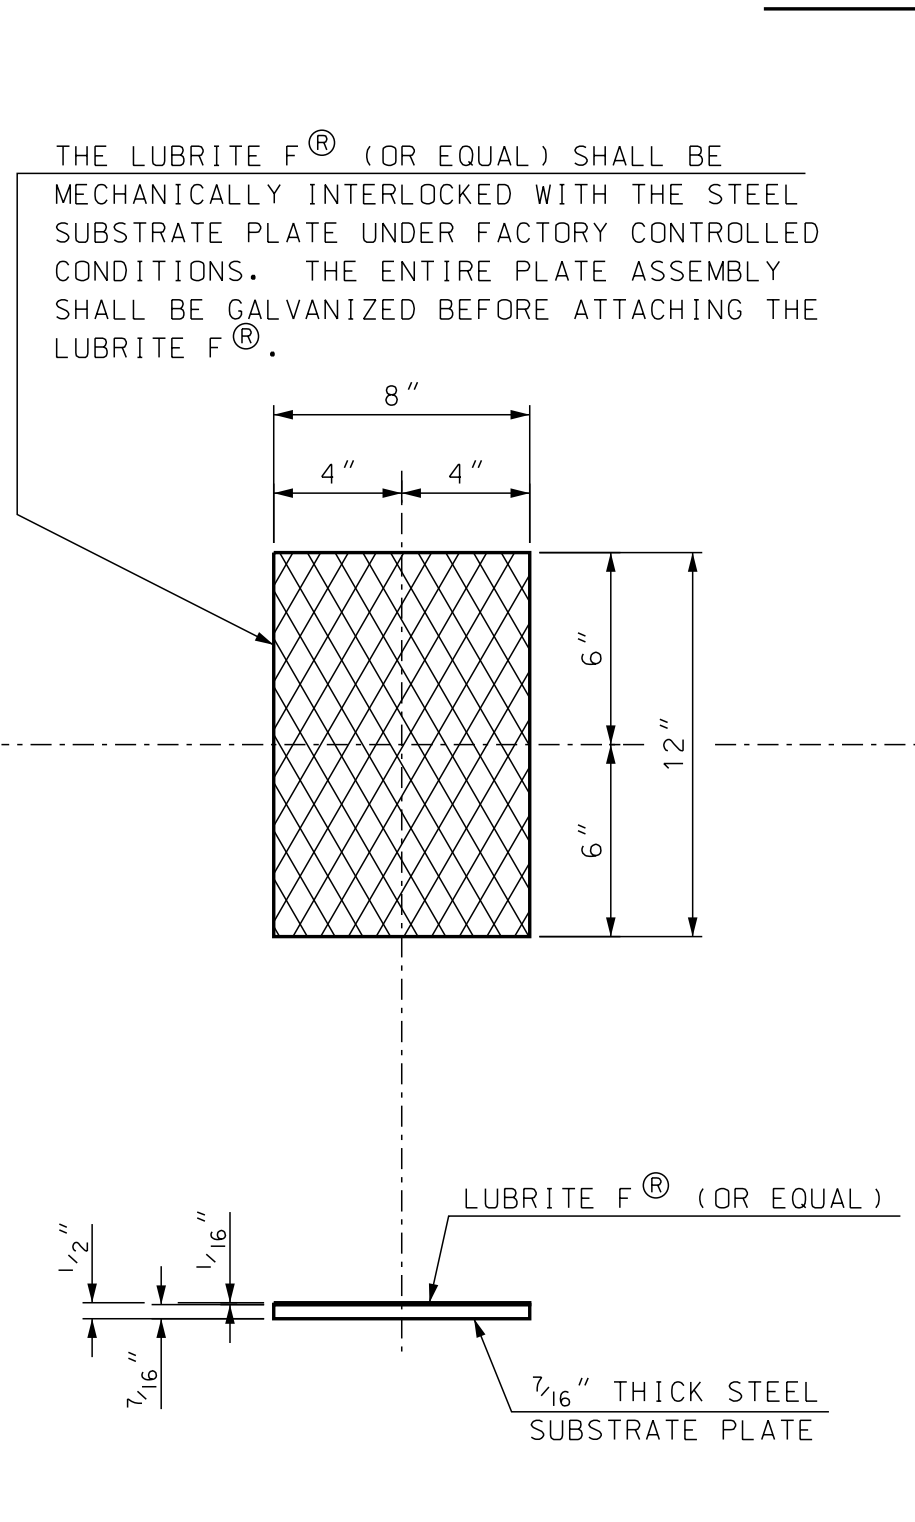


SUBSTRATE PLATE

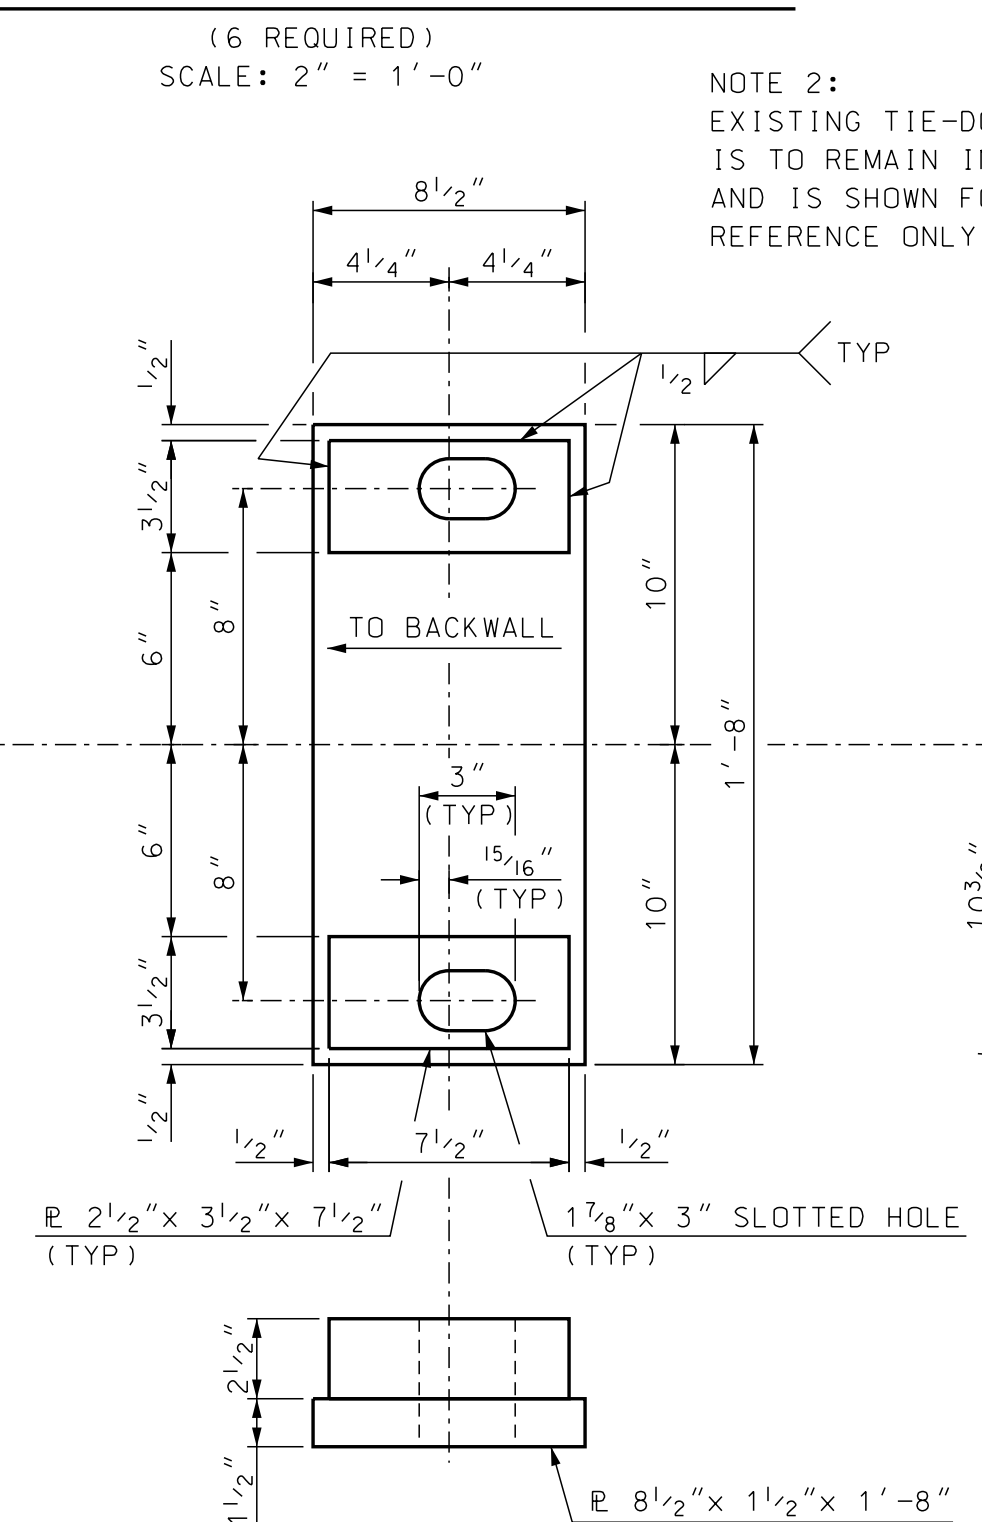

MASONRY PLATE

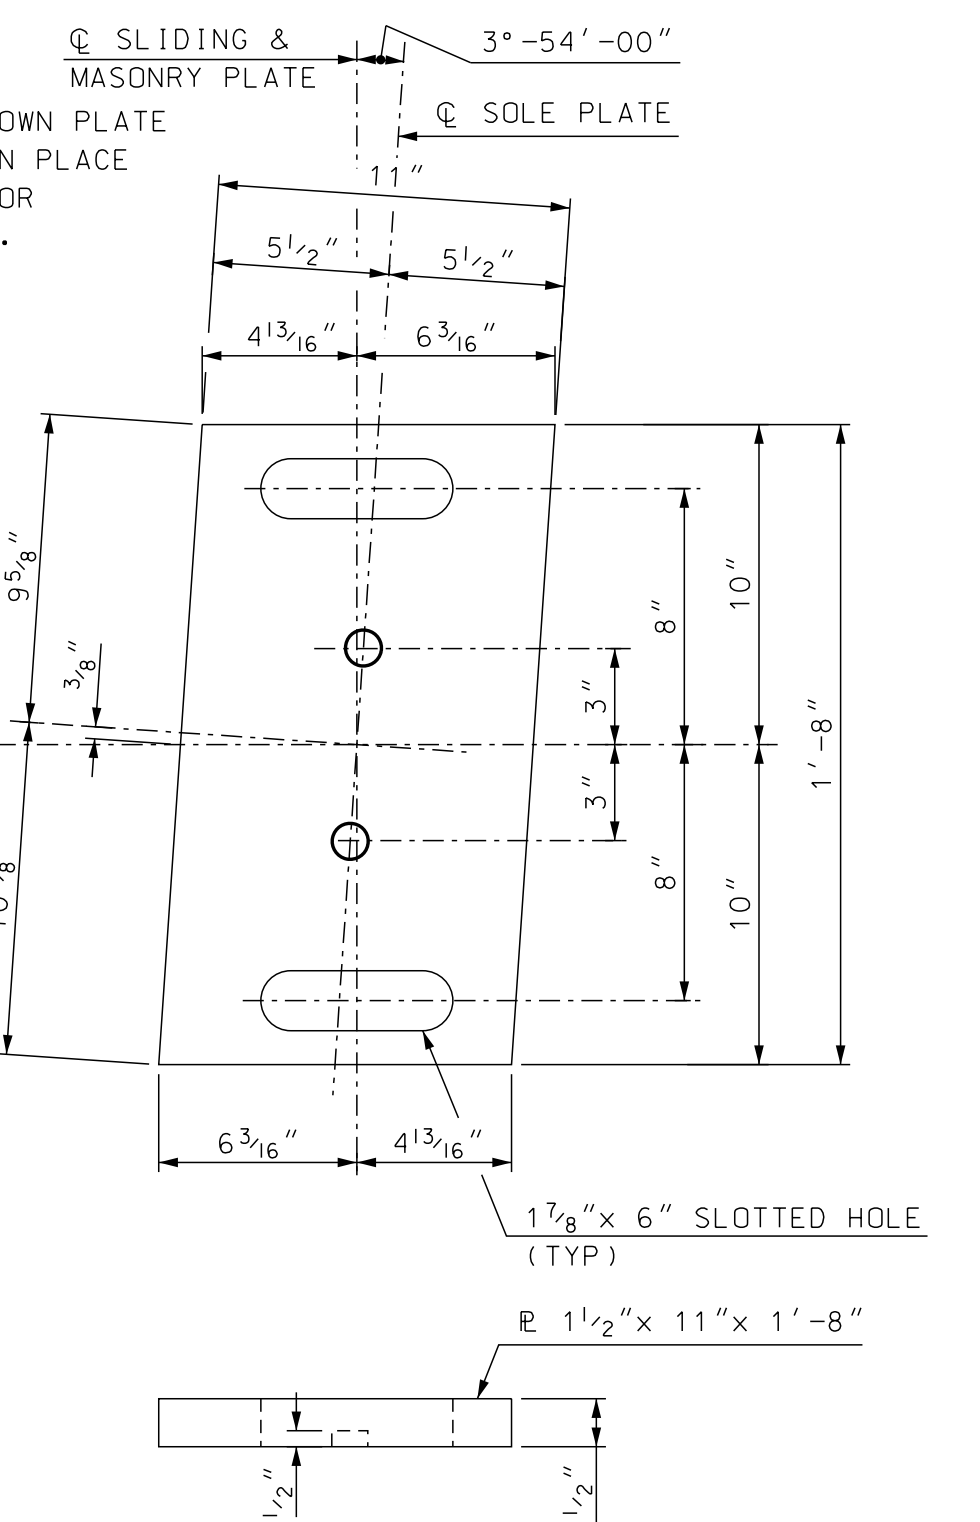


EXISTING TIE-DOWN PLATE TO REMAIN WELDED TO GIRDER

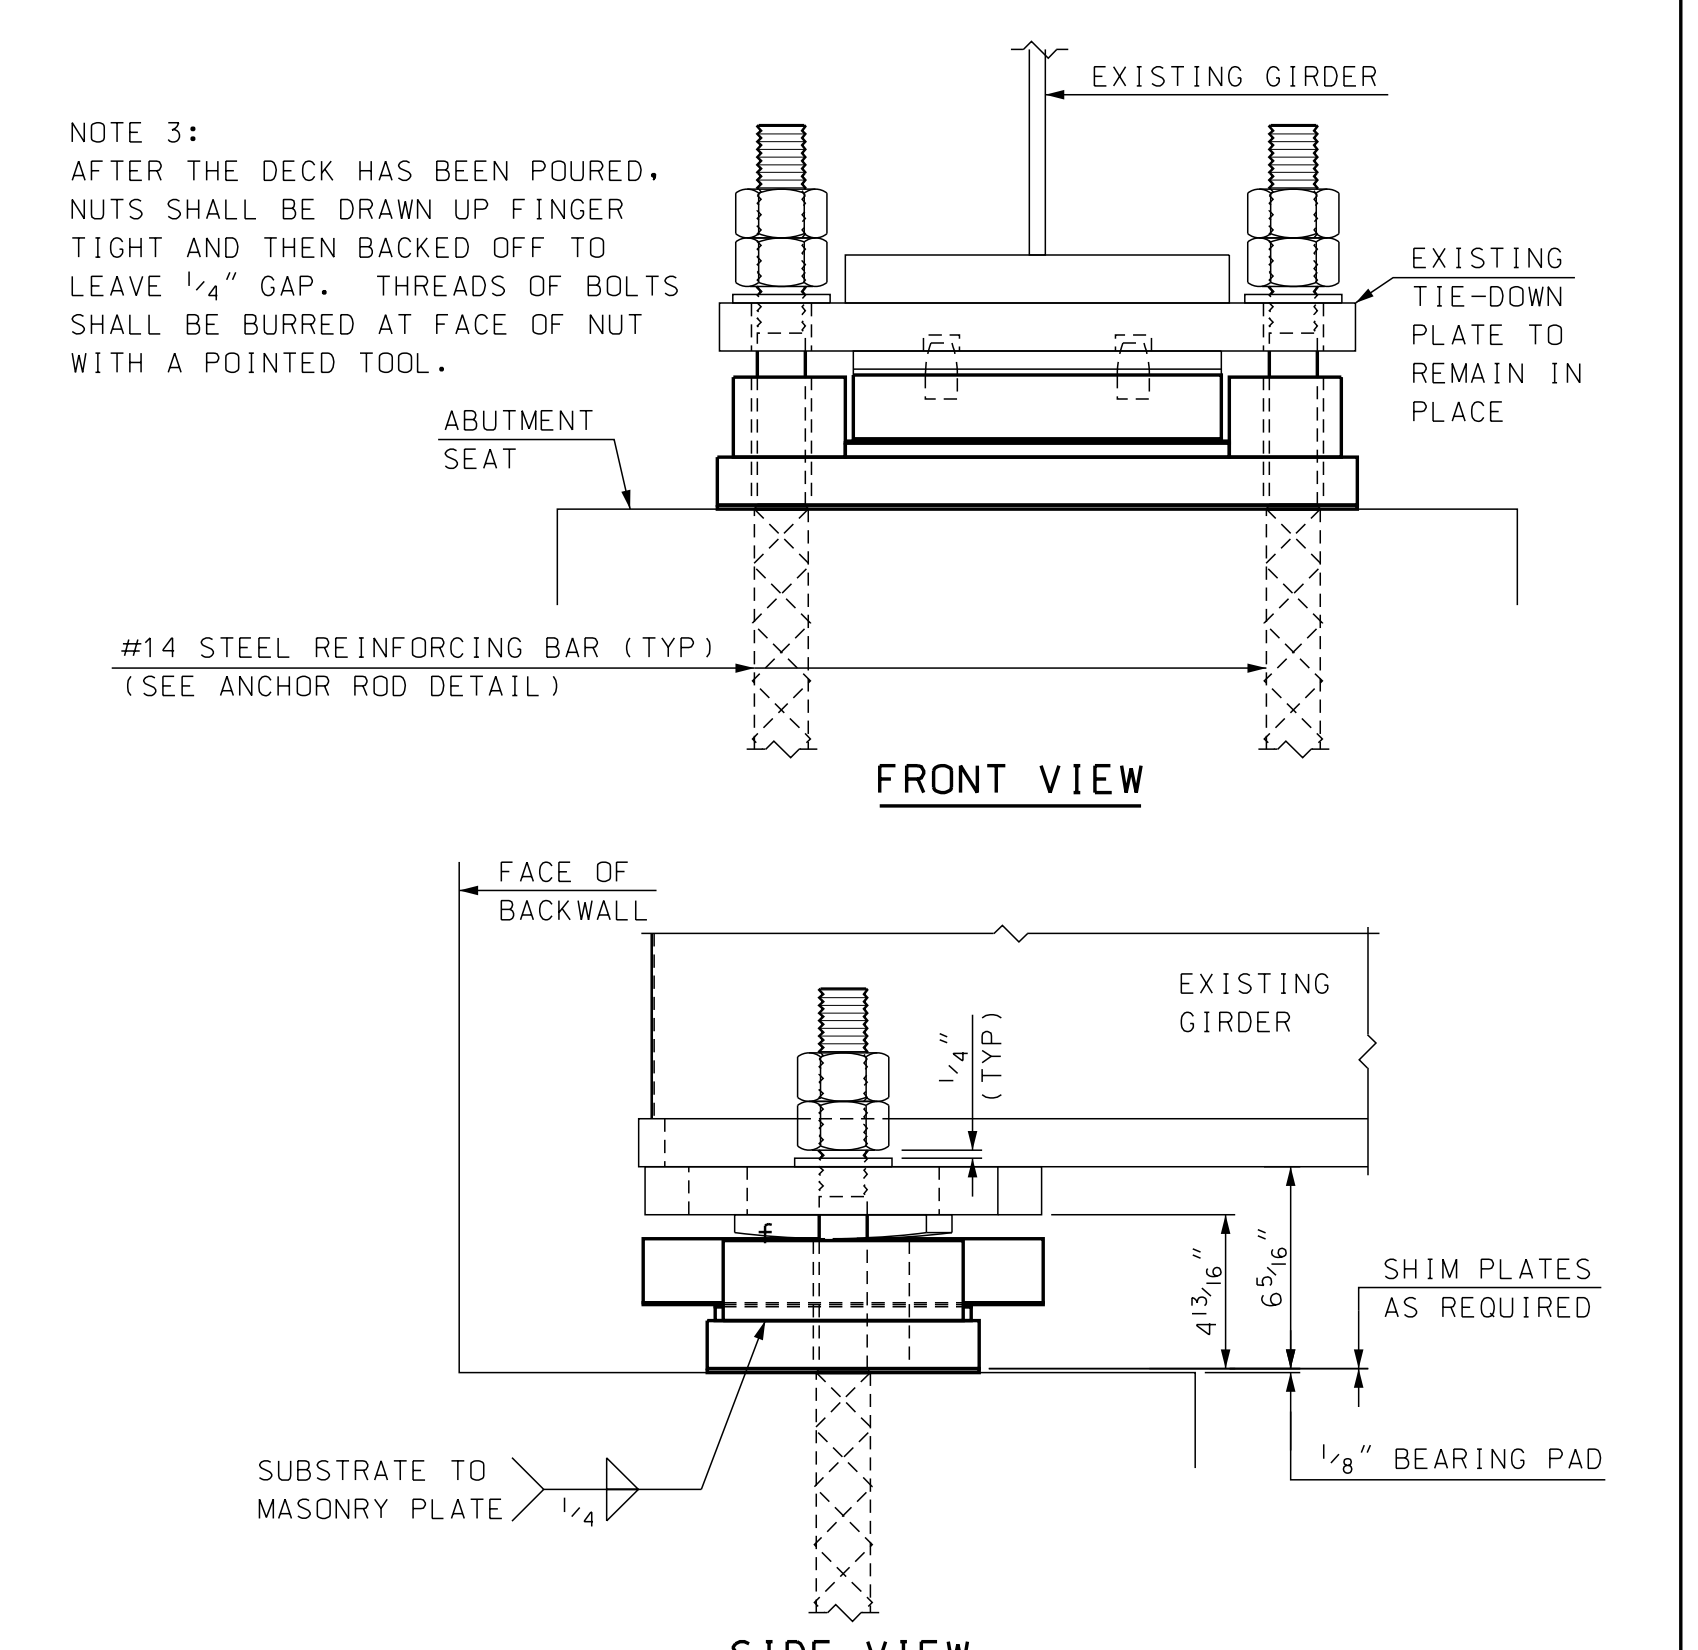


FRONT VIEW
SIDE VIEW

- BEARING NOTES**
- EXPANSION SHOE ASSEMBLIES, INCLUDING ANCHOR RODS, NUTS, WASHERS, SHIMS, AND BEARING PADS, SHALL BE PAID FOR AS ITEM 550.2, BRIDGE SHOES (F).
 - STEEL PLATES SHALL CONFORM TO AASHTO M270, GRADE 50W (ASTM A709, GRADE 50W). EXPOSED ASSEMBLED SURFACES SHALL BE GALVANIZED IN ACCORDANCE WITH SECTION 550.2.9 OF THE NHDOT STANDARD SPECIFICATIONS, 2010.
 - ALL PLATES SHALL BE FLAT AND TRUE AFTER WELDING.
 - ANCHOR RODS SHALL BE GALVANIZED AND FABRICATED IN ACCORDANCE WITH SECTION 550.2.5 OF THE NHDOT STANDARD SPECIFICATIONS, 2010
 - BEARING SURFACES MARKED "f", OR SURFACES IN CONTACT TO BE WELDED, SHALL BE FINISHED IN ACCORDANCE WITH AASHTO LRFD BRIDGE CONSTRUCTION SPECIFICATIONS, SECTION 11.4.6.
 - THE PREFORMED FABRIC PADS SHALL CONFORM TO SECTION 550.2.6 OF THE NHDOT STANDARD SPECIFICATIONS.
 - PROVIDE 2 - 1/16" SHIMS AND 1 - 1/8" SHIM FOR EACH BEARING ASSEMBLY.
 - EXISTING PLATES TO REMAIN IN PLACE SHALL BE BLAST CLEANED AND GALVANIZED. THE EXISTING PAINT SYSTEM ON THE BRIDGE SHOES IS LEAD BEARING PAINT.

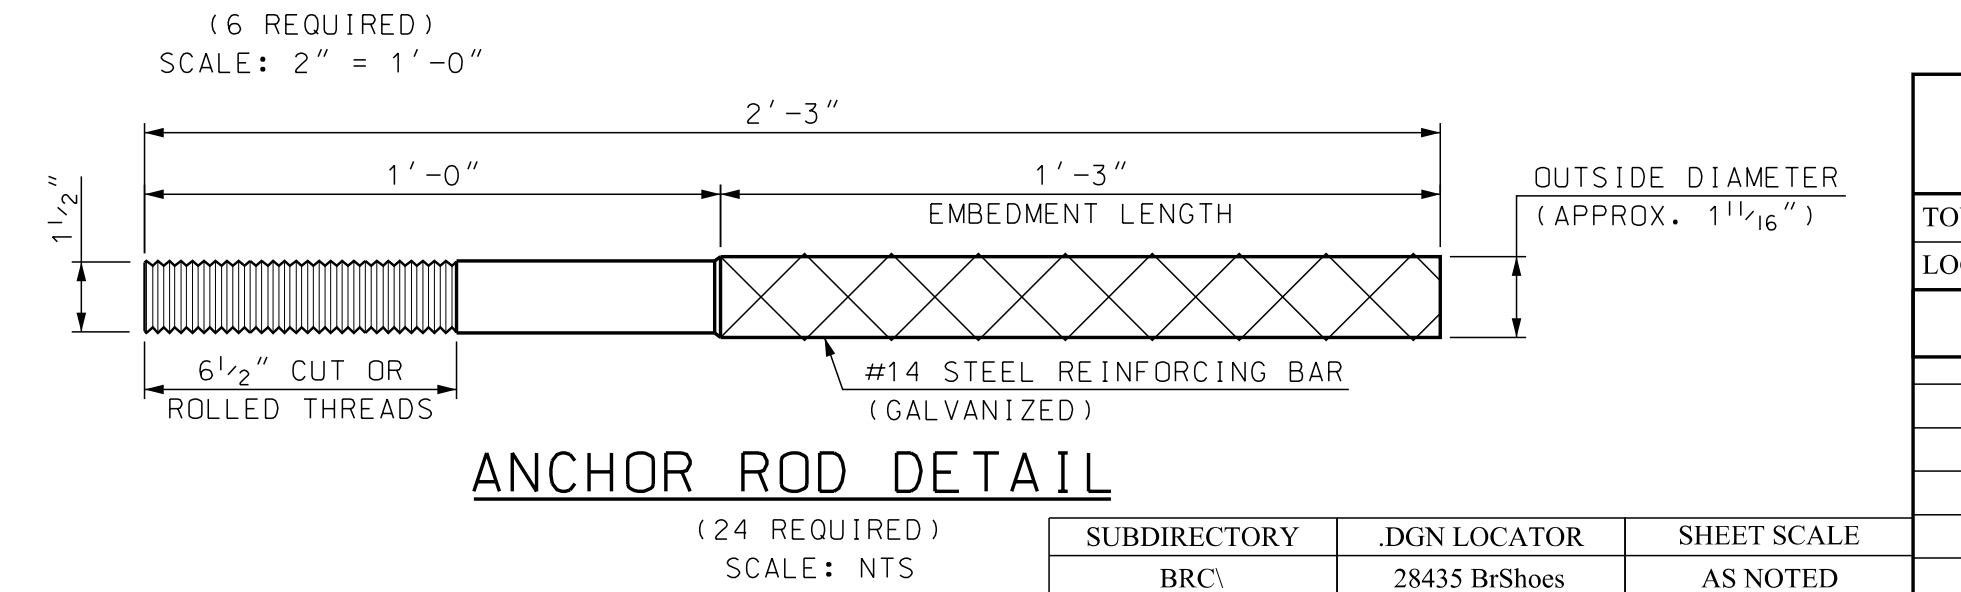

ANCHOR ROD DETAIL
 (24 REQUIRED)
 SCALE: NTS

STATE OF NEW HAMPSHIRE					
DEPARTMENT OF TRANSPORTATION * BUREAU OF BRIDGE DESIGN					
TOWN	HOOKSETT	BRIDGE NO.	080/148	STATE PROJECT	28435
LOCATION MAIN STREET over B&M RR, MERRIMACK RIVER, & RIVERSIDE STREET					
ABUTMENT A & B BRIDGE SHOES					BRIDGE SHEET
					7 OF 18
DESIGNED	JAT	8/14	CHECKED	SMG	8/14
DRAWN	SMG	8/14	CHECKED	JAT	8/14
QUANTITIES	SMG	9/14	CHECKED	JAT	9/14
ISSUE DATE	FEDERAL PROJECT NO.			SHEET NO.	TOTAL SHEETS
REV. DATE	-----			11	42

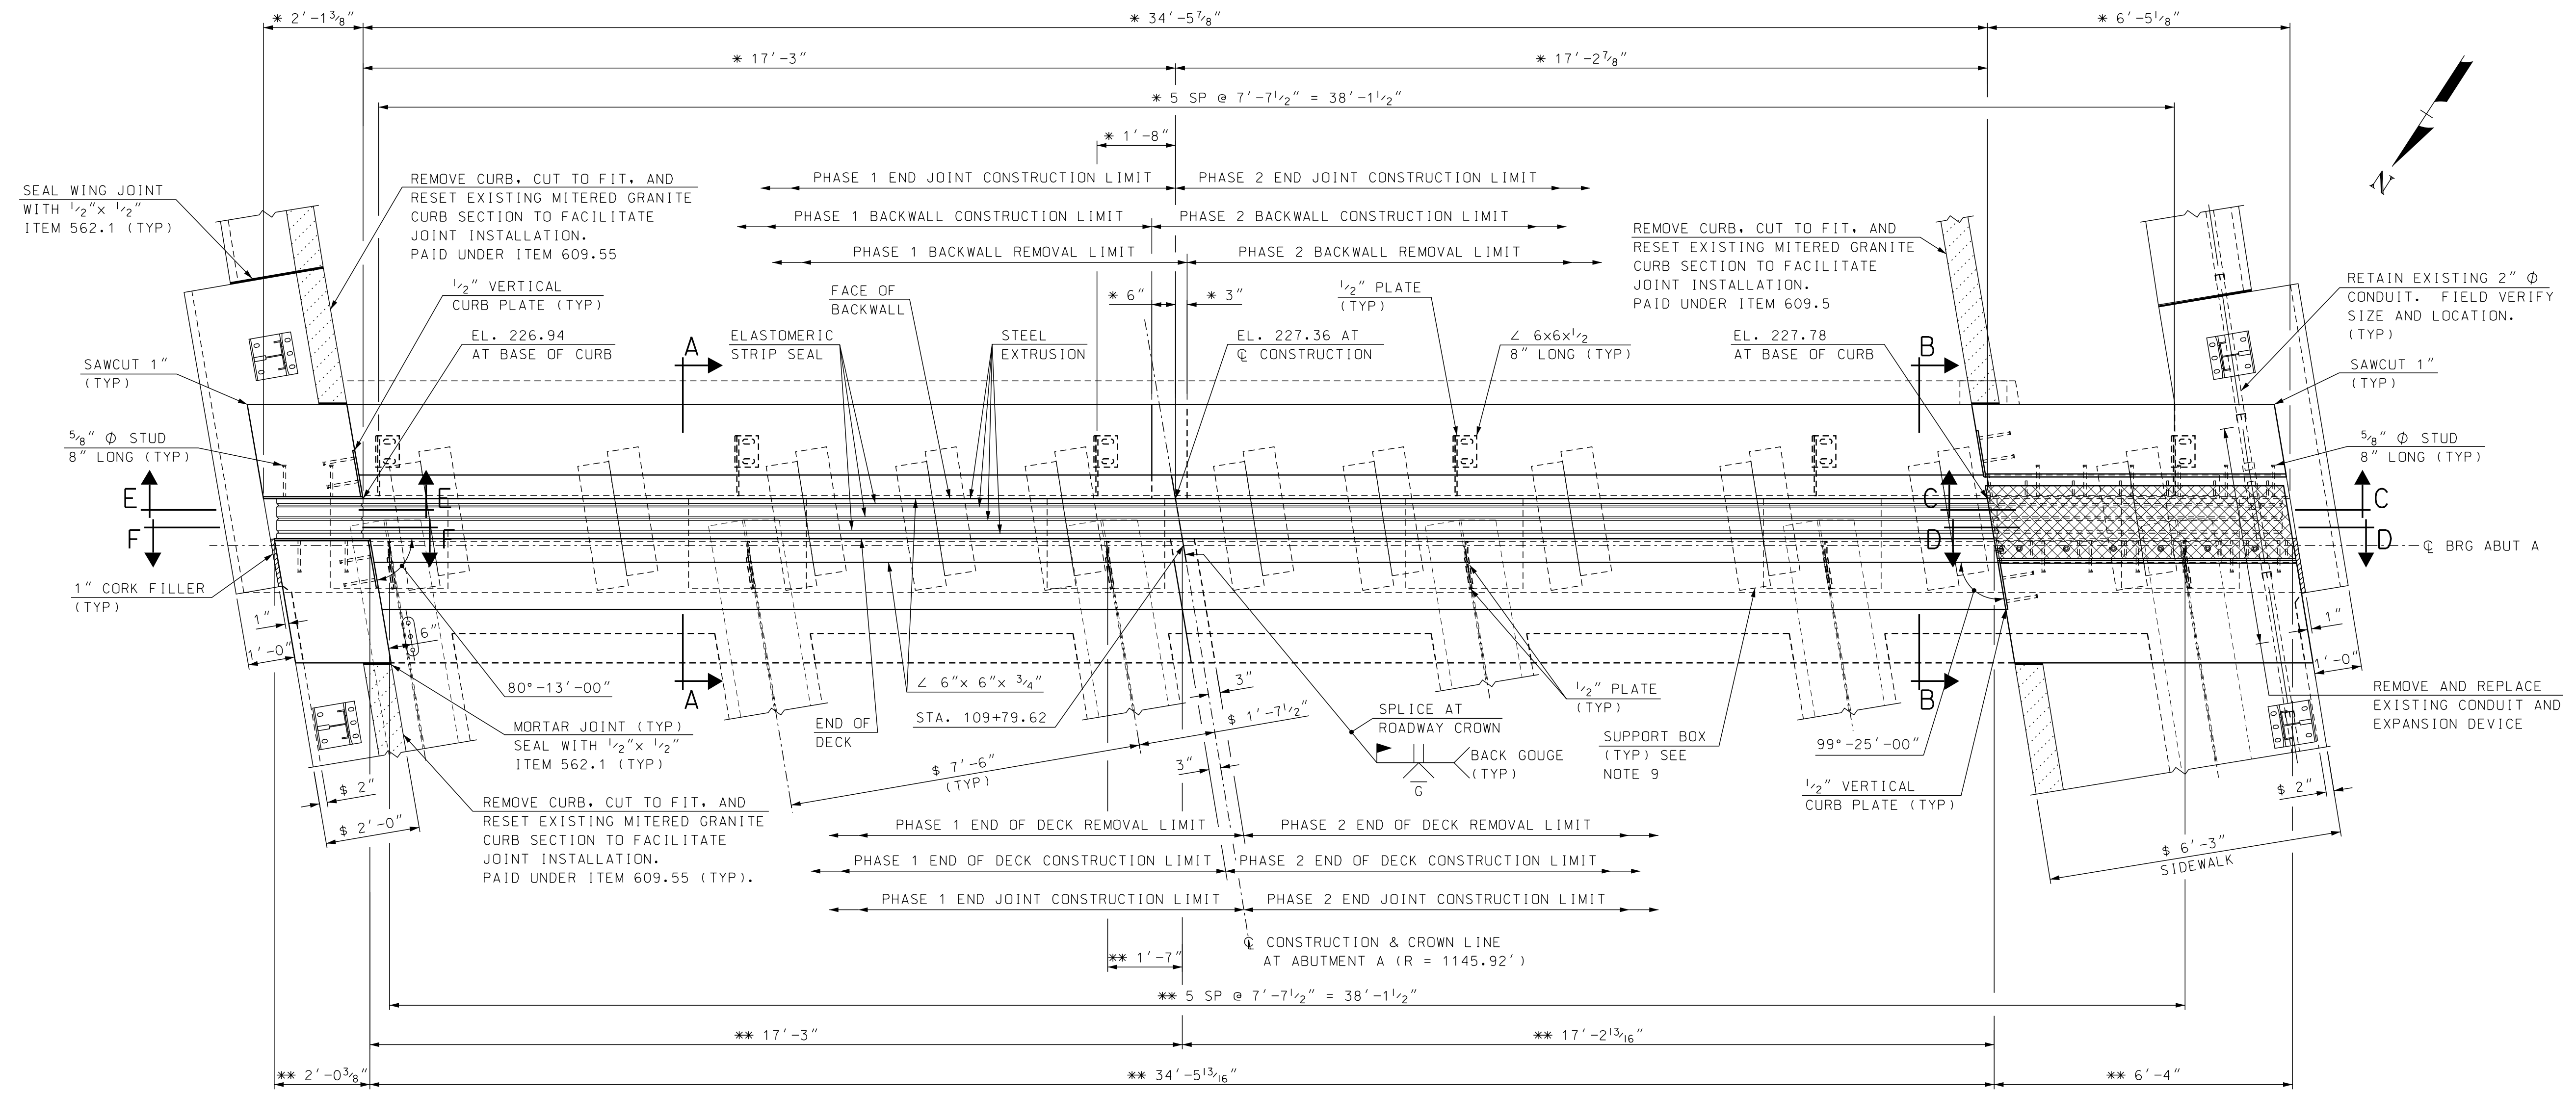

PLAN VIEW

SCALE: 1/2" = 1'-0"


§ RADIAL DIMENSION
 * DIMENSION ALONG FACE OF BACKWALL
 ** DIMENSION ALONG END OF DECK

EXPANSION JOINT NOTES

1. THE MODULAR JOINT SHOWN IS REPRESENTATIVE OF THE TYPE OF EXPANSION JOINT ACCEPTABLE FOR USE. THE EXACT JOINT CONFIGURATION WILL DEPEND UPON THE MANUFACTURER'S DETAILS. SHOP DRAWINGS OF MODULAR EXPANSION JOINT SYSTEM INCLUDING BARRIER/CURB DETAILS, PLACEMENT DETAILS, AND SHIPPING DEVICES SHALL BE SUBMITTED TO THE ENGINEER FOR APPROVAL. THE ENTIRE ASSEMBLY, INCLUDING ELASTOMERIC SEALS, SHALL BE PAID FOR AS ITEM 561.2001, PREFABRICATED MODULAR BRIDGE JOINT SYSTEM (F) (SEE SPECIAL PROVISION).
2. EXPANSION JOINT STEEL SHALL BE AASHTO M223 (ASTM A572) GRADE 50. THE MINOR STEEL PLATES AND EXTRUSIONS MAY CONFORM TO AASHTO M183 (ASTM A36). ALL STEEL SHALL BE GALVANIZED.
3. SPLICES FOR EXPANSION JOINT STEEL SHALL DEVELOP FULL STRENGTH.
4. ELASTOMERIC SEALS SHALL BE FURNISHED IN ONE CONTINUOUS LENGTH. NO SPLICES WILL BE ALLOWED.
5. THE EXPANSION JOINT MANUFACTURER SHALL INCLUDE A TEMPERATURE SETTING TABLE FOR THE EXPANSION JOINT LOCATION ON THE SHOP DRAWINGS.
6. MINIMUM INSTALLATION WIDTH "T" = 10 1/4" AT 65°F. ADJUSTMENT IN OPENING FOR A 15°F CHANGE IN TEMPERATURE = 3/8".
7. THE MODULAR BRIDGE JOINT SYSTEM SHALL HAVE A RANGE OF MOVEMENT OF 3.69". THE CONTRACTOR SHALL USE MODULAR BRIDGE JOINT SYSTEM STM SERIES BY WATSON BOWMAN ACME OR D SERIES BY D.S. BROWN. THIS DESIGN INCLUDES MOVEMENT DUE TO TEMPERATURE, SKEW, AND MINIMUM INSTALLATION.
8. JOINT SUPPORT PLATES AND HARDWARE SHALL BE SHOP WELDED TO THE EXPANSION JOINT STEEL AND SHALL BE DETAILED TO ALLOW FOR ALL NECESSARY ADJUSTMENTS TO ACCOMMODATE ROADWAY CROSS SLOPE, GRADE, AND TEMPERATURE SETTINGS.
9. SUPPORT BOXES AND BARS SHALL BE DESIGNED BY THE MANUFACTURER. TYPE, SIZE, AND LOCATION SHALL BE DETERMINED BY THE MANUFACTURER.
10. STIFFENER PLATES, STUDS, AND ANCHORAGES MAY NEED TO SHIFTED FROM THE LAYOUT AS SHOWN ON THESE PLANS BASED ON THE MANUFACTURER'S DESIGN OF THE SUPPORT BOXES AND BARS.
11. PROTECT THE TOP OF THE EXPANSION JOINT DURING PLACEMENT OF CONCRETE AND BITUMINOUS PAVEMENT.
12. ELEVATIONS SHOWN AT THE TOP OF THE EXPANSION JOINT STEEL ARMOR ANGLES AND BEAMS ARE 1/8" LOWER THAN ADJACENT PROPOSED FINISHED ROADWAY GRADE.
13. NO "LOW PROFILE" STEEL EXTRUSIONS SHALL BE ALLOWED.
14. NO REINFORCING STEEL SHALL BE CUT TO CLEAR THE BRIDGE EXPANSION DEVICE WITHOUT PRIOR APPROVAL OF THE ENGINEER.
15. IMMEDIATELY AFTER THE JOINT HAS BEEN SECURED TO THE STRUCTURAL STEEL AND BACKWALL, REMOVE SHIPPING DEVICES AND GRIND SMOOTH ANY WELDS ON EXPOSED SURFACES. REPAIR ANY DAMAGE TO GALVANIZED SURFACES PER SECTION 550
16. SEE BRIDGE SHEETS 7 & 8 FOR SECTIONS A-A, B-B, C-C, D-D AND E-E.

STATE OF NEW HAMPSHIRE					
DEPARTMENT OF TRANSPORTATION * BUREAU OF BRIDGE DESIGN					
TOWN	HOOKSETT	BRIDGE NO.	080/148	STATE PROJECT	28435
LOCATION MAIN STREET over B&M RR, MERRIMACK RIVER, & RIVERSIDE STREET					
ABUTMENT A EXPANSION JOINT (1 OF 3)					BRIDGE SHEET
REVISIONS AFTER PROPOSAL				BY	DATE
DESIGNED	JAT	12/13	CHECKED	SMG	8/14
DRAWN	SMG	12/13	CHECKED	JAT	8/14
QUANTITIES	SMG	9/14	CHECKED	JAT	9/14
ISSUE DATE	FEDERAL PROJECT NO.			SHEET NO.	TOTAL SHEETS
REV. DATE	-----			12	42

SUBDIRECTORY	DGN LOCATOR	SHEET SCALE
BRC\	28435 Exp Jt A	AS NOTED

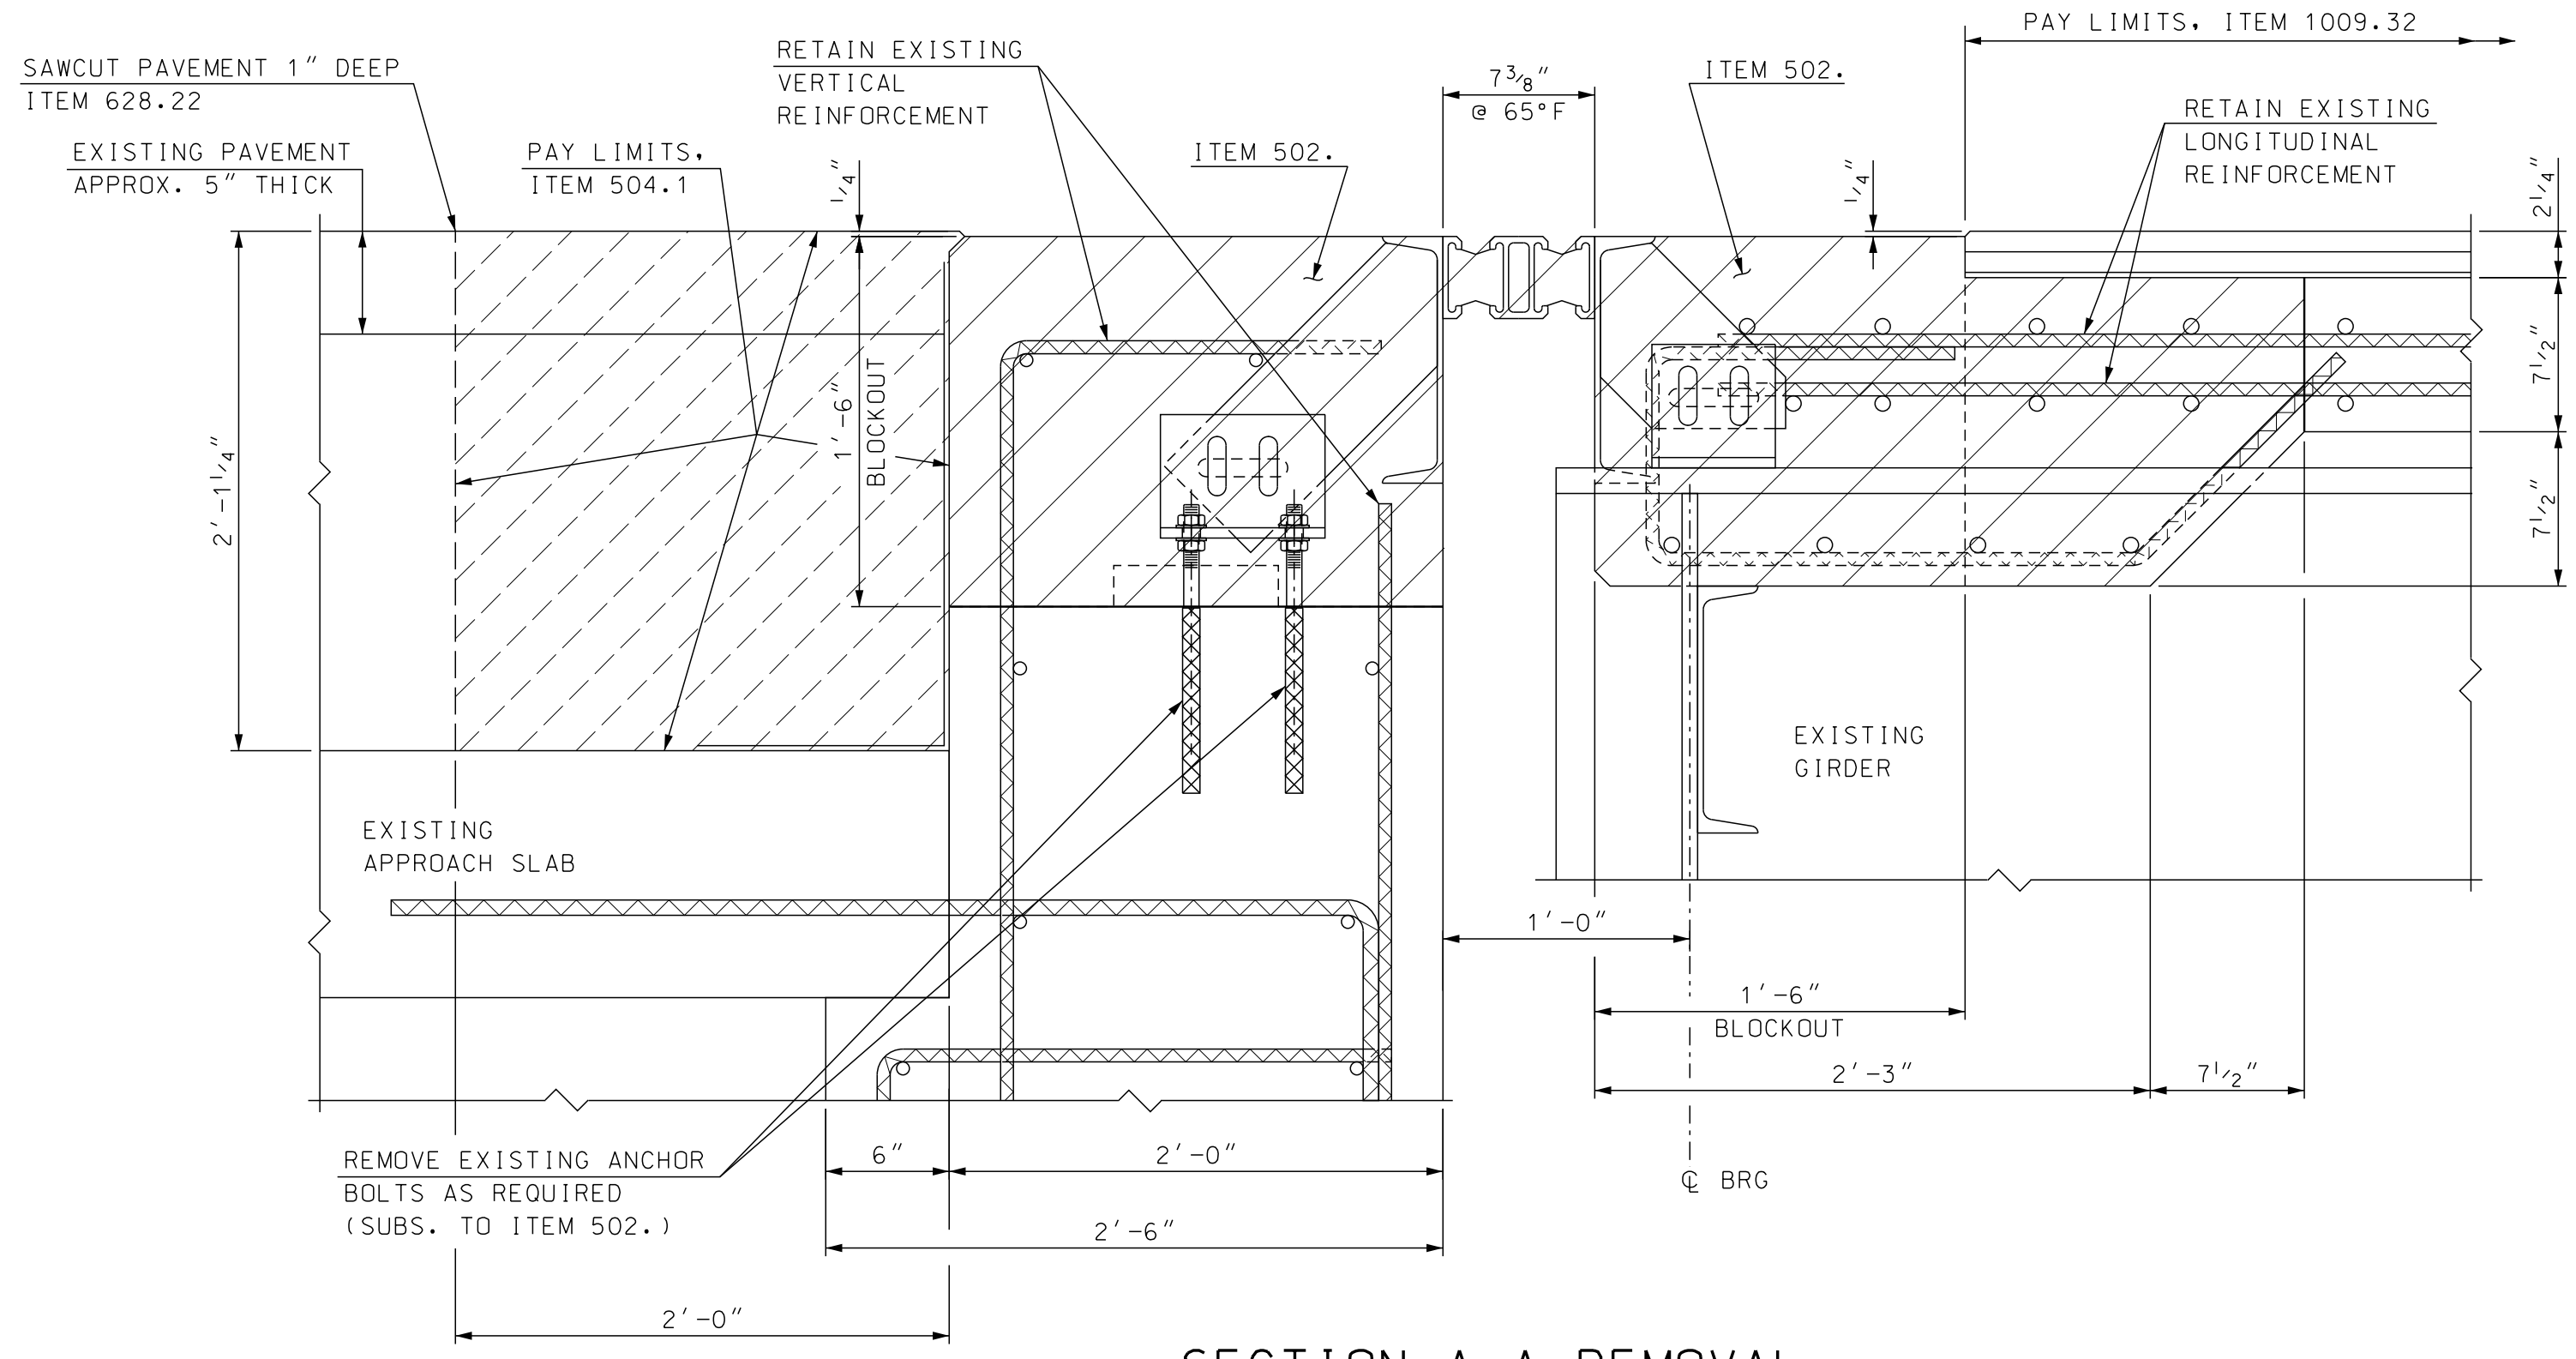


SECTION A-A REMOVAL
SCALE: 1 1/2" = 1'-0"


TEMPERATURE ADJUSTMENT TABLE	
TEMPERATURE	"T"
20°F	11 3/8"
35°F	11"
50°F	10 5/8"
65°F	10 1/4"
80°F	9 7/8"
95°F	9 1/2"

TEMPERATURE ADJUSTMENT NOTES

- "T" DIMENSIONS ARE PERPENDICULAR TO FACE OF BACKWALL.
- MINIMUM "T" WIDTH FOR SEAL INSTALLATION = 10 1/4" (APPROXIMATELY 65°F OR LESS).
- VALUES IN THE TEMPERATURE ADJUSTMENT TABLE ARE FOR SETTING THE EXPANSION JOINT ASSEMBLY IMMEDIATELY PRIOR TO POURING CONCRETE BLOCKOUTS.

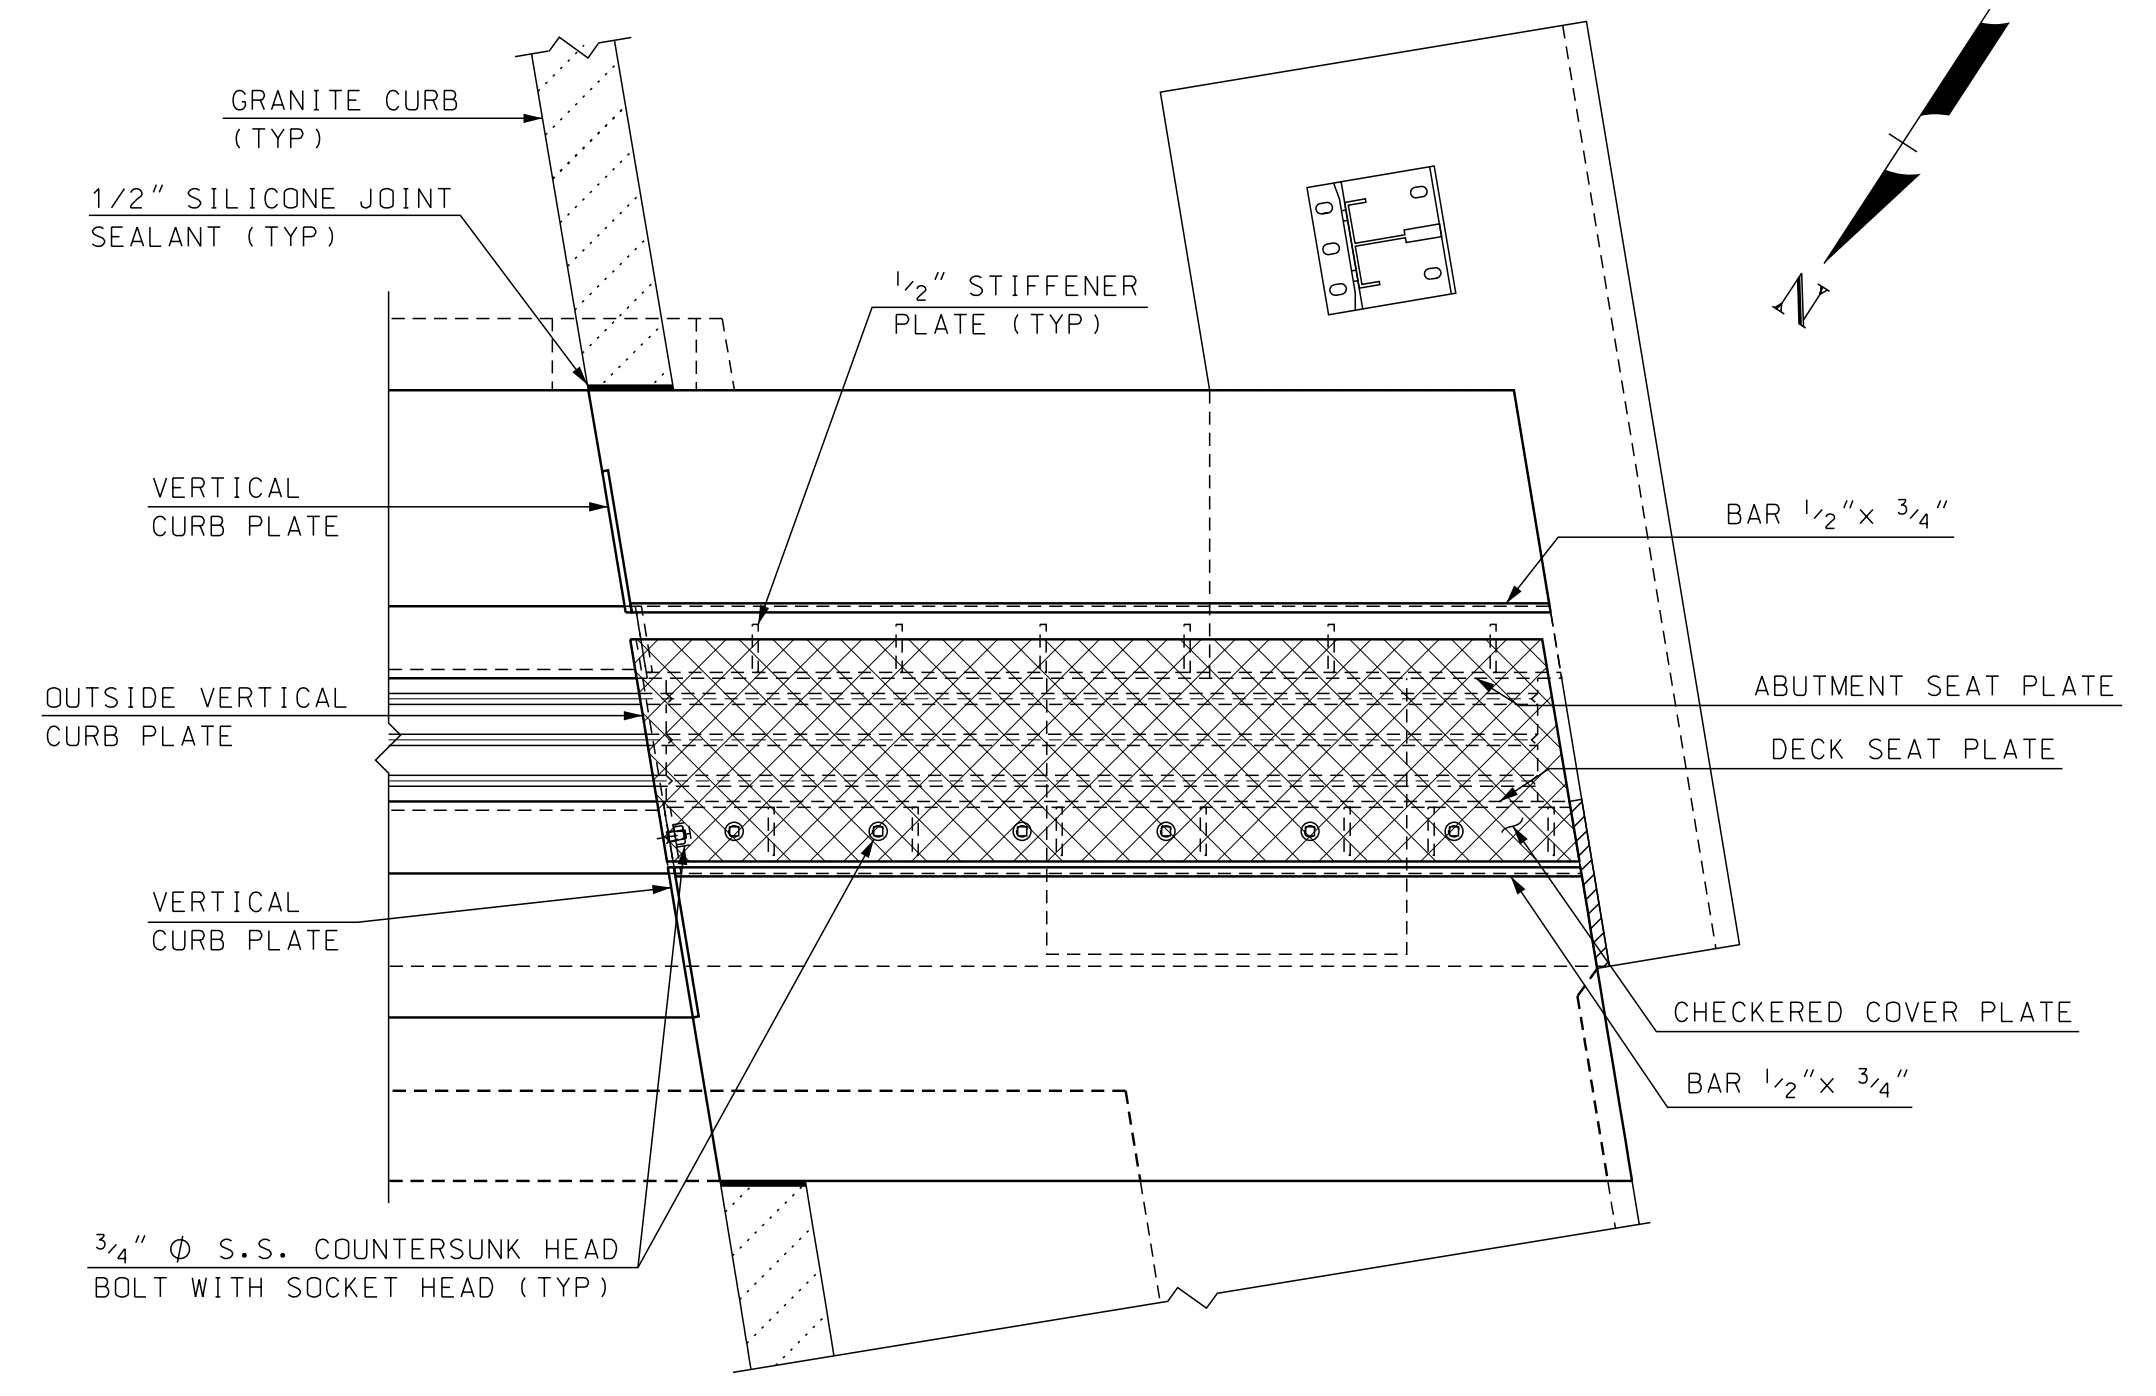


UPPER ASSEMBLY
SCALE: 3/4" = 1'-0"

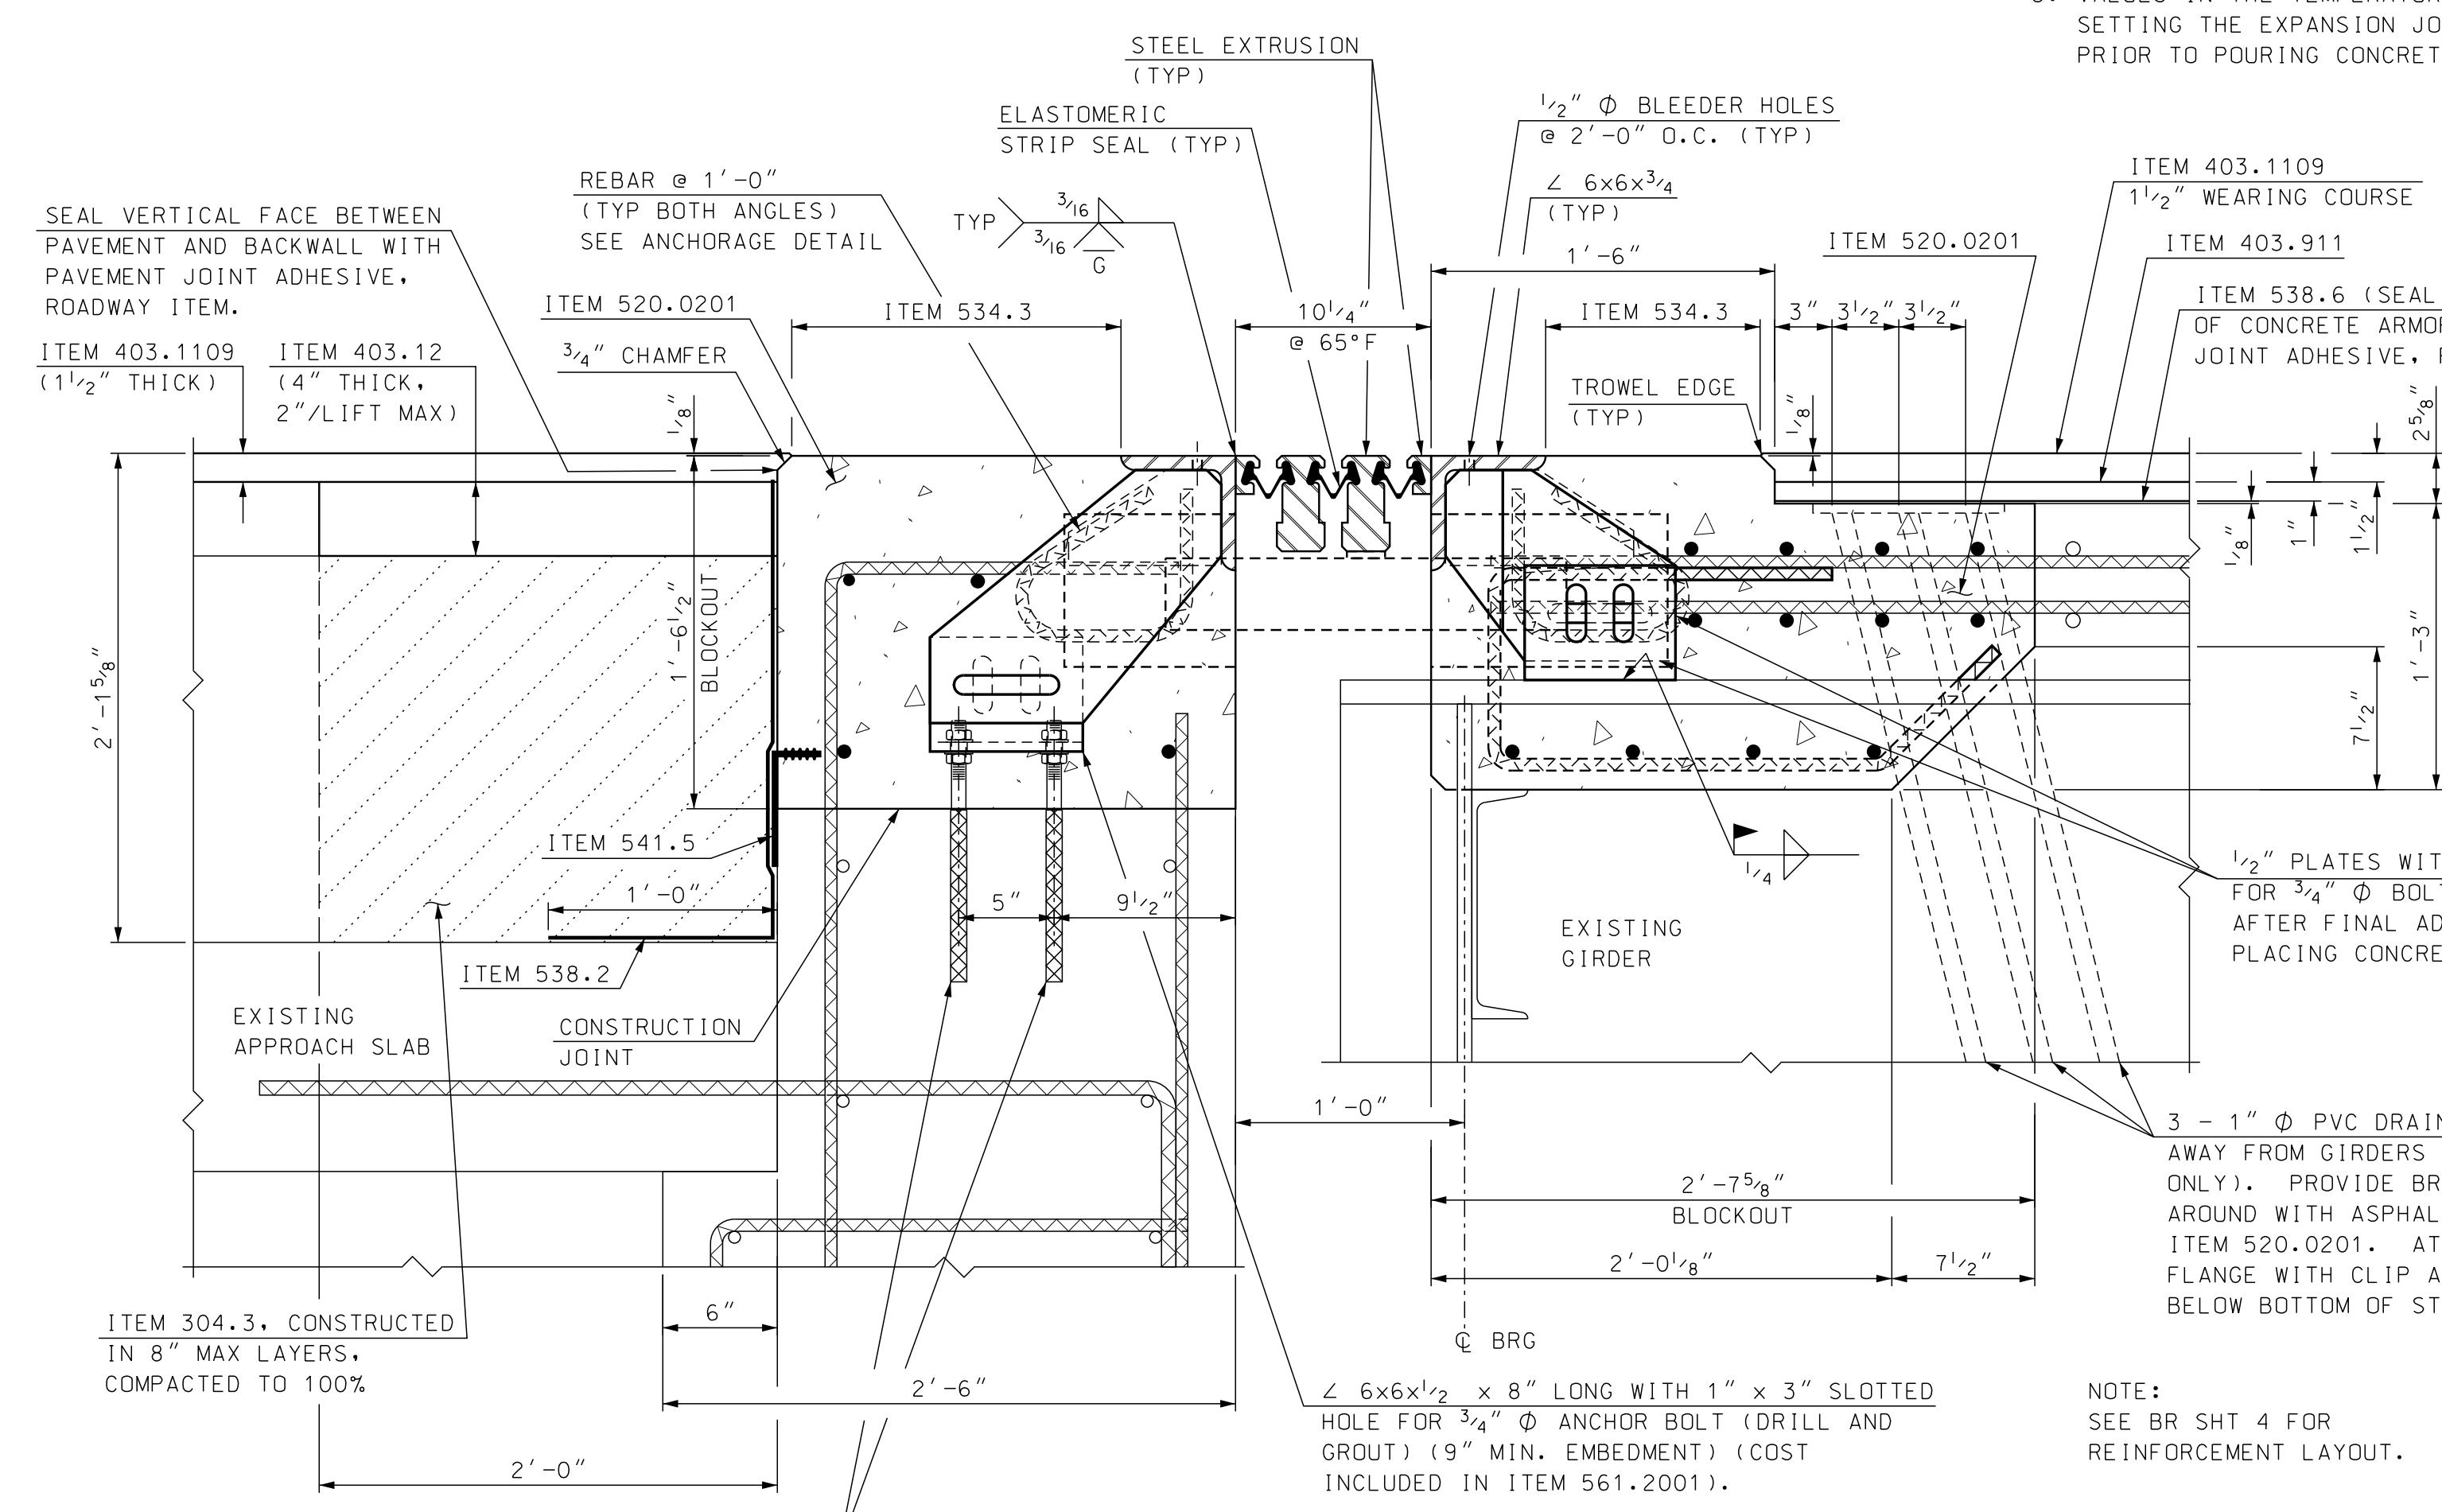

SECTION A-A CONSTRUCTION
SCALE: 1 1/2" = 1'-0"











NOTE:
SEE BR SHT 4 FOR REINFORCEMENT LAYOUT.

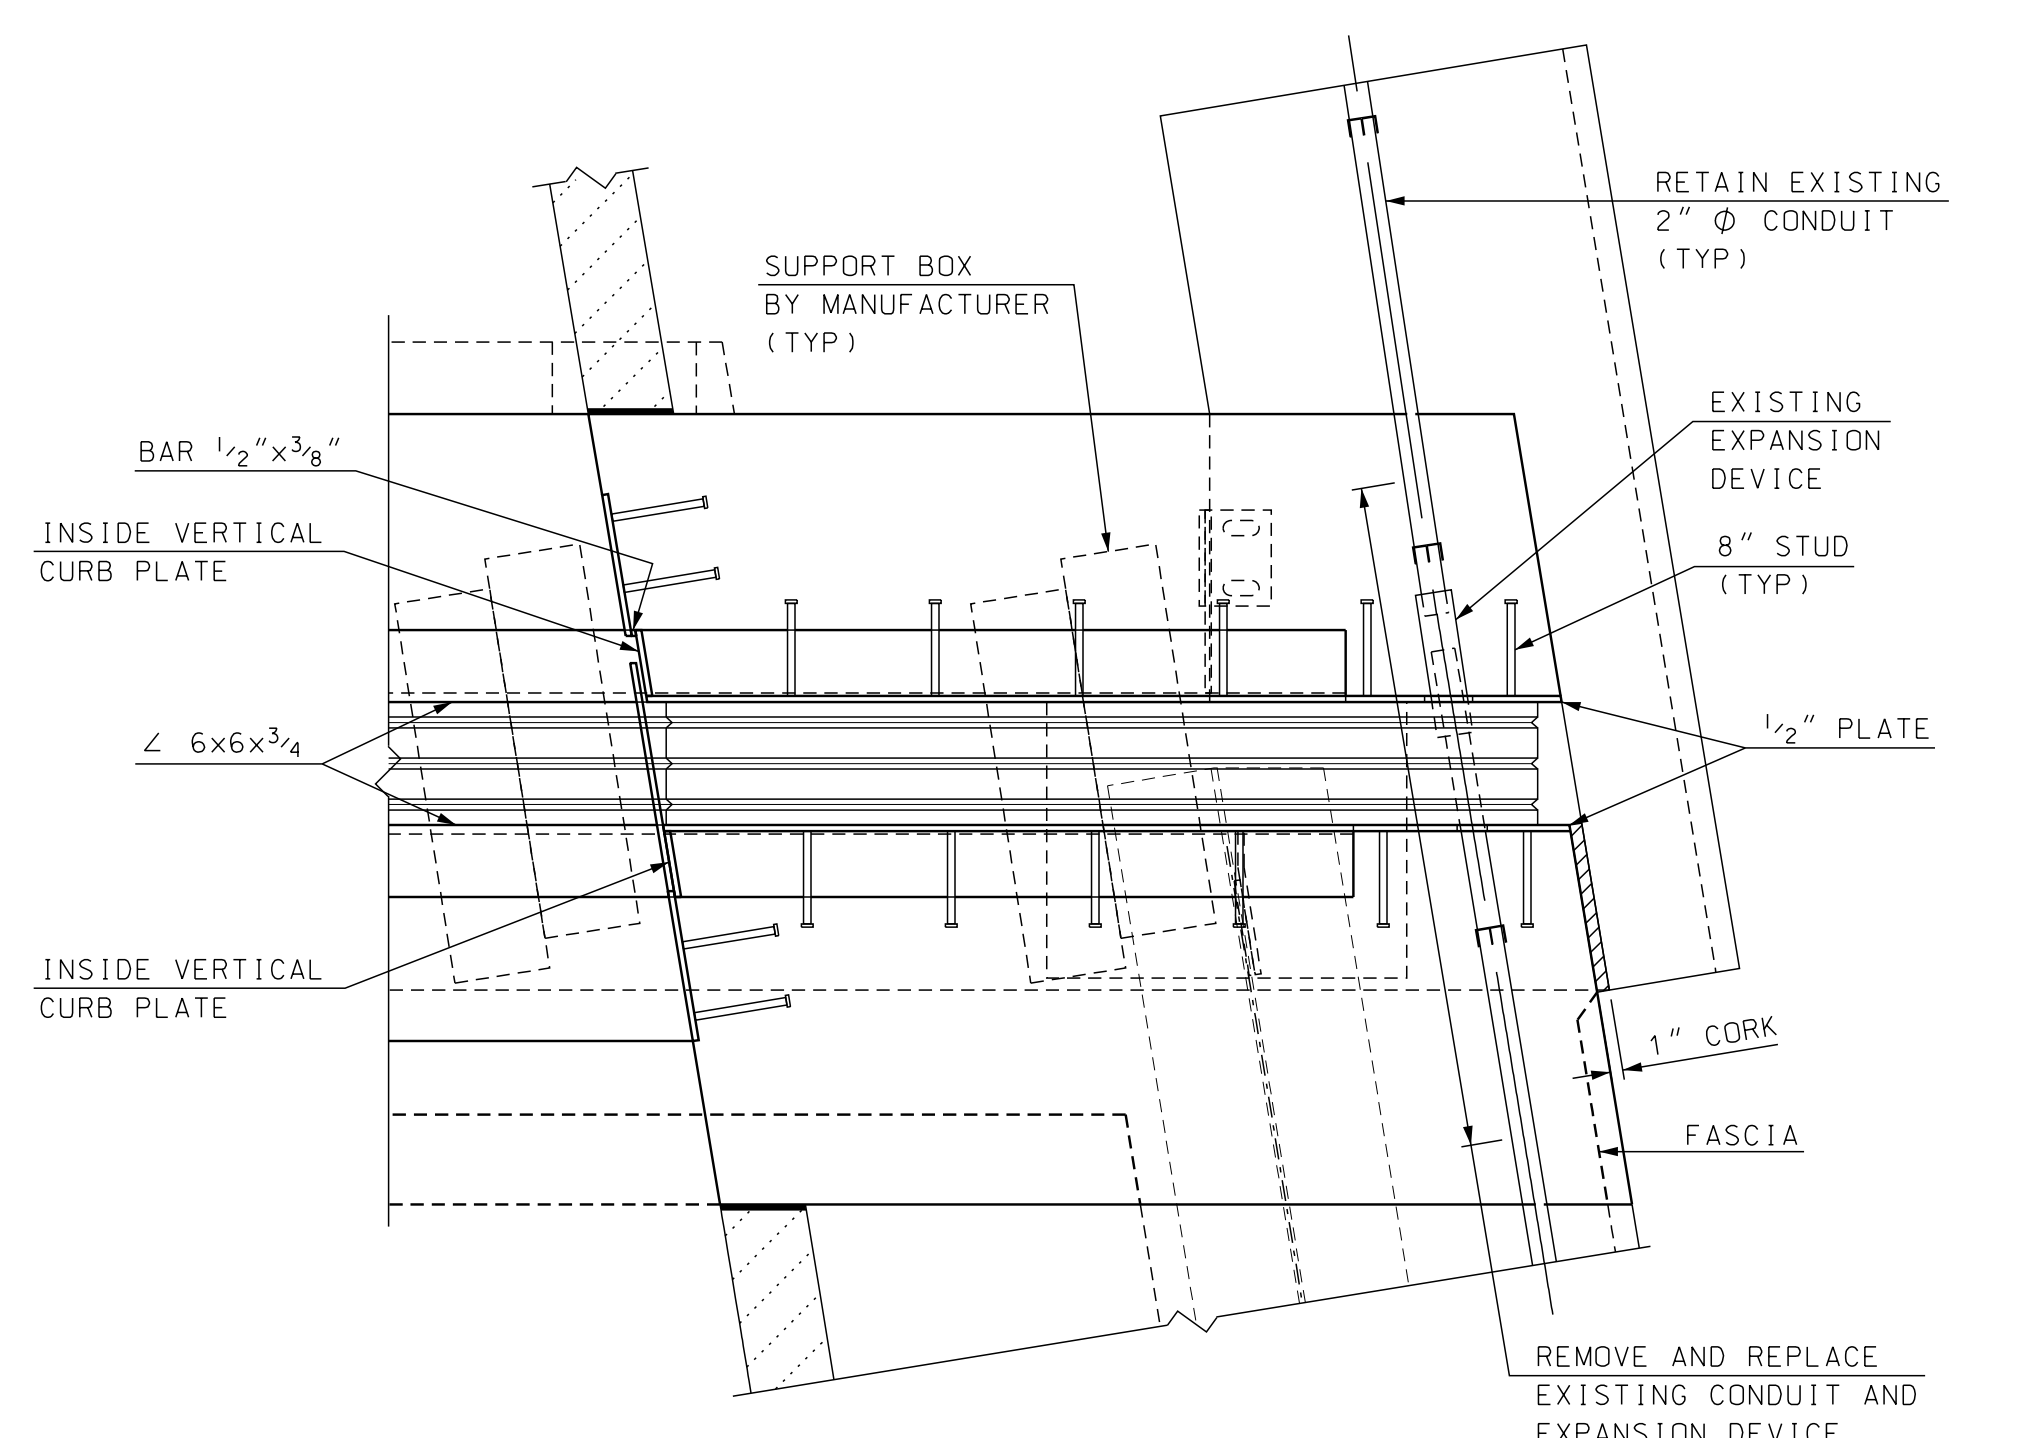

LOWER ASSEMBLY
SCALE: 3/4" = 1'-0"


STATE OF NEW HAMPSHIRE									
DEPARTMENT OF TRANSPORTATION * BUREAU OF BRIDGE DESIGN									
TOWN	HOOKSETT	BRIDGE NO.	080/148	STATE PROJECT	28435				
LOCATION MAIN STREET over B&M RR, MERRIMACK RIVER, & RIVERSIDE STREET									
ABUTMENT A EXPANSION JOINT (2 OF 3)								BRIDGE SHEET	
REVISIONS AFTER PROPOSAL								9 OF 18	
		BY	DATE	CHECKED	SMG	BY	DATE	FILE NUMBER	
		JAT	12/13	JAT	8/14	126-1-1			
		SMG	12/13	JAT	8/14				
		SMG	9/14	JAT	9/14				
ISSUE DATE		FEDERAL PROJECT NO.			SHEET NO.		TOTAL SHEETS		
REV. DATE		-----			13		42		

SUBDIRECTORY	DGN LOCATOR	SHEET SCALE
BRC\	28435 Exp Jt A	AS NOTED

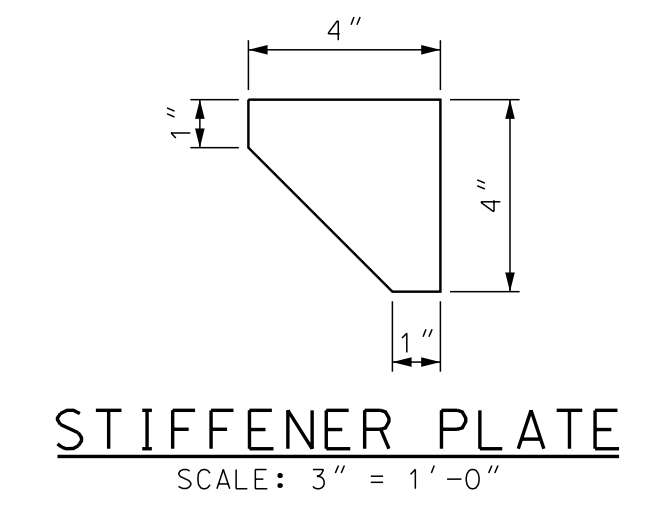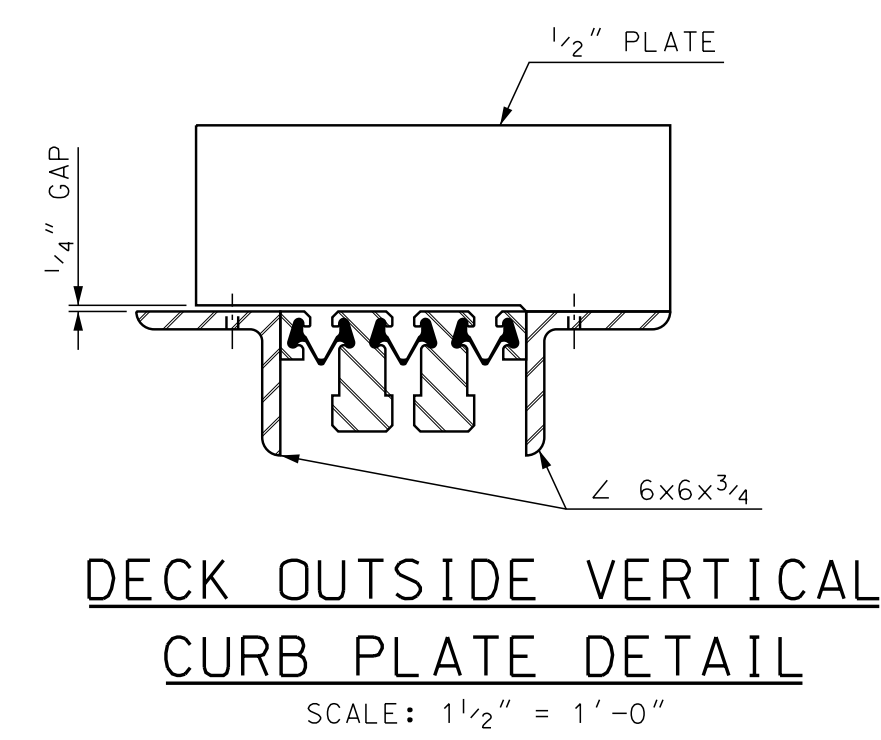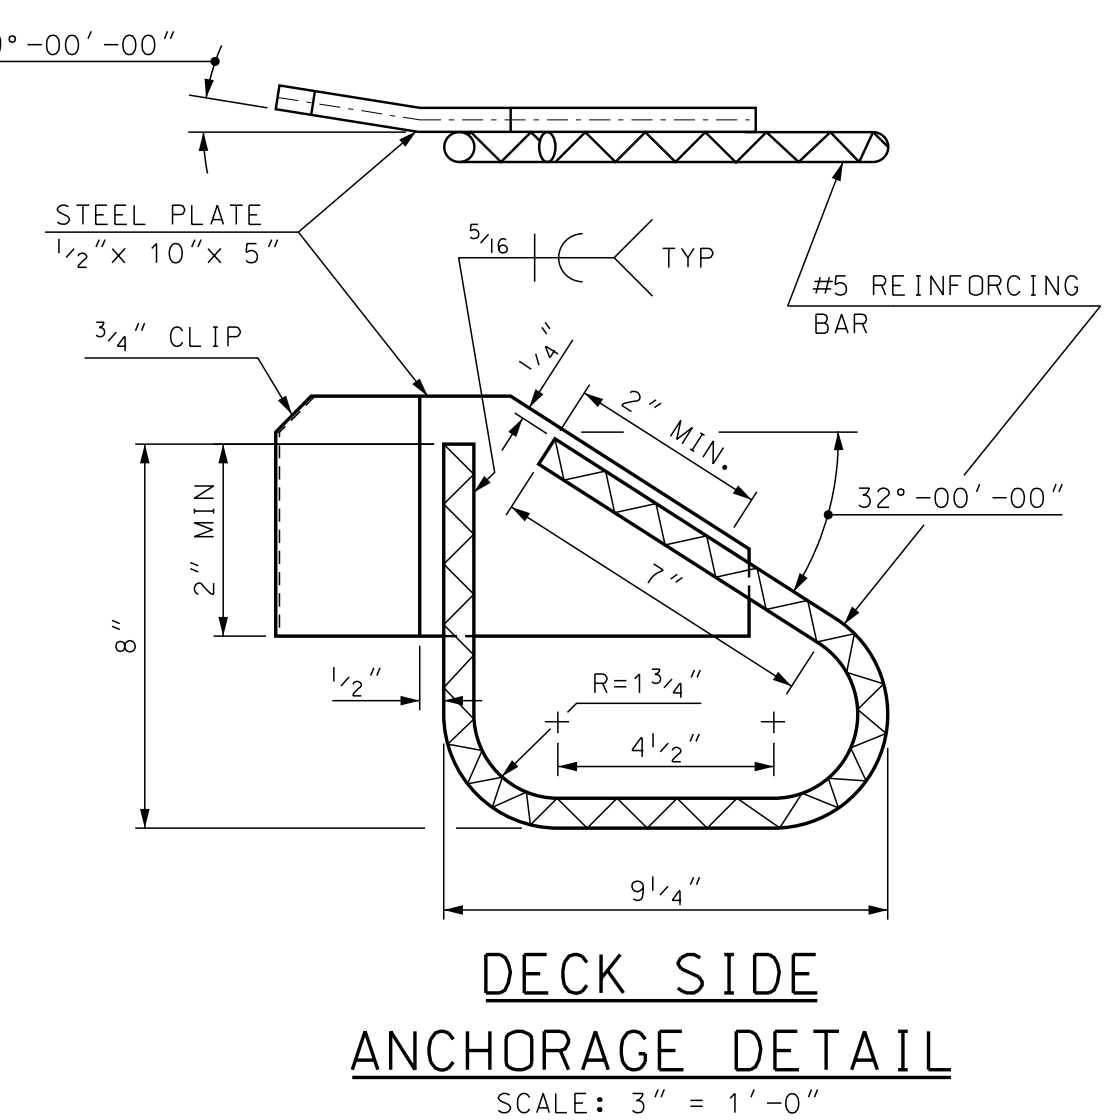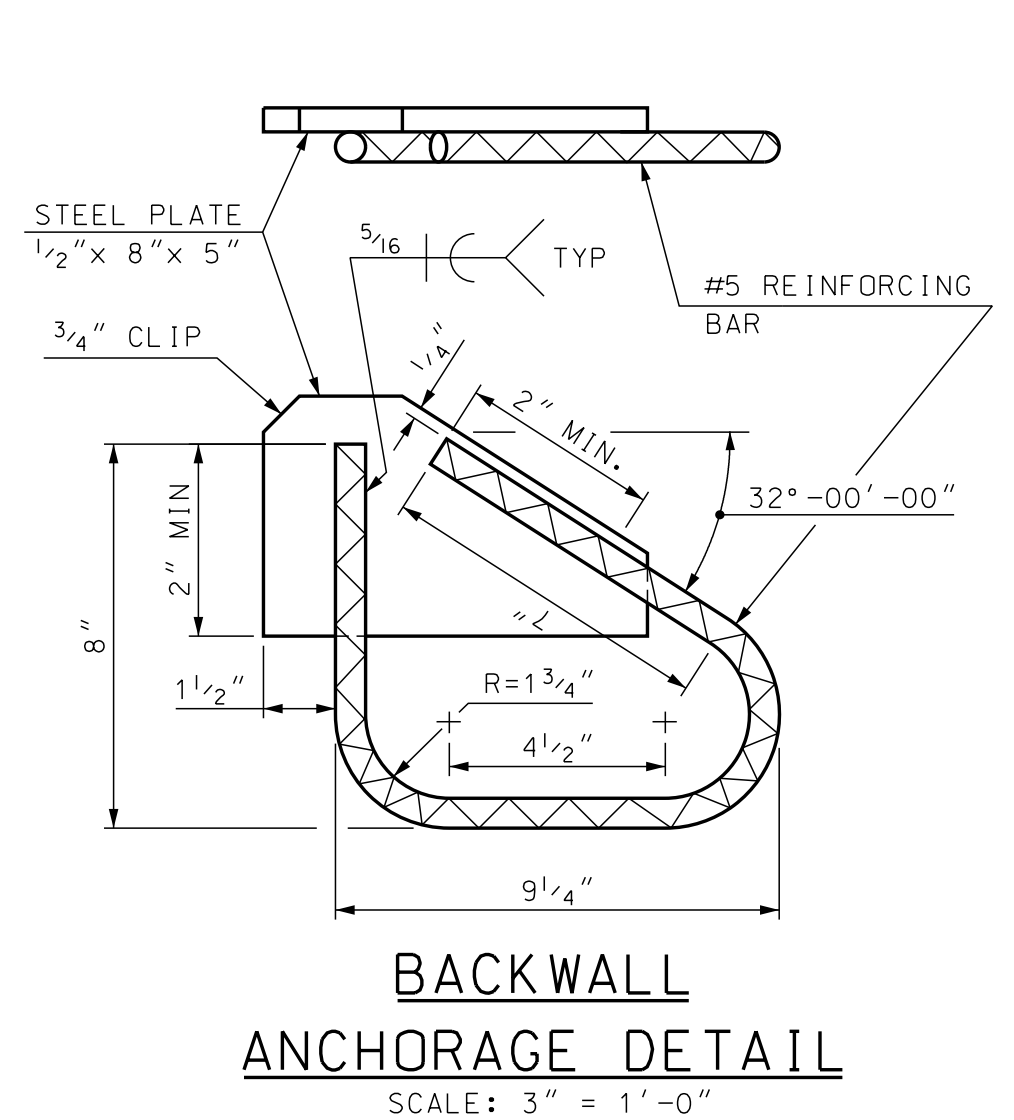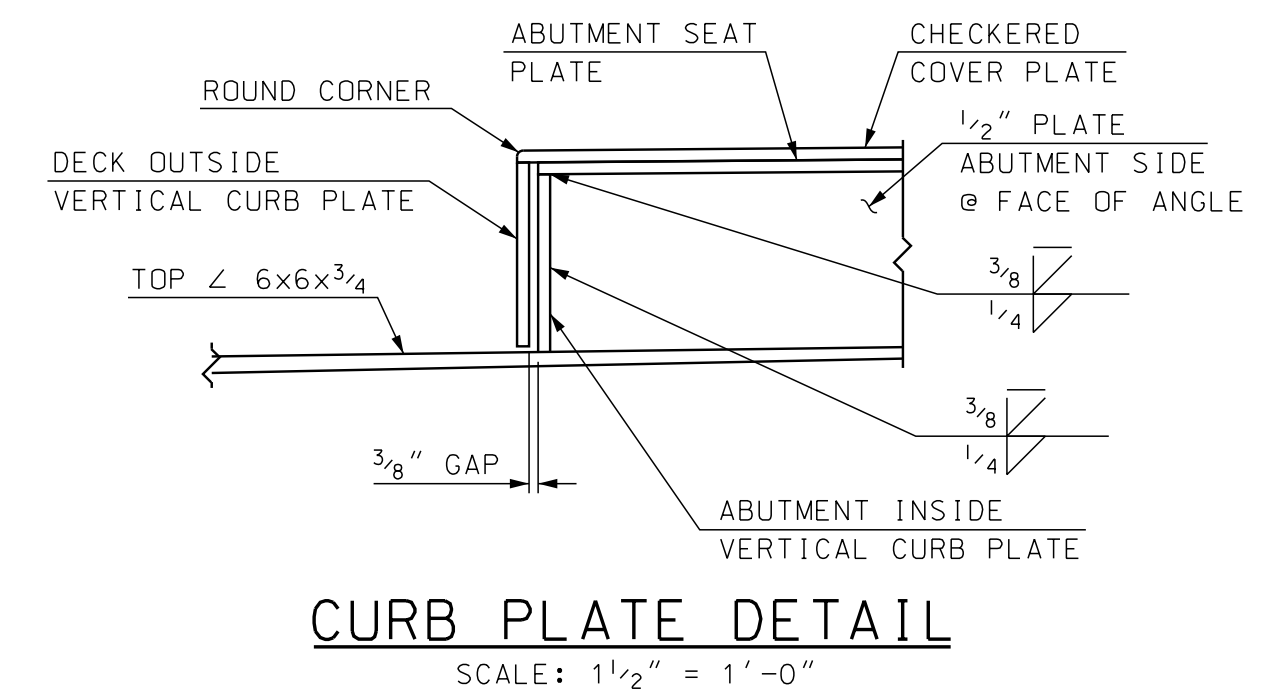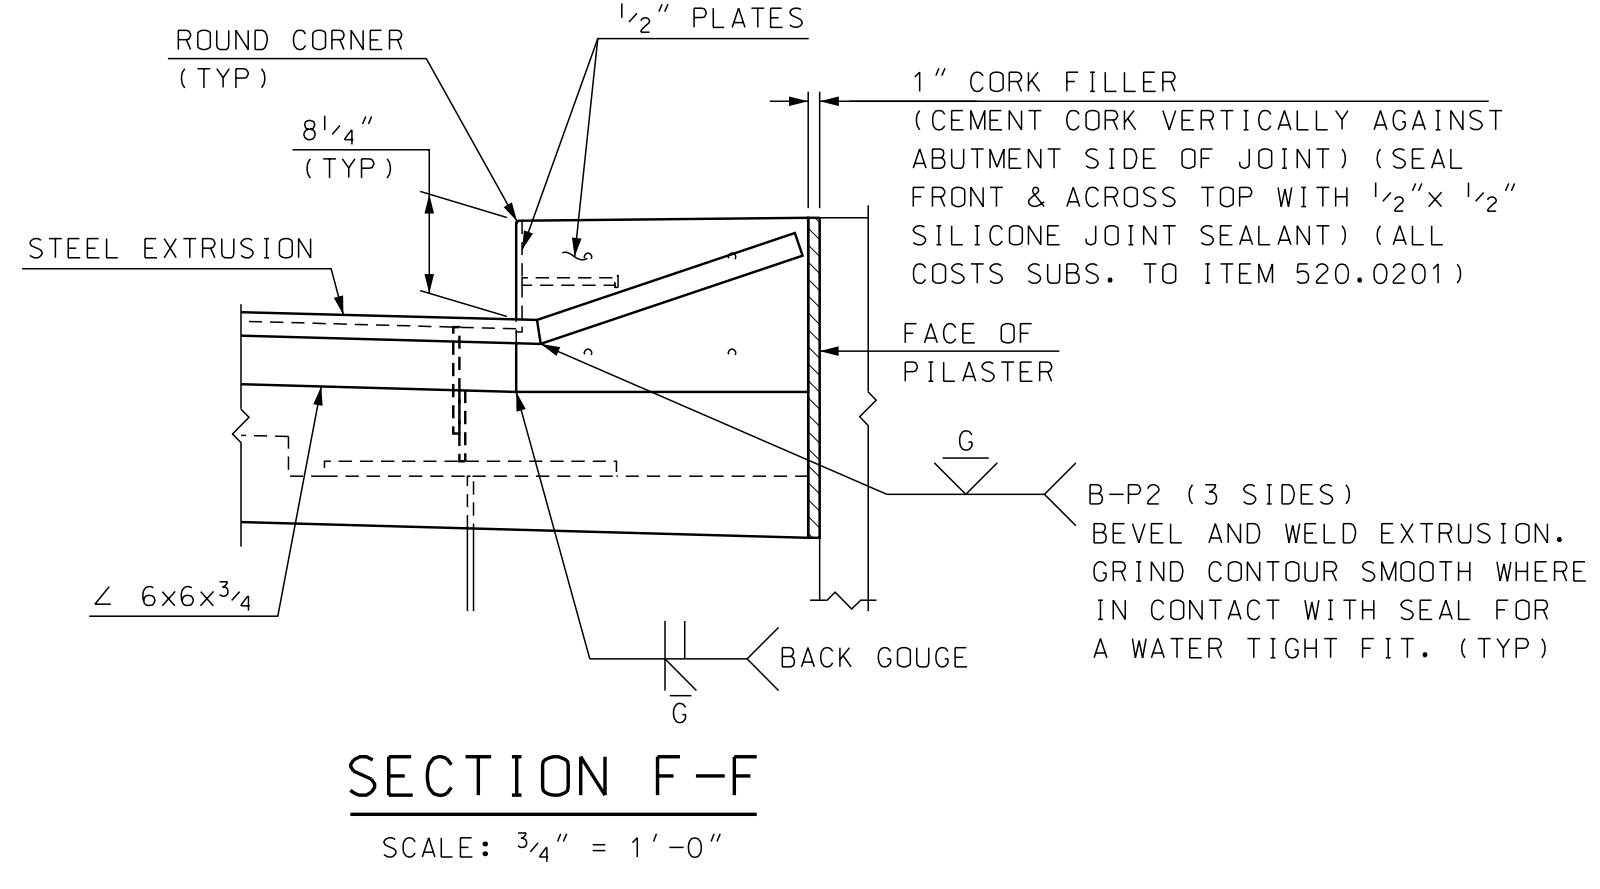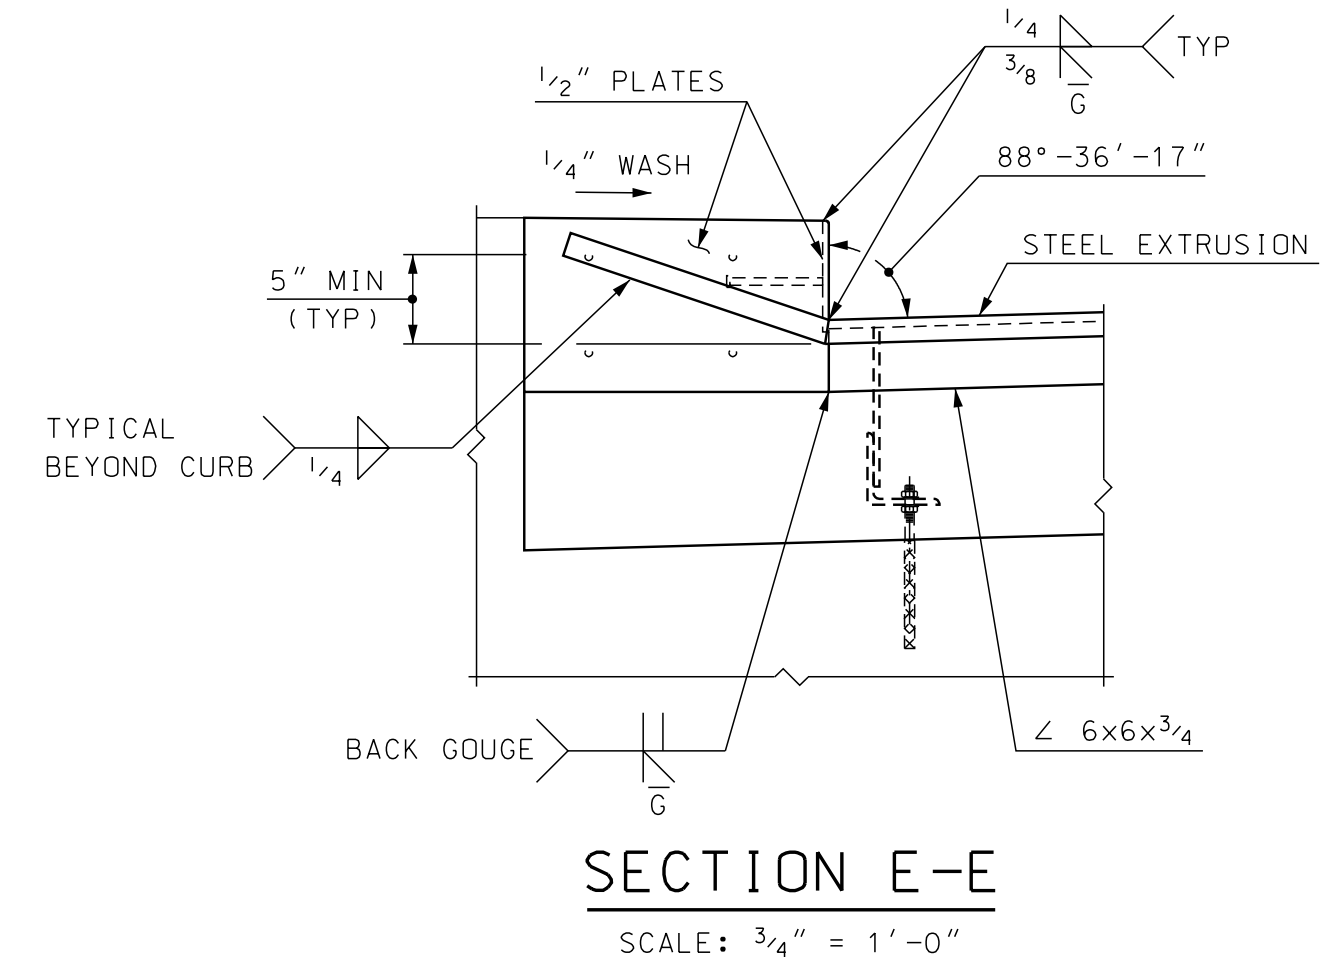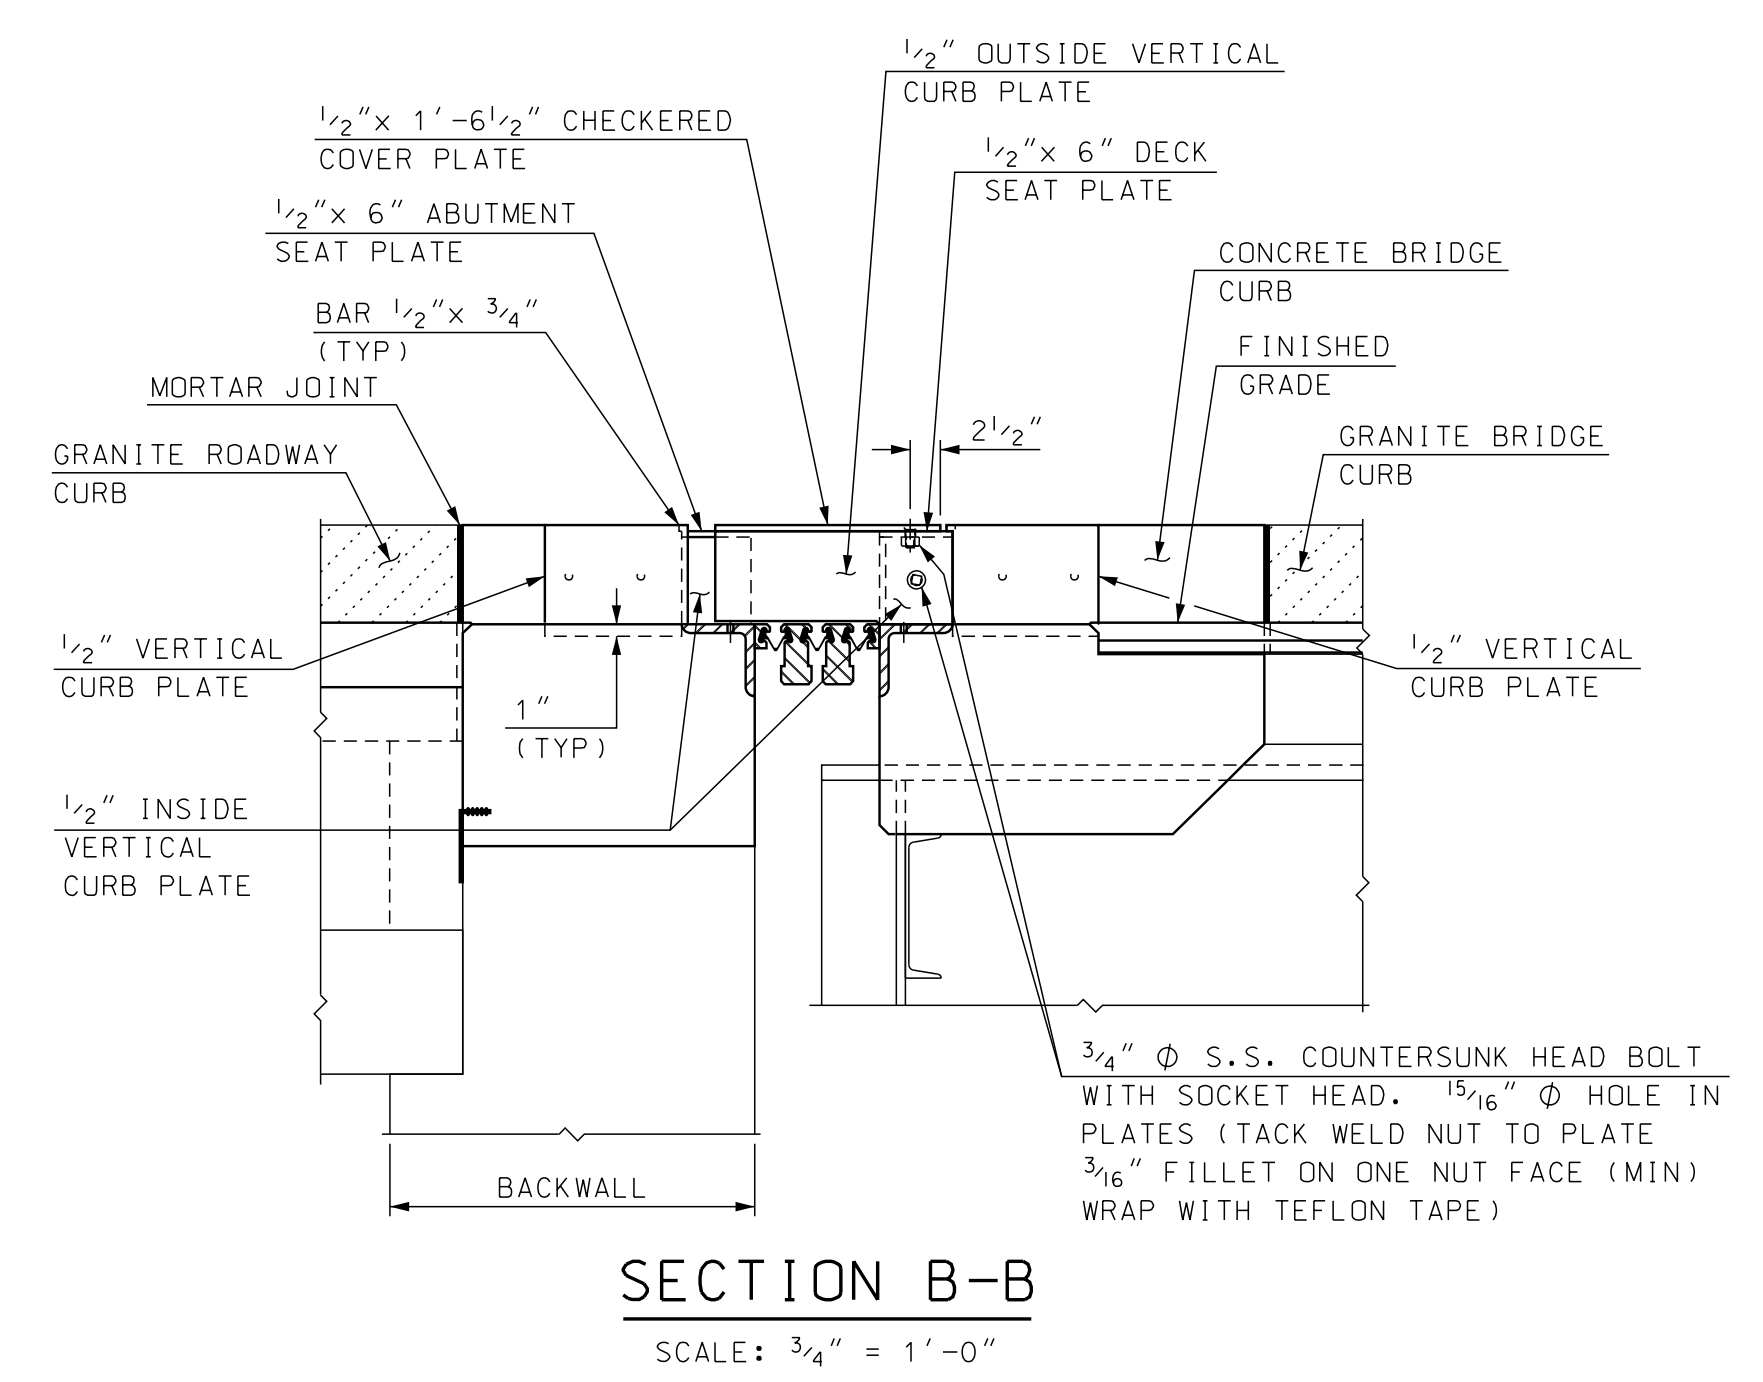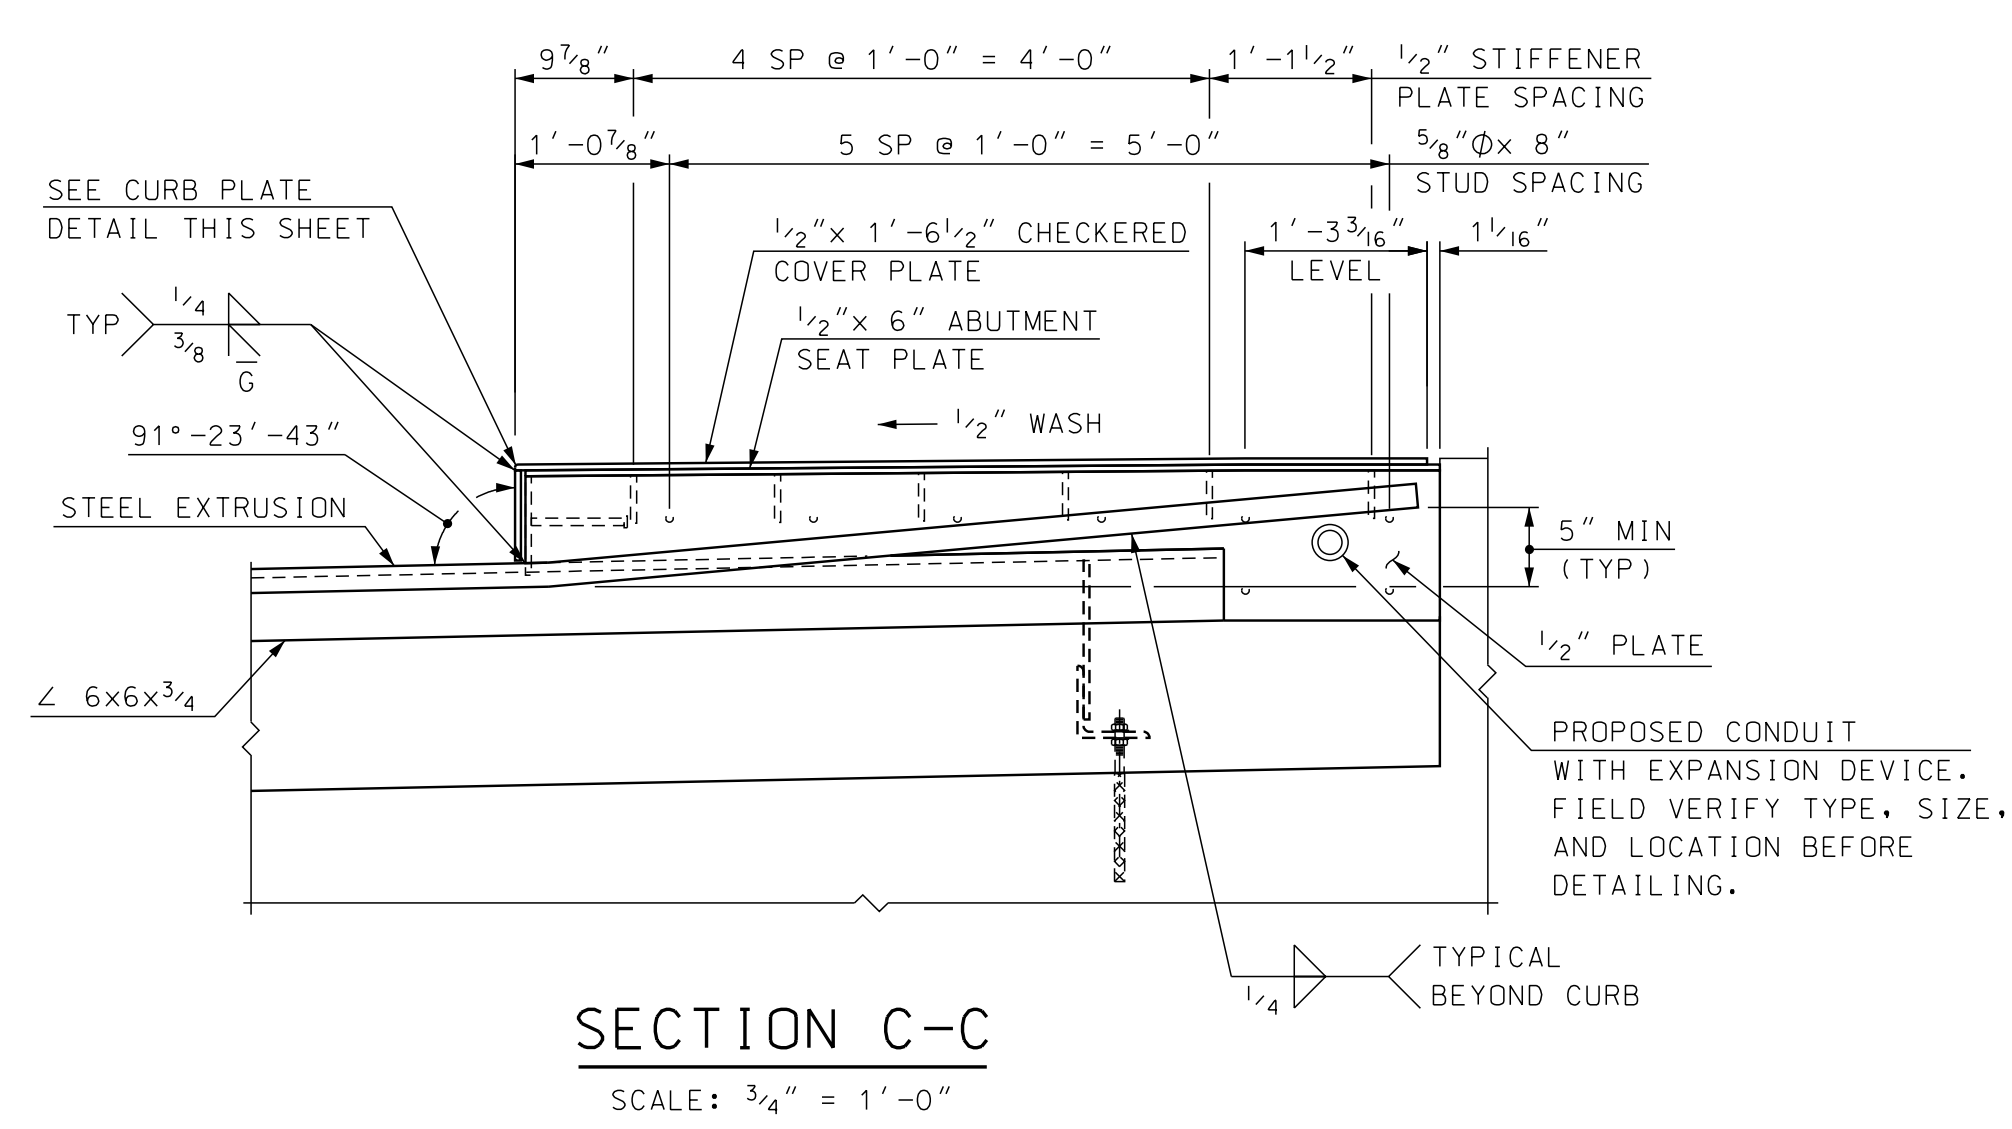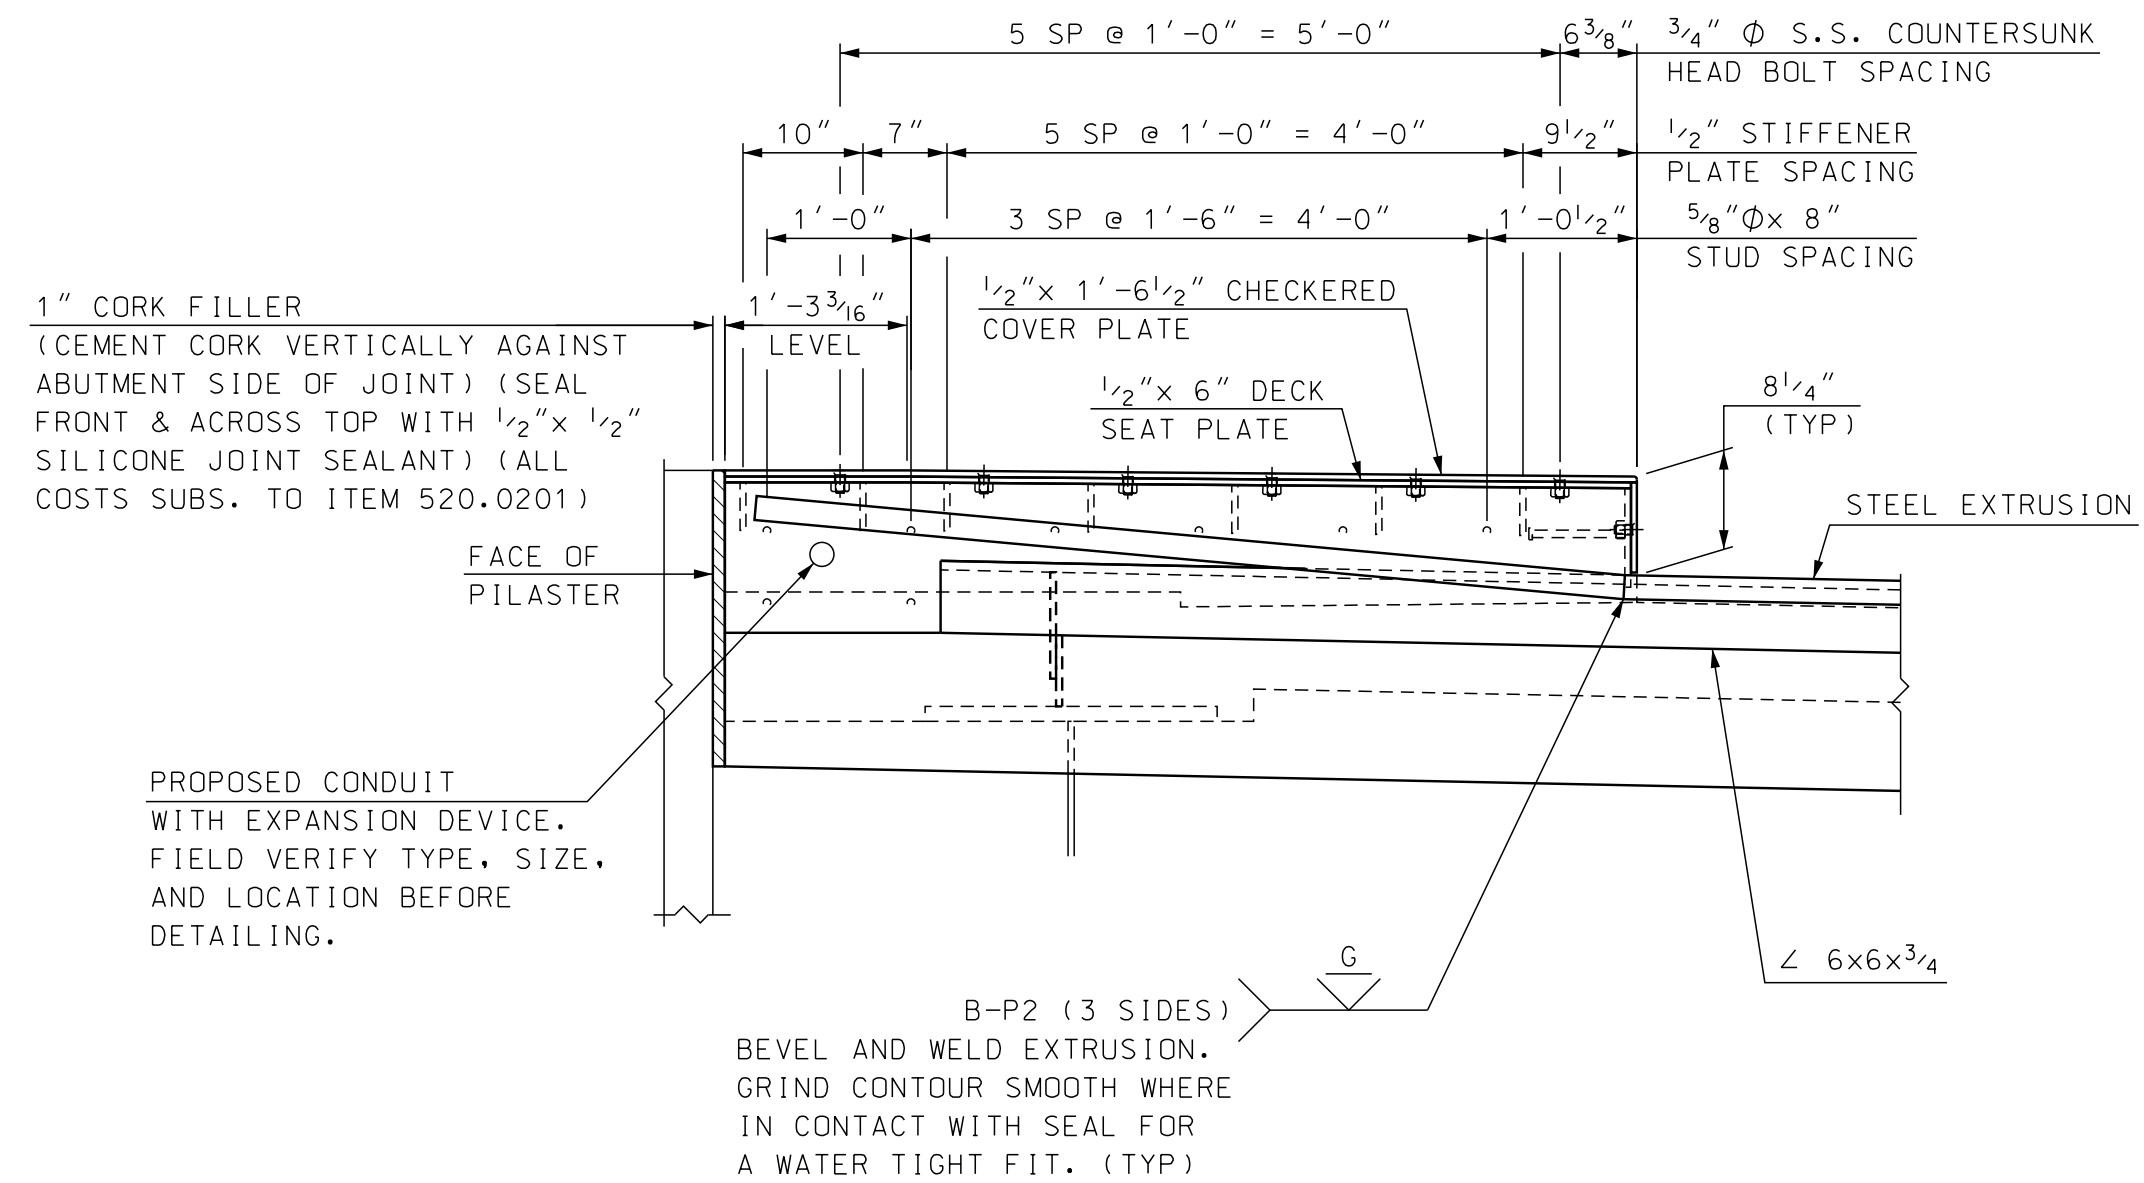

STATE OF NEW HAMPSHIRE									
DEPARTMENT OF TRANSPORTATION * BUREAU OF BRIDGE DESIGN									
TOWN	HOOKSETT	BRIDGE NO.	080/148	STATE PROJECT	28435				
LOCATION MAIN STREET over B&M RR, MERRIMACK RIVER, & RIVERSIDE STREET									
ABUTMENT A EXPANSION JOINT (3 OF 3)								BRIDGE SHEET	
REVISIONS AFTER PROPOSAL		BY	DATE	CHECKED	SMG	DATE	10 OF 18		
		DESIGNED	JAT	12/13	CHECKED	SMG	8/14		
		DRAWN	SMG	12/13	CHECKED	JAT	8/14		
		QUANTITIES	SMG	9/14	CHECKED	JAT	9/14		
ISSUE DATE		FEDERAL PROJECT NO.				SHEET NO.		TOTAL SHEETS	
REV. DATE		-----				14		42	

SUBDIRECTORY	DGN LOCATOR	SHEET SCALE
BRC\	28435 Exp Jt A	AS NOTED

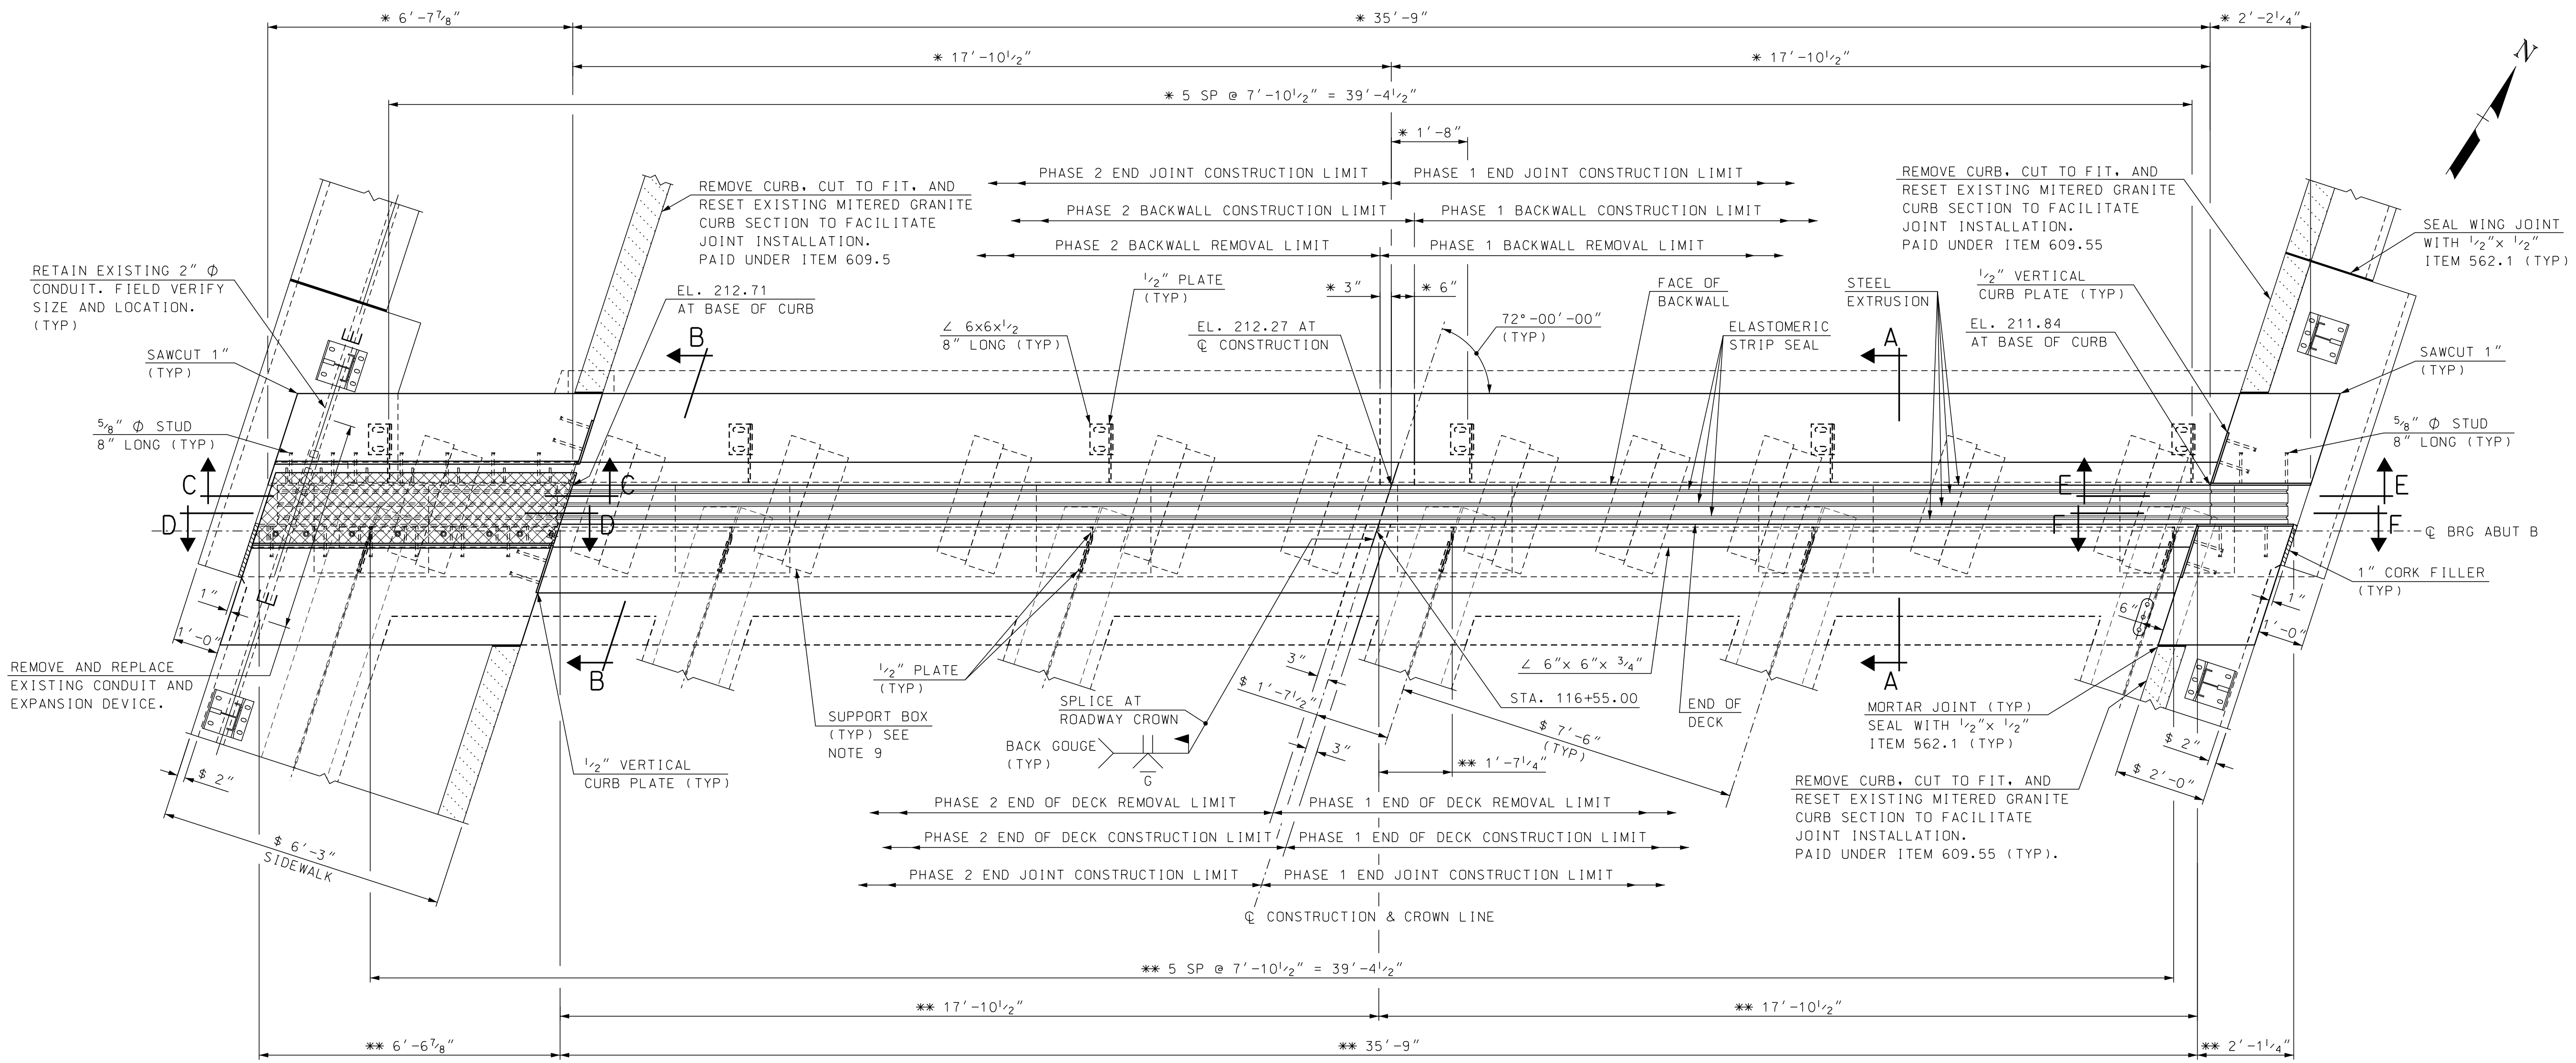

PLAN VIEW

SCALE: 1/2" = 1'-0"


\$ RADIAL DIMENSION
 * DIMENSION ALONG FACE OF BACKWALL
 ** DIMENSION ALONG END OF DECK

EXPANSION JOINT NOTES

- THE MODULAR JOINT SHOWN IS REPRESENTATIVE OF THE TYPE OF EXPANSION JOINT ACCEPTABLE FOR USE. THE EXACT JOINT CONFIGURATION WILL DEPEND UPON THE MANUFACTURER'S DETAILS. SHOP DRAWINGS OF MODULAR EXPANSION JOINT SYSTEM INCLUDING BARRIER/CURB DETAILS, PLACEMENT DETAILS, AND SHIPPING DEVICES SHALL BE SUBMITTED TO THE ENGINEER FOR APPROVAL. THE ENTIRE ASSEMBLY, INCLUDING ELASTOMERIC SEALS, SHALL BE PAID FOR AS ITEM 561.2002, PREFABRICATED MODULAR BRIDGE JOINT SYSTEM (F) (SEE SPECIAL PROVISION).
- EXPANSION JOINT STEEL SHALL BE AASHTO M223 (ASTM A572) GRADE 50. THE MINOR STEEL PLATES AND EXTRUSIONS MAY CONFORM TO AASHTO M183 (ASTM A36). ALL STEEL SHALL BE GALVANIZED.
- SPLICES FOR EXPANSION JOINT STEEL SHALL DEVELOP FULL STRENGTH.
- ELASTOMERIC SEALS SHALL BE FURNISHED IN ONE CONTINUOUS LENGTH. NO SPLICES WILL BE ALLOWED.
- THE EXPANSION JOINT MANUFACTURER SHALL INCLUDE A TEMPERATURE SETTING TABLE FOR THE EXPANSION JOINT LOCATION ON THE SHOP DRAWINGS.
- MINIMUM INSTALLATION WIDTH "T" = 10 3/8" AT 65°F. ADJUSTMENT IN OPENING FOR A 15°F CHANGE IN TEMPERATURE = 7/16".
- THE MODULAR BRIDGE JOINT SYSTEM SHALL HAVE A RANGE OF MOVEMENT OF 4.21". THE CONTRATOR SHALL USE MODULAR BRIDGE JOINT SYSTEM STM SERIES BY WATSON BOWMAN ACME OR D SERIES BY D.S. BROWN. THIS DESIGN INCLUDES MOVEMENT DUE TO TEMPERATURE, SKEW, AND MINIMUM INSTALLATION.
- JOINT SUPPORT PLATES AND HARDWARE SHALL BE SHOP WELDED TO THE EXPANSION JOINT STEEL AND SHALL BE DETAILED TO ALLOW FOR ALL NECESSARY ADJUSTMENTS TO ACCOMMODATE ROADWAY CROSS SLOPE, GRADE, AND TEMPERATURE SETTINGS.
- SUPPORT BOXES AND BARS SHALL BE DESIGNED BY THE MANUFACTURER. TYPE, SIZE, AND LOCATION SHALL BE DETERMINED BY THE MANUFACTURER.
- STIFFENER PLATES, STUDS, AND ANCHORAGES MAY NEED TO SHIFTED FROM THE LAYOUT AS SHOWN ON THESE PLANS BASED ON THE MANUFACTURER'S DESIGN OF THE SUPPORT BOXES AND BARS.
- PROTECT THE TOP OF THE EXPANSION JOINT DURING PLACEMENT OF CONCRETE AND BITUMINOUS PAVEMENT.
- ELEVATIONS SHOWN AT THE TOP OF THE EXPANSION JOINT STEEL ARMOR ANGLES AND BEAMS ARE 1/8" LOWER THAN ADJACENT PROPOSED FINISHED ROADWAY GRADE.
- NO "LOW PROFILE" STEEL EXTRUSIONS SHALL BE ALLOWED.
- NO REINFORCING STEEL SHALL BE CUT TO CLEAR THE BRIDGE EXPANSION DEVICE WITHOUT PRIOR APPROVAL OF THE ENGINEER.
- IMMEDIATELY AFTER THE JOINT HAS BEEN SECURED TO THE STRUCTURAL STEEL AND BACKWALL, REMOVE SHIPPING DEVICES AND GRIND SMOOTH ANY WELDS ON EXPOSED SURFACES. REPAIR ANY DAMAGE TO GALVANIZED SURFACES PER SECTION 550
- SEE BRIDGE SHEETS 10 & 11 FOR SECTIONS A-A, B-B, C-C, D-D AND E-E.

STATE OF NEW HAMPSHIRE									
DEPARTMENT OF TRANSPORTATION * BUREAU OF BRIDGE DESIGN									
TOWN	HOOKSETT	BRIDGE NO.	080/148	STATE PROJECT	28435				
LOCATION MAIN STREET over B&M RR, MERRIMACK RIVER, & RIVERSIDE STREET									
ABUTMENT B EXPANSION JOINT (1 OF 3)									BRIDGE SHEET
REVISIONS AFTER PROPOSAL			BY	DATE	BY	DATE	11 OF 18		
			DESIGNED	JAT	12/13	CHECKED	SMG	8/14	FILE NUMBER
			DRAWN	SMG	12/13	CHECKED	JAT	8/14	126-1-1
			QUANTITIES	SMG	9/14	CHECKED	JAT	9/14	TOTAL SHEETS
			ISSUE DATE	FEDERAL PROJECT NO.			SHEET NO.	42	
			REV. DATE	-----			15		

SUBDIRECTORY	DGN LOCATOR	SHEET SCALE
BRC\	28435 Exp Jt B	AS NOTED

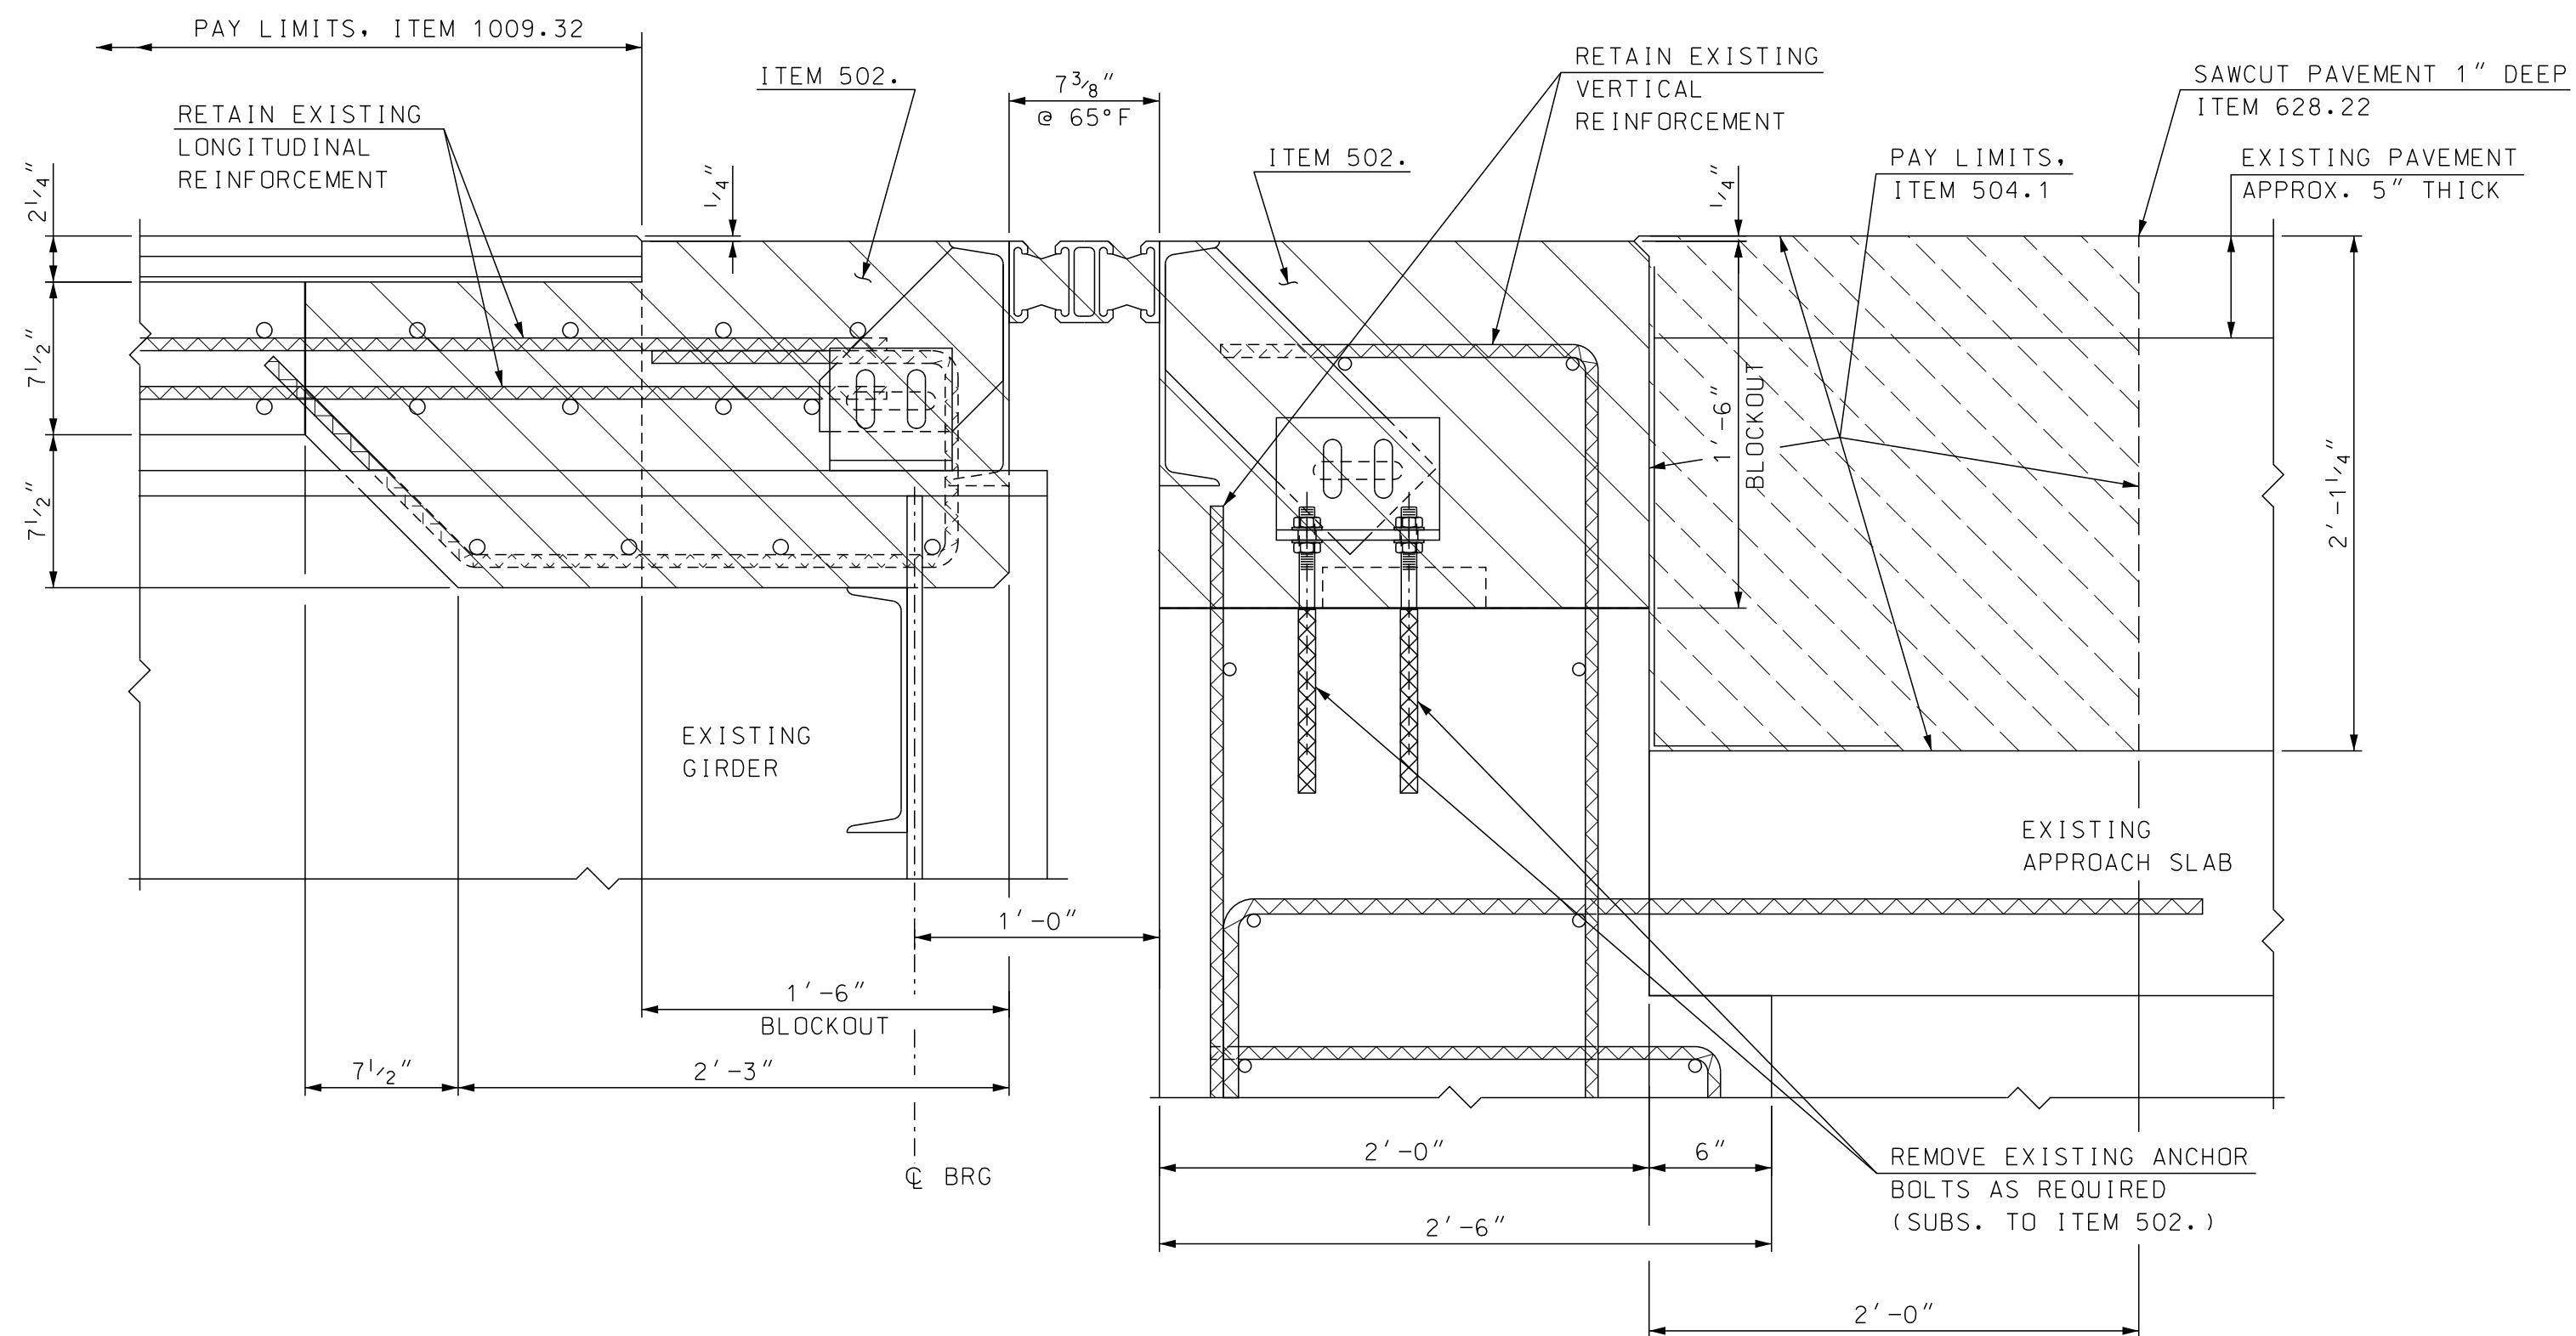


SECTION A-A REMOVAL

SCALE: 1 1/2" = 1'-0"

TEMPERATURE ADJUSTMENT TABLE	
TEMPERATURE	"T"
20°F	11 11/16"
35°F	11 1/4"
50°F	10 3/16"
65°F	10 3/8"
80°F	9 15/16"
95°F	9 1/2"


TEMPERATURE ADJUSTMENT NOTES

- "T" DIMENSIONS ARE PERPENDICULAR TO FACE OF BACKWALL.
- MINIMUM "T" WIDTH FOR SEAL INSTALLATION = 10 1/4" (APPROXIMATELY 65°F OR LESS).
- VALUES IN THE TEMPERATURE ADJUSTMENT TABLE ARE FOR SETTING THE EXPANSION JOINT ASSEMBLY IMMEDIATELY PRIOR TO POURING CONCRETE BLOCKOUTS.

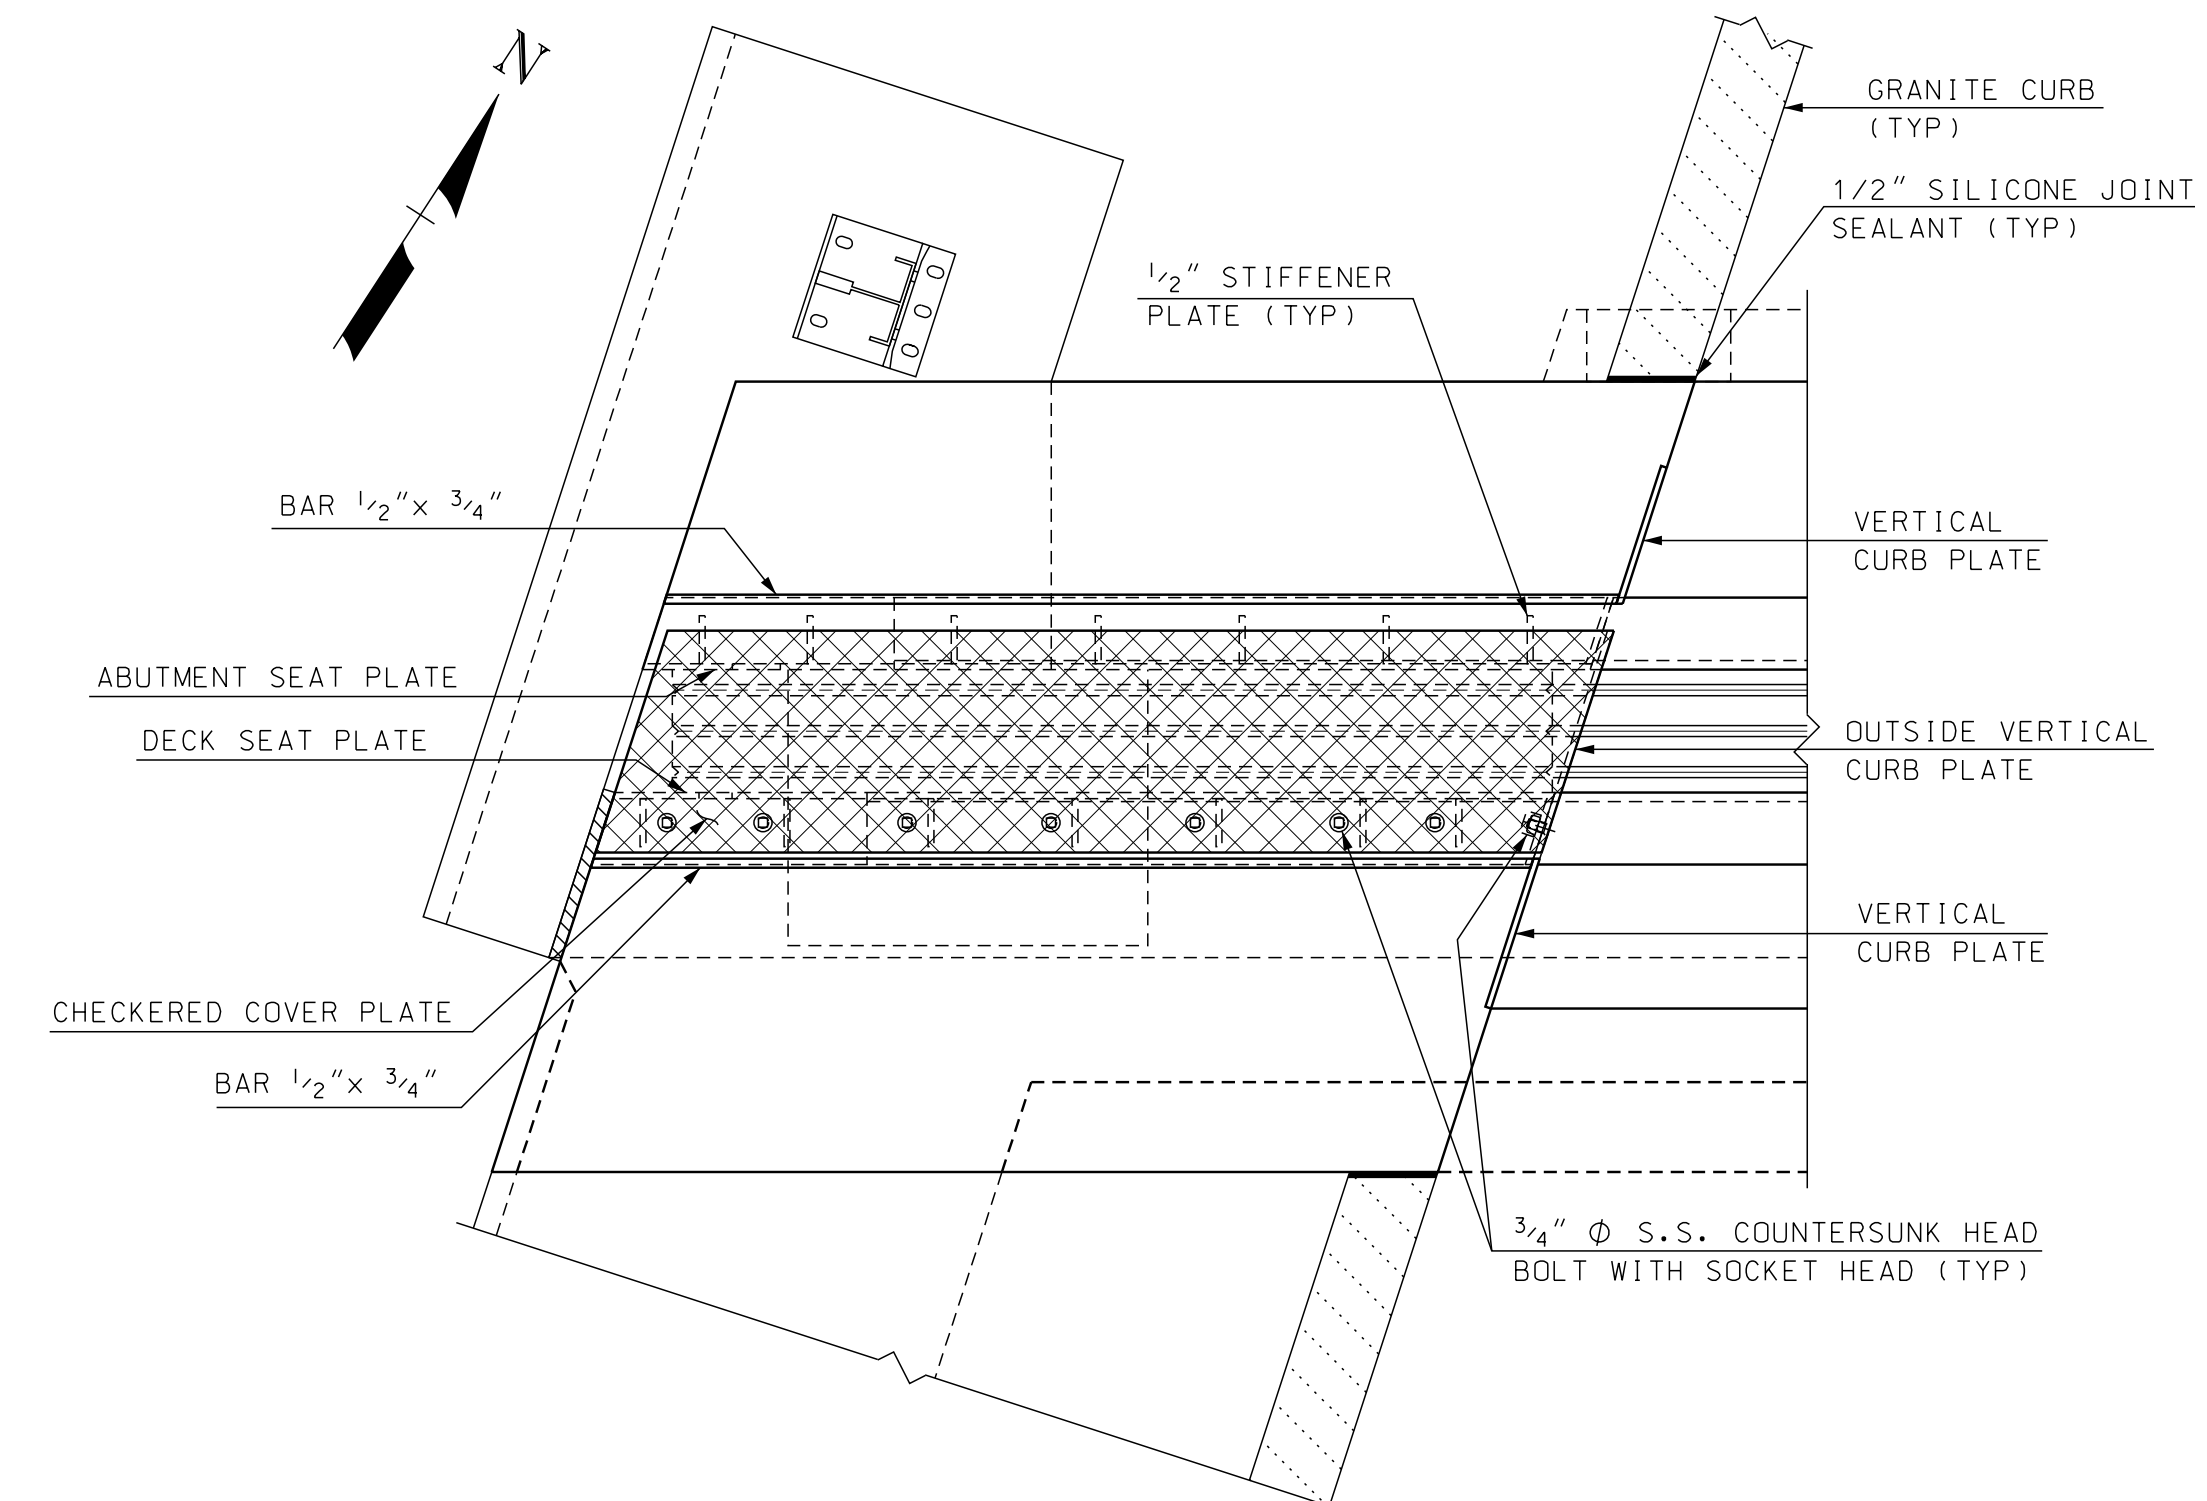


UPPER ASSEMBLY

SCALE: 3/4" = 1'-0"

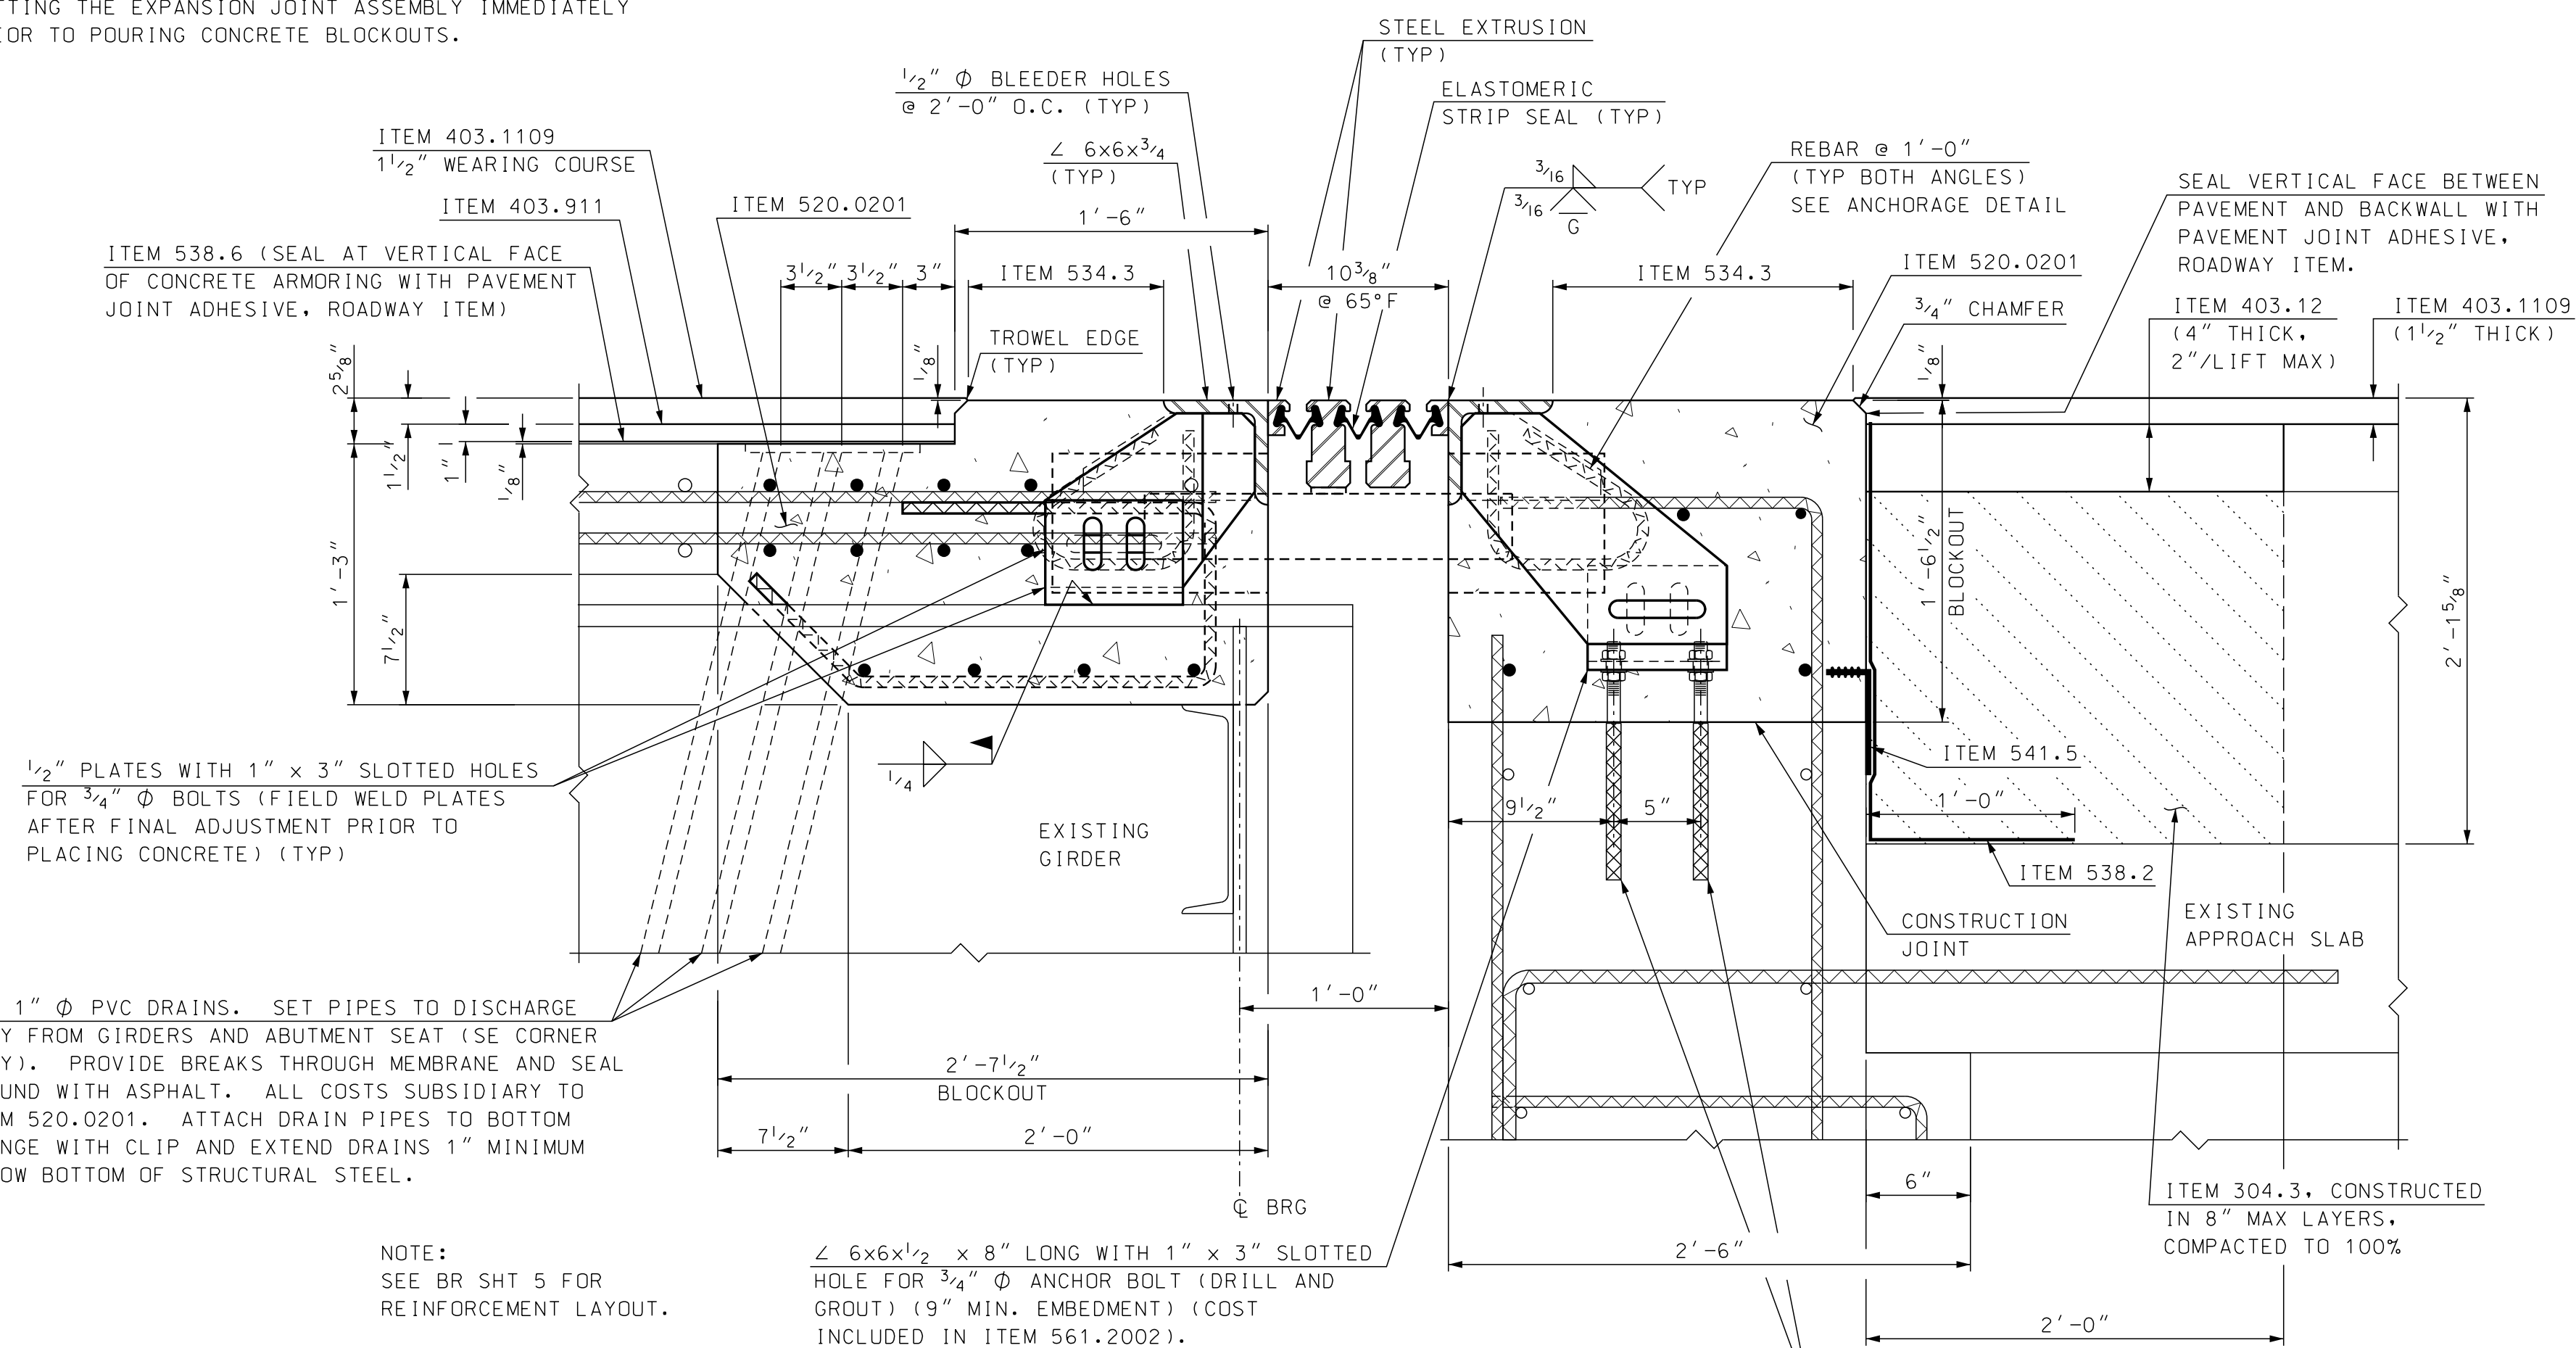

SECTION A-A CONSTRUCTION

SCALE: 1 1/2" = 1'-0"

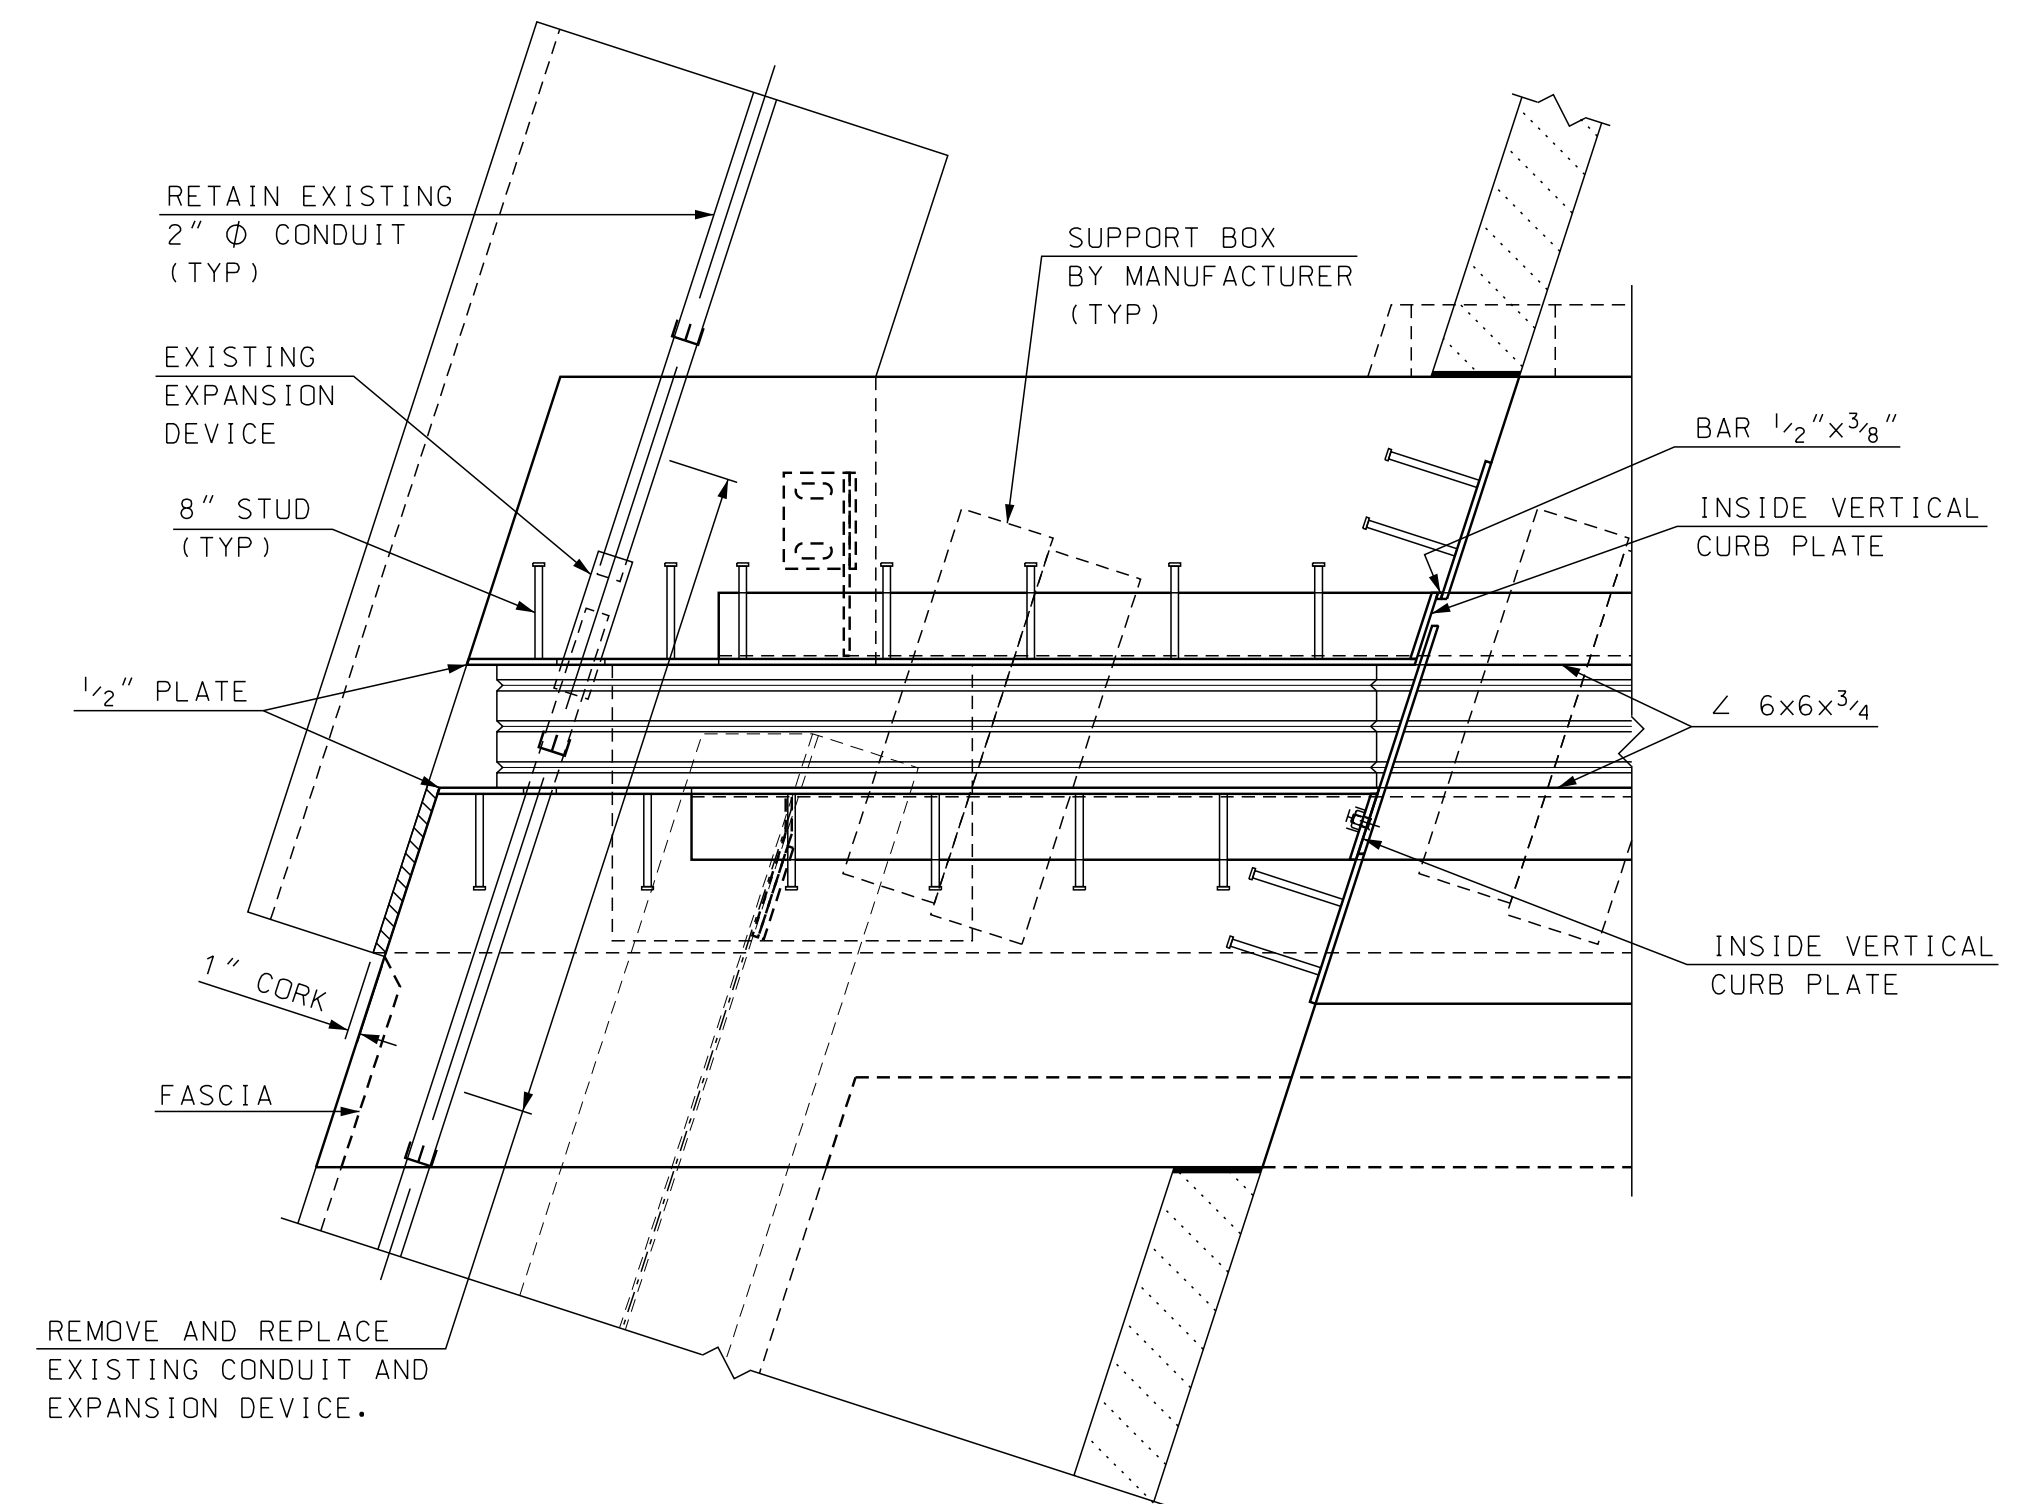

LOWER ASSEMBLY

SCALE: 3/4" = 1'-0"


3 - 1" Ø PVC DRAINS. SET PIPES TO DISCHARGE AWAY FROM GIRDERS AND ABUTMENT SEAT (SEE CORNER ONLY). PROVIDE BREAKS THROUGH MEMBRANE AND SEAL AROUND WITH ASPHALT. ALL COSTS SUBSIDIARY TO ITEM 520.0201. ATTACH DRAIN PIPES TO BOTTOM FLANGE WITH CLIP AND EXTEND DRAINS 1" MINIMUM BELOW BOTTOM OF STRUCTURAL STEEL.

NOTE:
SEE BR SHT 5 FOR REINFORCEMENT LAYOUT.


∠ 6x6x1/2 x 8" LONG WITH 1" x 3" SLOTTED HOLE FOR 3/4" Ø ANCHOR BOLT (DRILL AND GROUT) (9" MIN. EMBEDMENT) (COST INCLUDED IN ITEM 561.2002).

3/4" Ø ANCHOR BOLT @ 9" MINIMUM EMBEDMENT (ALL COSTS SUBSIDIARY TO ITEM 520.0201)


STATE OF NEW HAMPSHIRE									
DEPARTMENT OF TRANSPORTATION * BUREAU OF BRIDGE DESIGN									
TOWN	HOOKSETT	BRIDGE NO.	080/148	STATE PROJECT	28435				
LOCATION MAIN STREET over B&M RR, MERRIMACK RIVER, & RIVERSIDE STREET									
ABUTMENT B EXPANSION JOINT (2 OF 3)									BRIDGE SHEET
REVISIONS AFTER PROPOSAL									12 OF 18
		BY	DATE	CHECKED	BY	DATE			
		JAT	12/13	CHECKED	SMG	8/14			
		SMG	12/13	CHECKED	JAT	8/14			
		SMG	9/14	CHECKED	JAT	9/14			
		ISSUE DATE	FEDERAL PROJECT NO.			SHEET NO.			
		REV. DATE	-----			16			
SUBDIRECTORY	DGN LOCATOR	SHEET SCALE							
BRC\	28435 Exp J1 B	AS NOTED							
							TOTAL SHEETS	42	

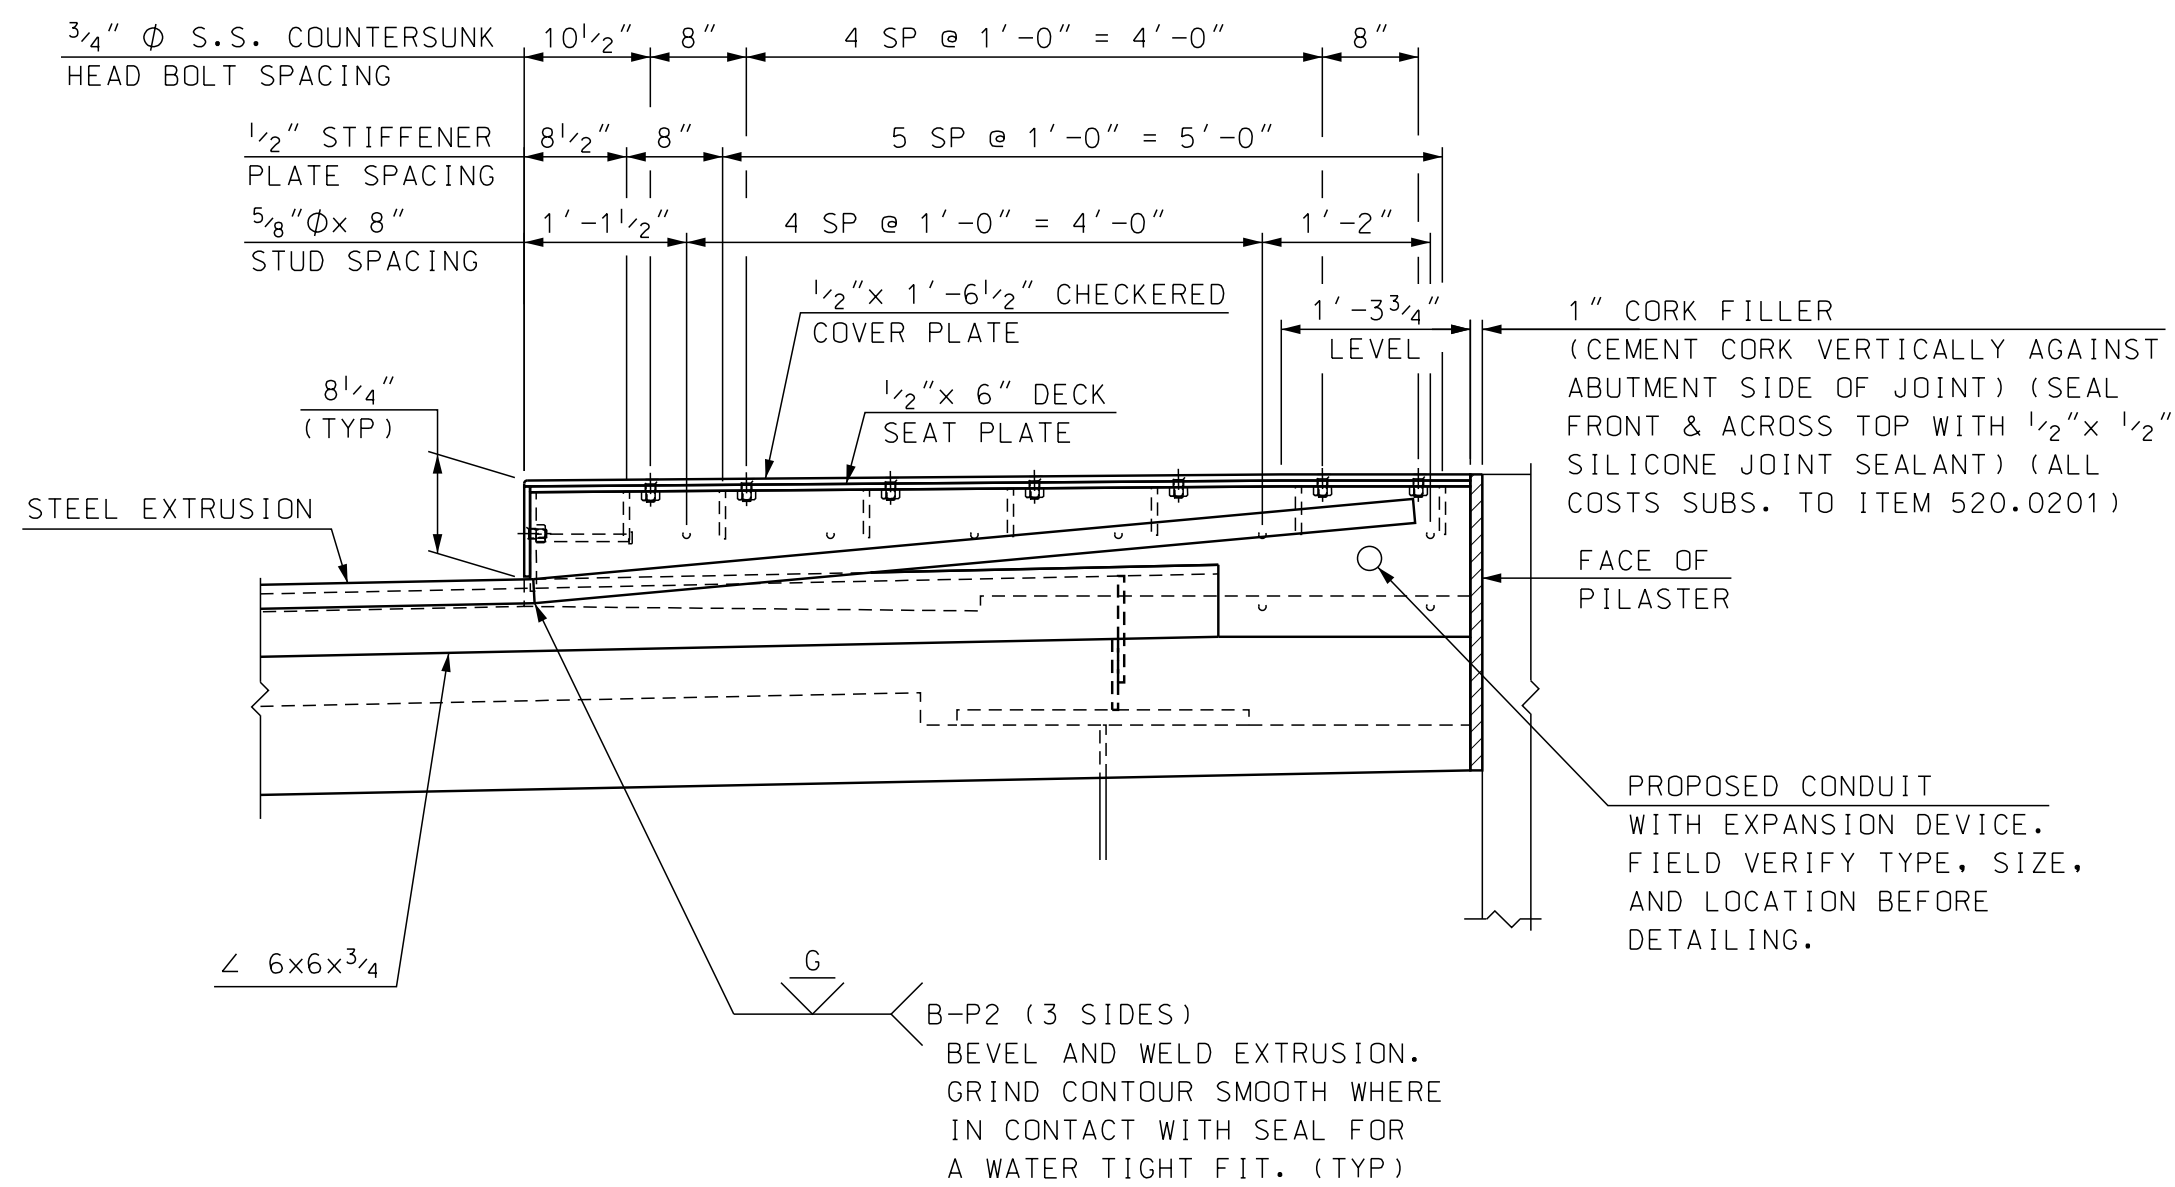


SECTION D-D
SCALE: 3/4" = 1'-0"

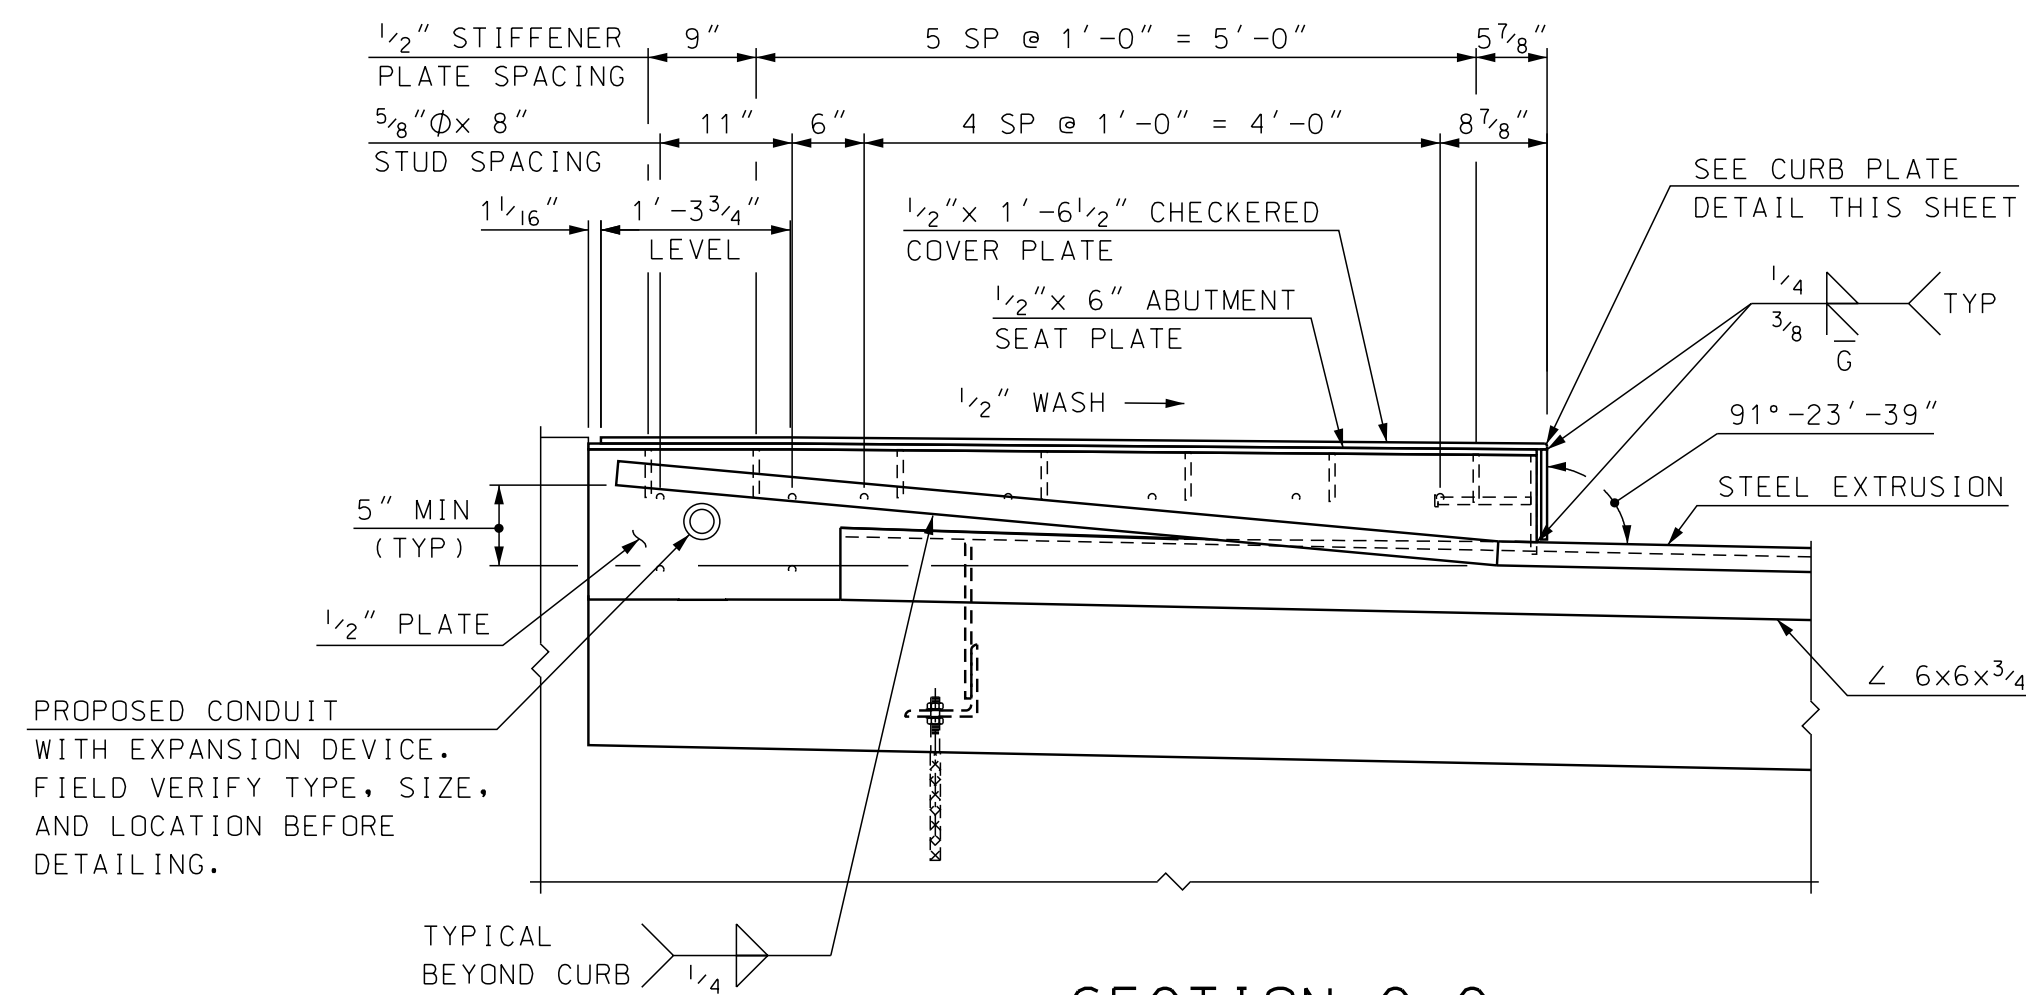


SECTION C-C
SCALE: 3/4" = 1'-0"

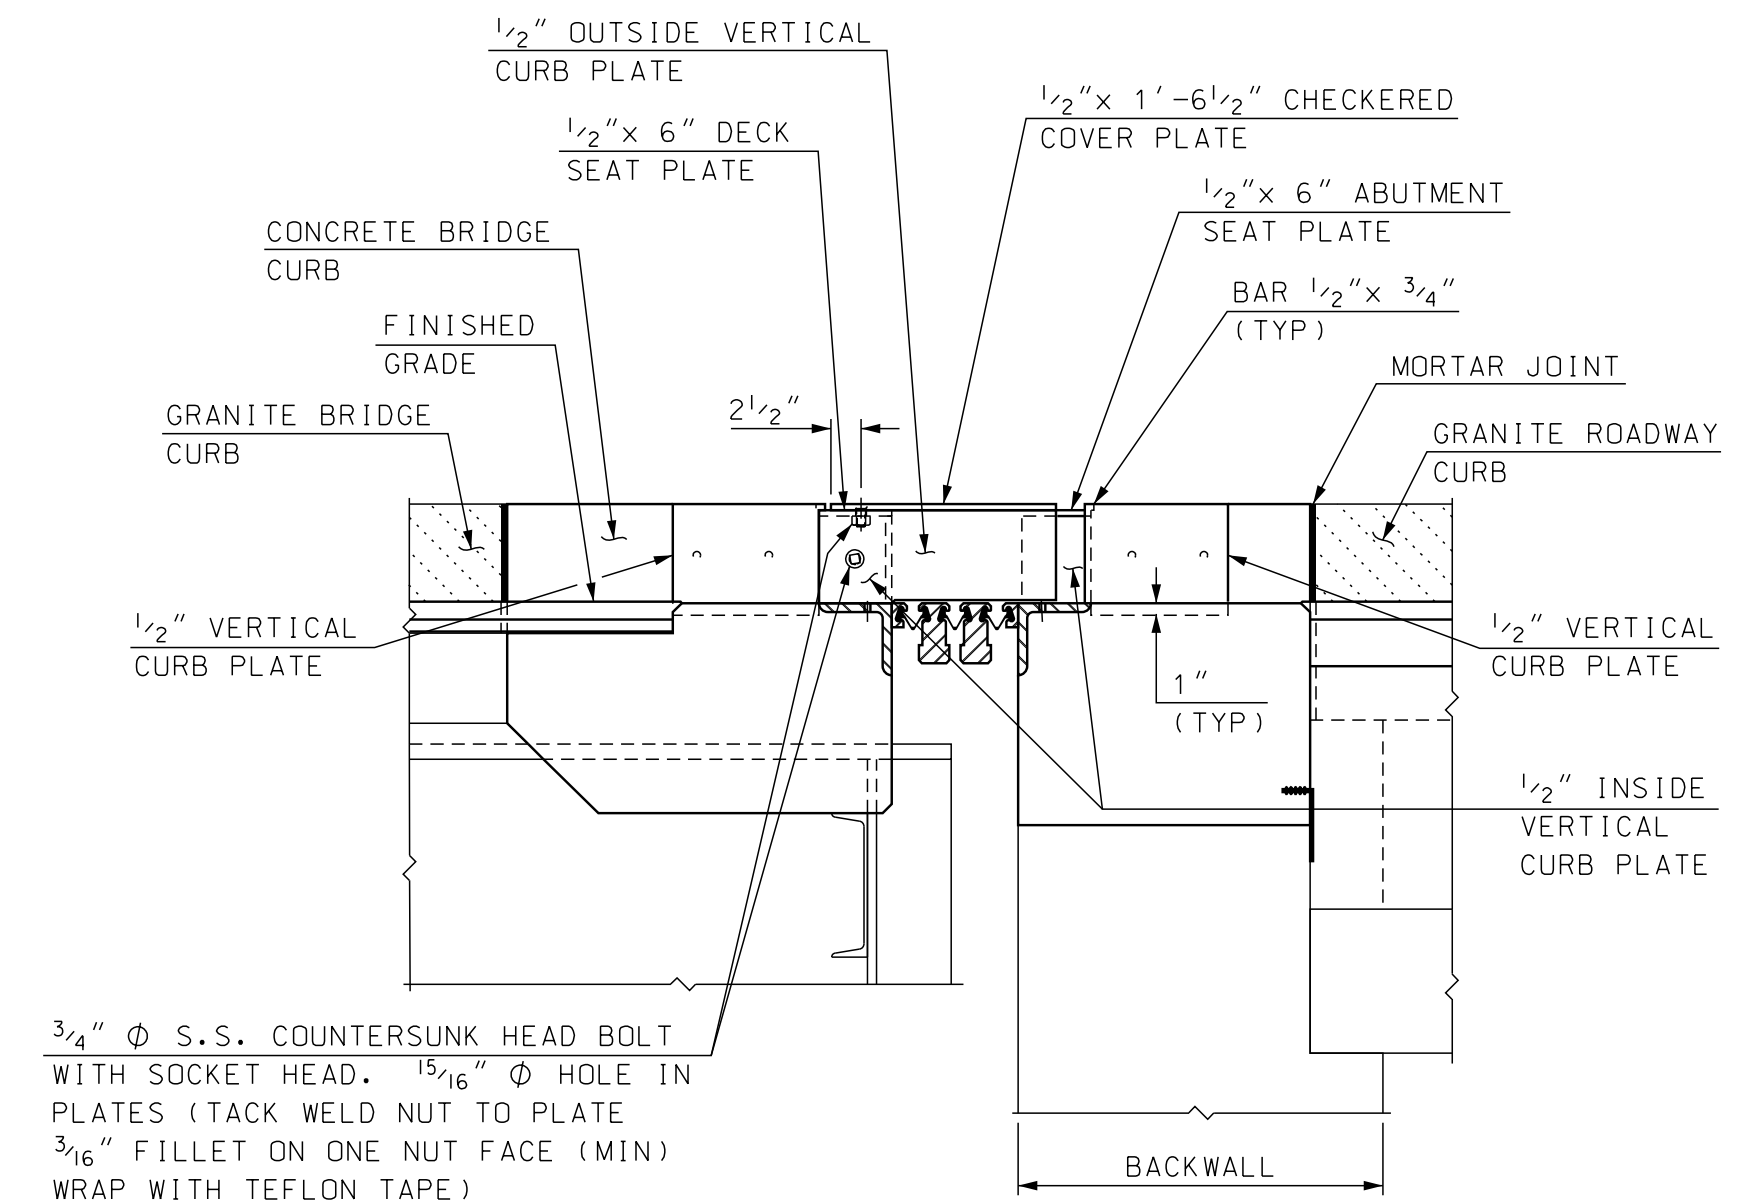


SECTION B-B
SCALE: 3/4" = 1'-0"

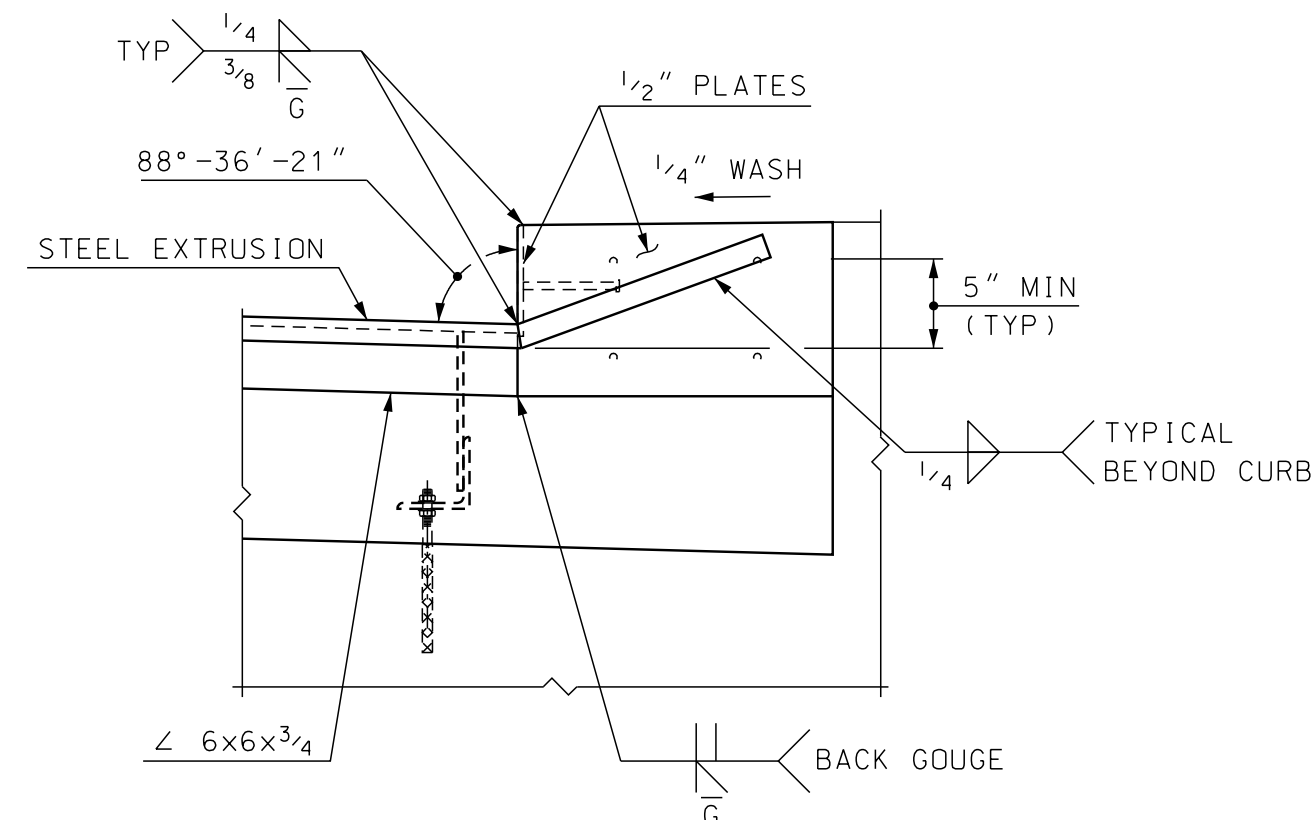


SECTION E-E
SCALE: 3/4" = 1'-0"

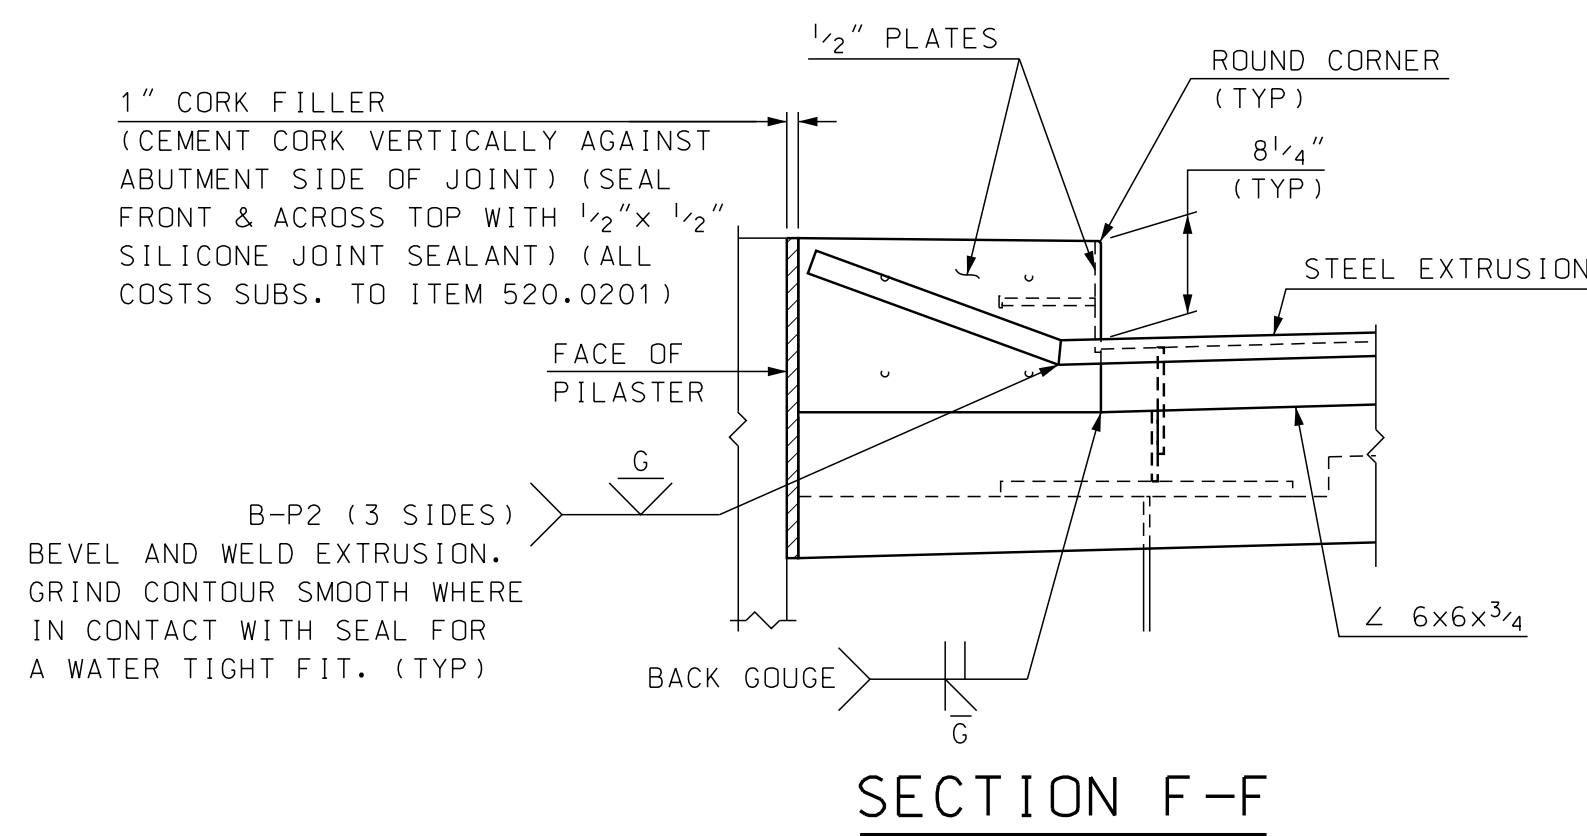


SECTION F-F
SCALE: 3/4" = 1'-0"

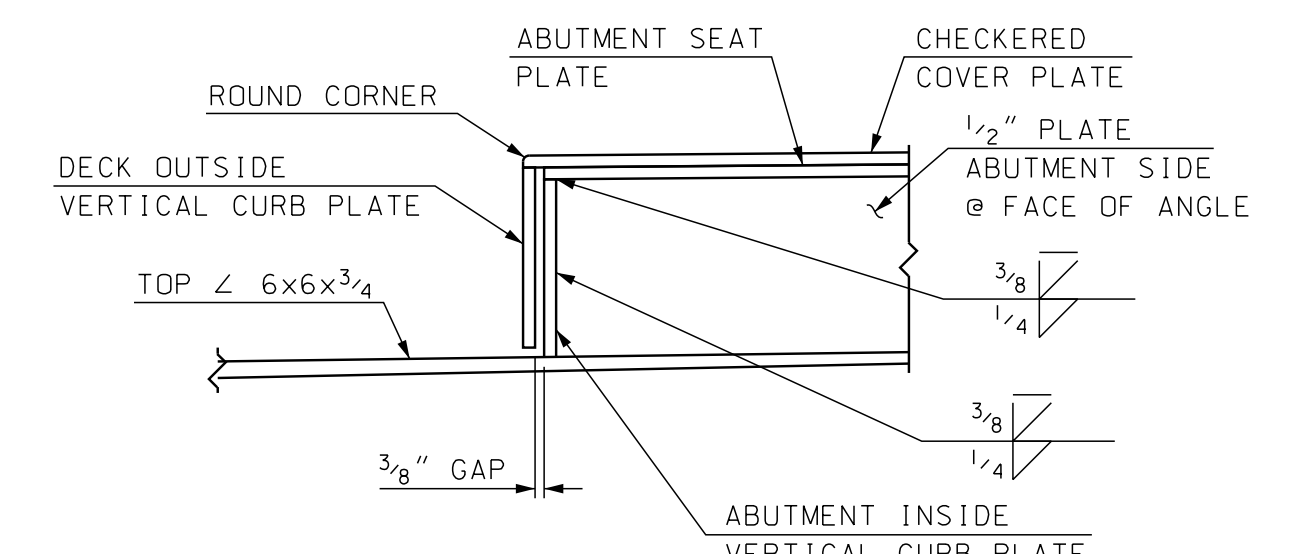


CURB PLATE DETAIL
SCALE: 1 1/2" = 1'-0"

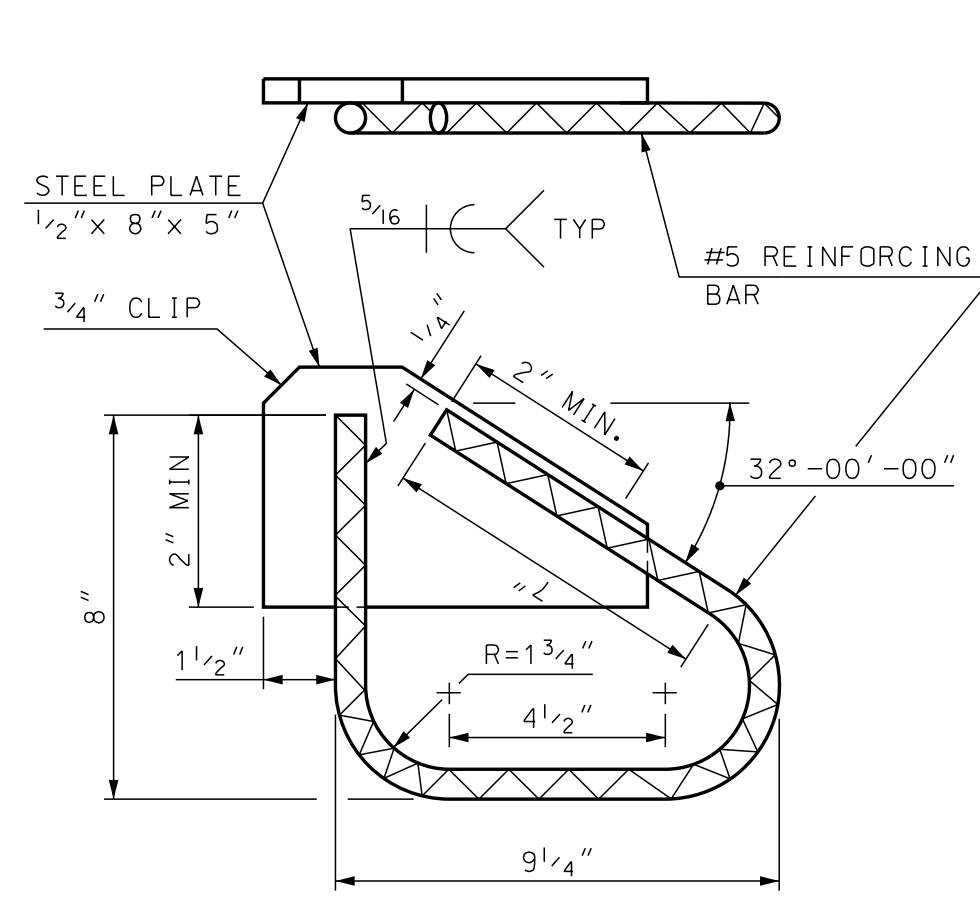


BACKWALL ANCHORAGE DETAIL
SCALE: 3" = 1'-0"

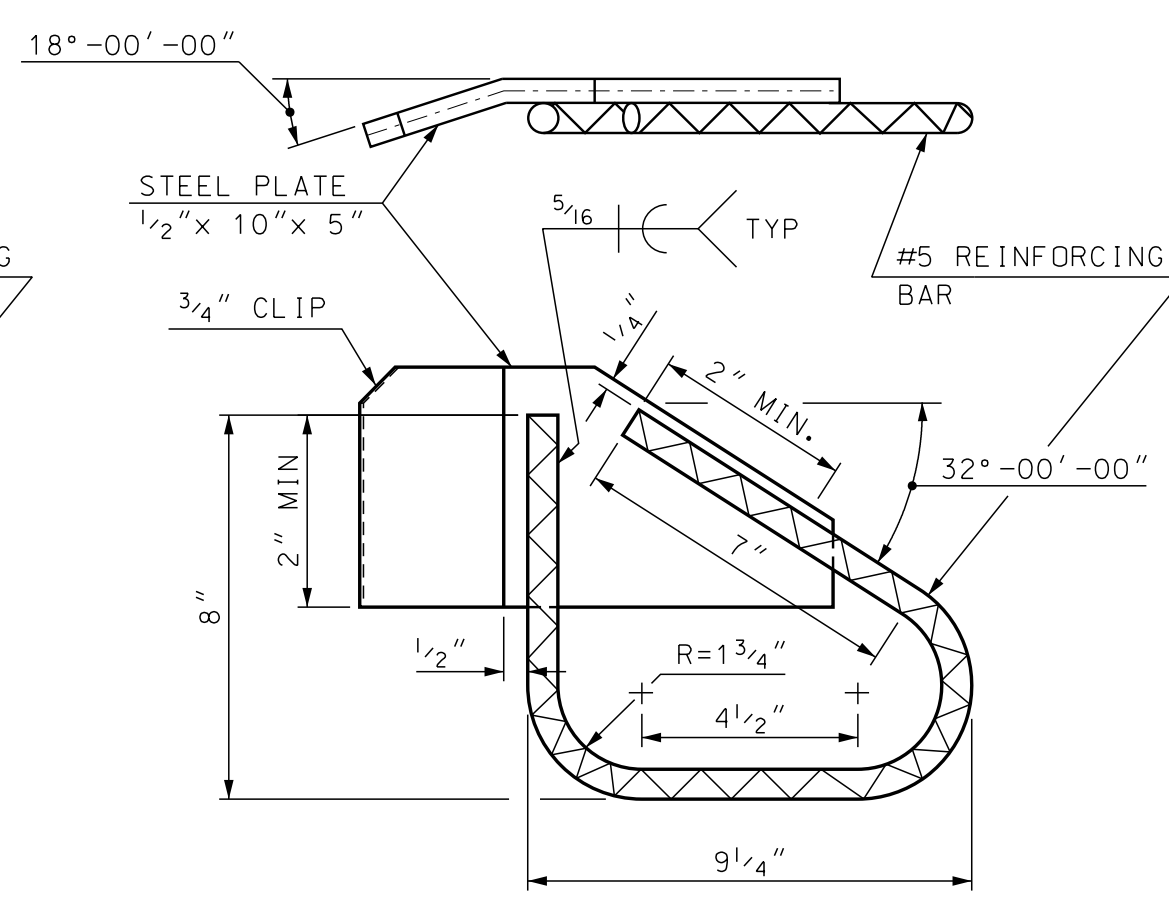

DECK SIDE ANCHORAGE DETAIL
SCALE: 3" = 1'-0"

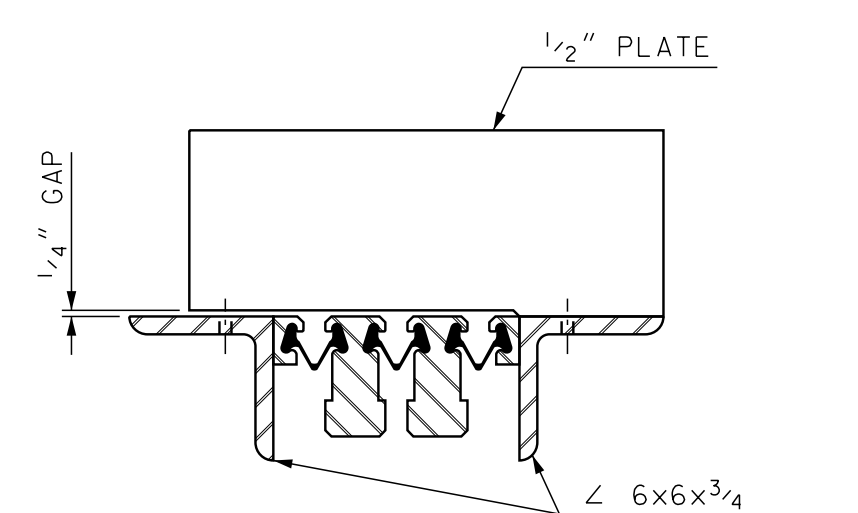








DECK OUTSIDE VERTICAL CURB PLATE DETAIL
SCALE: 1 1/2" = 1'-0"

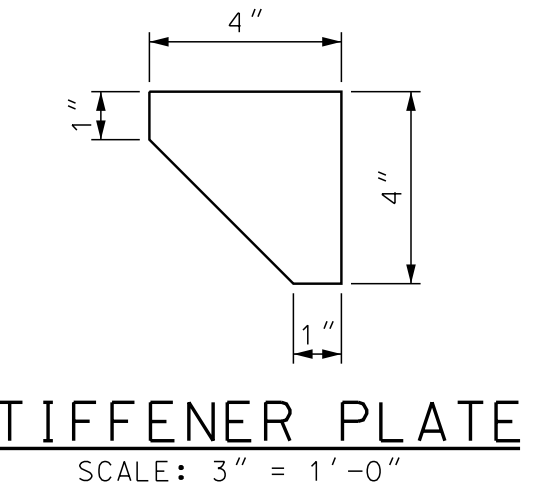


STIFFENER PLATE
SCALE: 3" = 1'-0"

STATE OF NEW HAMPSHIRE									
DEPARTMENT OF TRANSPORTATION * BUREAU OF BRIDGE DESIGN									
TOWN HOOKSETT		BRIDGE NO. 080.148		STATE PROJECT 28435					
LOCATION MAIN STREET over B&M RR, MERRIMACK RIVER, & RIVERSIDE STREET									
ABUTMENT B EXPANSION JOINT (3 OF 3)								BRIDGE SHEET	
REVISIONS AFTER PROPOSAL		BY DATE		BY DATE		13 OF 18		FILE NUMBER	
		DESIGNED JAT 12/13		CHECKED SMG 8/14		126-1-1			
		DRAWN SMG 12/13		CHECKED JAT 8/14					
		QUANTITIES SMG 9/14		CHECKED JAT 9/14					
ISSUE DATE		FEDERAL PROJECT NO.		SHEET NO.		TOTAL SHEETS			
REV. DATE		-----		17		42			

SUBDIRECTORY	DGN LOCATOR	SHEET SCALE
BRC\	28435 Exp J1 B	AS NOTED

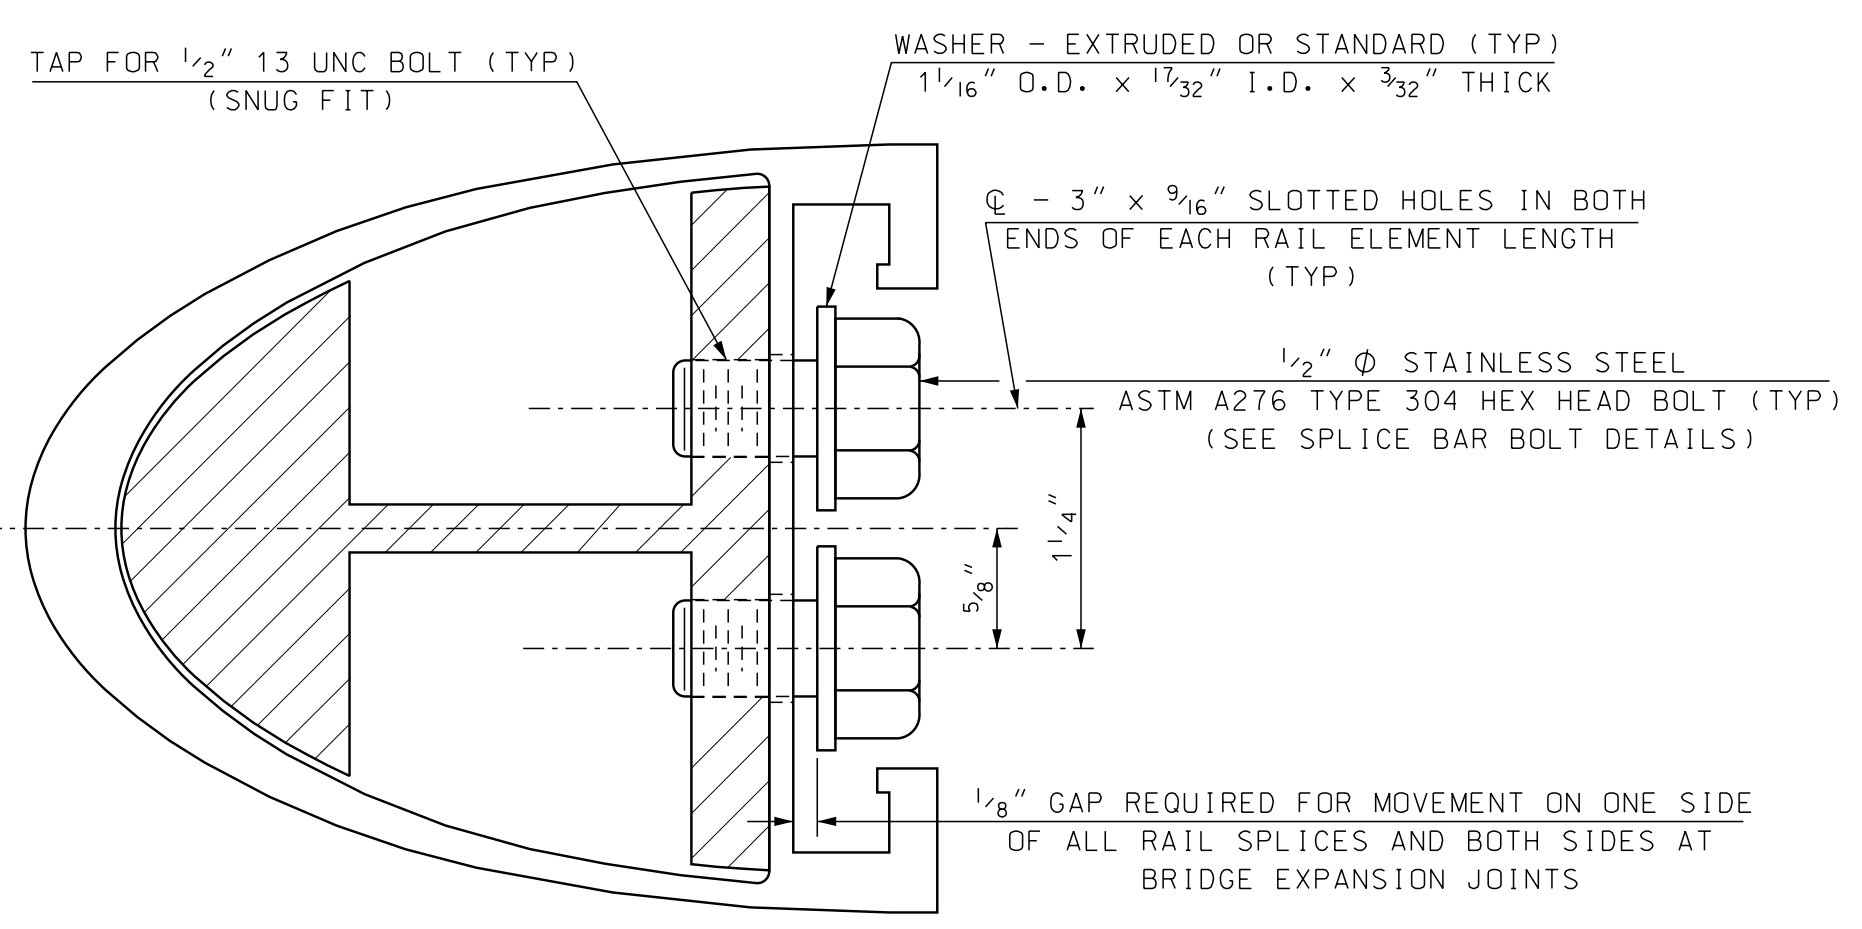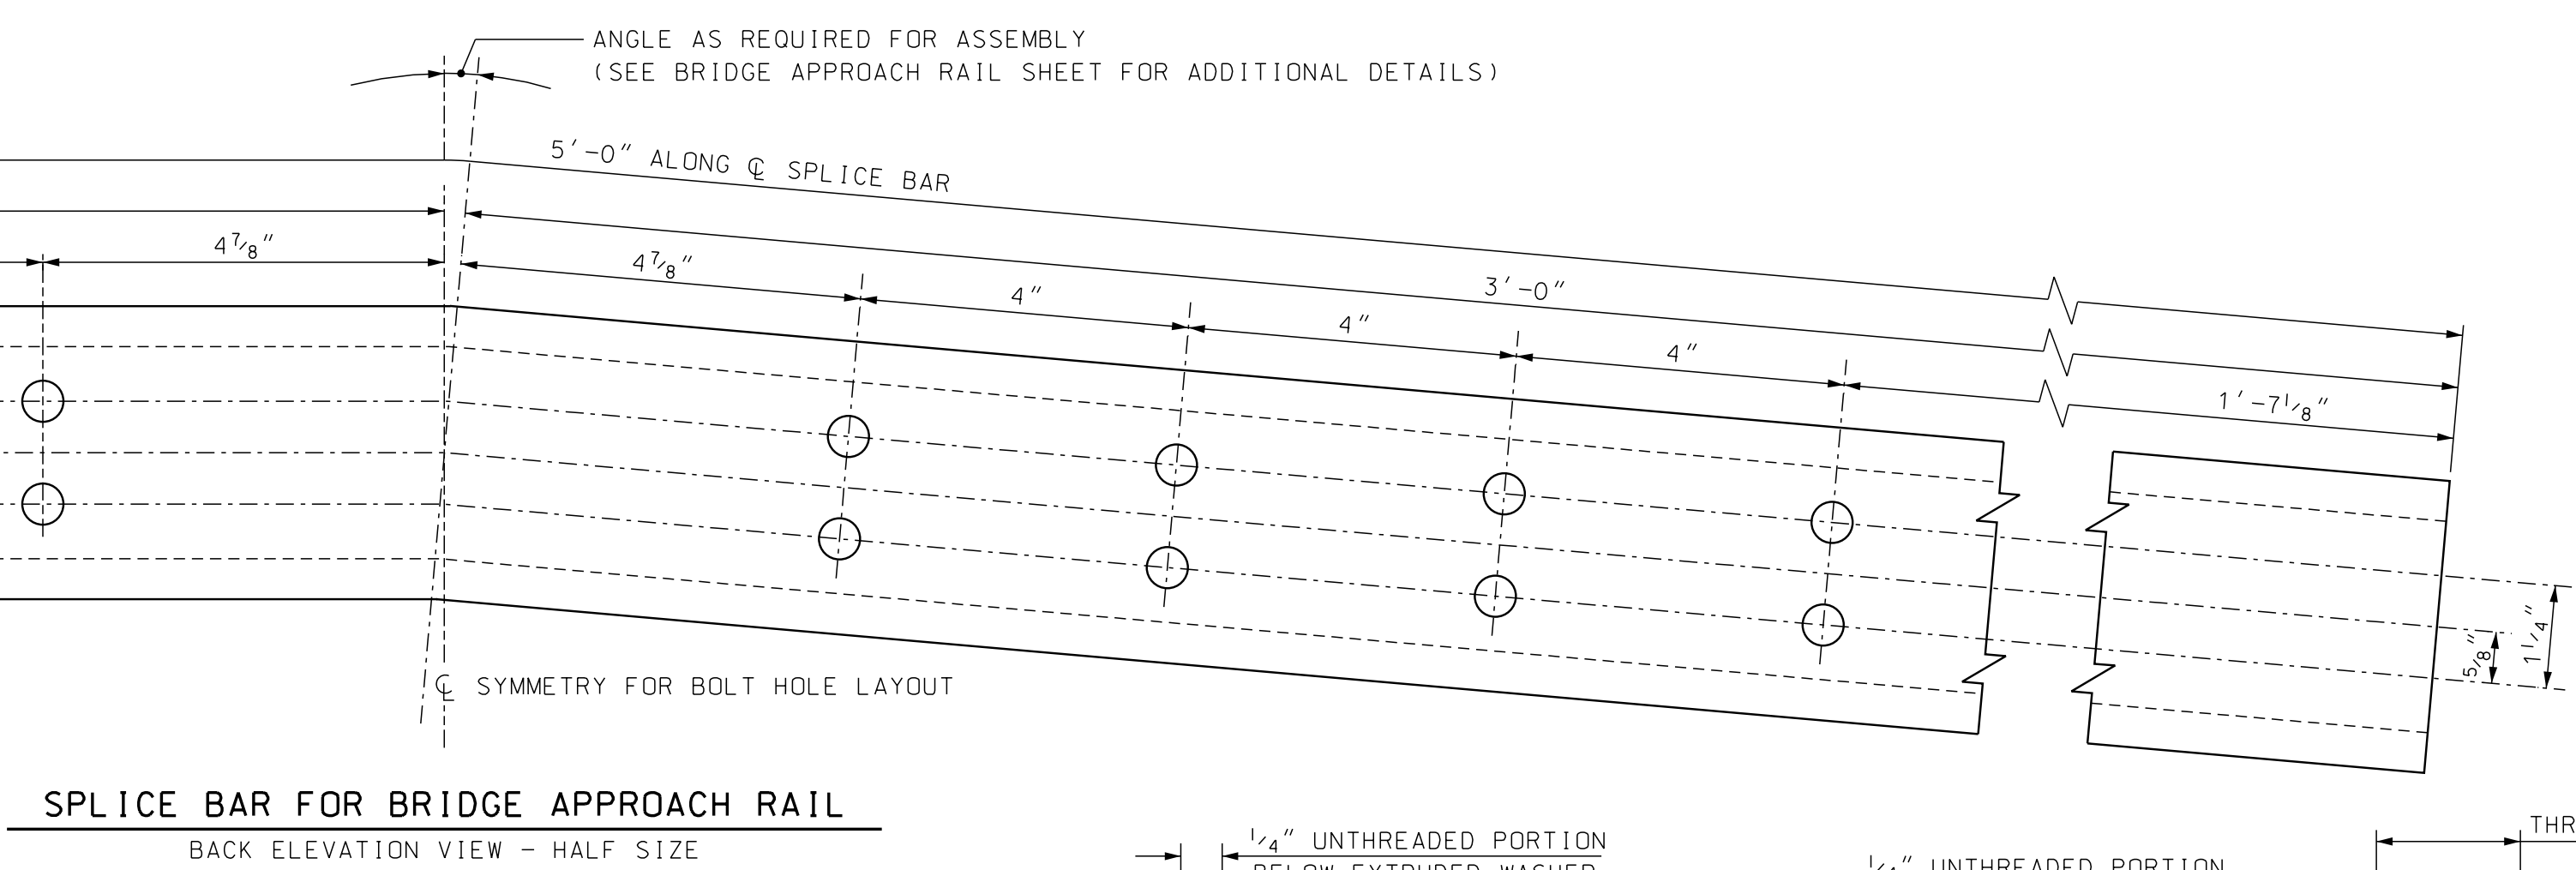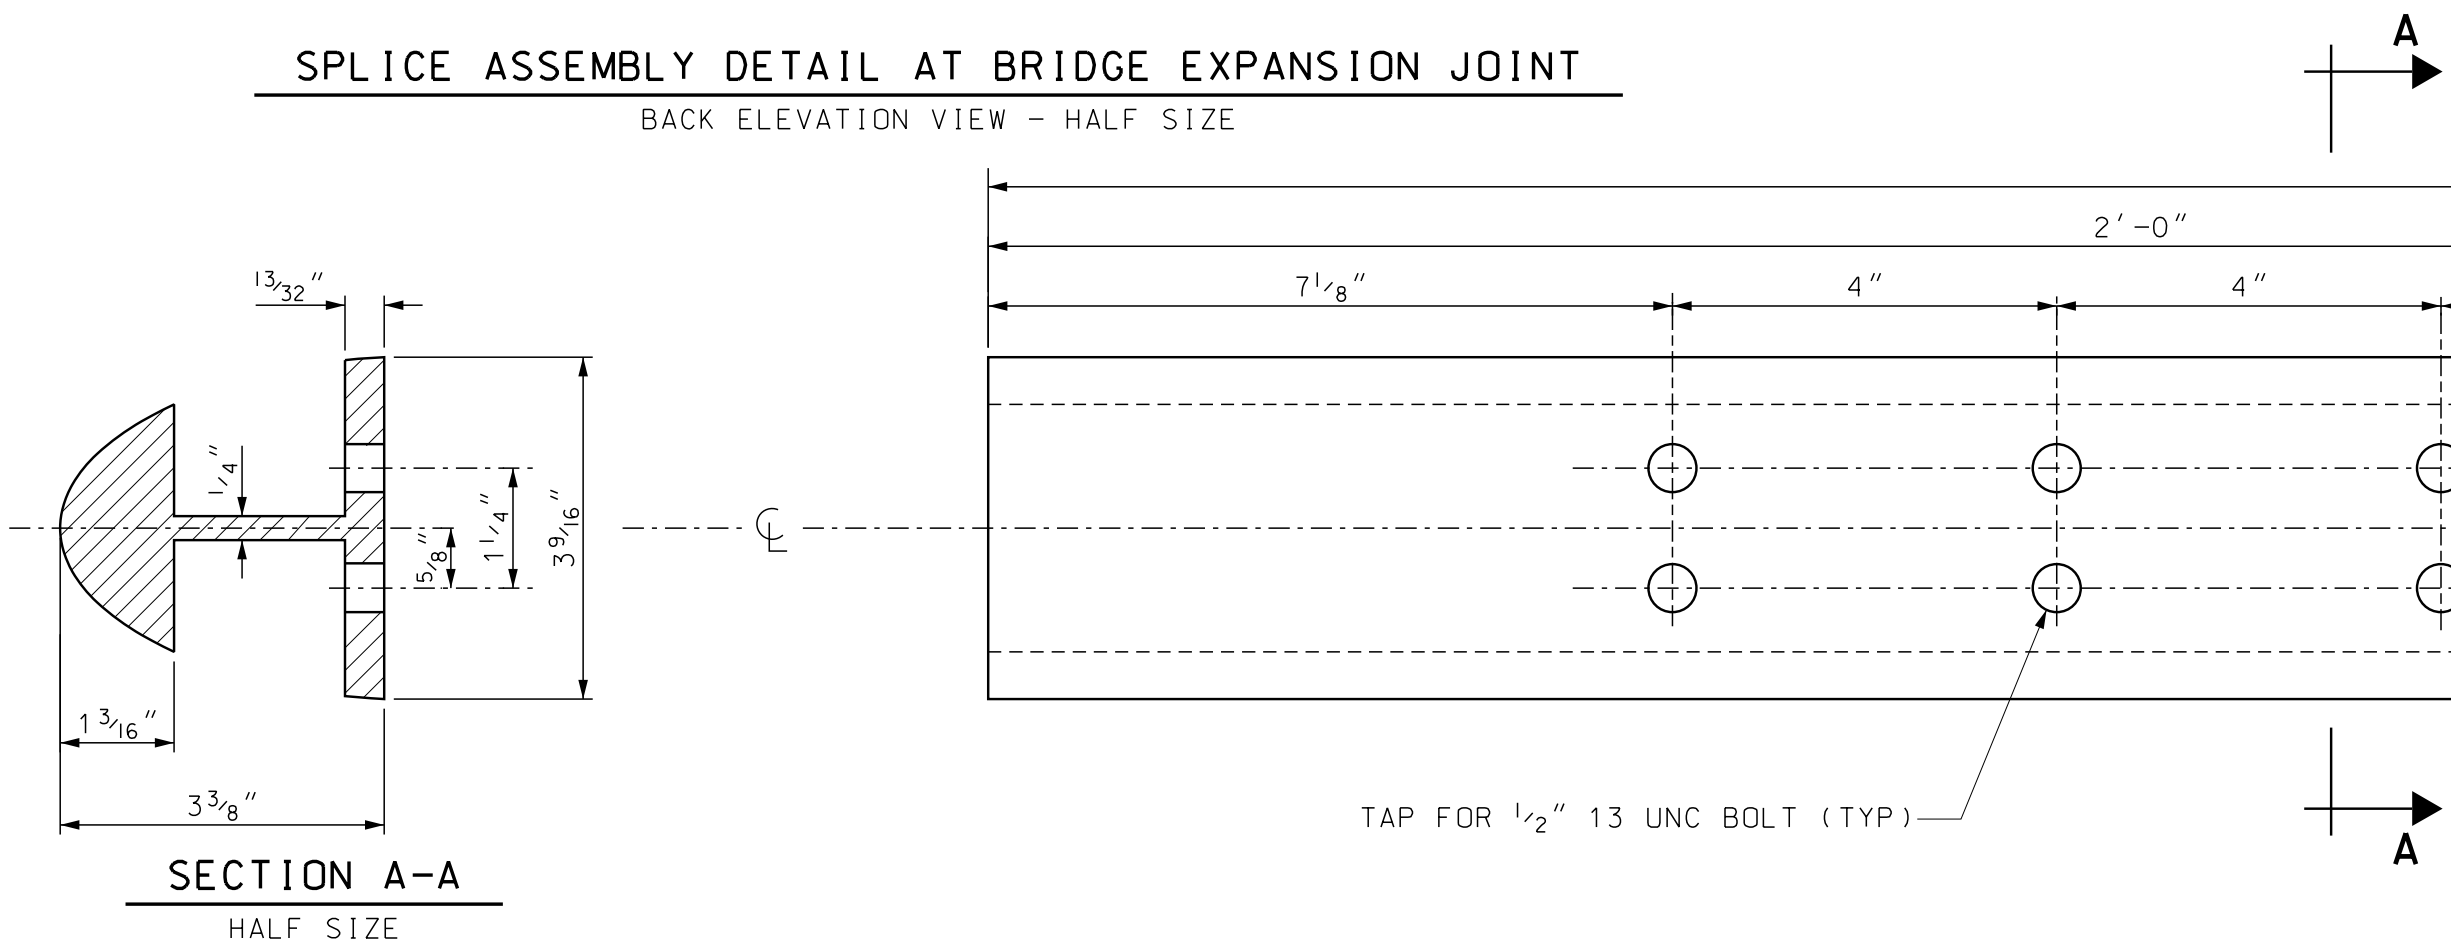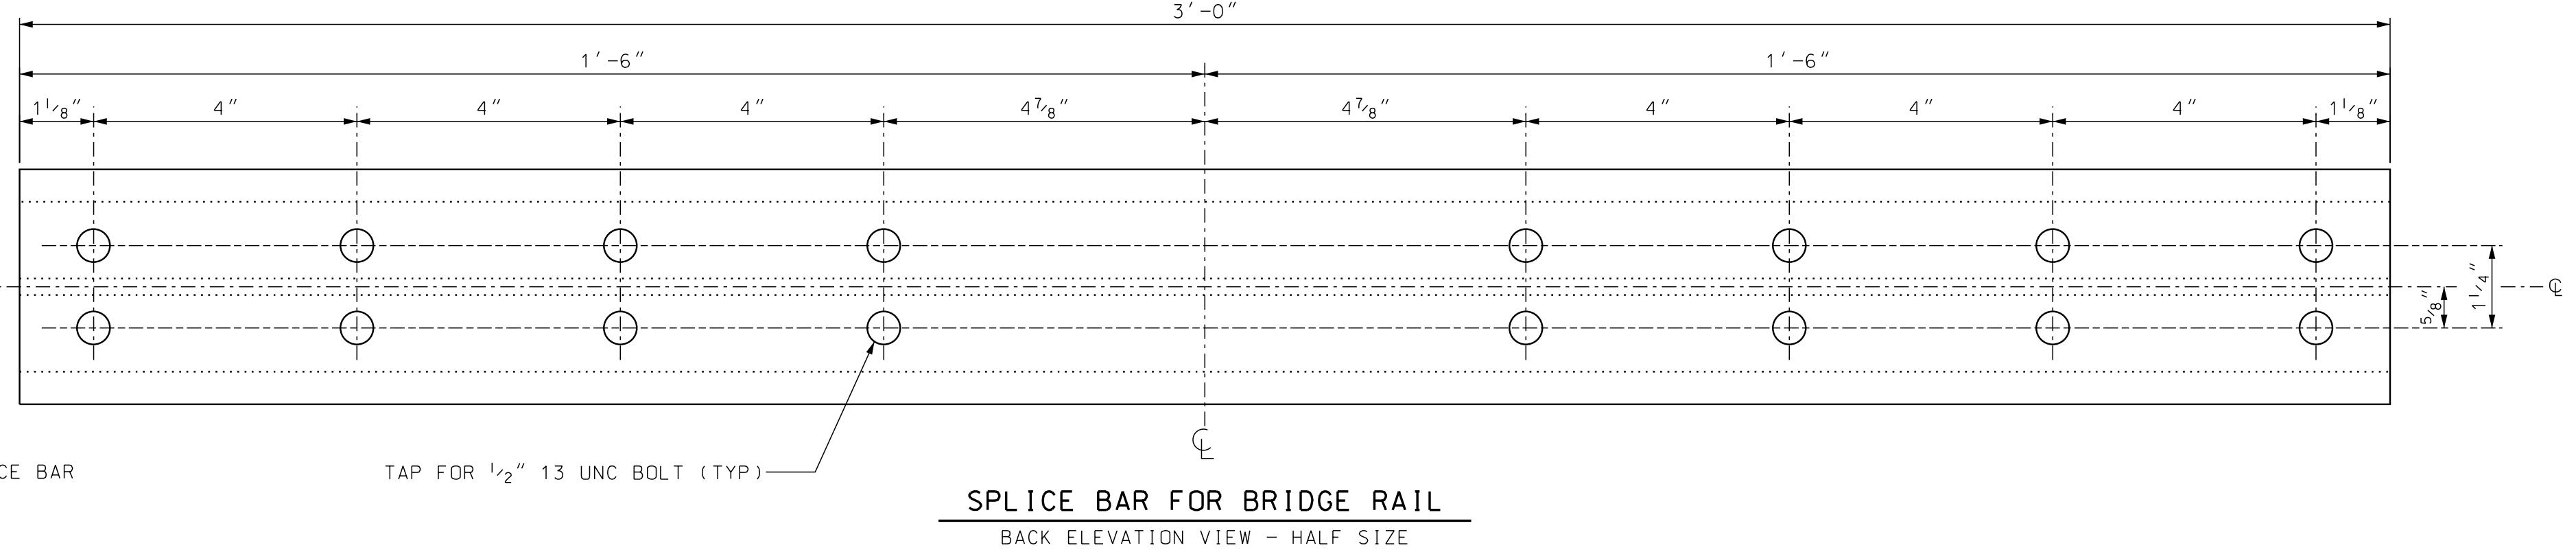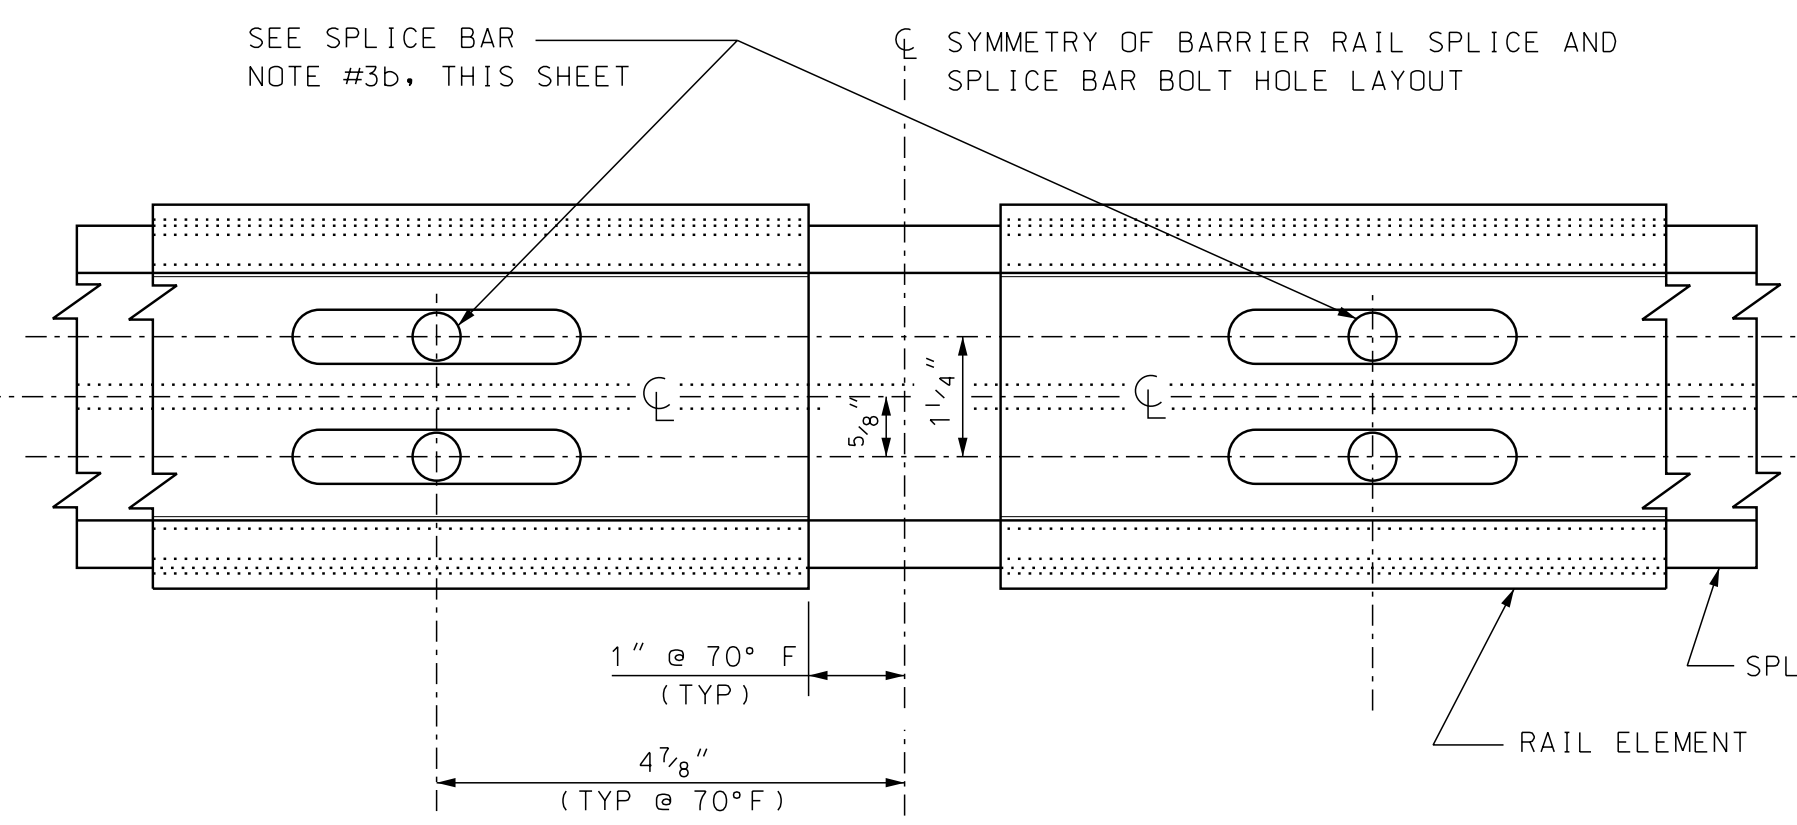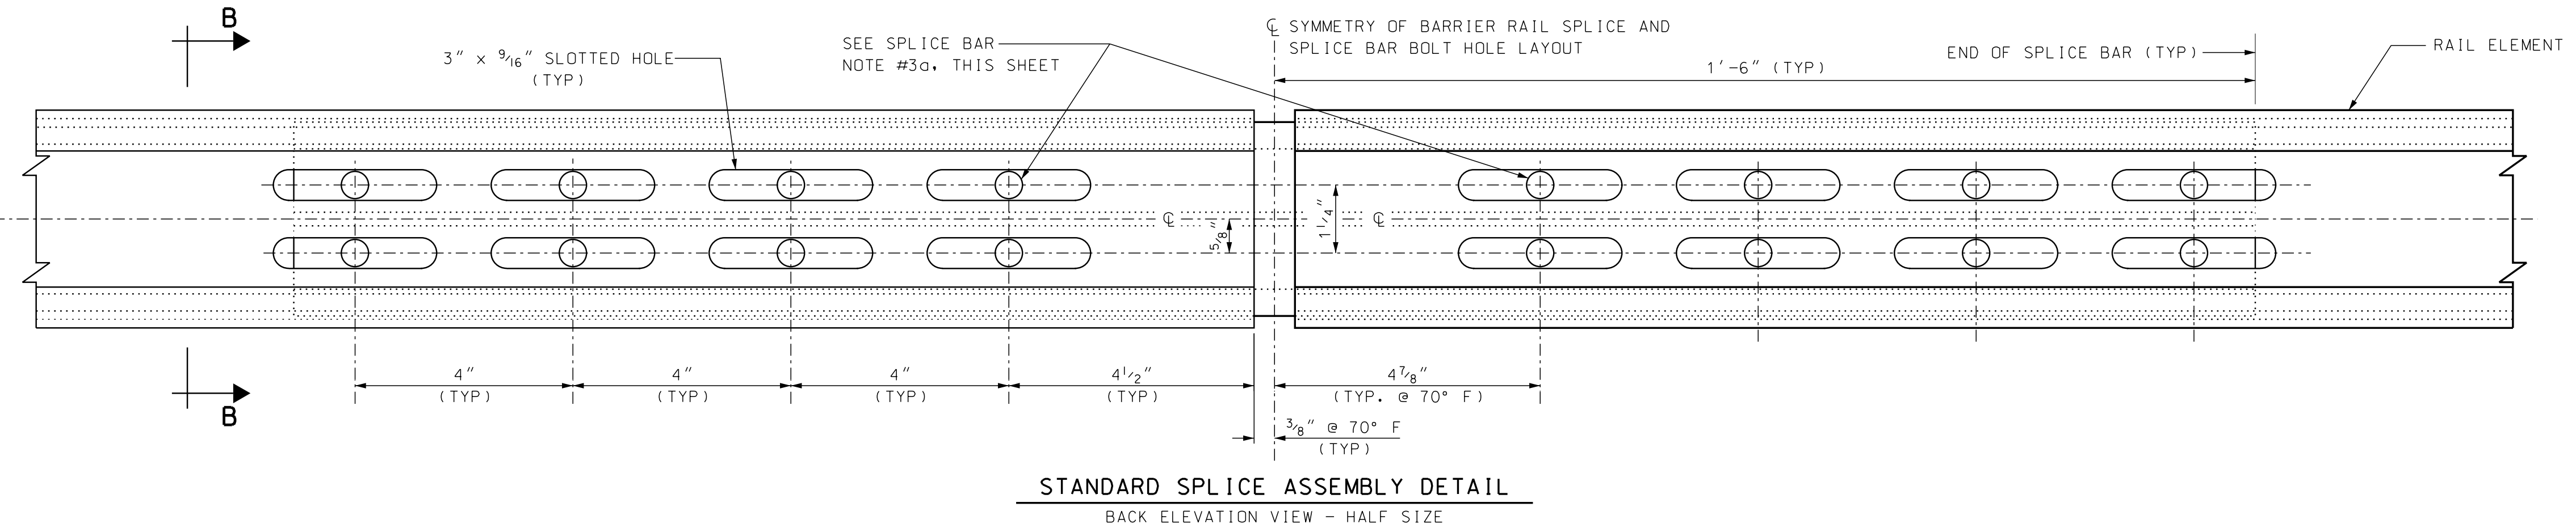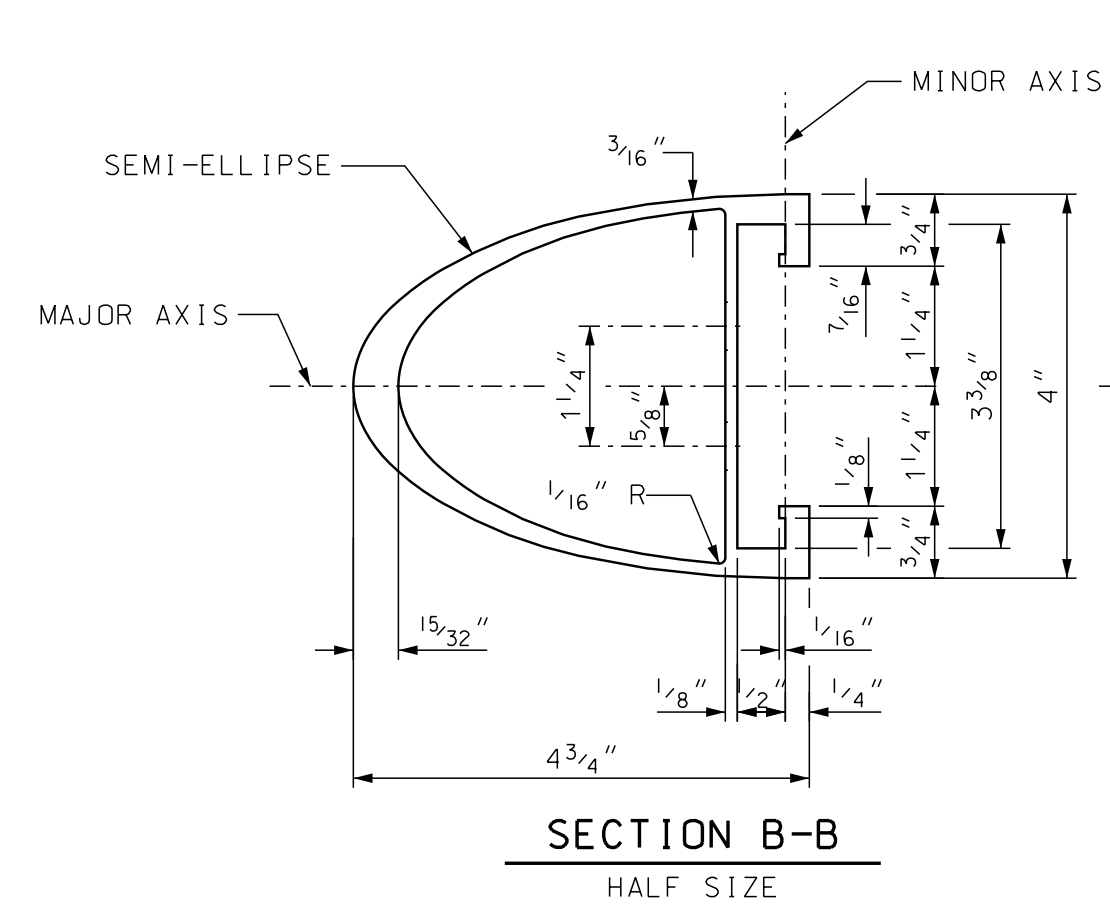


- SPLICE BAR NOTES**
- (1) FOR MATERIALS SPECIFICATIONS AND ADDITIONAL DETAILS, SEE THE BRIDGE RAIL AND BRIDGE APPROACH RAIL SHEETS.
 - (2) ALL BRIDGE RAILS AND BRIDGE APPROACH RAILS SHALL HAVE SLOTTED HOLES AT BOTH ENDS OF EACH RAIL ELEMENT.
 - (3) THE SPLICE BAR SHALL BE ATTACHED TO THE RAIL ELEMENT AS FOLLOWS:
 - (a) THE STANDARD SPLICE FOR BOTH BRIDGE AND APPROACH RAILS SHALL BE FASTENED ON ONE SIDE USING STANDARD BOLTS & WASHERS TIGHTENED SECURELY. THE OTHER SIDE OF THE SPLICE SHALL USE THE PARTIALLY THREADED BOLT WITH EITHER THE EXTRUDED WASHER OR THE WELDED WASHER, TIGHTENED SECURELY TO THE END OF THE THREADS, AND LEAVING A 1/8" GAP. THIS ALLOWS EXPANSION ON ONE SIDE OF THE JOINT.
 - (b) THE RAIL SPLICE AT THE BRIDGE EXPANSION JOINT SHALL BE FASTENED ON BOTH SIDES OF THE RAIL SPLICE USING THE PARTIALLY THREADED BOLTS, WITH EITHER THE EXTRUDED WASHER OR THE WELDED WASHER, TIGHTENED SECURELY TO THE END OF THE THREADS, AND LEAVING A 1/8" GAP. THIS ALLOWS EXPANSION ON BOTH SIDES OF THE JOINT.

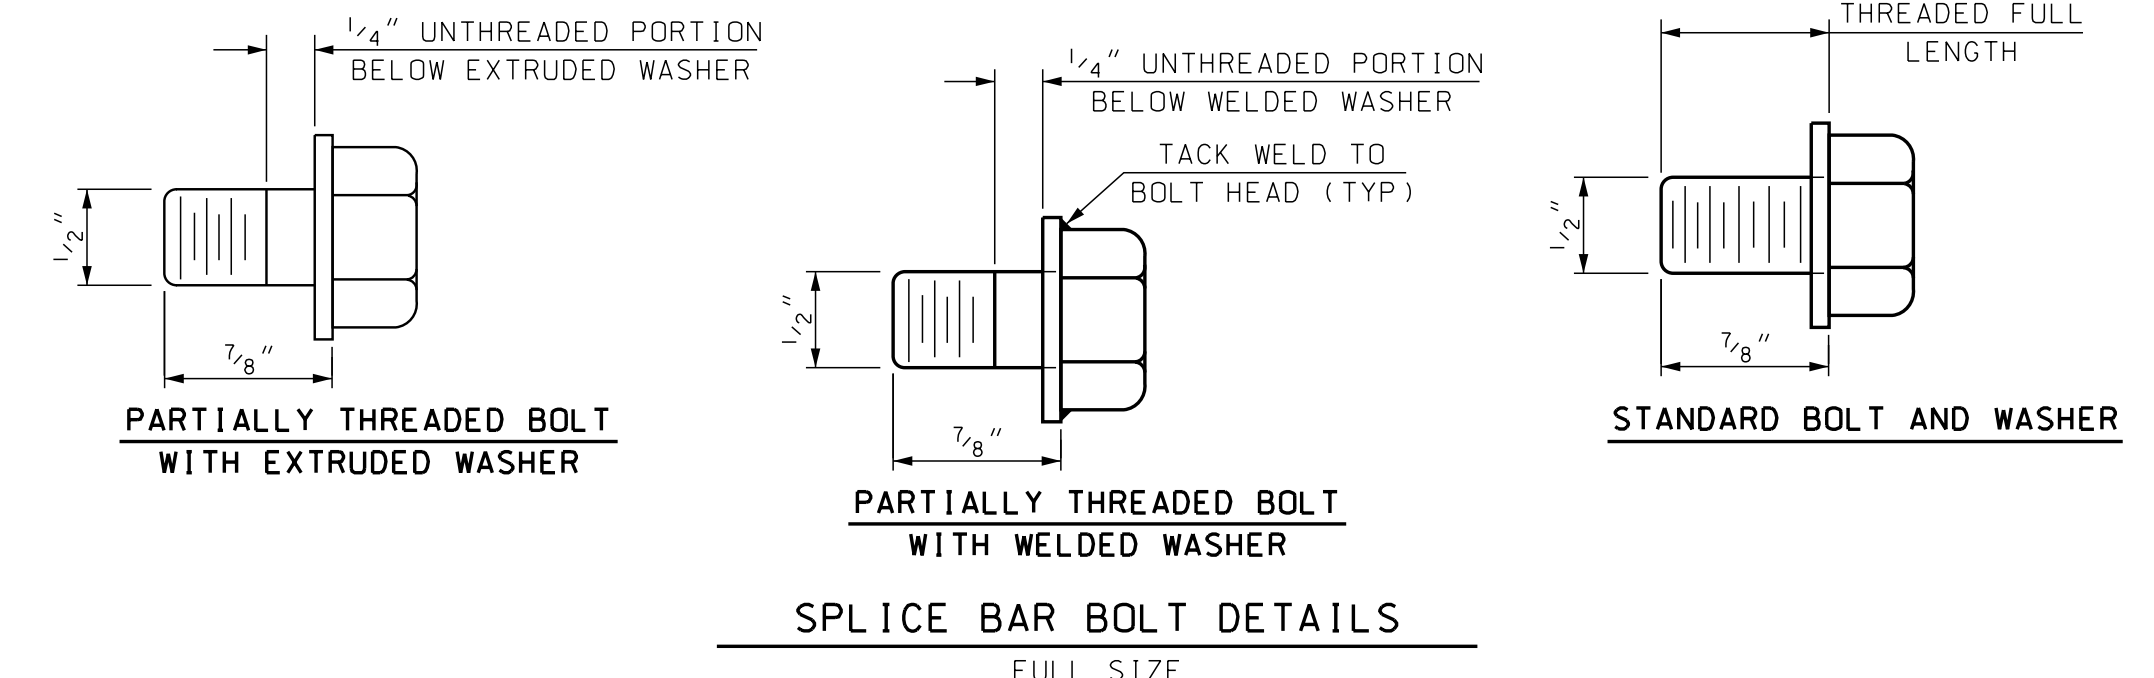


STATE OF NEW HAMPSHIRE									
DEPARTMENT OF TRANSPORTATION * BUREAU OF BRIDGE DESIGN									
TOWN	HOOKSETT	BRIDGE NO.	080/148	STATE PROJECT	28435	BRIDGE SHEET			
LOCATION	MAIN STREET over B&M RR, MERRIMACK RIVER, & RIVERSIDE STREET					16 OF 18			
ALUMINUM RAIL SPLICE BAR DETAILS									
DESIGNED	NHDOT	DATE	9/87	CHECKED	NHDOT	BY	DATE	FILE NUMBER	
DRAWN	NDS/MTG	DATE	4/01	CHECKED	PJP	DATE	6/01	126-1-1	
QUANTITIES			CHECKED						
ISSUE DATE	10/87	FEDERAL PROJECT NO.			SHEET NO.	TOTAL SHEETS			
REV. DATE	12/20/13	-----		20		42			


SUBDIRECTORY	DGN LOCATOR	SHEET SCALE
BRC/STANDARDS	AL-SPLICEBAR	AS NOTED

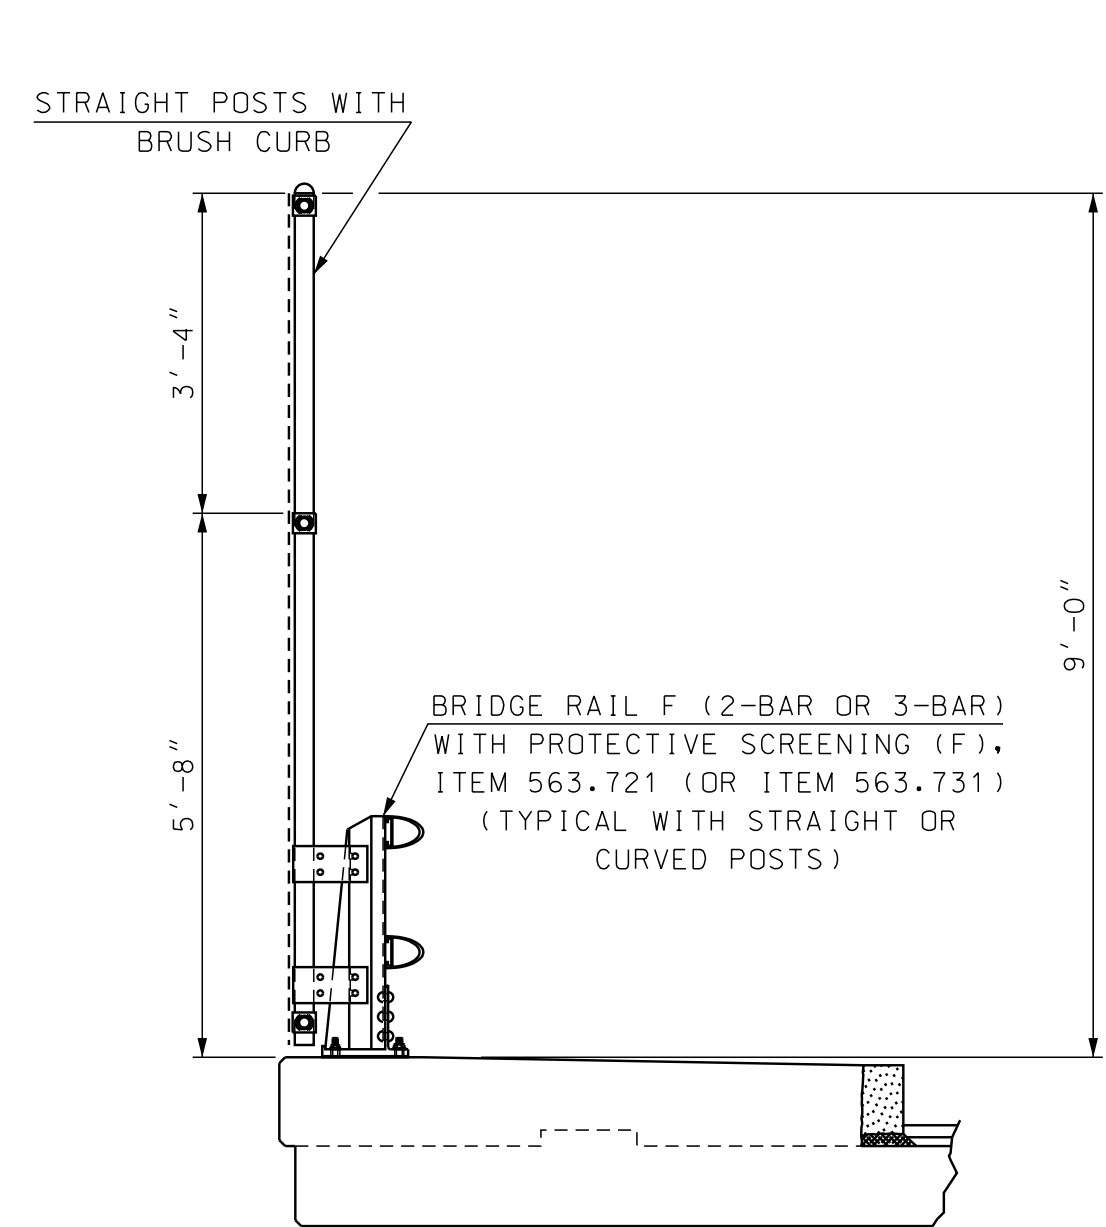


SECTION A-A
SCALE: 1/2" = 1'-0"

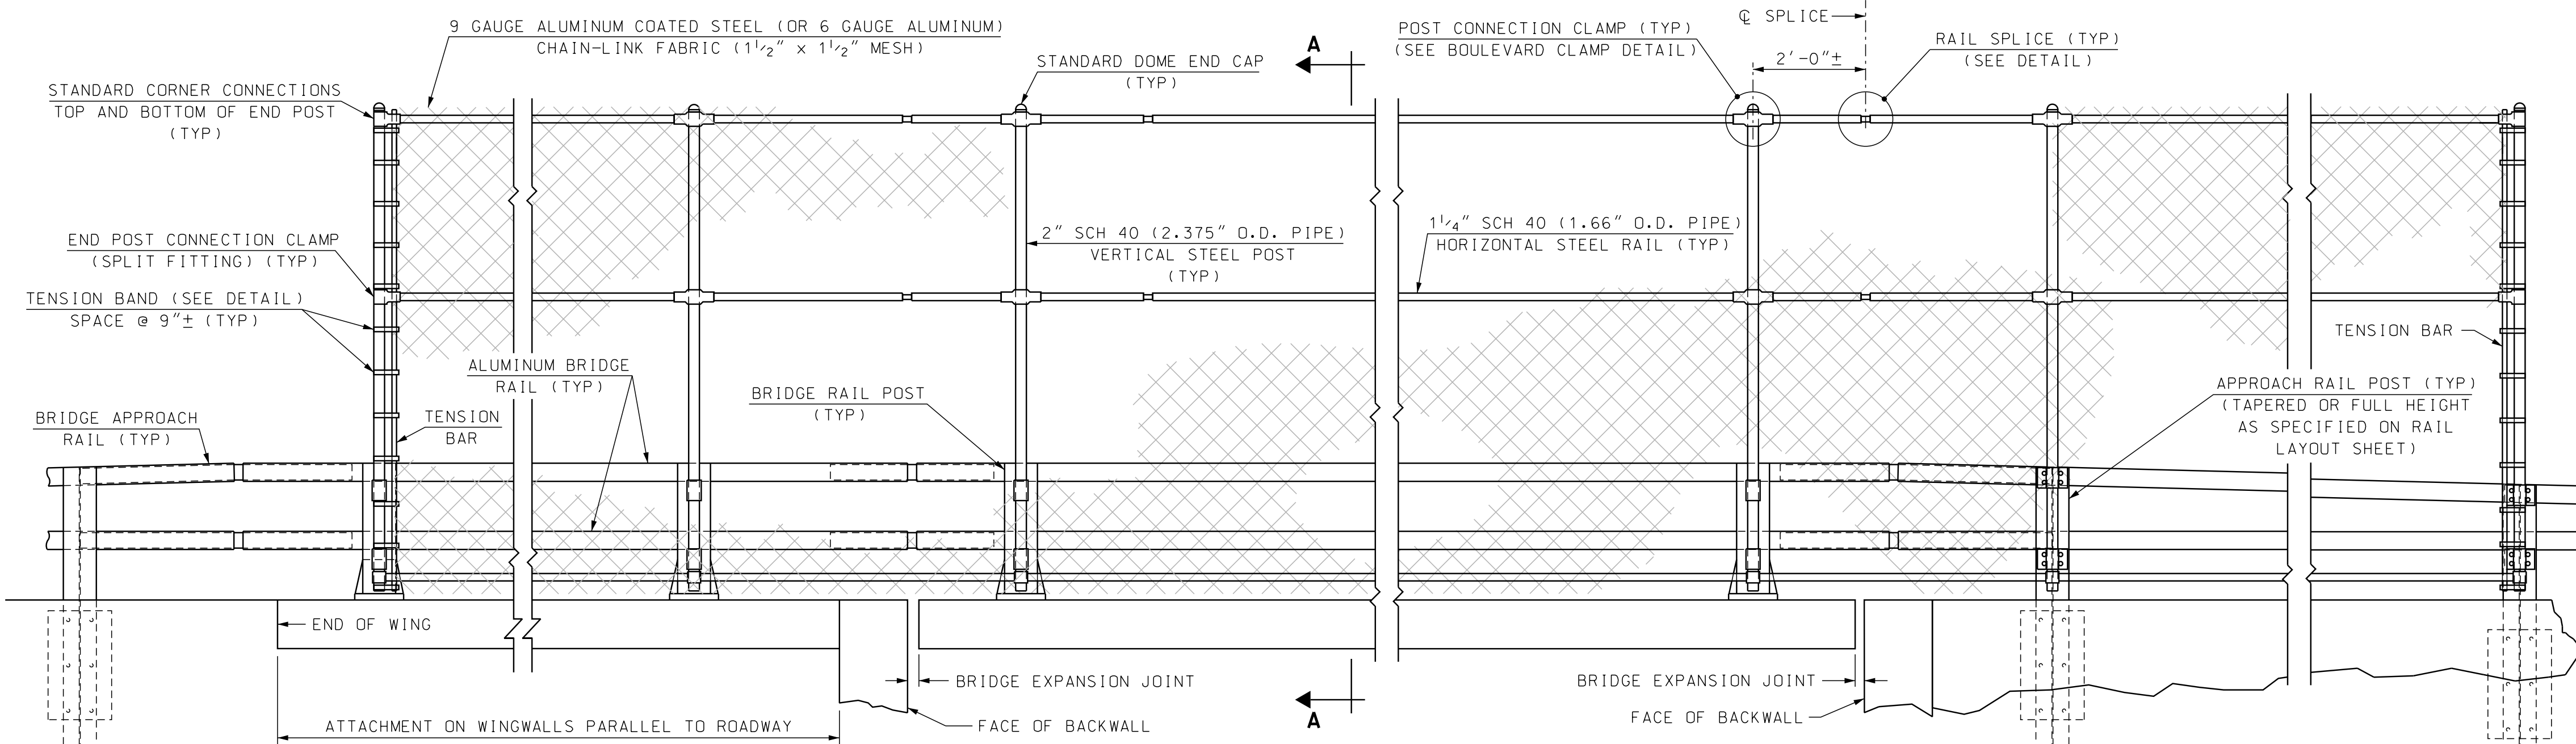


BACK SIDE ELEVATION VIEW
SCALE: 1/2" = 1'-0"

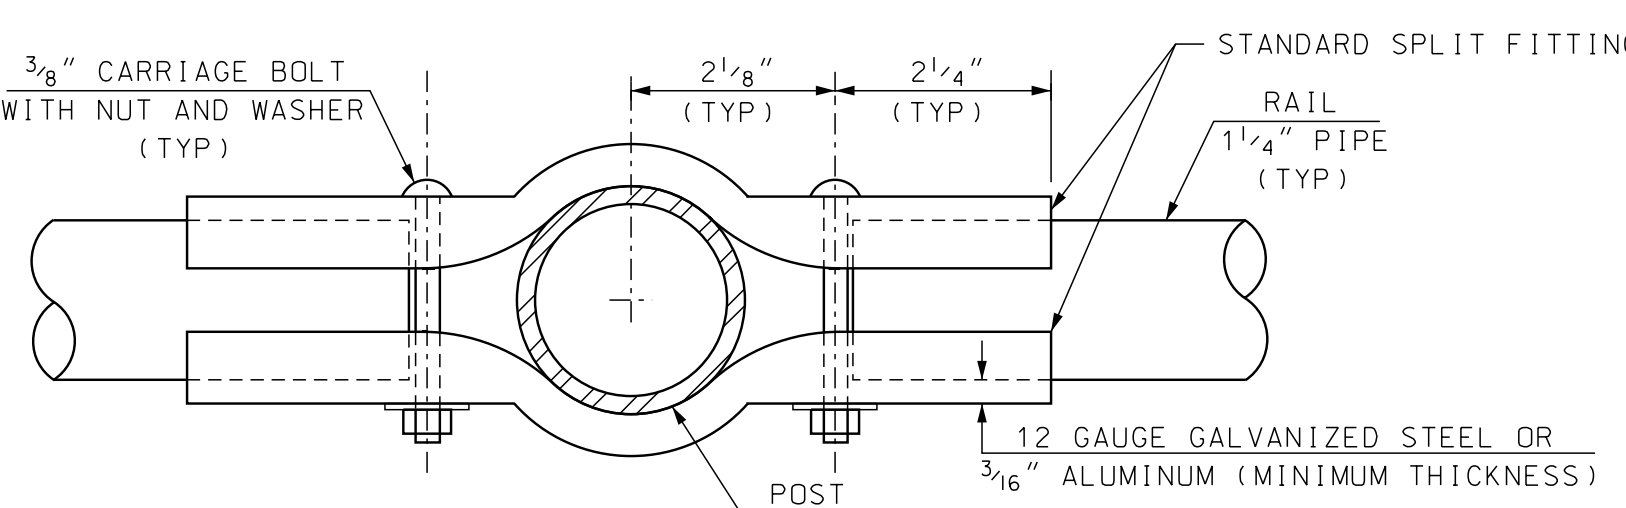


BOULEVARD CLAMP DETAIL
SCALE: 6" = 1'-0"

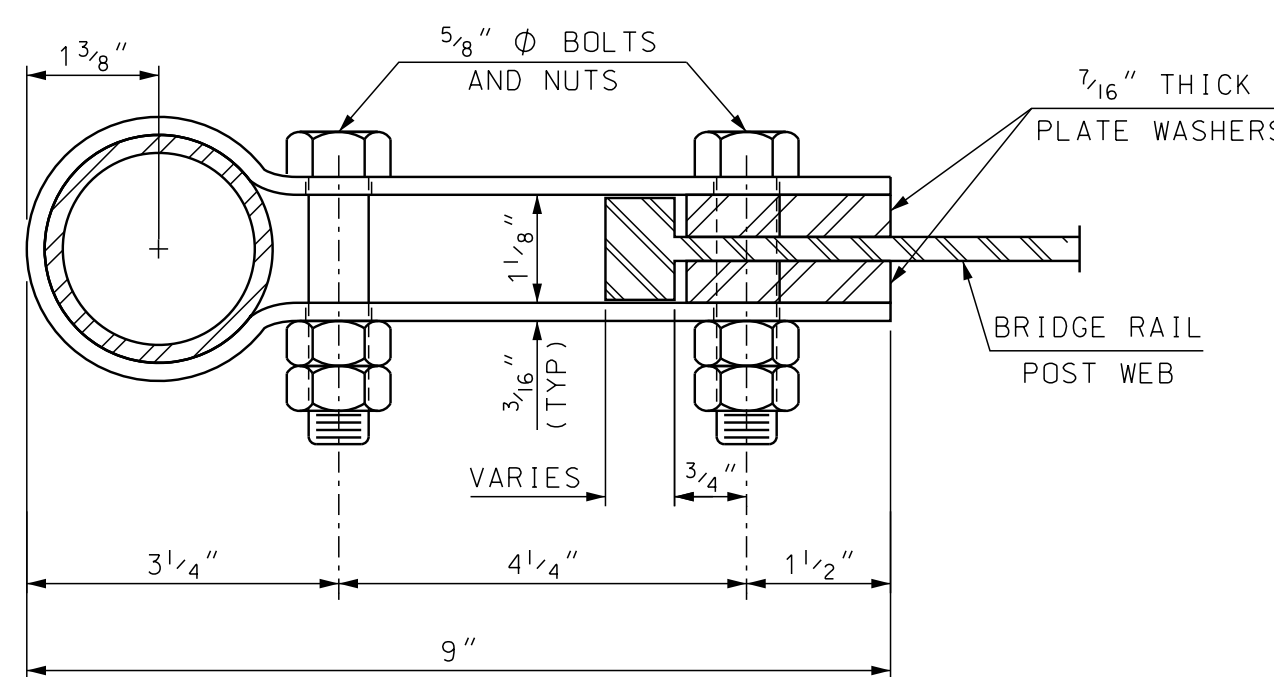

SECTION B-B
SCALE: 6" = 1'-0"

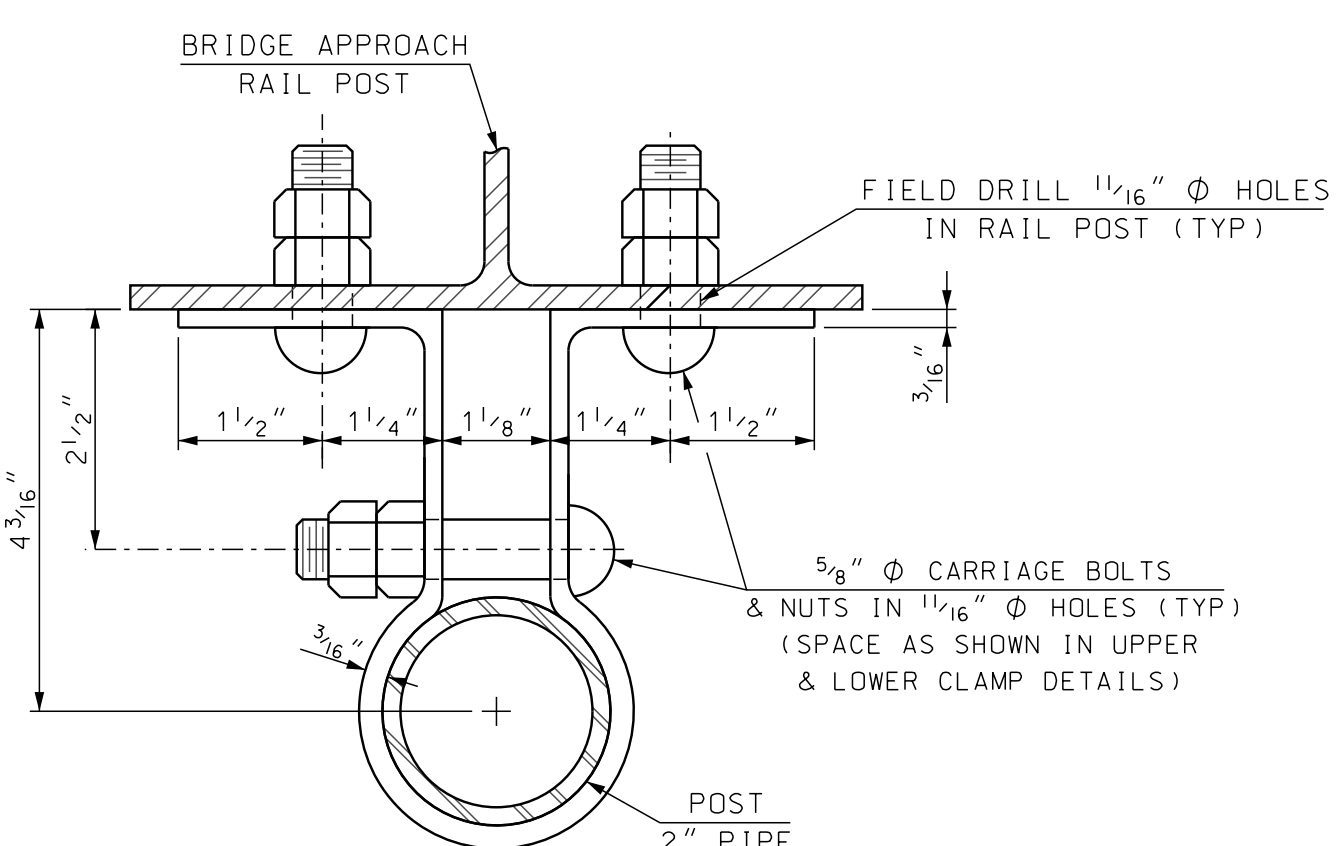


CLAMP AT APPROACH RAIL
SCALE: 6" = 1'-0"

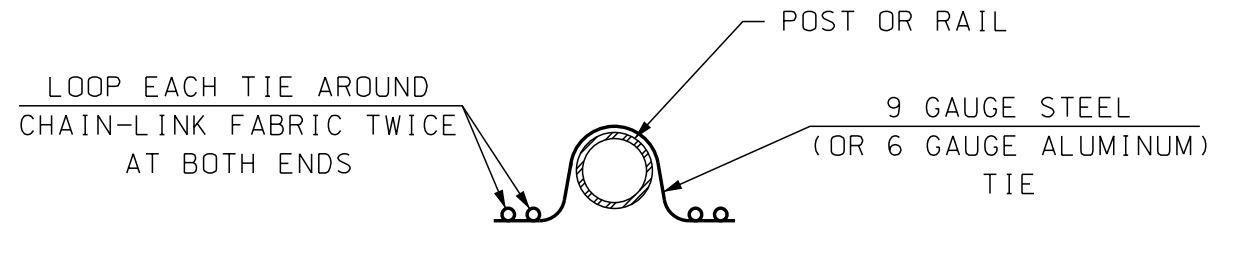


DOUBLE PIGTAILED TIE
NOT TO SCALE

GENERAL NOTES


- CHAIN-LINK FABRIC SHALL BE 9 GAUGE STEEL, ZINC-COATED CONFORMING TO AASHTO M 181, TYPE 1, CLASS D (ASTM A 392), ALUMINUM-COATED CONFORMING TO AASHTO M 181, TYPE II (ASTM A 491) OR 6 GAUGE ALUMINUM ALLOY CONFORMING TO AASHTO M 181, TYPE III (ASTM F 1183). CHAIN-LINK FABRIC SHALL BE KNUCKLED ON TOP AND BOTTOM. THE SIZE OF WIRE MESH (FABRIC) SHALL BE 1 1/2".
- WIRE TIES SHALL BE STANDARD ROUND 9 GAUGE ZINC- OR ALUMINUM-COATED STEEL OR 6 GAUGE ALUMINUM ALLOY CONFORMING TO ASTM F 626. ALL TIES SHALL BE WRAPPED AROUND CHAIN-LINK FABRIC TWICE (DOUBLE PIGTAILED) AT BOTH ENDS. SPACE TIES @ 6" O.C. TO BOTTOM RAIL AND @ 12" O.C. TO ALL POSTS AND OTHER RAILS.
- POST AND RAIL PIPE SHALL BE HOT-DIP GALVANIZED STEEL CONFORMING TO AASHTO M 181, GRADE 1 (ASTM F 1083) OR ALUMINUM ALLOY CONFORMING TO AASHTO M 181 (ASTM B 429, ALLOY 6063-T6). ALL PIPE SHALL BE SCHEDULE 40, STANDARD WEIGHT. NOMINAL PIPE SIZES ARE SHOWN ON THE DRAWING.
- TENSION BARS, BAR BANDS, BOULEVARD AND END CLAMPS SHALL BE STEEL OR ALUMINUM ALLOY CONFORMING TO AASHTO M 181 (ASTM F 626). STEEL COMPONENTS SHALL BE HOT-DIP GALVANIZED IN ACCORDANCE WITH AASHTO M 111 (ASTM A 123) OR AASHTO M 232 (ASTM A 153) AS APPLICABLE.
- ALL BOLTS AND NUTS SHALL BE STEEL CONFORMING TO ASTM A 307 AND ASTM A 563 GRADE A RESPECTIVELY. WASHERS SHALL BE HARDENED STEEL COMMERCIAL TYPE A PLAIN AND SHALL MEET THE DIMENSIONAL REQUIREMENTS OF ANSI B18.22. ALL BOLTS, NUTS AND WASHERS SHALL BE HOT-DIP GALVANIZED IN ACCORDANCE WITH AASHTO M 111 (ASTM A 123) OR AASHTO M 232 (ASTM A 153) AS APPLICABLE.
- RAIL SPLICES SHALL BE PROVIDED AT BRIDGE DECK EXPANSION JOINT(S) AND BRIDGE RAIL SPLICES AS DIRECTED BY THE CONTRACTOR ADMINISTRATOR.
- RAIL MAY BE FIELD CUT (SAWN) TO FIT POST SPACING. GALVANIZED RAIL, CUT OR DRILLED AS ALLOWED, SHALL BE TOUCHED-UP IN ACCORDANCE WITH 563.3.2.2.3.
- ALL COSTS FOR CHAIN-LINK FABRIC, POSTS, RAILS AND APPURTENANCES SHALL BE INCLUDED IN ITEM 563.971, PROTECTIVE SCREENING FOR OVERPASS STRUCTURES RAIL F.

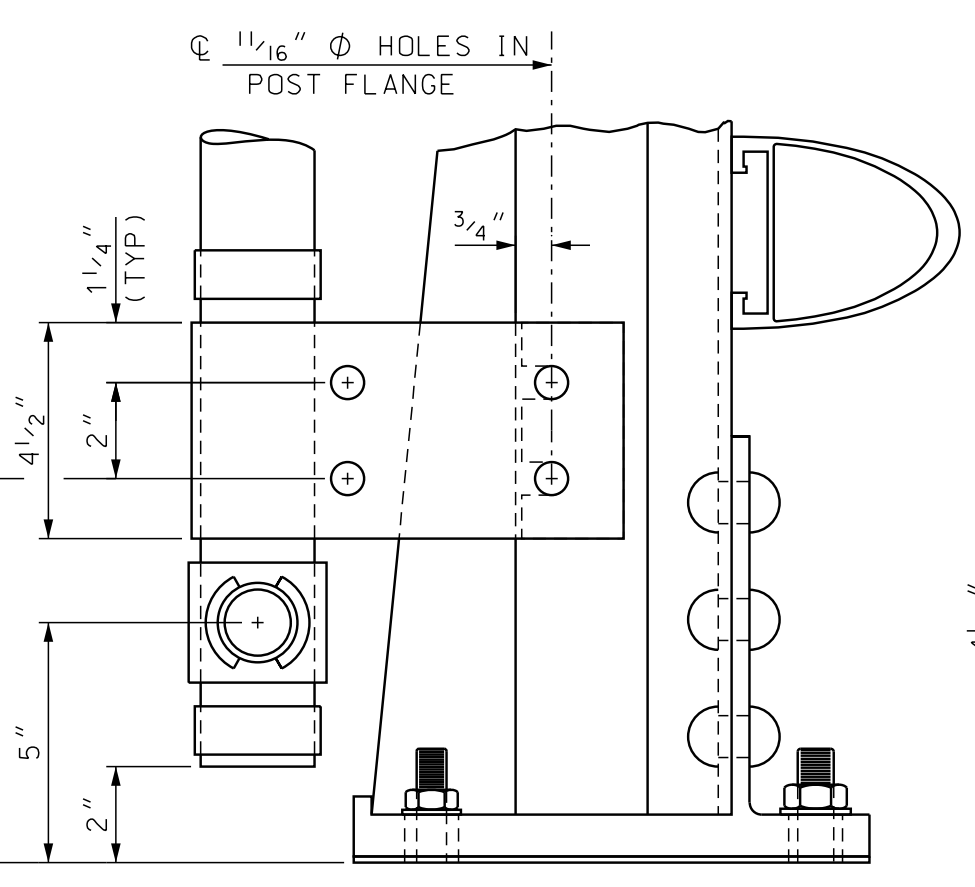

LOWER CLAMP DETAILS
TYPICAL WITH 2-BAR & 3-BAR RAIL
(BASE OF FENCE)
SCALE: 3" = 1'-0"

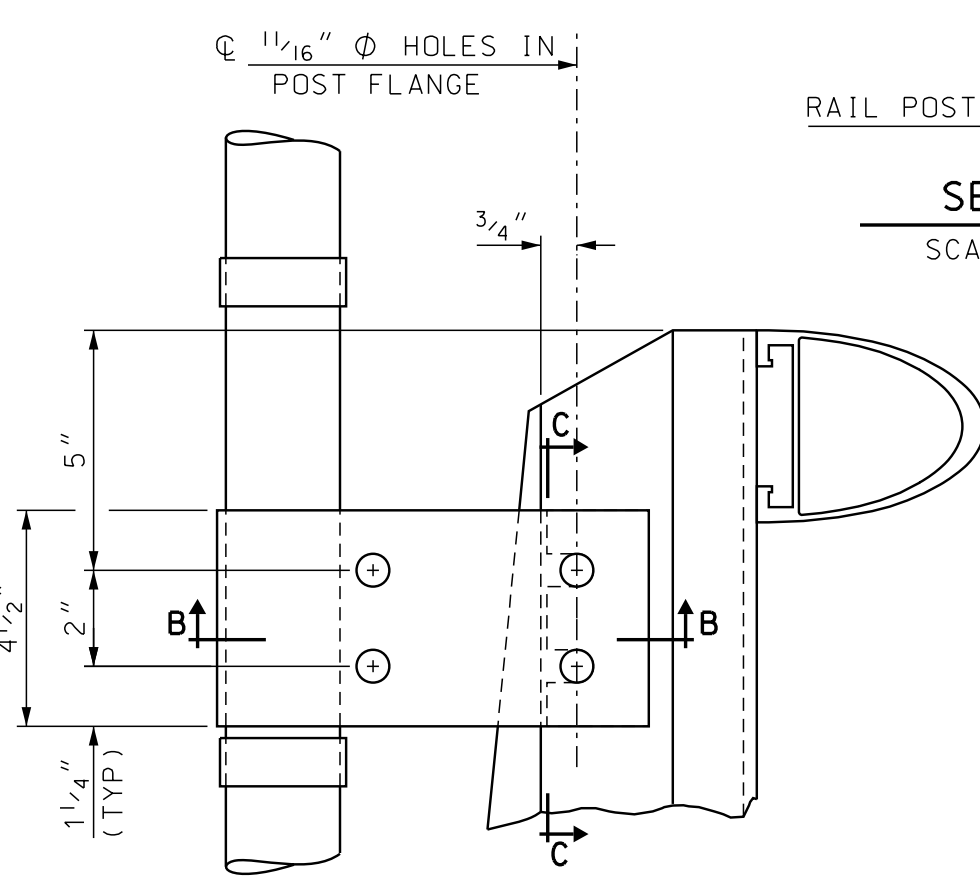

UPPER CLAMP DETAILS
TYPICAL WITH 2-BAR & 3-BAR RAIL
(TOP OF RAIL POST)
SCALE: 3" = 1'-0"

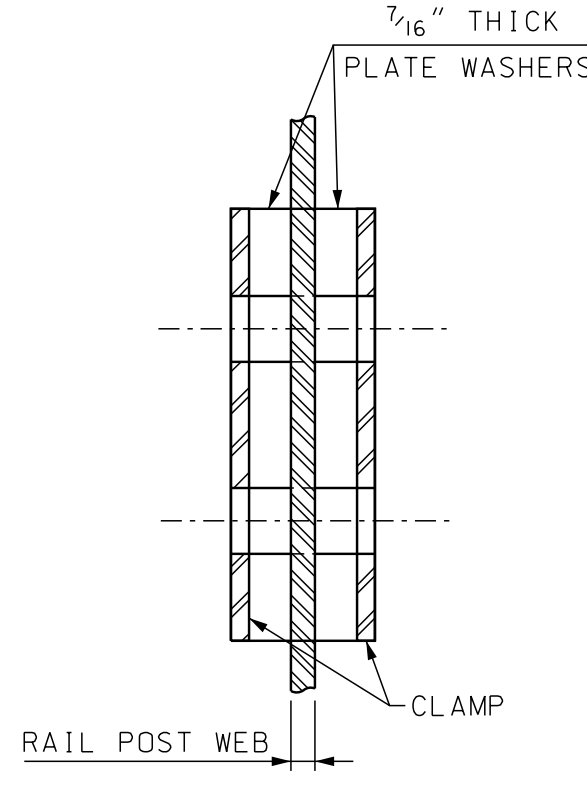

SECTION C-C
SCALE: 6" = 1'-0"



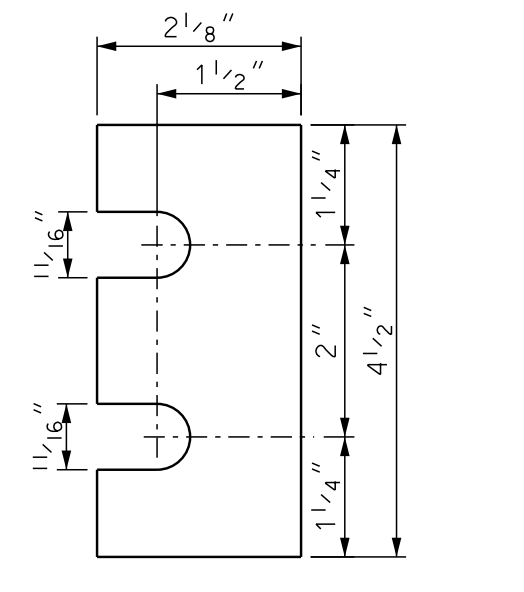


PLATE WASHER DETAIL
SCALE: 6" = 1'-0"

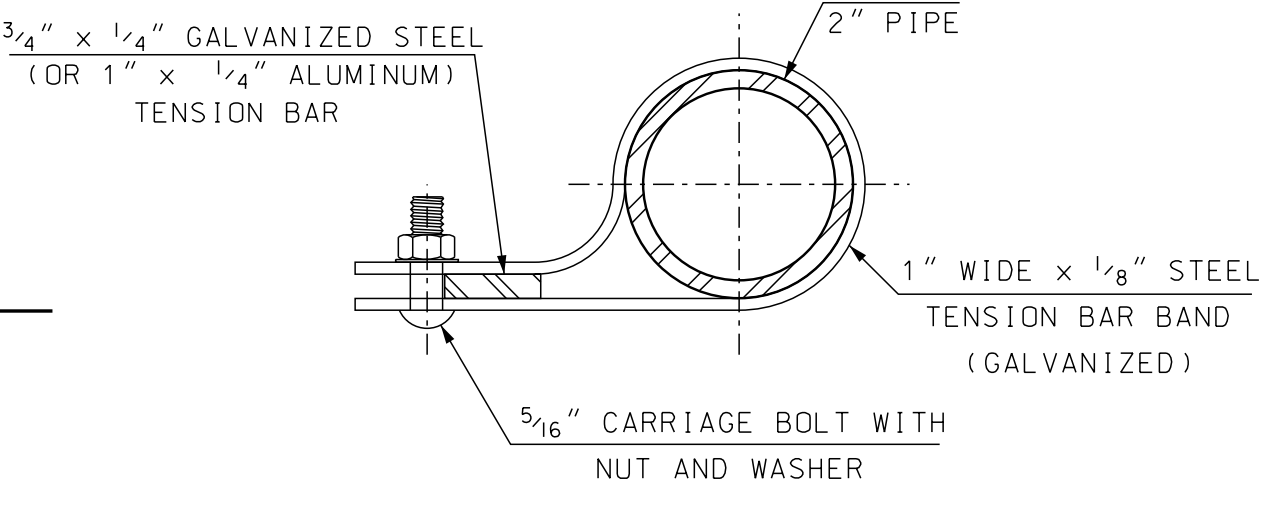


TENSION BAND DETAIL
SCALE: 6" = 1'-0"

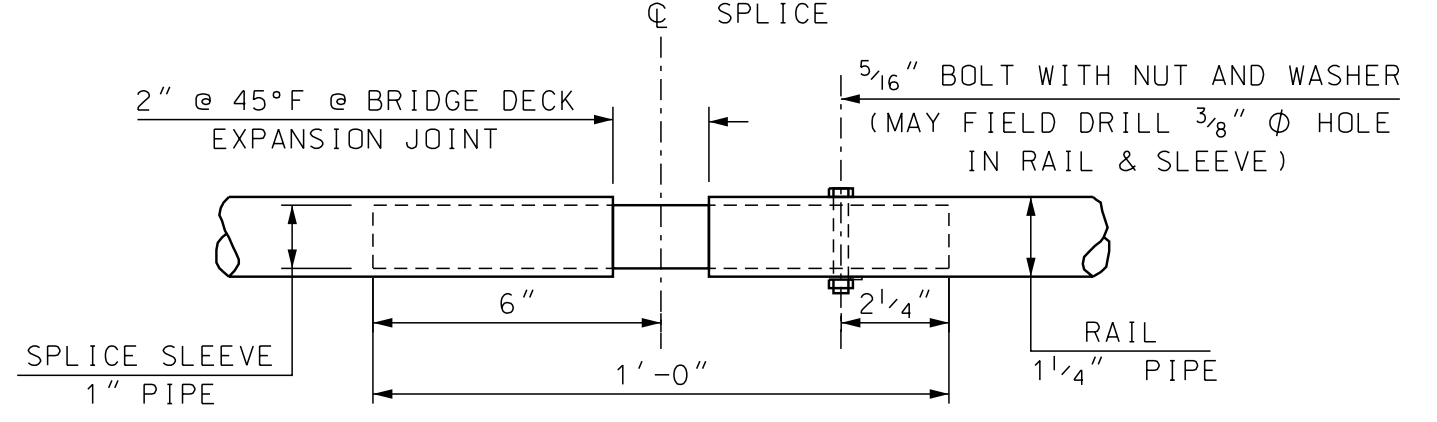


RAIL SPLICE DETAIL
SCALE: 3" = 1'-0"

STATE OF NEW HAMPSHIRE									
DEPARTMENT OF TRANSPORTATION * BUREAU OF BRIDGE DESIGN									
TOWN	HOOKSETT	BRIDGE NO.	080/148	STATE PROJECT	28435				
LOCATION	MAIN STREET over B&M RR, MERRIMACK RIVER, & RIVERSIDE STREET								
PROTECTIVE SCREENING FOR ALUMINUM BRIDGE RAIL						BRIDGE SHEET			
REVISIONS AFTER PROPOSAL		DESIGNED	BY	DATE	CHECKED	NHDOT	6/06	FILE NUMBER	17 OF 18
		DRAWN	PJP	6/06	CHECKED	MGL	6/06	126-1-1	
		QUANTITIES			CHECKED				
ISSUE DATE		FEDERAL PROJECT NO.		SHEET NO.	21	TOTAL SHEETS	42		
REV. DATE									



SUBDIRECTORY	DGN LOCATOR	SHEET SCALE
BRC/STANDARD	AL-RAIL_PROSCRN	AS NOTED

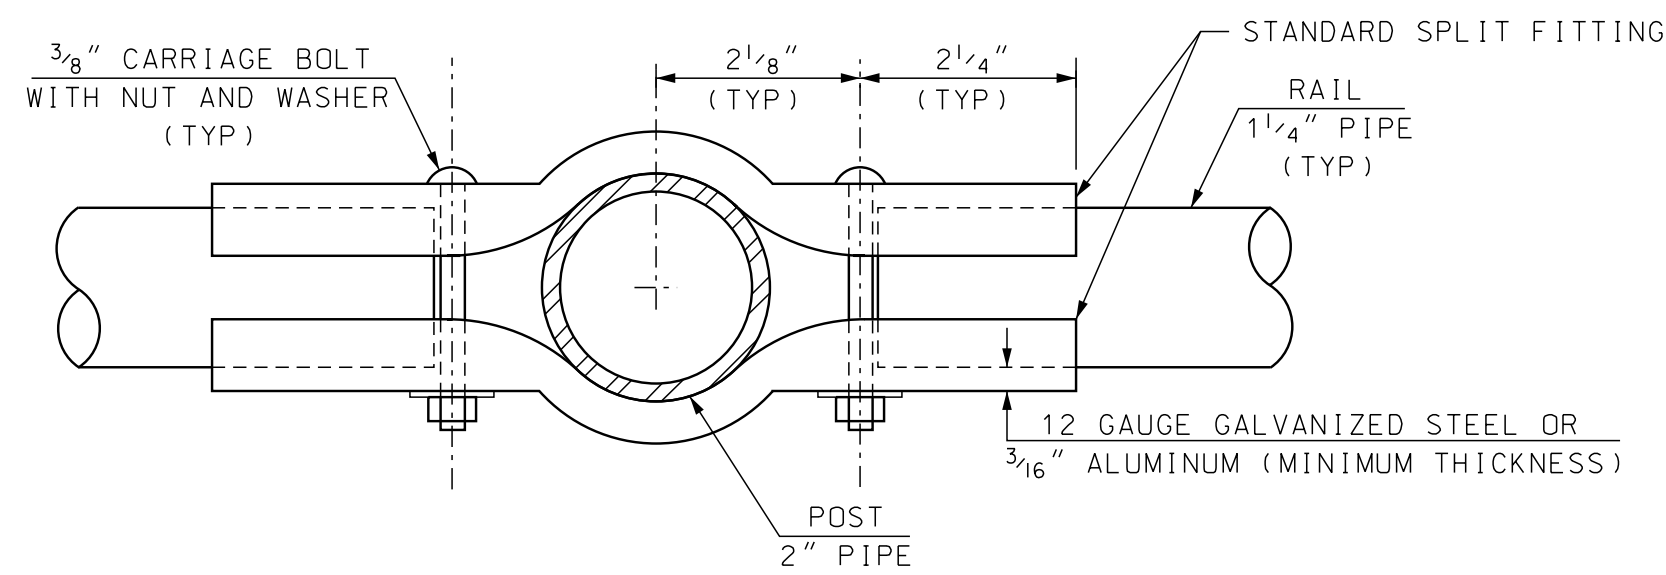


BOULEVARD CLAMP DETAIL
SCALE: 6" = 1'-0"

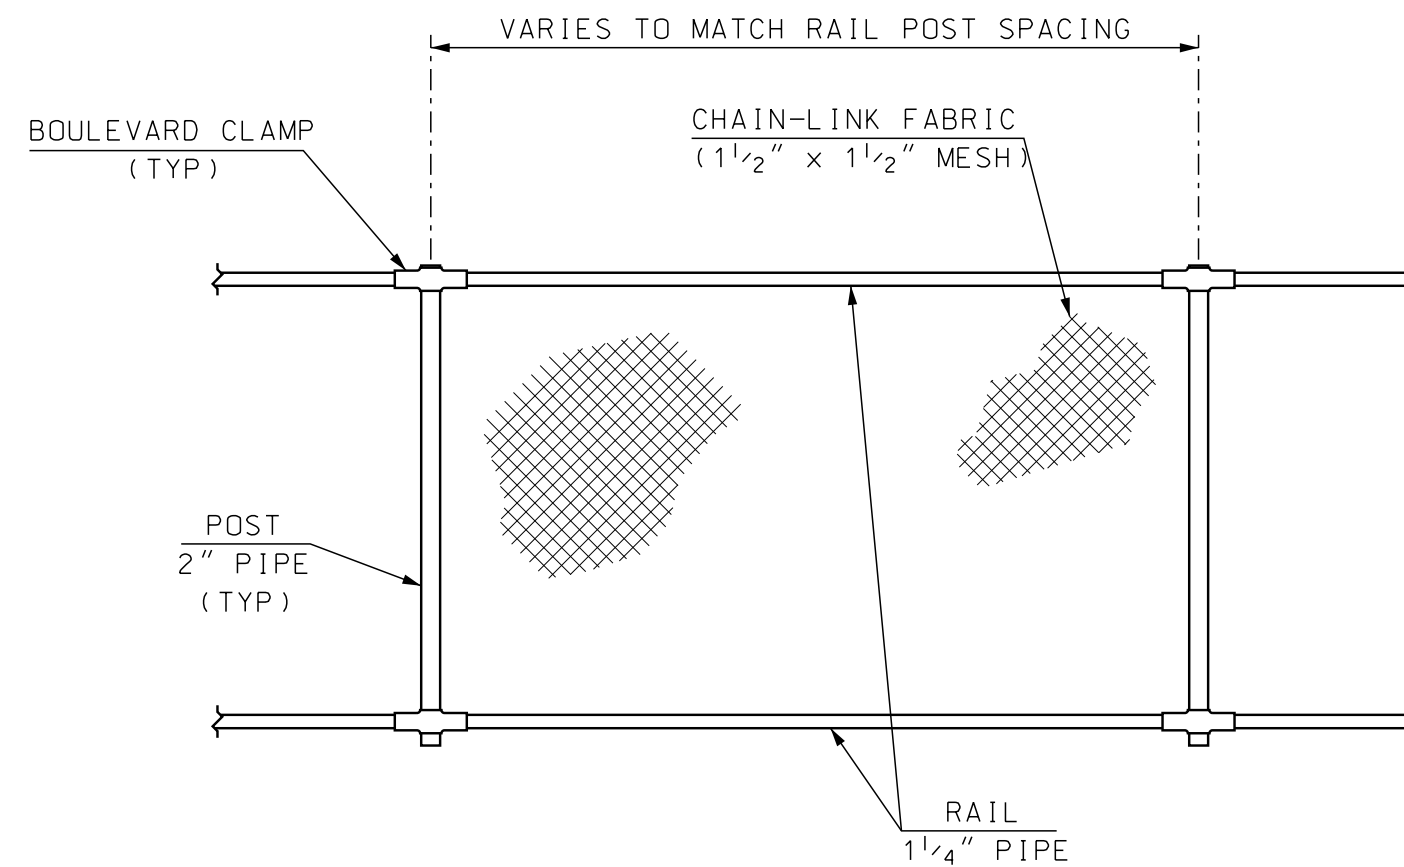


ELEVATION - SNOW SCREENING
SCALE: 1/2" = 1'-0"

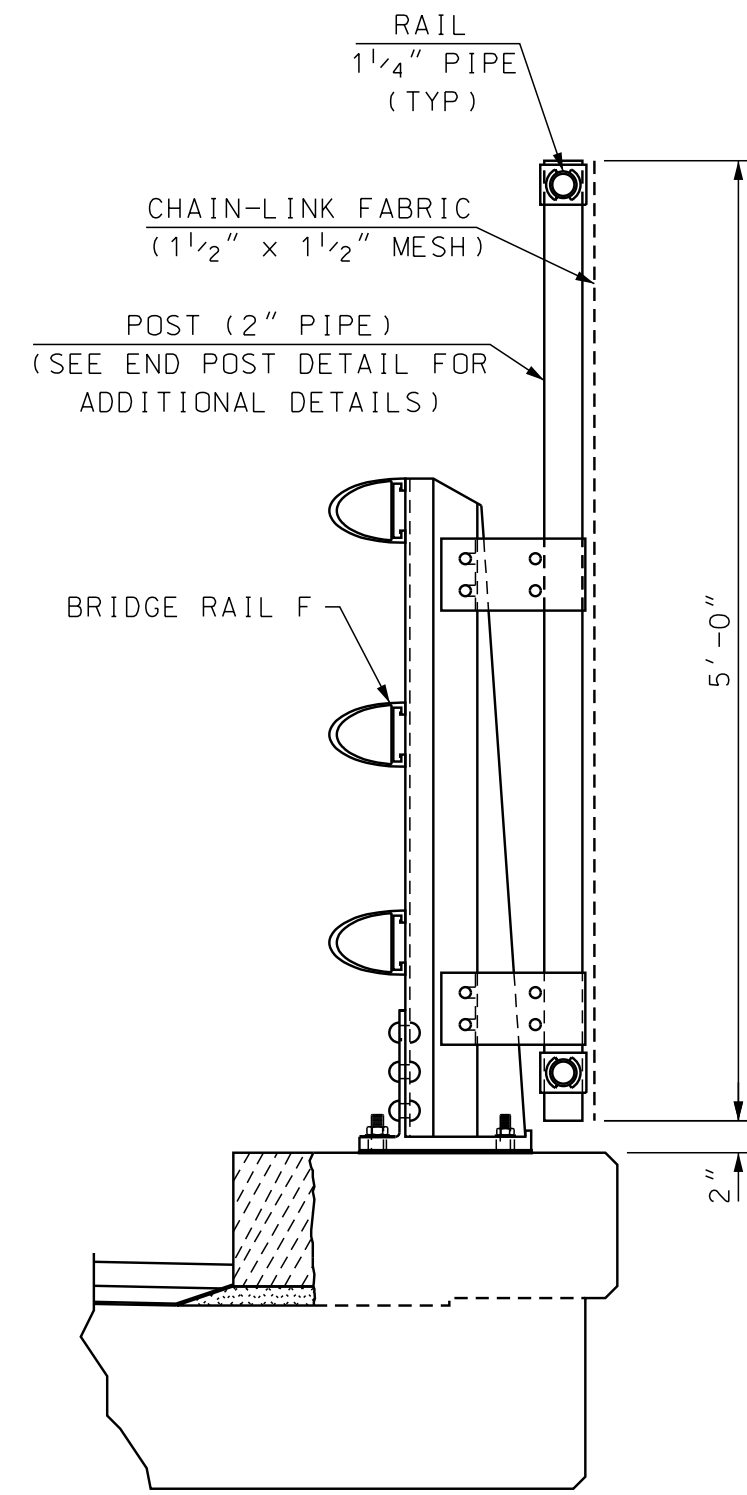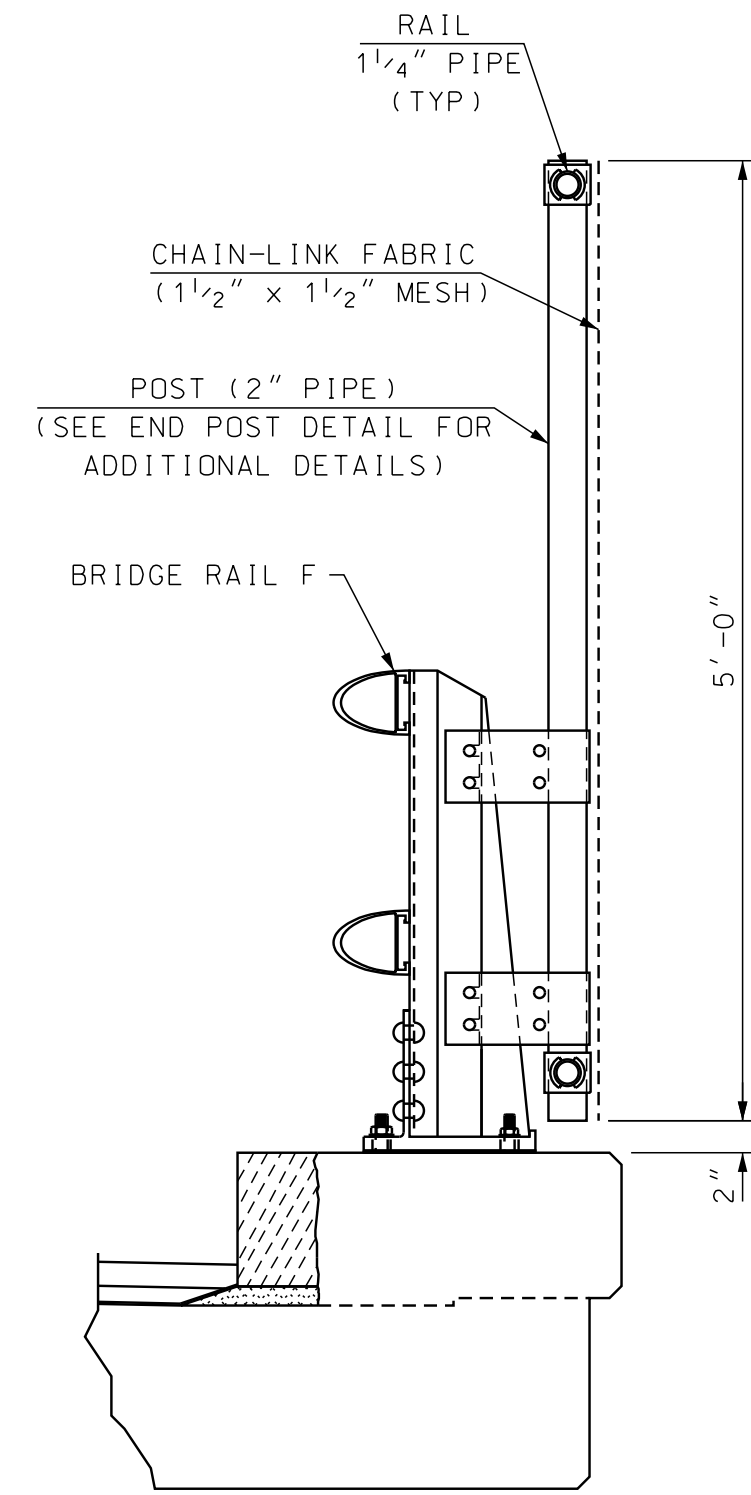


TYPICAL SECTIONS
SCALE: 1" = 1'-0"

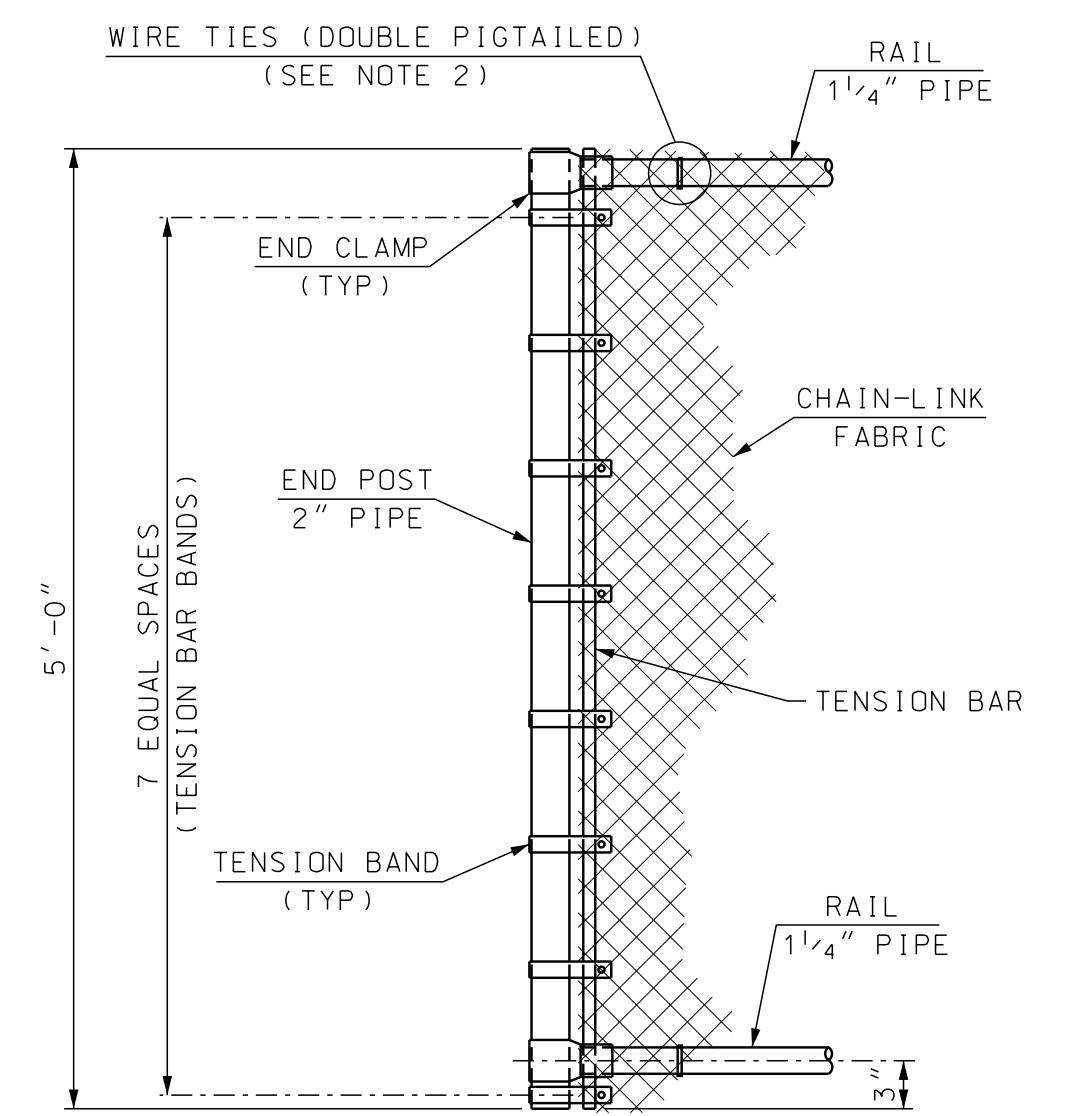

END POST DETAIL
SCALE: 1" = 1'-0"

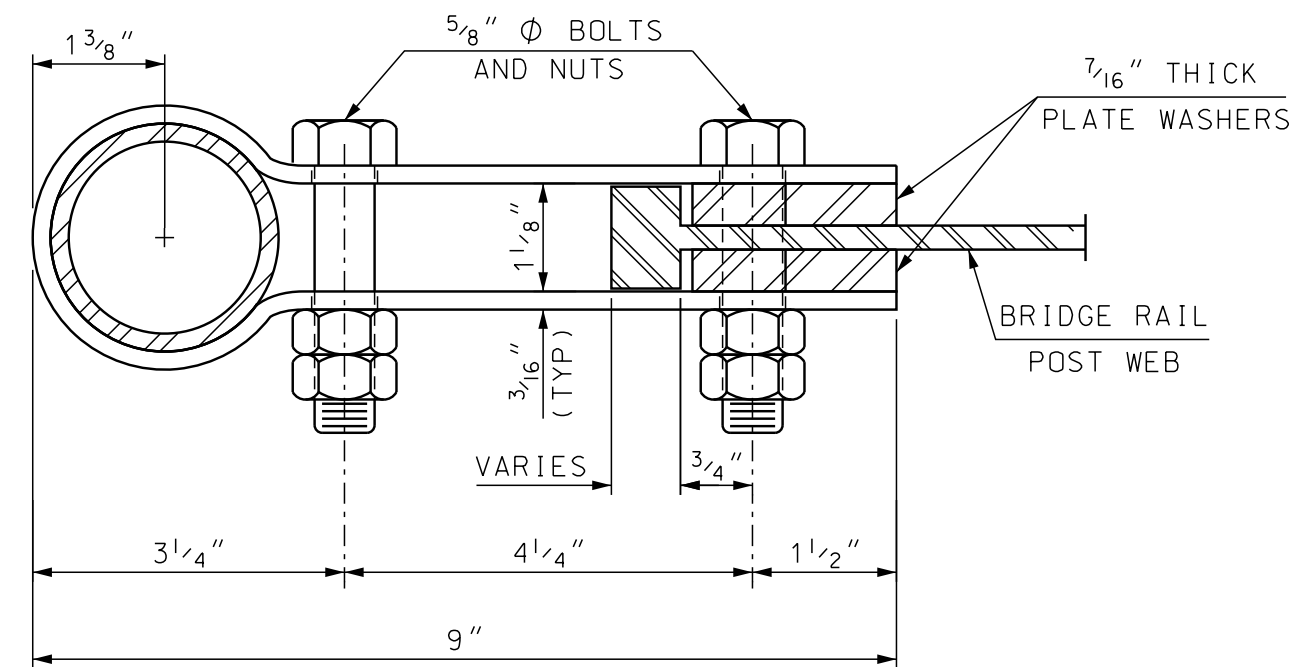

SECTION A-A
SCALE: 6" = 1'-0"

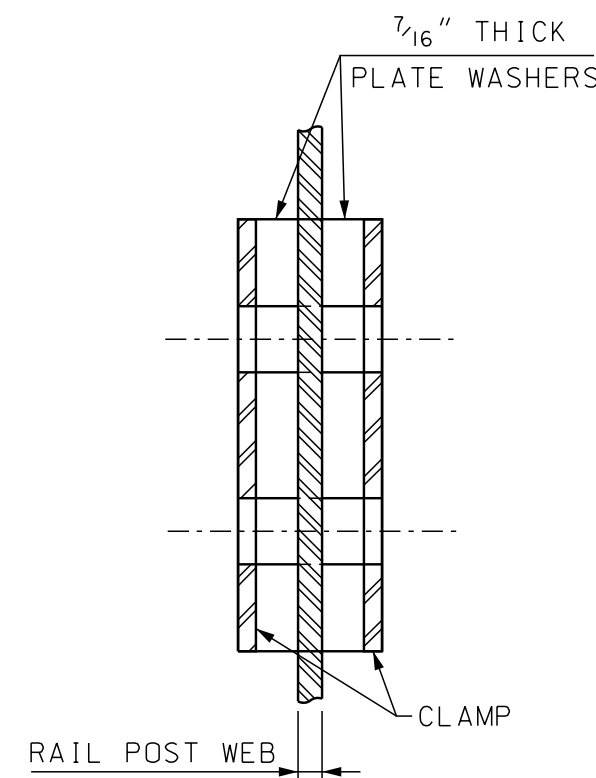

SECTION B-B
SCALE: 6" = 1'-0"



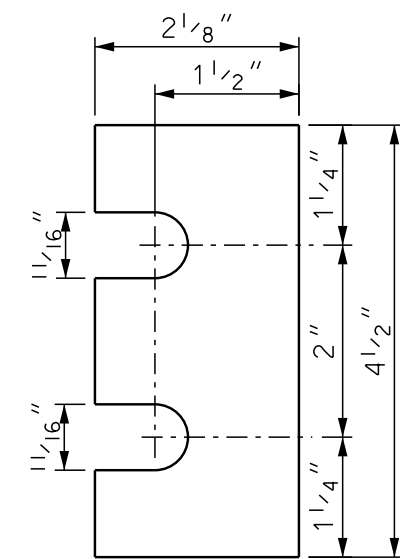



PLATE WASHER DETAIL
SCALE: 6" = 1'-0"

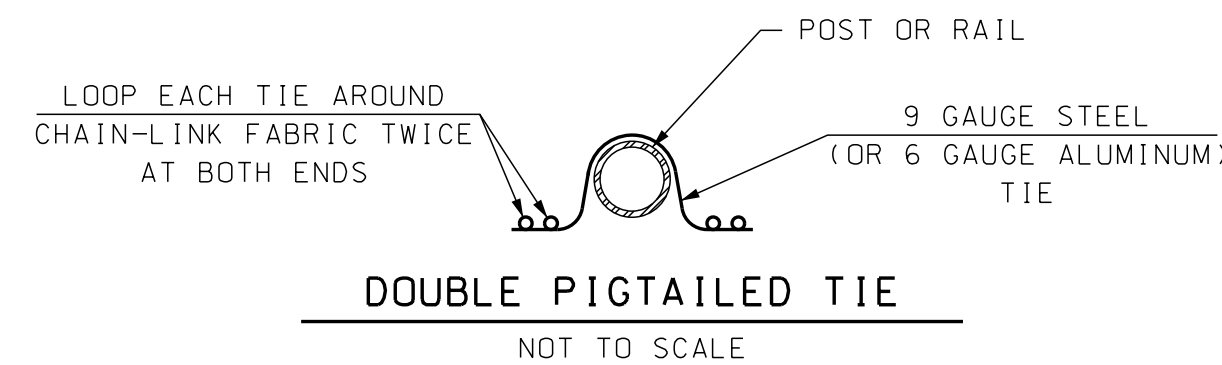


DOUBLE PIGTAILED TIE
NOT TO SCALE

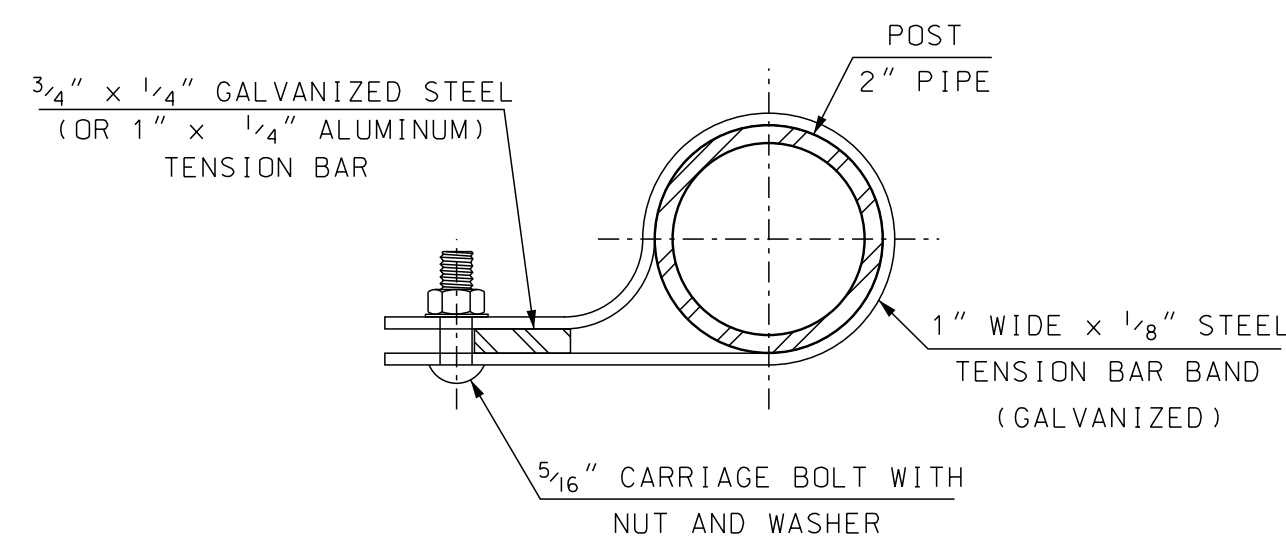


TENSION BAND DETAIL
SCALE: 6" = 1'-0"

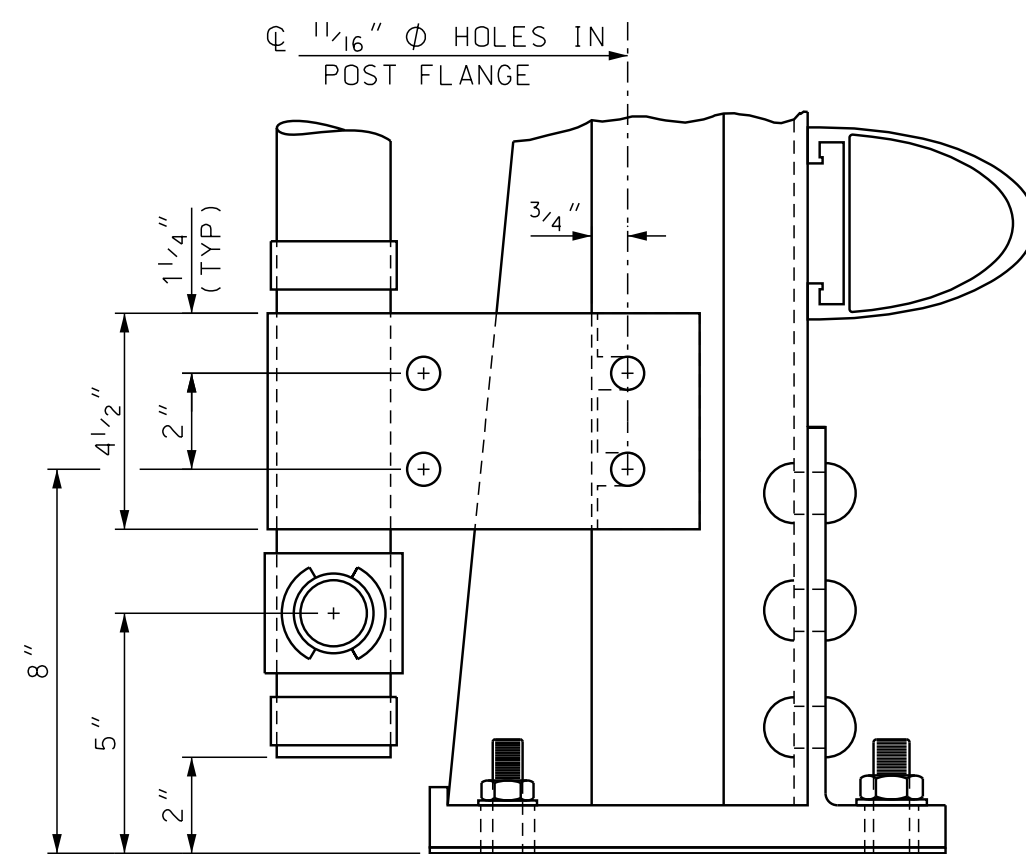

LOWER CLAMP DETAILS
TYPICAL WITH 2-BAR & 3-BAR RAIL
(BASE OF FENCE)
SCALE: 3" = 1'-0"

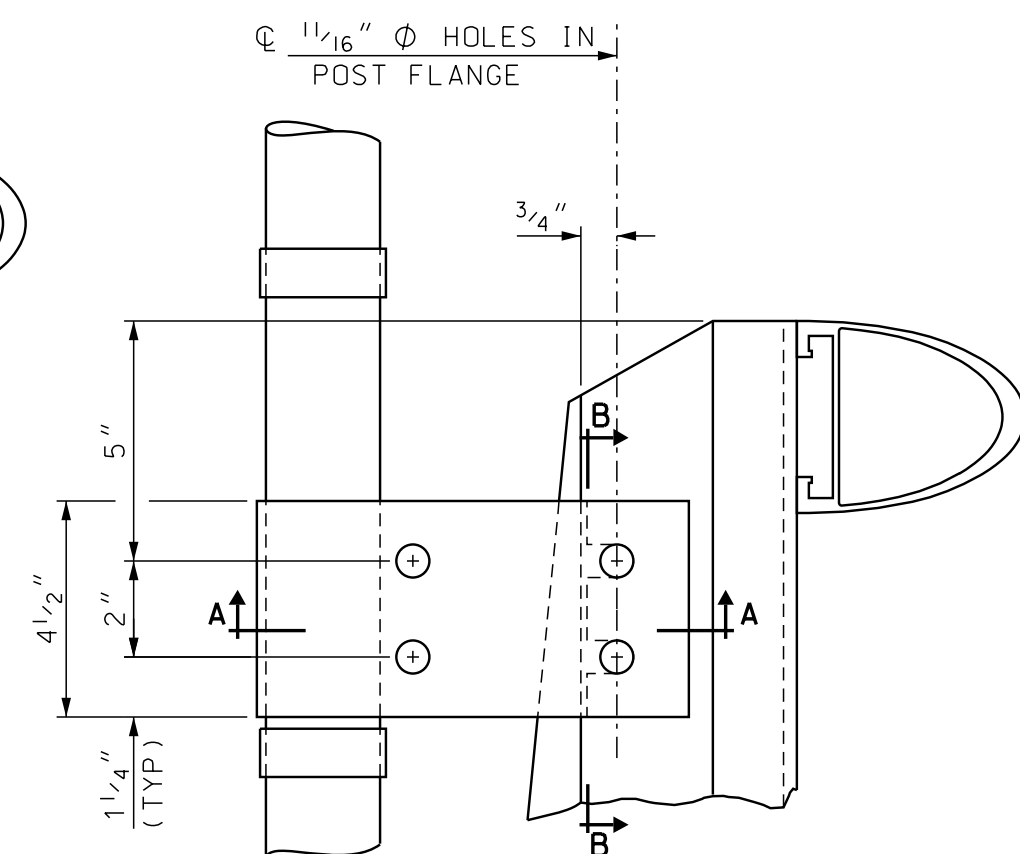

UPPER CLAMP DETAILS
TYPICAL WITH 2-BAR & 3-BAR RAIL
(TOP OF RAIL POST)
SCALE: 3" = 1'-0"

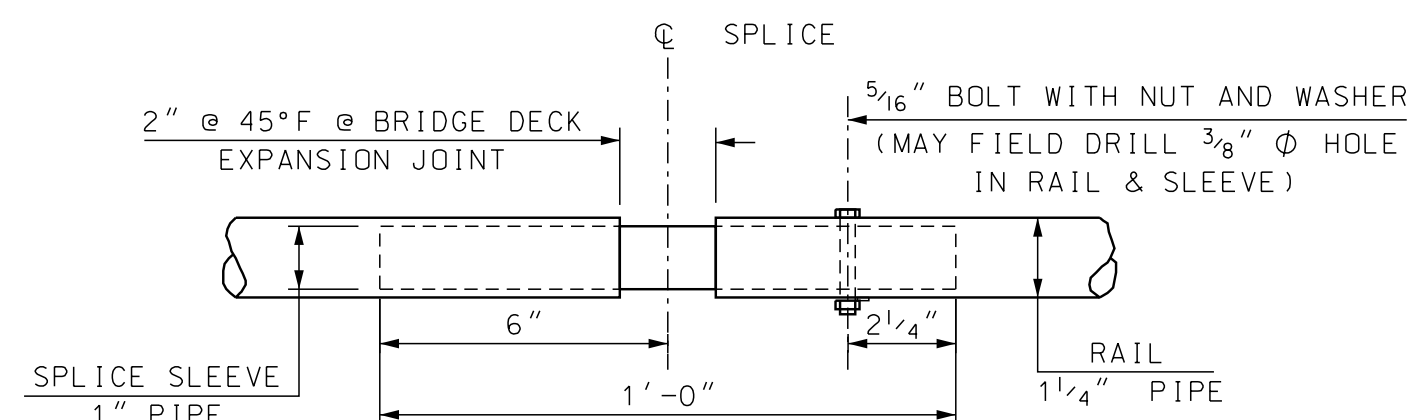

RAIL SPLICE DETAIL
SCALE: 3" = 1'-0"


GENERAL NOTES

- (1) CHAIN-LINK FABRIC SHALL BE 9 GAUGE STEEL, ZINC-COATED CONFORMING TO AASHTO M 181, TYPE I, CLASS D (ASTM A 392), ALUMINUM-COATED CONFORMING TO AASHTO M 181, TYPE II (ASTM A 491) OR 6 GAUGE ALUMINUM ALLOY CONFORMING TO AASHTO M 181, TYPE III (ASTM F 1183). CHAIN-LINK FABRIC SHALL BE KNUCKLED ON TOP AND BOTTOM. THE SIZE OF WIRE MESH (FABRIC) SHALL BE 1 1/2".
- (2) WIRE TIES SHALL BE STANDARD ROUND 9 GAUGE ZINC- OR ALUMINUM-COATED STEEL OR 6 GAUGE ALUMINUM ALLOY CONFORMING TO ASTM F 626. ALL TIES SHALL BE WRAPPED AROUND CHAIN-LINK FABRIC TWICE (DOUBLE PIGTAILED) AT BOTH ENDS. SPACE TIES @ 6" O.C. TO BOTTOM RAIL AND @ 12" O.C. TO ALL POSTS AND OTHER RAILS.
- (3) POST AND RAIL PIPE SHALL BE HOT-DIP GALVANIZED STEEL CONFORMING TO AASHTO M 181, GRADE 1 (ASTM F 1083) OR ALUMINUM ALLOY CONFORMING TO AASHTO M 181 (ASTM B 429, ALLOY 6063-T6). ALL PIPE SHALL BE SCHEDULE 40, STANDARD WEIGHT. NOMINAL PIPE SIZES ARE SHOWN ON THE DRAWING.
- (4) TENSION BARS, BAR BANDS, BOULEVARD AND END CLAMPS SHALL BE STEEL OR ALUMINUM ALLOY CONFORMING TO AASHTO M 181 (ASTM F 626). STEEL COMPONENTS SHALL BE HOT-DIP GALVANIZED IN ACCORDANCE WITH AASHTO M 111 (ASTM A 123) OR AASHTO M 232 (ASTM A 153) AS APPLICABLE.
- (5) ALL BOLTS AND NUTS SHALL BE STEEL CONFORMING TO ASTM A 307 AND ASTM A 563 GRADE A RESPECTIVELY. WASHERS SHALL BE HARDENED STEEL COMMERCIAL TYPE A PLAIN AND SHALL MEET THE DIMENSIONAL REQUIREMENTS OF ANSI B18.22. ALL BOLTS, NUTS AND WASHERS SHALL BE HOT-DIP GALVANIZED IN ACCORDANCE WITH AASHTO M 111 (ASTM A 123) OR AASHTO M 232 (ASTM A 153) AS APPLICABLE.
- (6) RAIL SPLICES SHALL BE PROVIDED AT BRIDGE DECK EXPANSION JOINT(S) AND BRIDGE RAIL SPLICES AS DIRECTED BY THE CONTRACT ADMINISTRATOR.
- (7) RAIL MAY BE FIELD CUT (SAWN) TO FIT POST SPACING. GALVANIZED RAIL, CUT OR DRILLED AS ALLOWED, SHALL BE TOUCHED-UP IN ACCORDANCE WITH 563.3.2.2.3.
- (8) ALL COSTS FOR CHAIN-LINK FABRIC, POSTS, RAILS AND APPURTENANCES SHALL BE INCLUDED IN ITEM 563.973, SNOW SCREENING FOR OVERPASS STRUCTURES RAIL F.

STATE OF NEW HAMPSHIRE									
DEPARTMENT OF TRANSPORTATION * BUREAU OF BRIDGE DESIGN									
TOWN	HOOKSETT	BRIDGE NO.	080/148	STATE PROJECT	28435	BRIDGE SHEET			
LOCATION	MAIN STREET over B&M RR, MERRIMACK RIVER, & RIVERSIDE STREET					FILE NUMBER			
SNOW SCREENING FOR ALUMINUM BRIDGE RAIL									
REVISIONS AFTER PROPOSAL	BY	DATE	BY	DATE	FILE NUMBER				
	DESIGNED		CHECKED	NHDOT	6/06				
	DRAWN	PJP	6/06	CHECKED	MGL	6/06			
	QUANTITIES		CHECKED						
ISSUE DATE	FEDERAL PROJECT NO.			SHEET NO.	TOTAL SHEETS				
REV. DATE	-----			22	42				


SUBDIRECTORY	DGN LOCATOR	SHEET SCALE
XX	AL-RAIL_SNOWSCR	AS NOTED

Terminal Unit Delineation

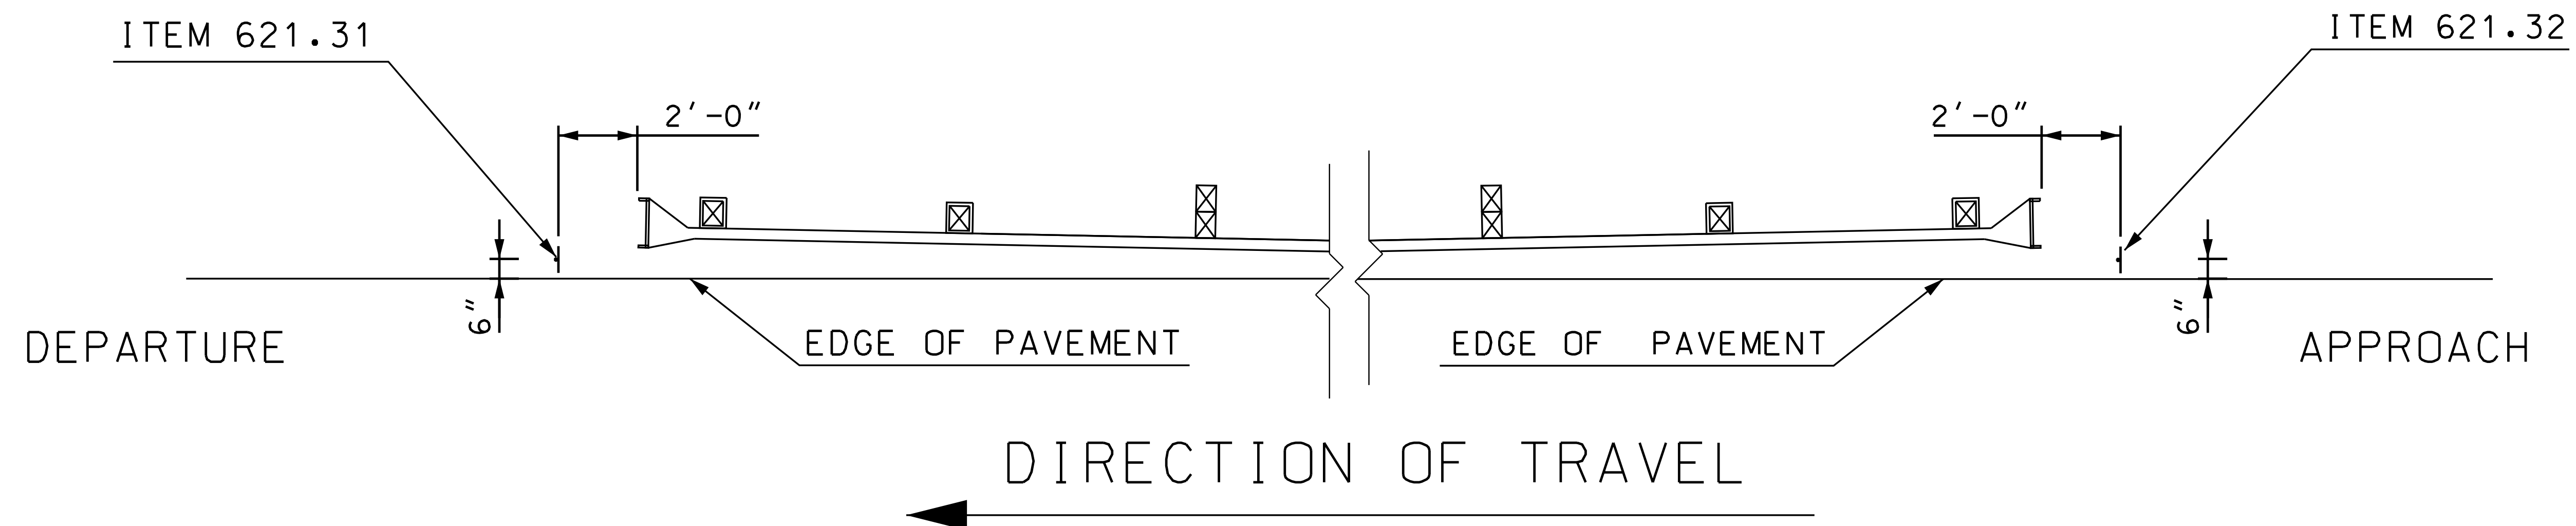

ITEM 621.31
SINGLE DELINEATOR
WITH POST

ITEM 621.32
DOUBLE DELINEATOR
WITH POST

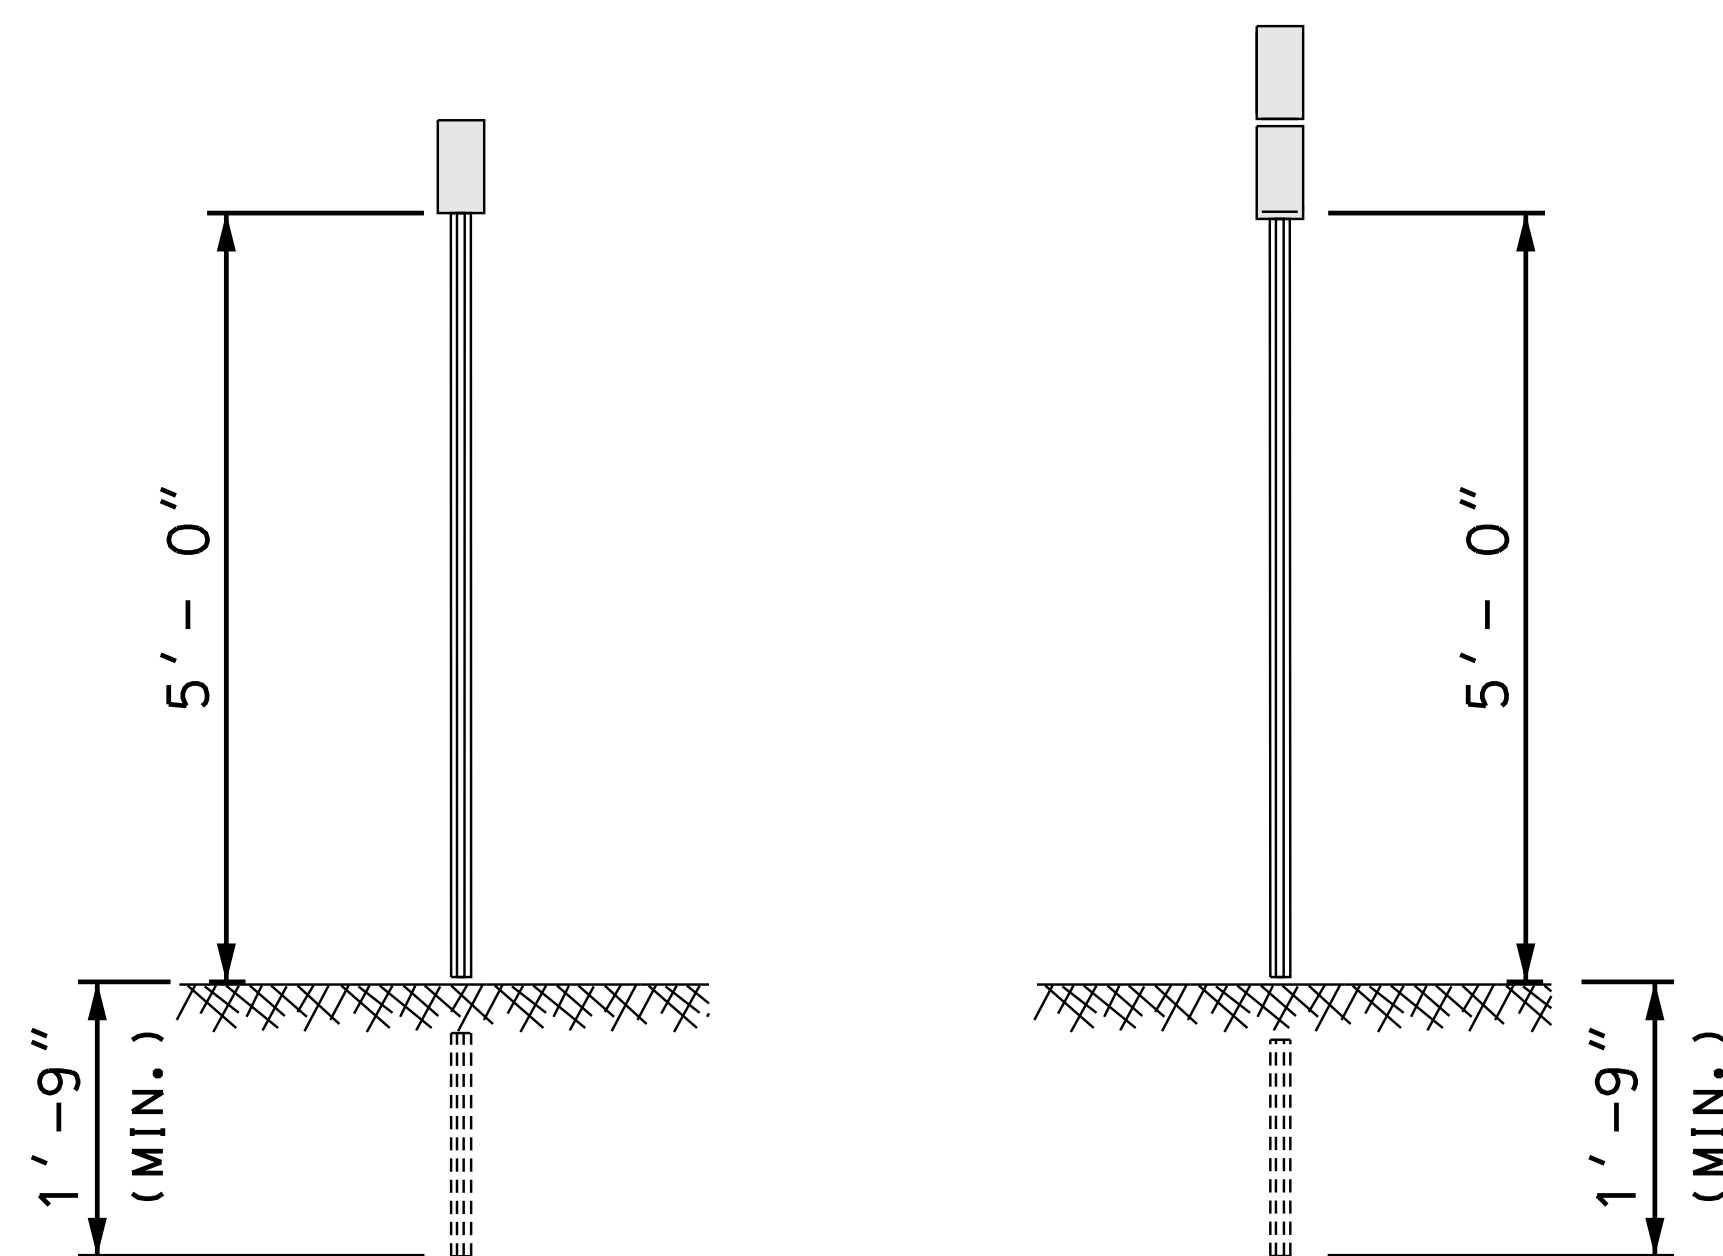

TYPICAL INSTALLATION

ITEM 621.31	SINGLE DELINEATOR WITH POST	WHITE 0	YELLOW 0	RED 0	GREEN 1
ITEM 621.32	DOUBLE DELINEATOR WITH POST	WHITE 0	YELLOW 0	RED 1	GREEN 0

REVISIONS AFTER PROPOSAL		STATION		DATE		DATE	
NUMBER	DESCRIPTION						

STATE OF NEW HAMPSHIRE			
DEPARTMENT OF TRANSPORTATION • BUREAU OF HIGHWAY DESIGN			
<i>Terminal Unit Delineation</i>			
DGN	STATE PROJECT NO.	SHEET NO.	TOTAL SHEETS
termunitdelin	28435	23	42

GENERAL NOTES

1. THE MAXIMUM RUNNING SLOPE OF ANY SIDEWALK CURB RAMP IS 12:1. THE MAXIMUM CROSS SLOPE IS 2%. THE SLOPE OF THE LANDING SHALL NOT EXCEED 2% IN ANY DIRECTION.
 RAMP RUNNING SLOPE EXCEPTION: A GREATER THAN 8.33% RAMP RUNNING GRADE IS ALLOWED WHERE THE ROADWAY AND THE SIDEWALK(S) ARE PARALLEL AND VERY CLOSE TOGETHER, WITH THE SAME GRADE, AND USING A GRADE OF 8.33% WOULD RESULT IN A RAMP LENGTH LONGER THAN 15'. IN THOSE CIRCUMSTANCES USE A MAXIMUM RAMP LENGTH OF 15' AND THE ALLOWABLE RUNNING SLOPE OF THE RAMP(S) IS GREATER THAN 8.33%.
2. TRANSITIONS SHALL BE FLUSH AND FREE OF ABRUPT CHANGES. ROADWAY SHOULDER SLOPES ADJOINING SIDEWALK CURB RAMPS SHALL BE A MAXIMUM OF 5% (FULL WIDTH) FOR A DISTANCE OF 2 FT. FROM THE ROADWAY CURBLINE.
3. INTERCEPT DRAINAGE ALONG THE CURB IN ADVANCE OF SIDEWALK CURB RAMPS OR LANDINGS. CATCH BASINS, MANHOLES, ETC. SHALL NOT BE LOCATED IN, OR AT THE BASE OF, SIDEWALK CURB RAMPS OR LANDINGS.
4. THE BOTTOM OF THE SIDEWALK CURB RAMP OR LANDING, EXCLUSIVE OF THE FLARED SIDES, SHALL BE WHOLLY CONTAINED WITHIN THE CROSSWALK MARKINGS.
5. THE SURFACE OF A PERPENDICULAR SIDEWALK CURB RAMP OR THE LANDING OF A PARALLEL SIDEWALK CURB RAMP SHALL CONTRAST VISUALLY WITH THE ADJOINING SIDEWALK SURFACE. EITHER ASPHALT/LIGHT-COLORED CONCRETE OR LIGHT-COLORED CONCRETE/DARK-STAINED CONCRETE. THE CONCRETE SURFACE SHALL BE SLIP RESISTANT.
6. DETECTABLE WARNING PANELS SHALL BE THE FULL WIDTH OF THE LANDING, BLENDED TRANSITION, OR CURB RAMP THEY ARE A PART OF AND SHALL BE A MINIMUM OF 2 FEET IN DEPTH. THE ROWS OF TRUNCATED DOMES SHALL BE ALIGNED PERPENDICULAR TO THE GRADE BREAK BETWEEN THE RAMP, BLENDED TRANSITION, OR LANDING AND THE STREET.

TRANSITION RAMPS:

BLENDED TRANSITIONS HAVE A RUNNING SLOPE GREATER THAN 2% BUT LESS THAN 5%. CURB RAMPS HAVE A RUNNING SLOPE OF 5% MIN. TO 8.33% MAX. SIDEWALK, BLENDED TRANSITIONS, AND CURB RAMPS HAVE A MAX. CROSS SLOPE OF 2%.

ALL GRADE BREAKS BETWEEN LANDINGS, RAMPS, AND BLENDED TRANSITIONS SHALL BE PERPENDICULAR TO THE DIRECTION OF TRAVEL.

IF IT IS NECESSARY TO USE SIDEWALK WIDTHS 5'-0" OR LESS, PROVIDE A WIDENED AREA A MINIMUM OF 5'-0" WIDE BY 5'-0" LONG SPACED AT INTERVALS OF 200' MAXIMUM TO ALLOW FOR USERS TO PASS EACH OTHER.


PROVIDE DETECTABLE WARNING SURFACES ANYTIME THAT A CURB RAMP, BLENDED TRANSITION, OR LANDING CONNECTS TO A STREET. PLACEMENT FOR DETECTABLE WARNING SURFACES ARE AS FOLLOWS:

PARALLEL CURB RAMPS:


LOCATE THE DETECTABLE WARNING SURFACES AT THE BACK OF THE CURB ALONG THE EDGE OF THE LANDING.

FOR BLENDED TRANSITIONS AND LANDINGS:


LOCATE THE DETECTABLE WARNING SURFACES AT THE BACK OF THE CURB.

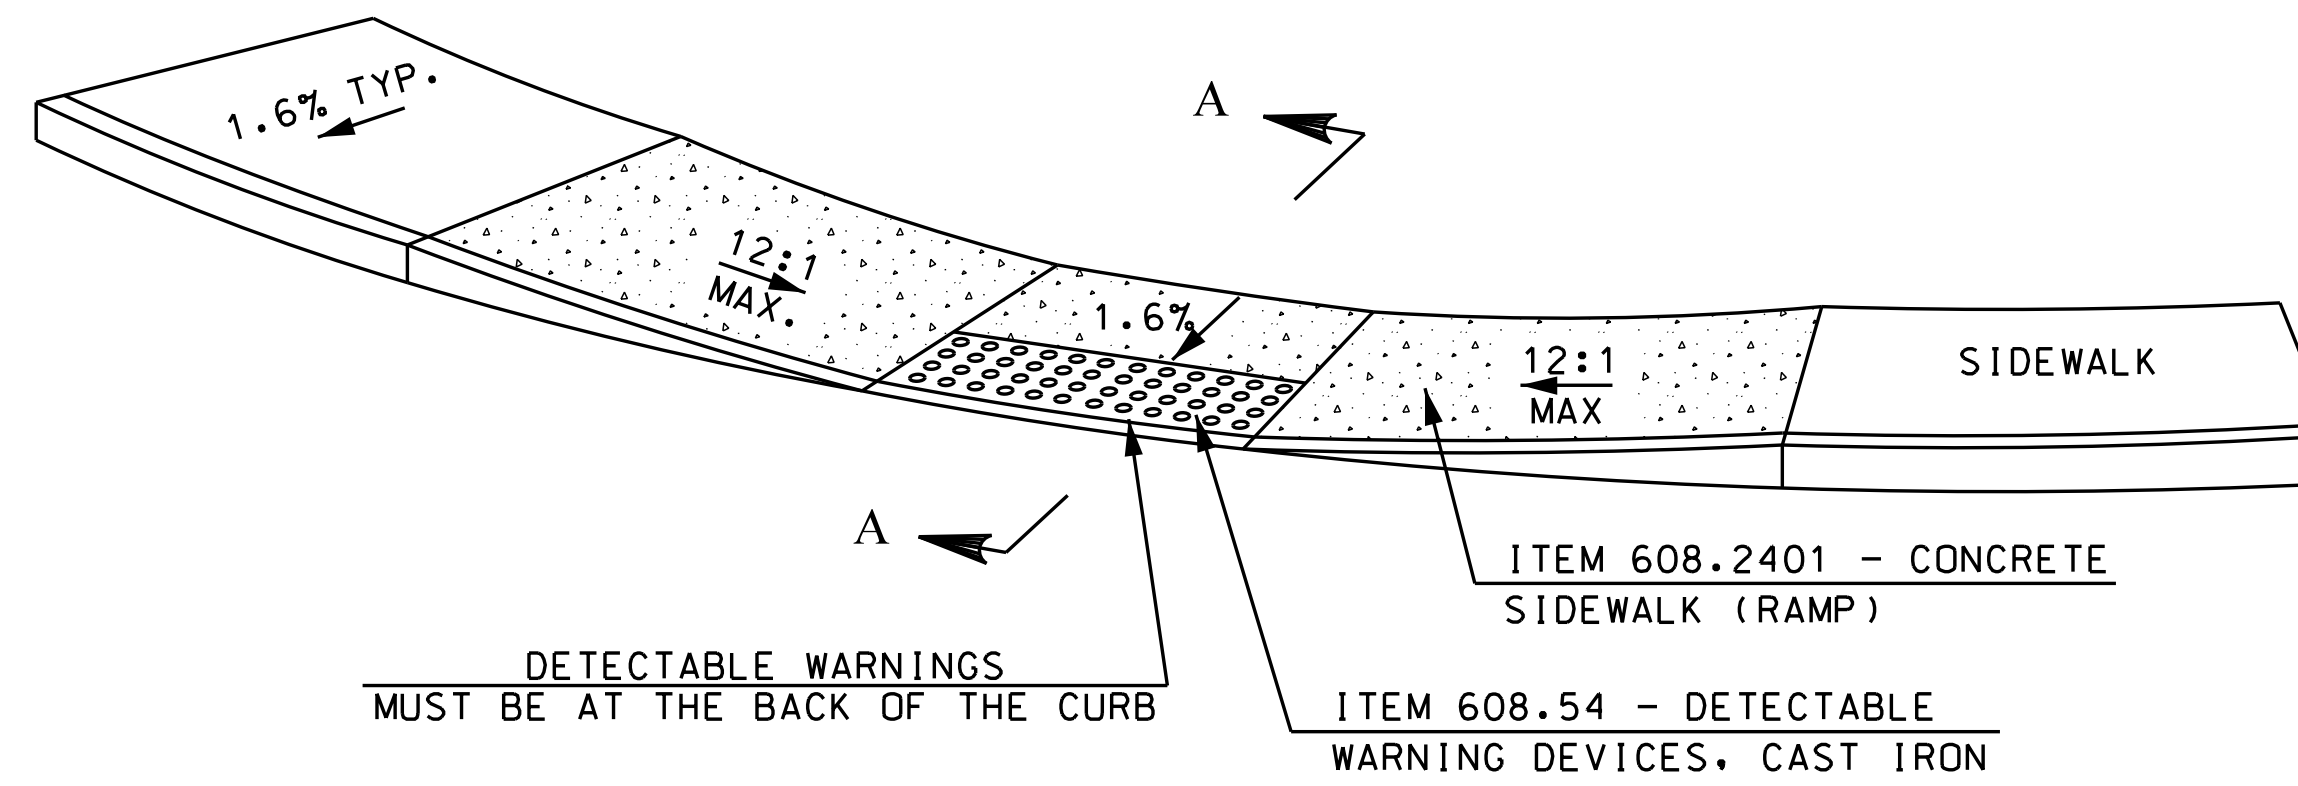

PARALLEL CURB RAMP DETAIL

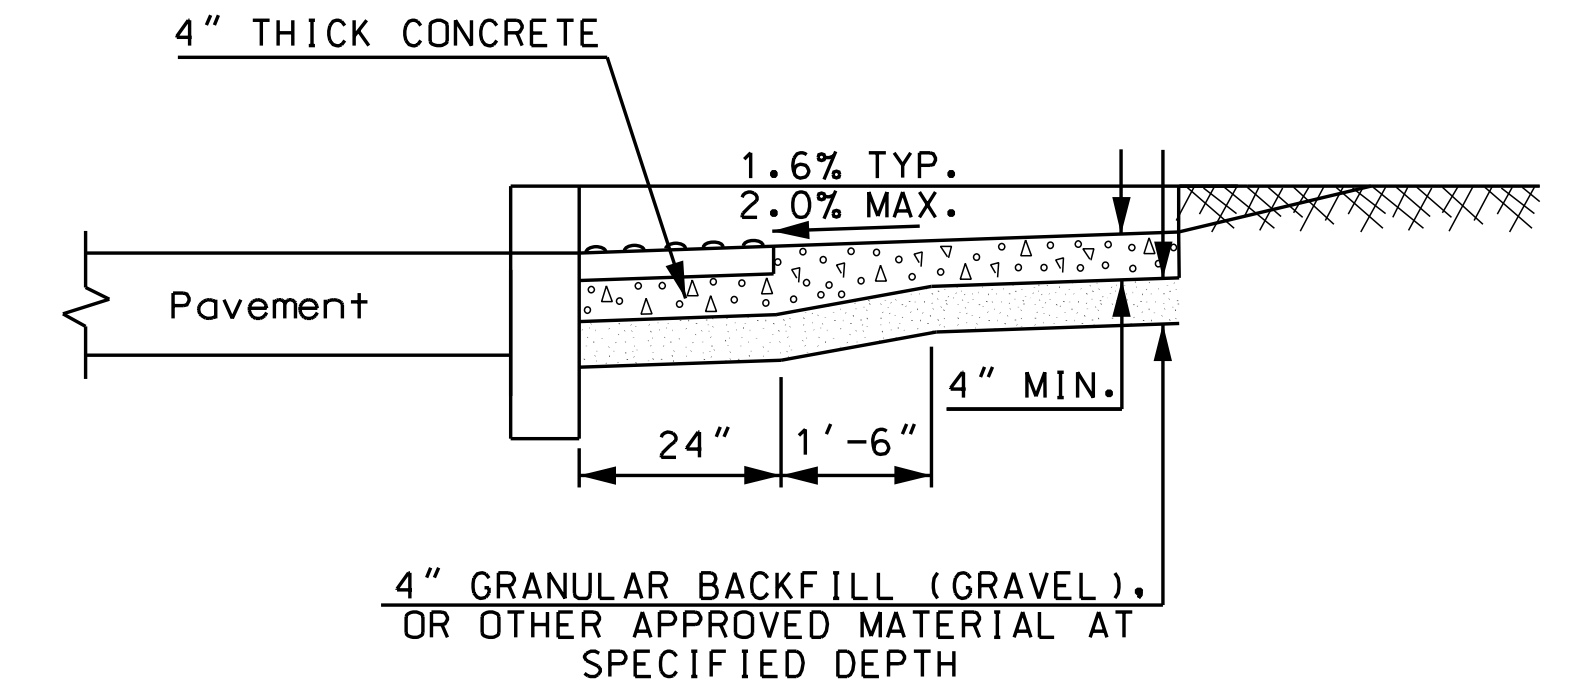


SECTION A-A

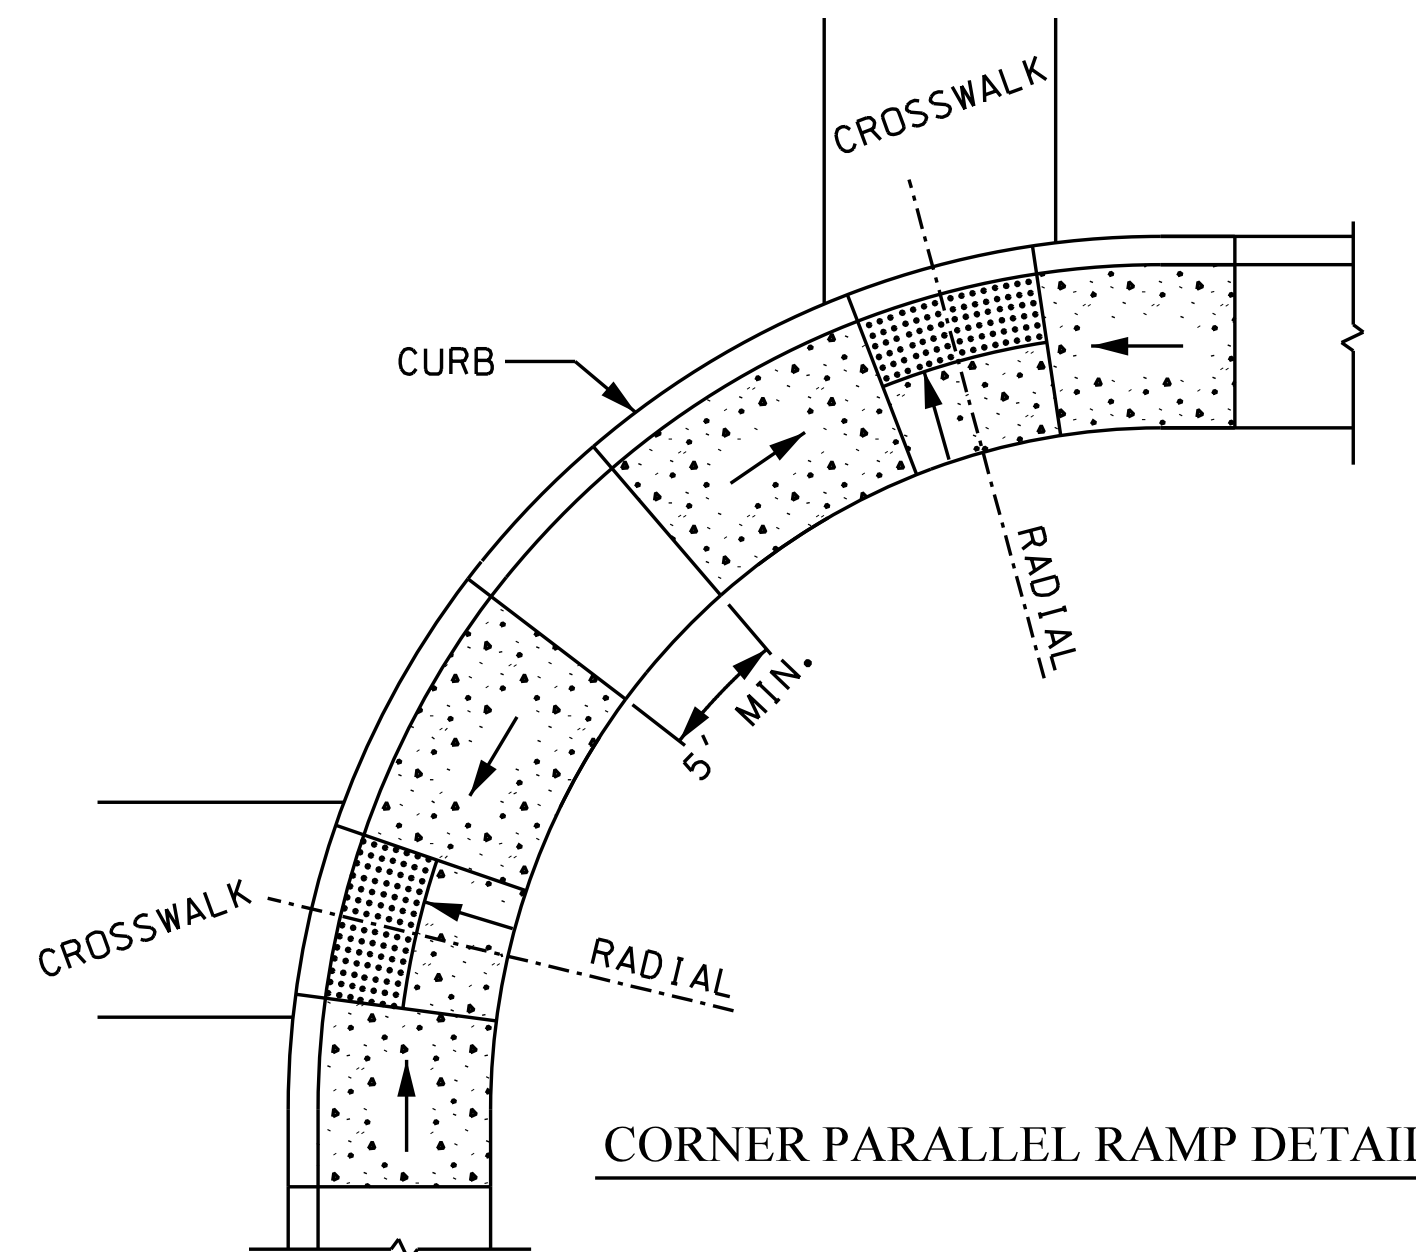


CORNER PARALLEL RAMP DETAIL

THE ORDER OF PREFERENCE FOR LOCATION OF CORNER RAMPS:

1. TWO SEPARATE RAMPS LOCATED ON TANGENT SIDEWALK AREA IMMEDIATELY OUTSIDE OF CORNER RADIUS.
2. TWO SEPARATE RAMPS SEPARATED BY 5' MINIMUM AS SHOWN ABOVE.
3. SINGLE RAMP SERVING TWO CROSSWALKS.

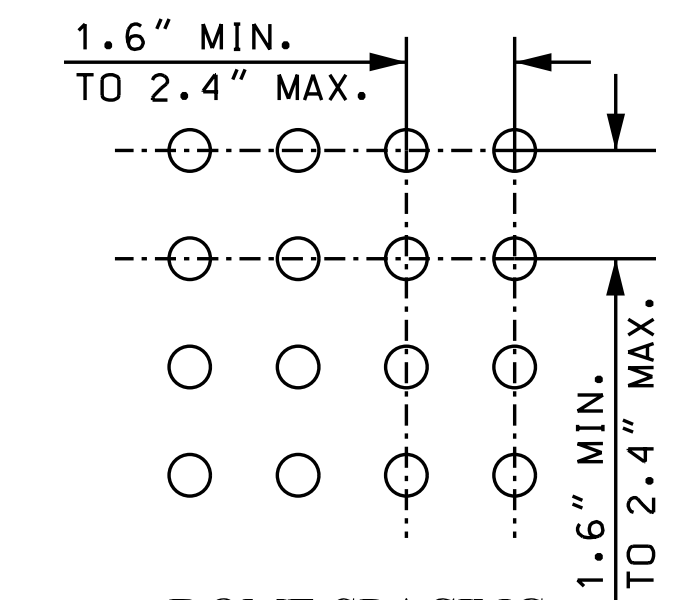


DOMES SPACING

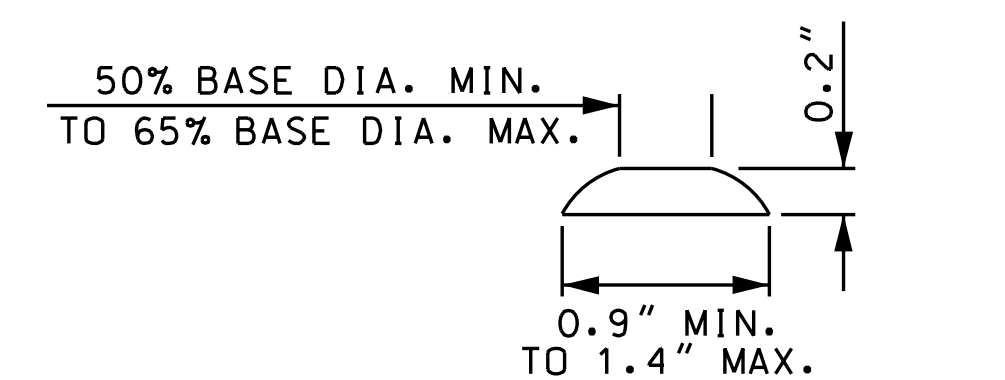


DOMES SECTION

STATE OF NEW HAMPSHIRE			
DEPARTMENT OF TRANSPORTATION • BUREAU OF HIGHWAY DESIGN			
SIDEWALK CURB RAMPS WITH DETECTABLE WARNINGS			
DGN	STATE PROJECT NO.	SHEET NO.	TOTAL SHEETS
crbrmp	28435	24	42

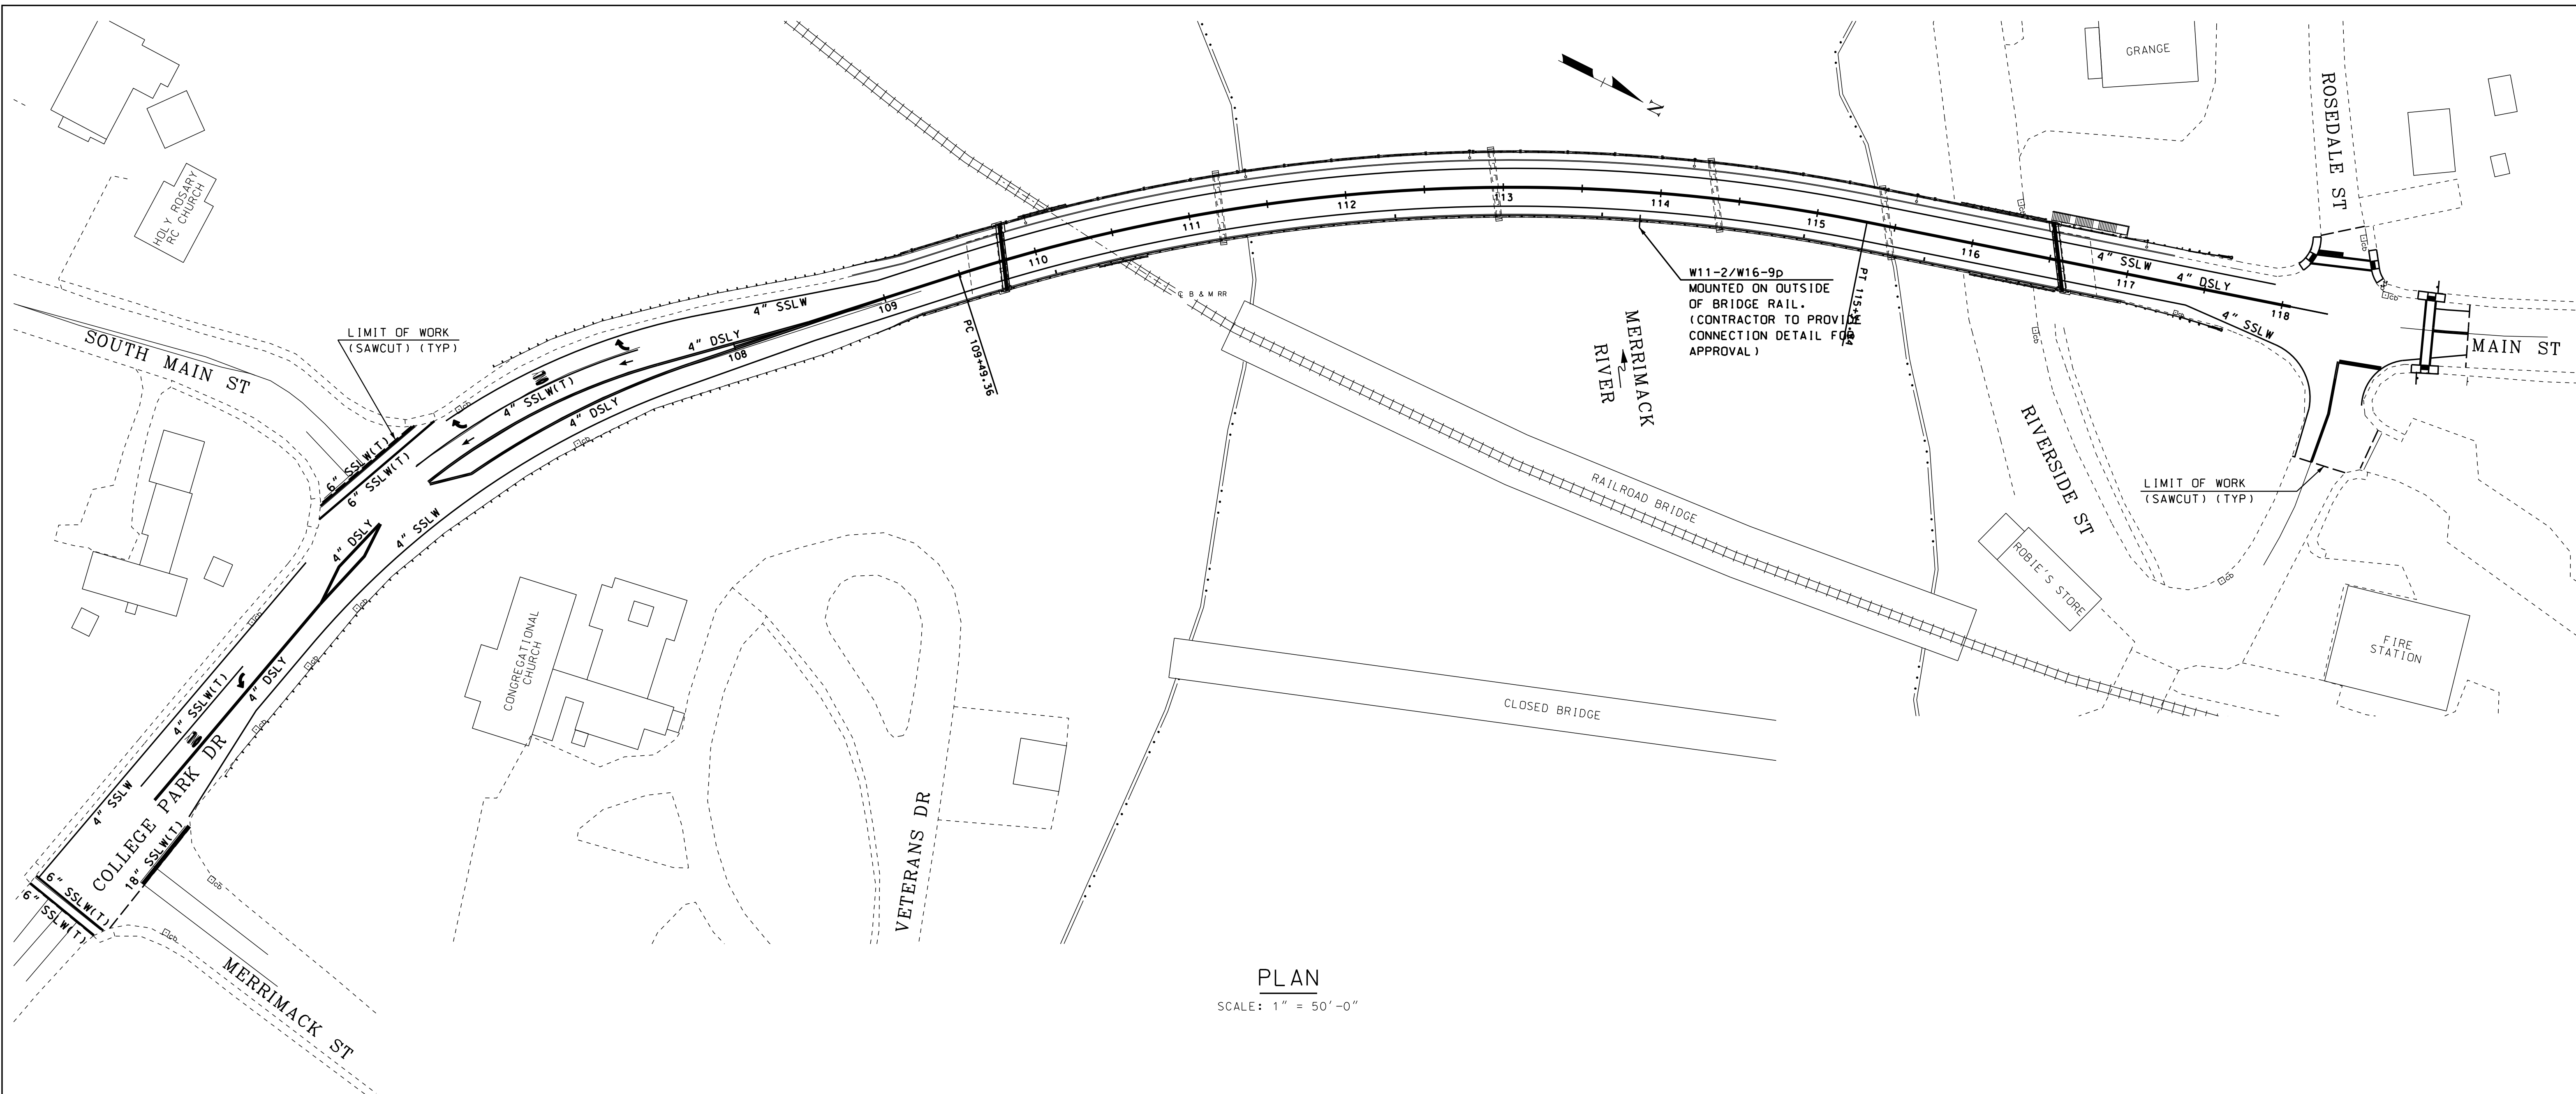

PLAN

SCALE: 1" = 50'-0"


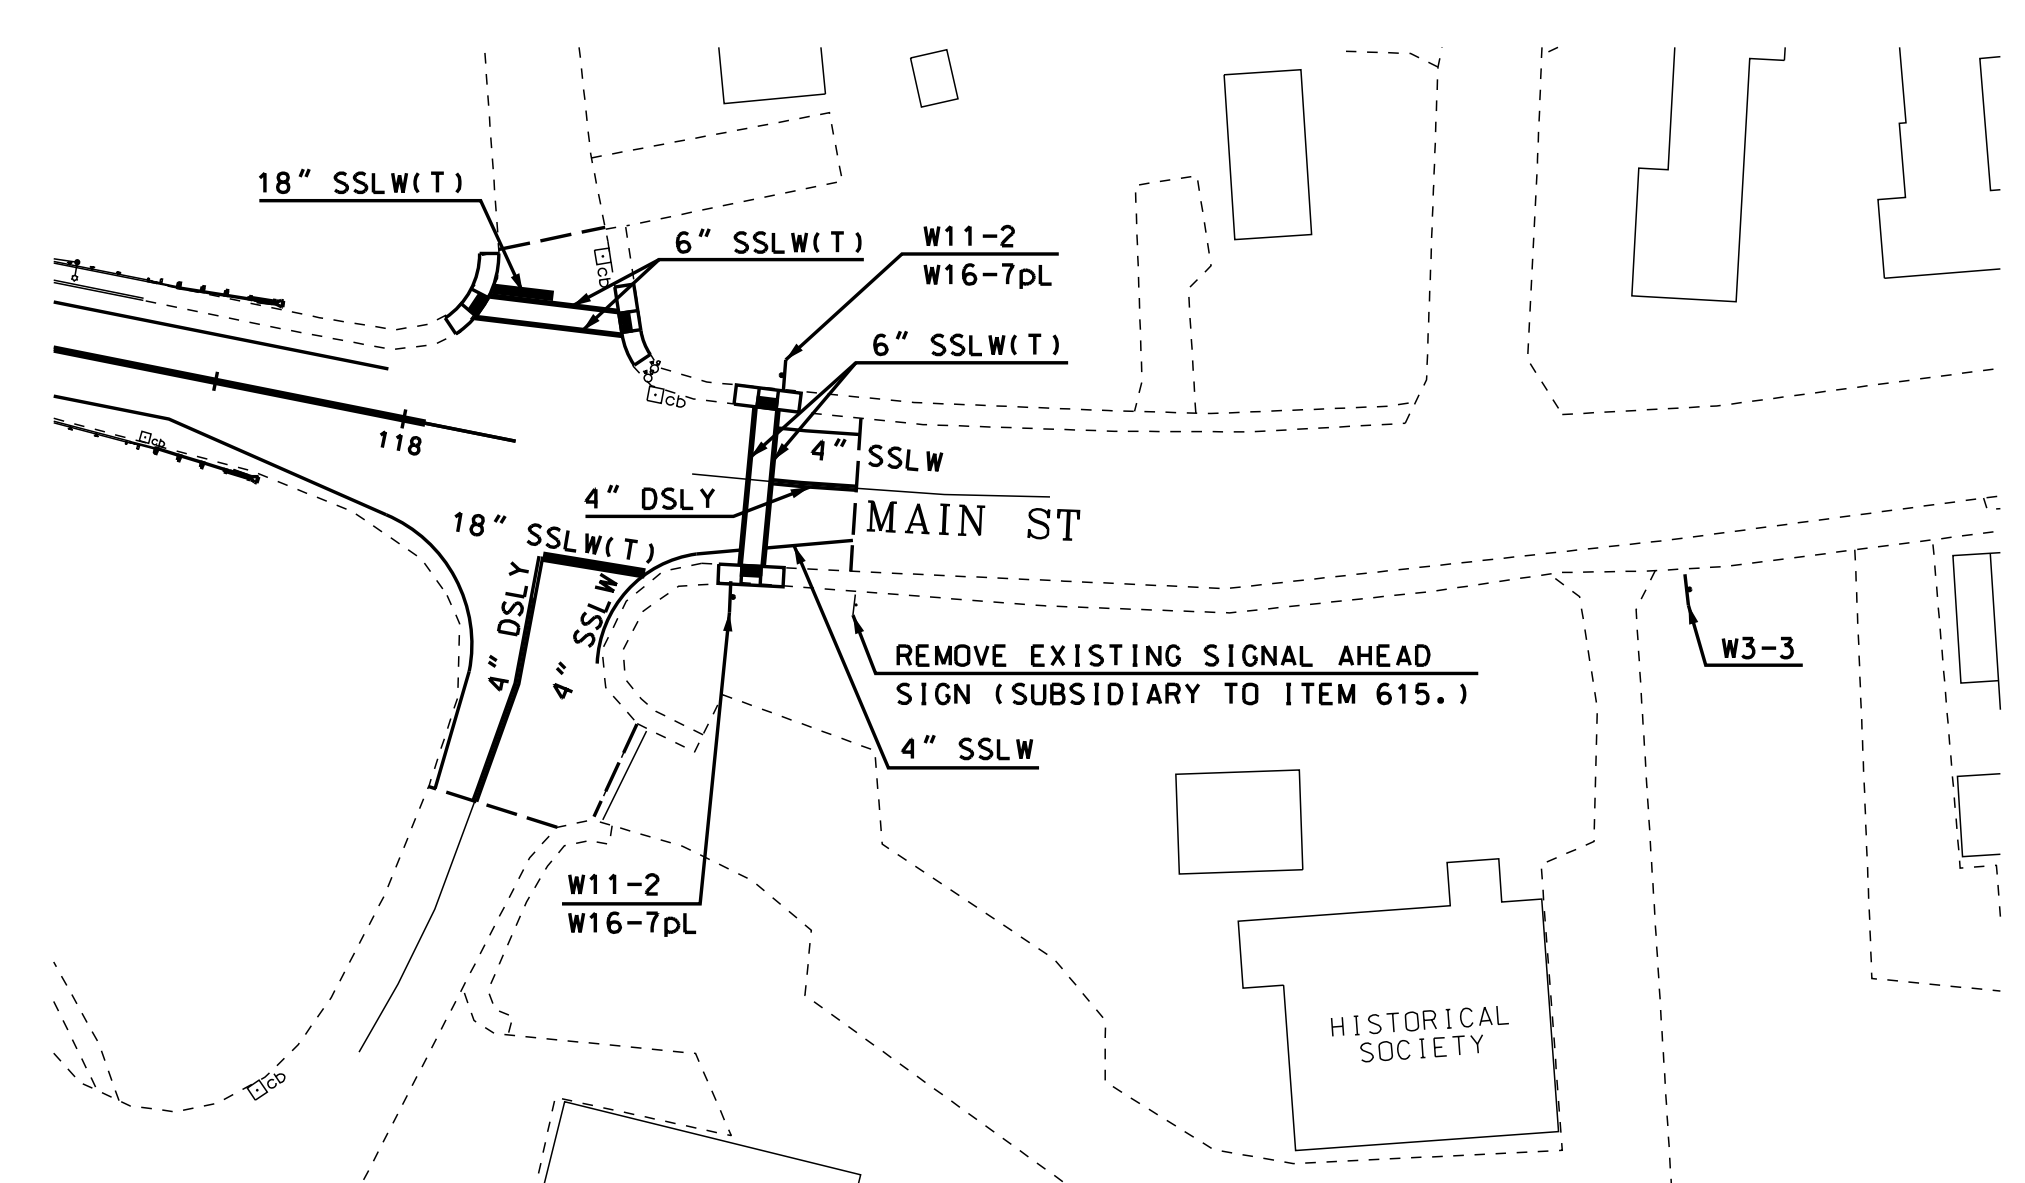


PLAN

SCALE: 1" = 50'-0"


STATE OF NEW HAMPSHIRE									
DEPARTMENT OF TRANSPORTATION * BUREAU OF BRIDGE DESIGN									
TOWN	HOOKSETT	BRIDGE NO.	080/148	STATE PROJECT	28435				
LOCATION MAIN STREET over B&M RR, MERRIMACK RIVER, & RIVERSIDE STREET									
PAVEMENT MARKING & PERMANENT SIGNING								BRIDGE SHEET	
REVISIONS AFTER PROPOSAL								--- OF ---	
	DESIGNED	JAT	8/14	CHECKED	SMG	8/14			
	DRAWN	SMG	8/14	CHECKED	JAT	8/14	FILE NUMBER		
	QUANTITIES	SMG	9/14	CHECKED	JAT	9/14	126-1-1		
	ISSUE DATE	FEDERAL PROJECT NO.				SHEET NO.	TOTAL SHEETS		
	REV. DATE	-----				25	42		

SUBDIRECTORY	DGN LOCATOR	SHEET SCALE
BRC\	28435 Pavemark	AS NOTED

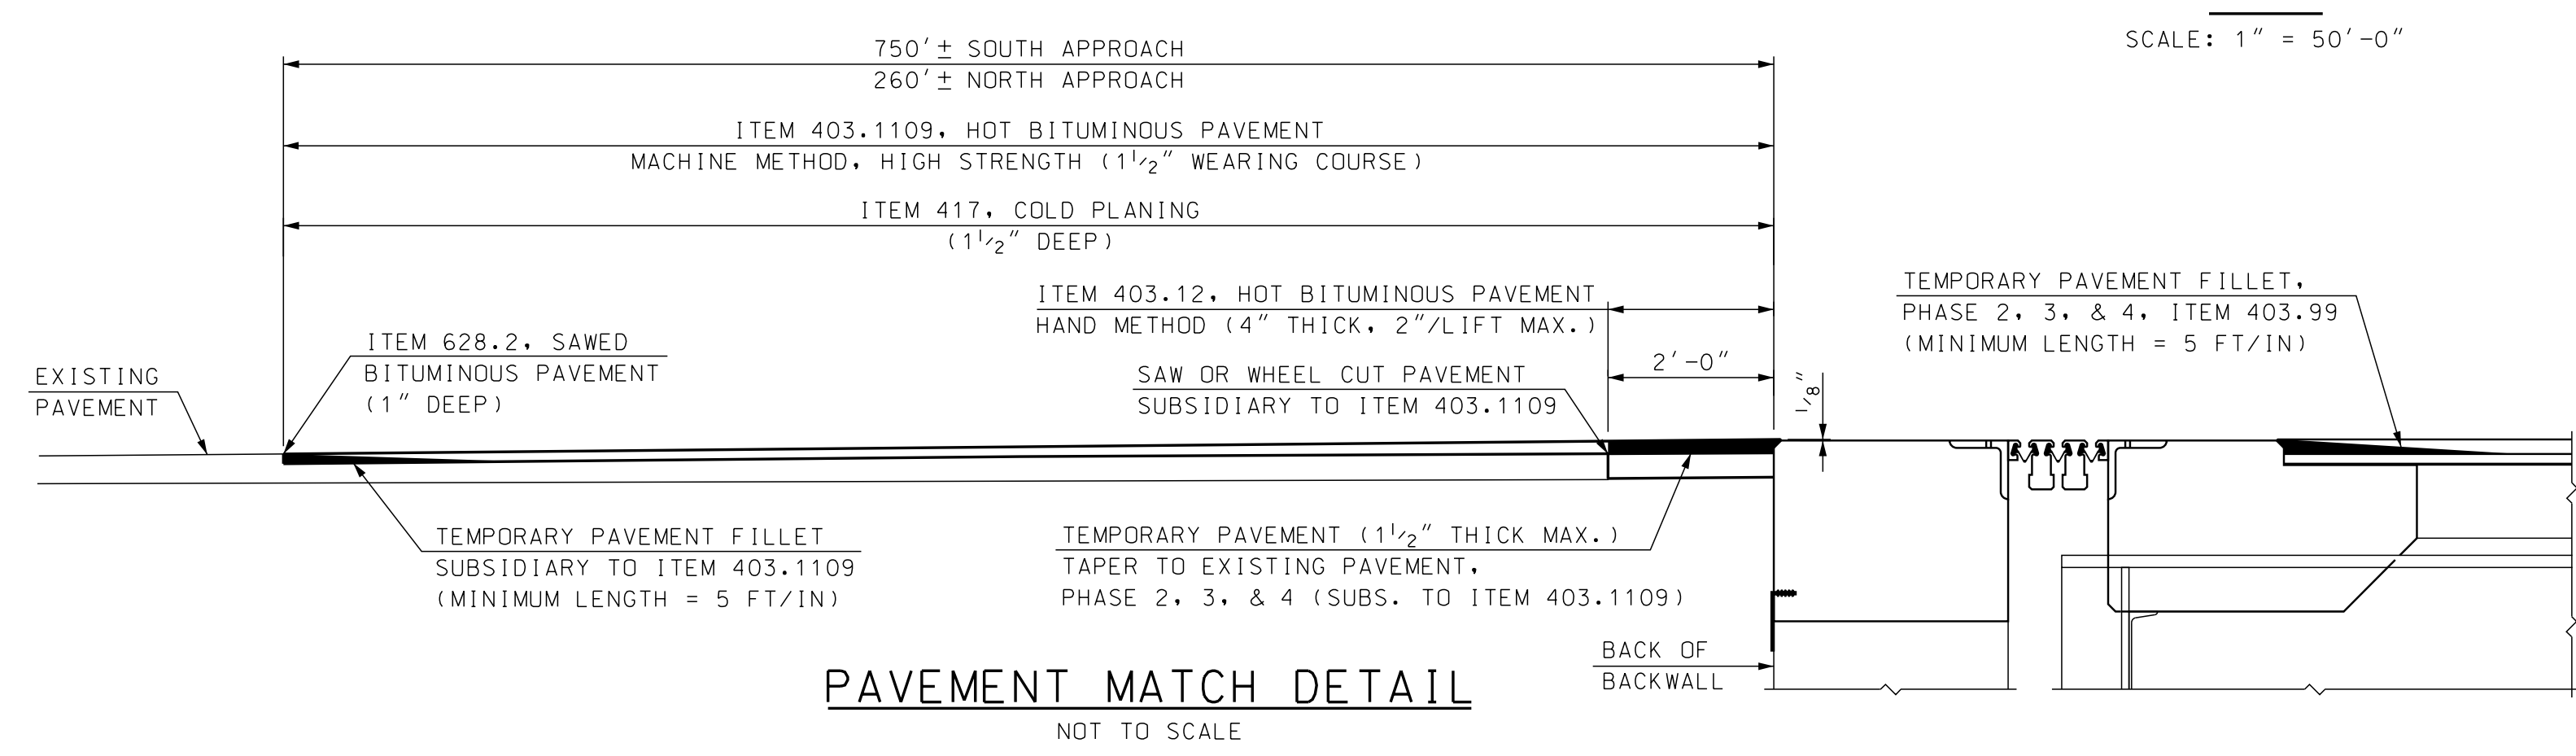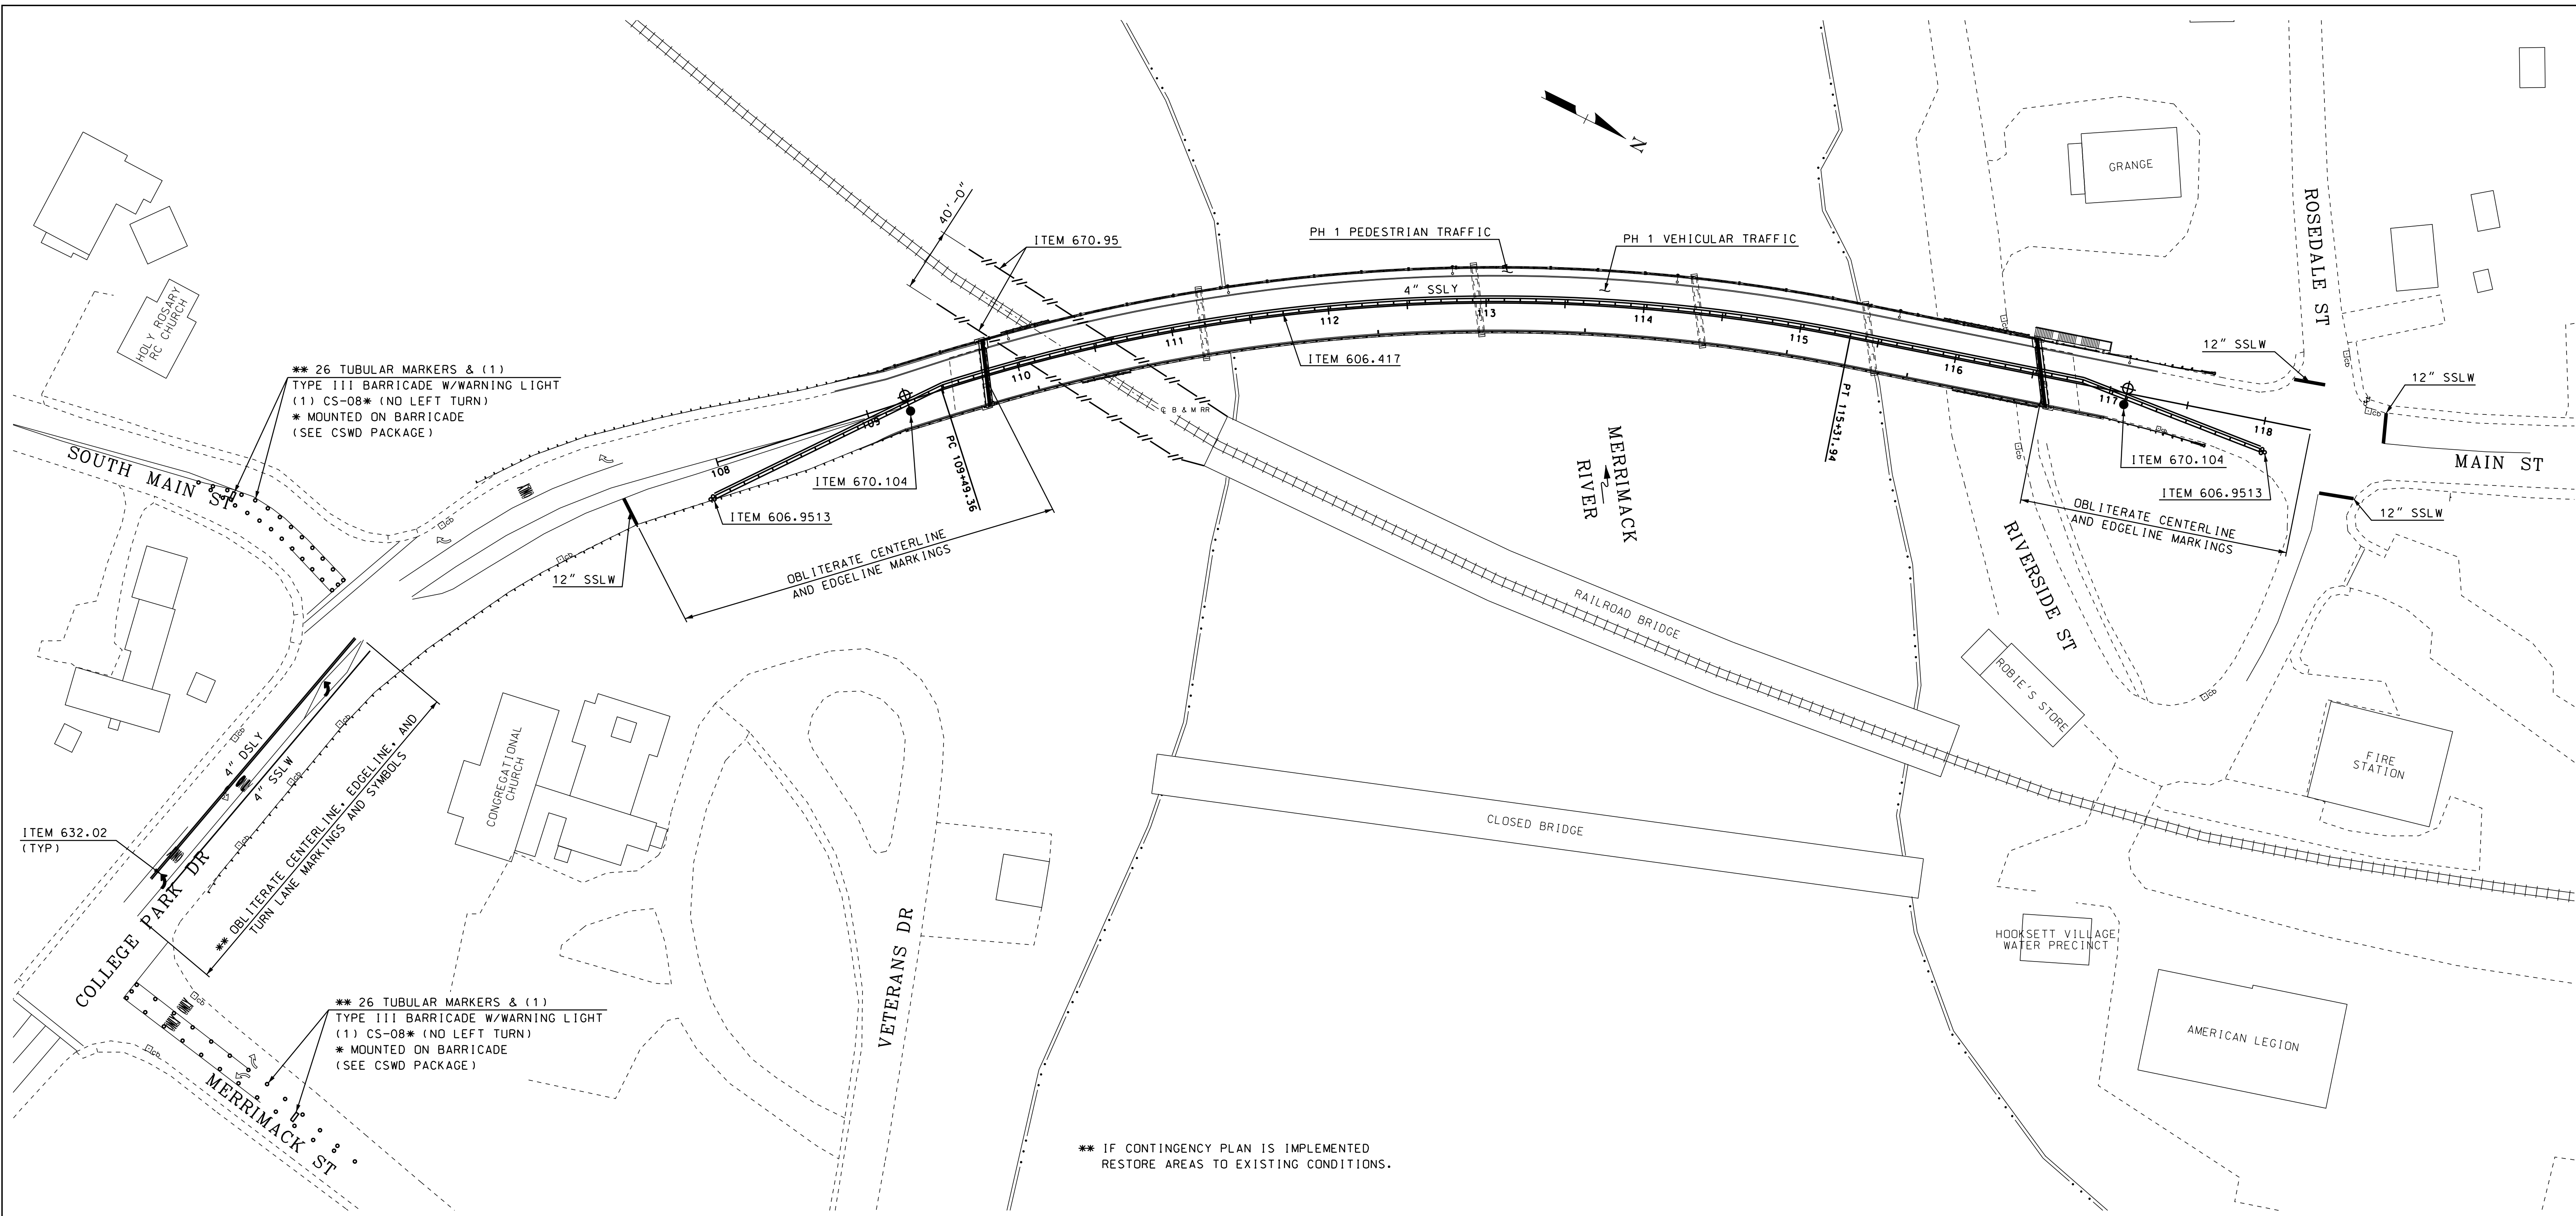

STATE OF NEW HAMPSHIRE					
DEPARTMENT OF TRANSPORTATION * BUREAU OF BRIDGE DESIGN					
TOWN	HOOKSETT	BRIDGE NO.	080/148	STATE PROJECT	28435
LOCATION MAIN STREET over B&M RR, MERRIMACK RIVER, & RIVERSIDE STREET					
TRAFFIC CONTROL PHASE 1					BRIDGE SHEET
REVISIONS AFTER PROPOSAL					--- OF ---
DESIGNED	JAT	DATE	6/14	CHECKED	SMG 8/14
DRAWN	SMG	DATE	6/14	CHECKED	JAT 8/14
QUANTITIES	SMG	DATE	9/14	CHECKED	JAT 9/14
ISSUE DATE		FEDERAL PROJECT NO.		SHEET NO.	26
REV. DATE					42



SUBDIRECTORY	DGN LOCATOR	SHEET SCALE
BRC\	28435 Traf Control	AS NOTED

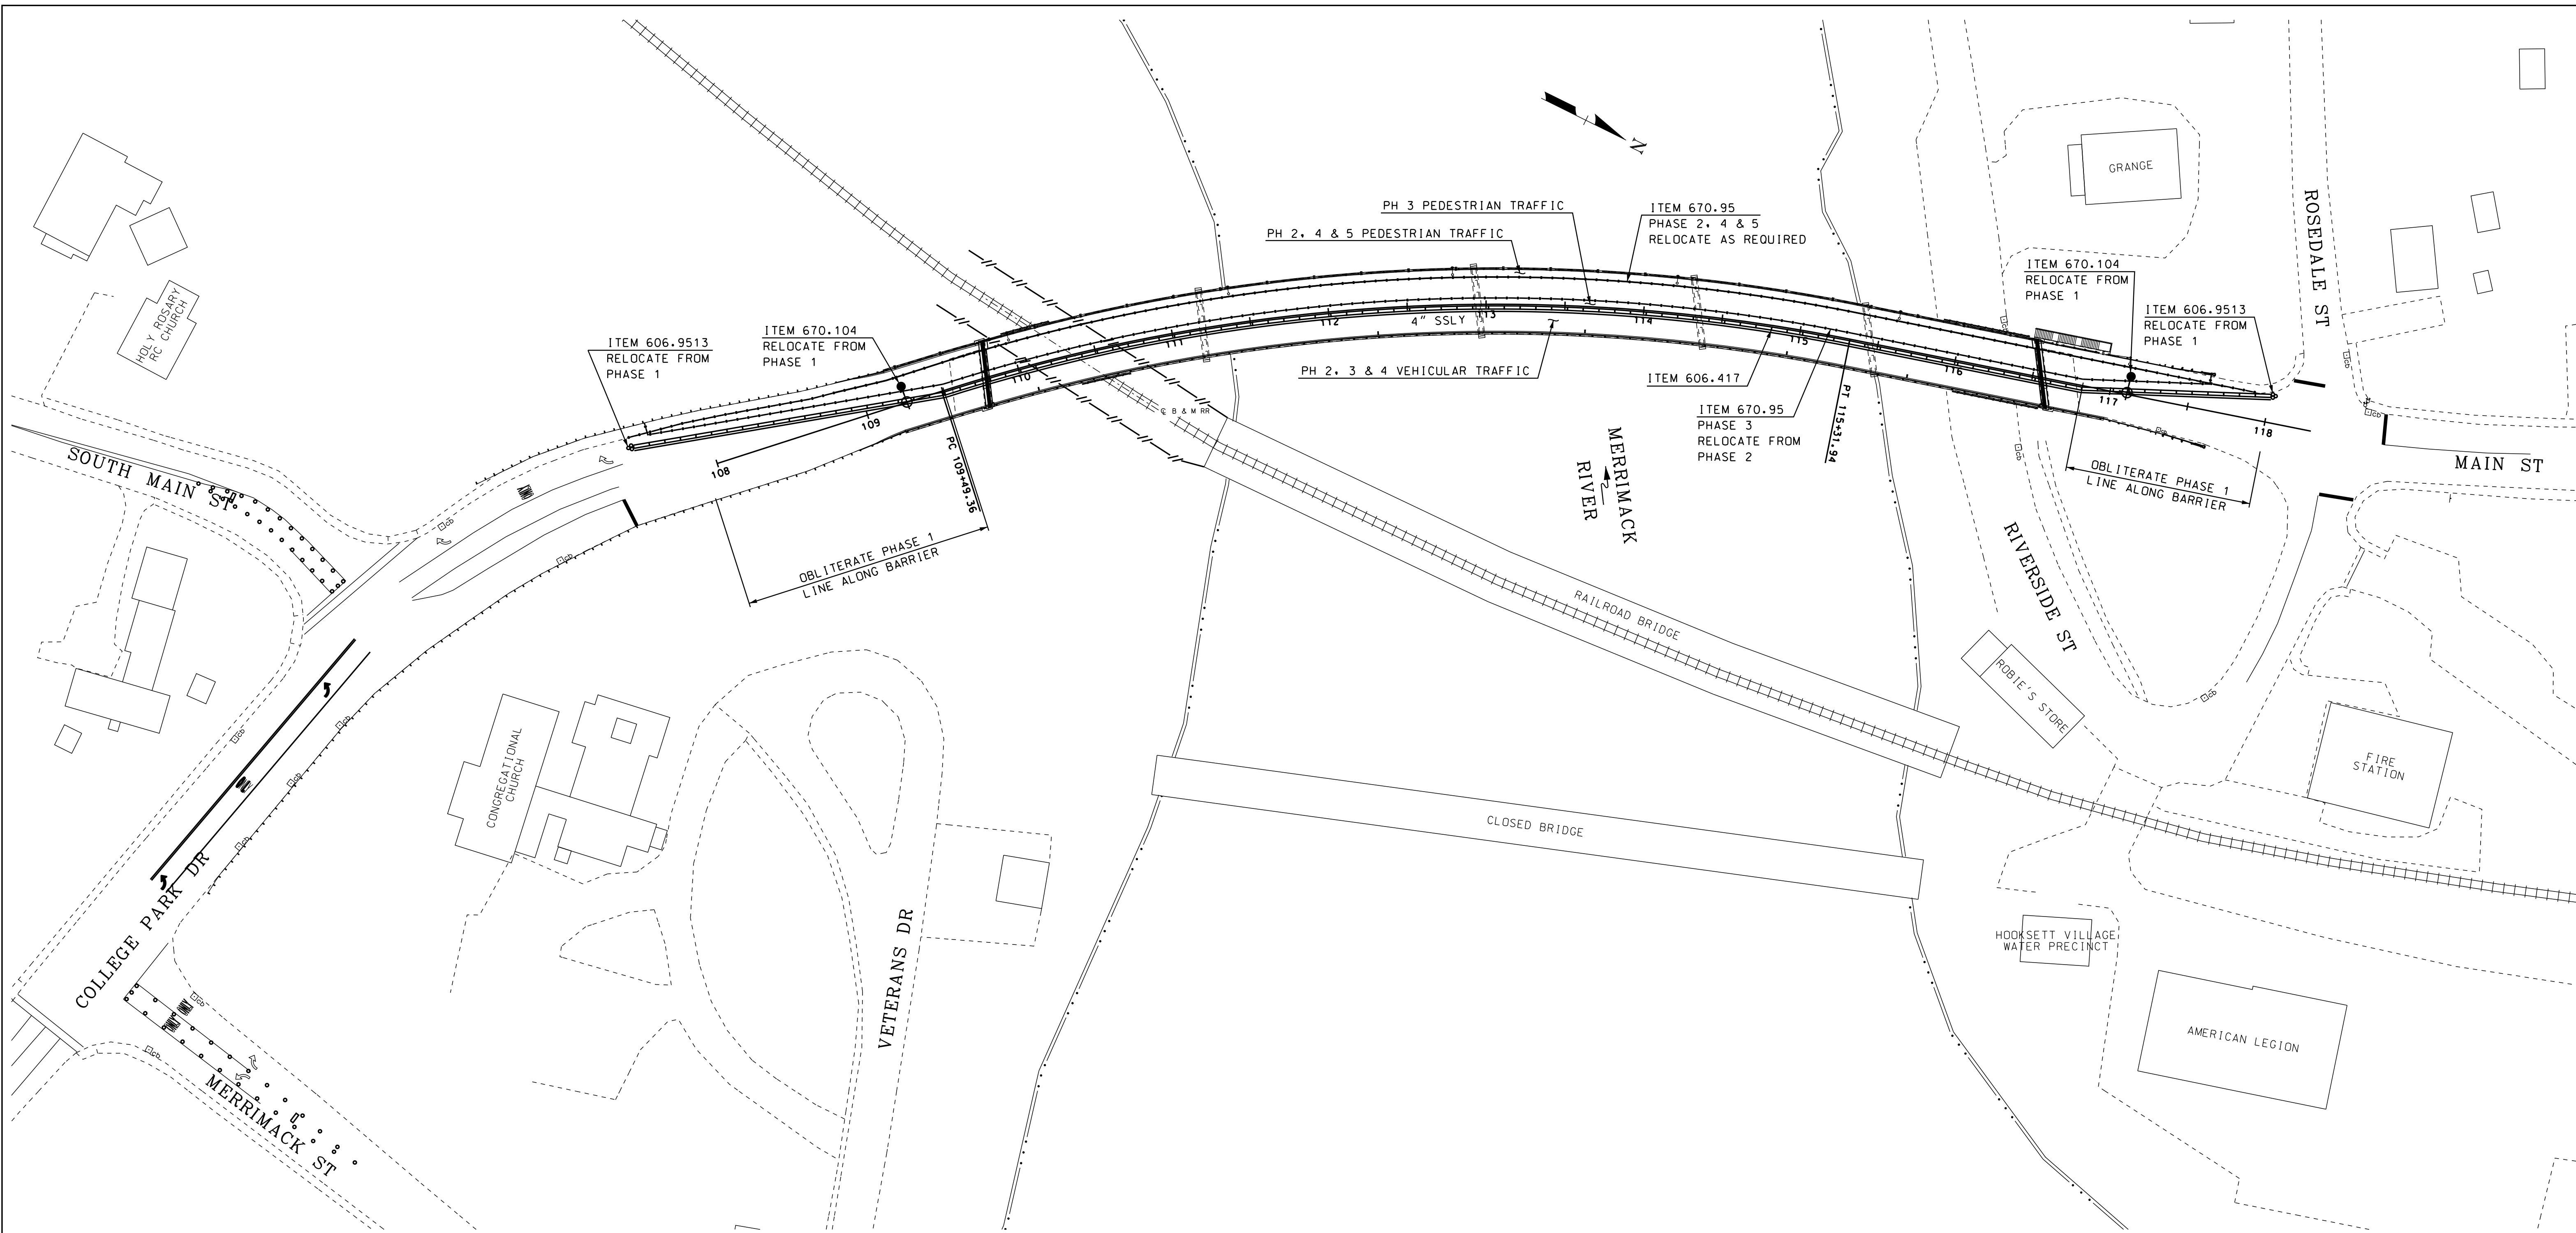


PLAN
SCALE: 1" = 50'-0"

STATE OF NEW HAMPSHIRE									
DEPARTMENT OF TRANSPORTATION * BUREAU OF BRIDGE DESIGN									
TOWN	HOOKSETT	BRIDGE NO.	080.148	STATE PROJECT	28435	BRIDGE SHEET			
LOCATION MAIN STREET over B&M RR, MERRIMACK RIVER, & RIVERSIDE STREET						--- OF ---			
TRAFFIC CONTROL PHASE 2, 3 & 4									
REVISIONS AFTER PROPOSAL		BY	DATE	CHECKED	BY	DATE	FILE NUMBER		
		DESIGNED	JAT	6/14	CHECKED	SMG	8/14	126-1-1	
		DRAWN	SMG	6/14	CHECKED	JAT	8/14	TOTAL SHEETS	
		QUANTITIES	SMG	9/14	CHECKED	JAT	9/14	27	
		ISSUE DATE		FEDERAL PROJECT NO.			SHEET NO.		
		REV. DATE		-----			27		
								42	

SUBDIRECTORY	DGN LOCATOR	SHEET SCALE
BRC\	28435 Traf Control	AS NOTED

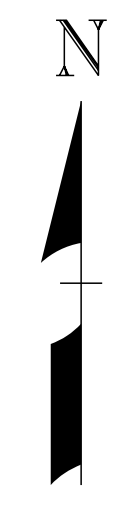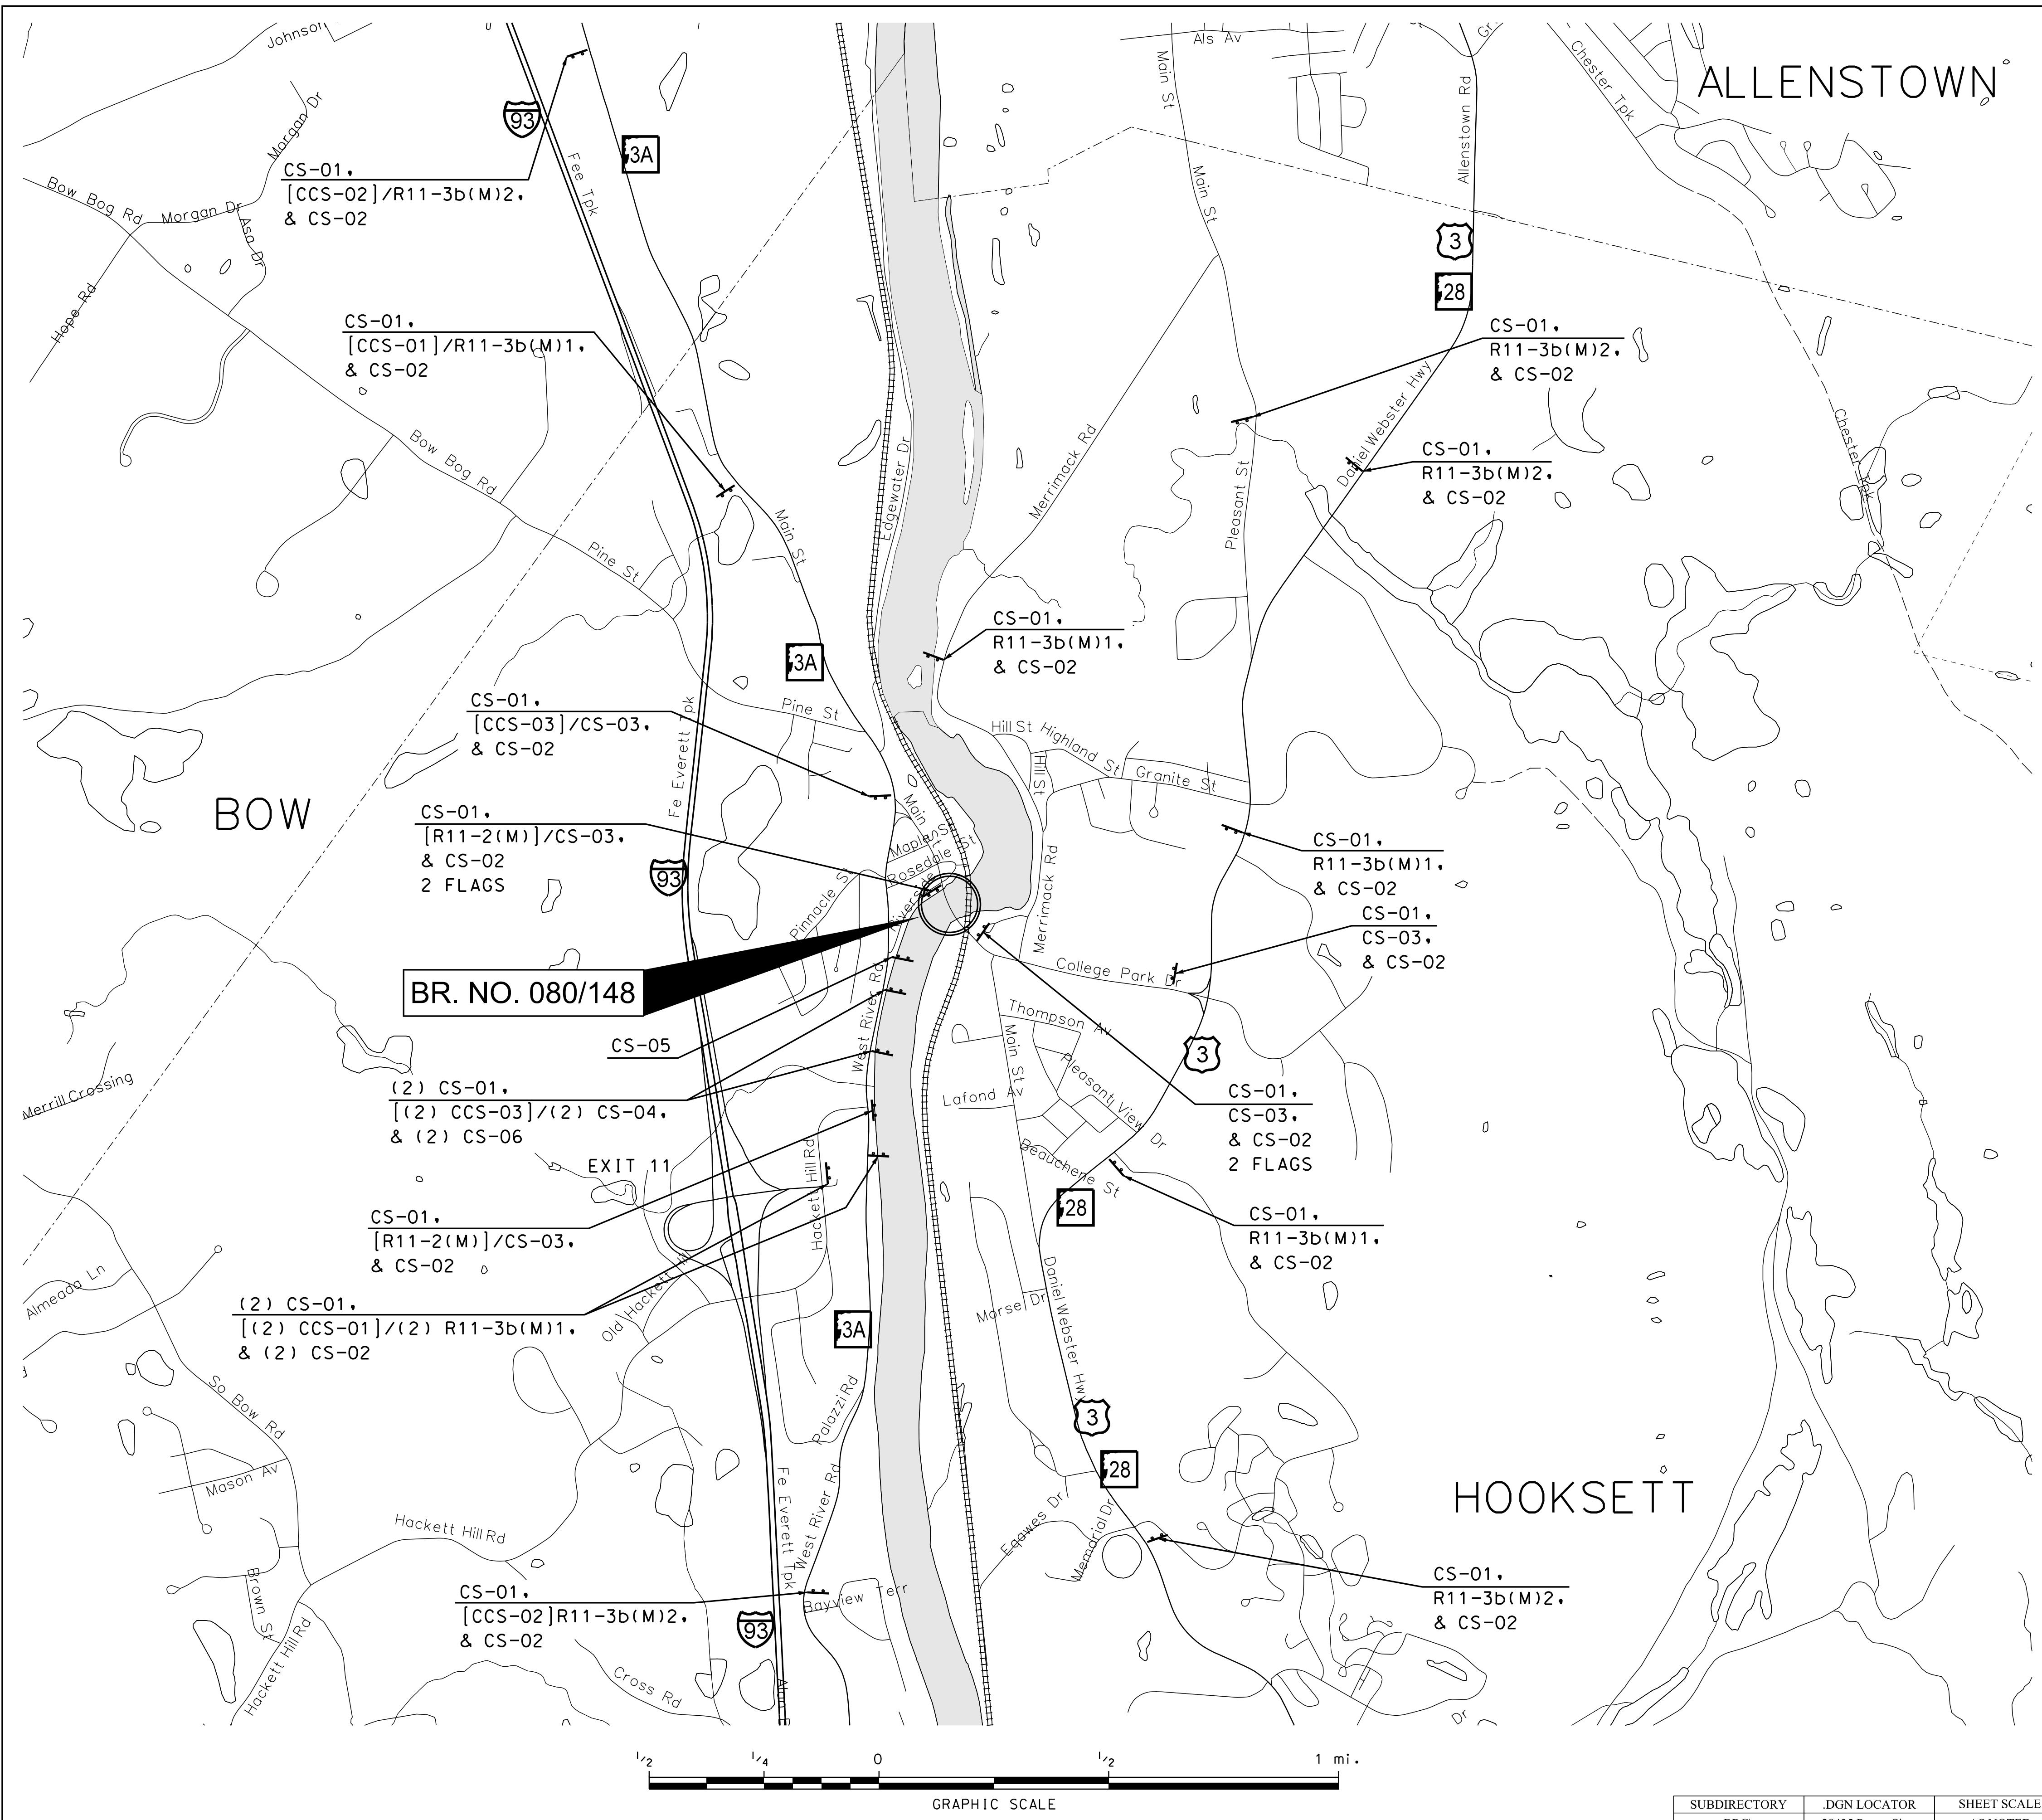

NOTE:
 SIGNS SHOWN WITH [SIGN]/ DESIGNATION ARE
 CONTINGENCY PLAN SIGNS THAT ARE TO BE MOUNTED
 BEHIND THE SIGN DESIGNATION FOLLOWING THE /.
 EXAMPLE [CCS-03]/CS-03 MEANS SIGN CCS-03 IS
 TO BE MOUNTED BEHIND SIGN CS-03.

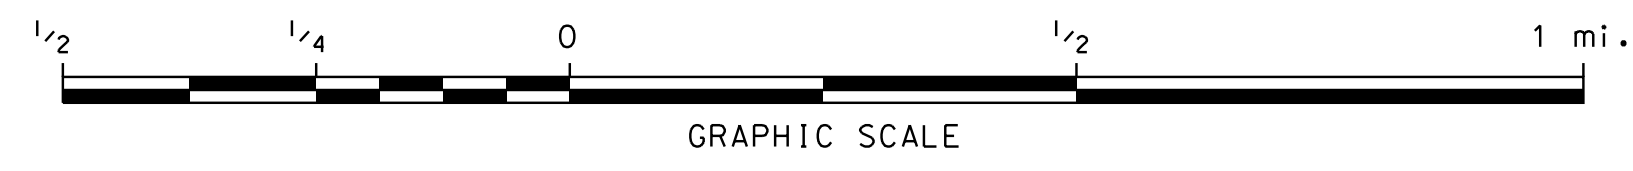

STATE OF NEW HAMPSHIRE									
DEPARTMENT OF TRANSPORTATION * BUREAU OF BRIDGE DESIGN									
TOWN	HOOKSETT	BRIDGE NO.	080/148	STATE PROJECT	28435	BRIDGE SHEET			
LOCATION MAIN STREET over B&M RR, MERRIMACK RIVER, & RIVERSIDE STREET						FILE NUMBER			
CONSTRUCTION/CONTINGENCY SIGNING						126-1-1			
REVISIONS AFTER PROPOSAL		BY	DATE	CHECKED	DATE	TOTAL SHEETS			
		DESIGNED	NHDOT	9/14	---	42			
		DRAWN	SMG	9/14	JAT	29			
		QUANTITIES	---	---	---				
		ISSUE DATE	FEDERAL PROJECT NO.		SHEET NO.				
		REV. DATE	-----		29				

SUBDIRECTORY	DGN LOCATOR	SHEET SCALE
BRC\	28435 PreconSign	AS NOTED



COVER EXISTING ROUTE
MARKER SIGNS
"TO RTE 3/28 →"


(2) R3-1
(2) R3-3RB1

CLOSE SLIP RAMP
(3) TRAFFIC BARRELS
(2) TYPE III BARRICADE
(W/ONE WARNING LIGHT)
(1) R11-2*
(1) R200S*
* MOUNT ON TYPE III
BARRICADE


COVER EXISTING GUIDE SIGN
"TO RTE 3/28 →"
"ALLENSTOWN 3 →"
"HOOKSETT →"

COVER EXISTING GUIDE SIGN
"TO RTE 3/28 900 FT"
DURING PROJECT DURATION

M4-5, M1-4(3), M1-5(28)
M6-2R

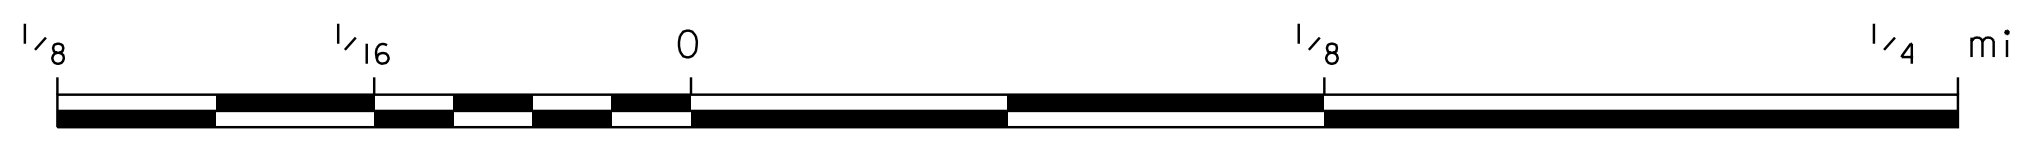

GRAPHIC SCALE

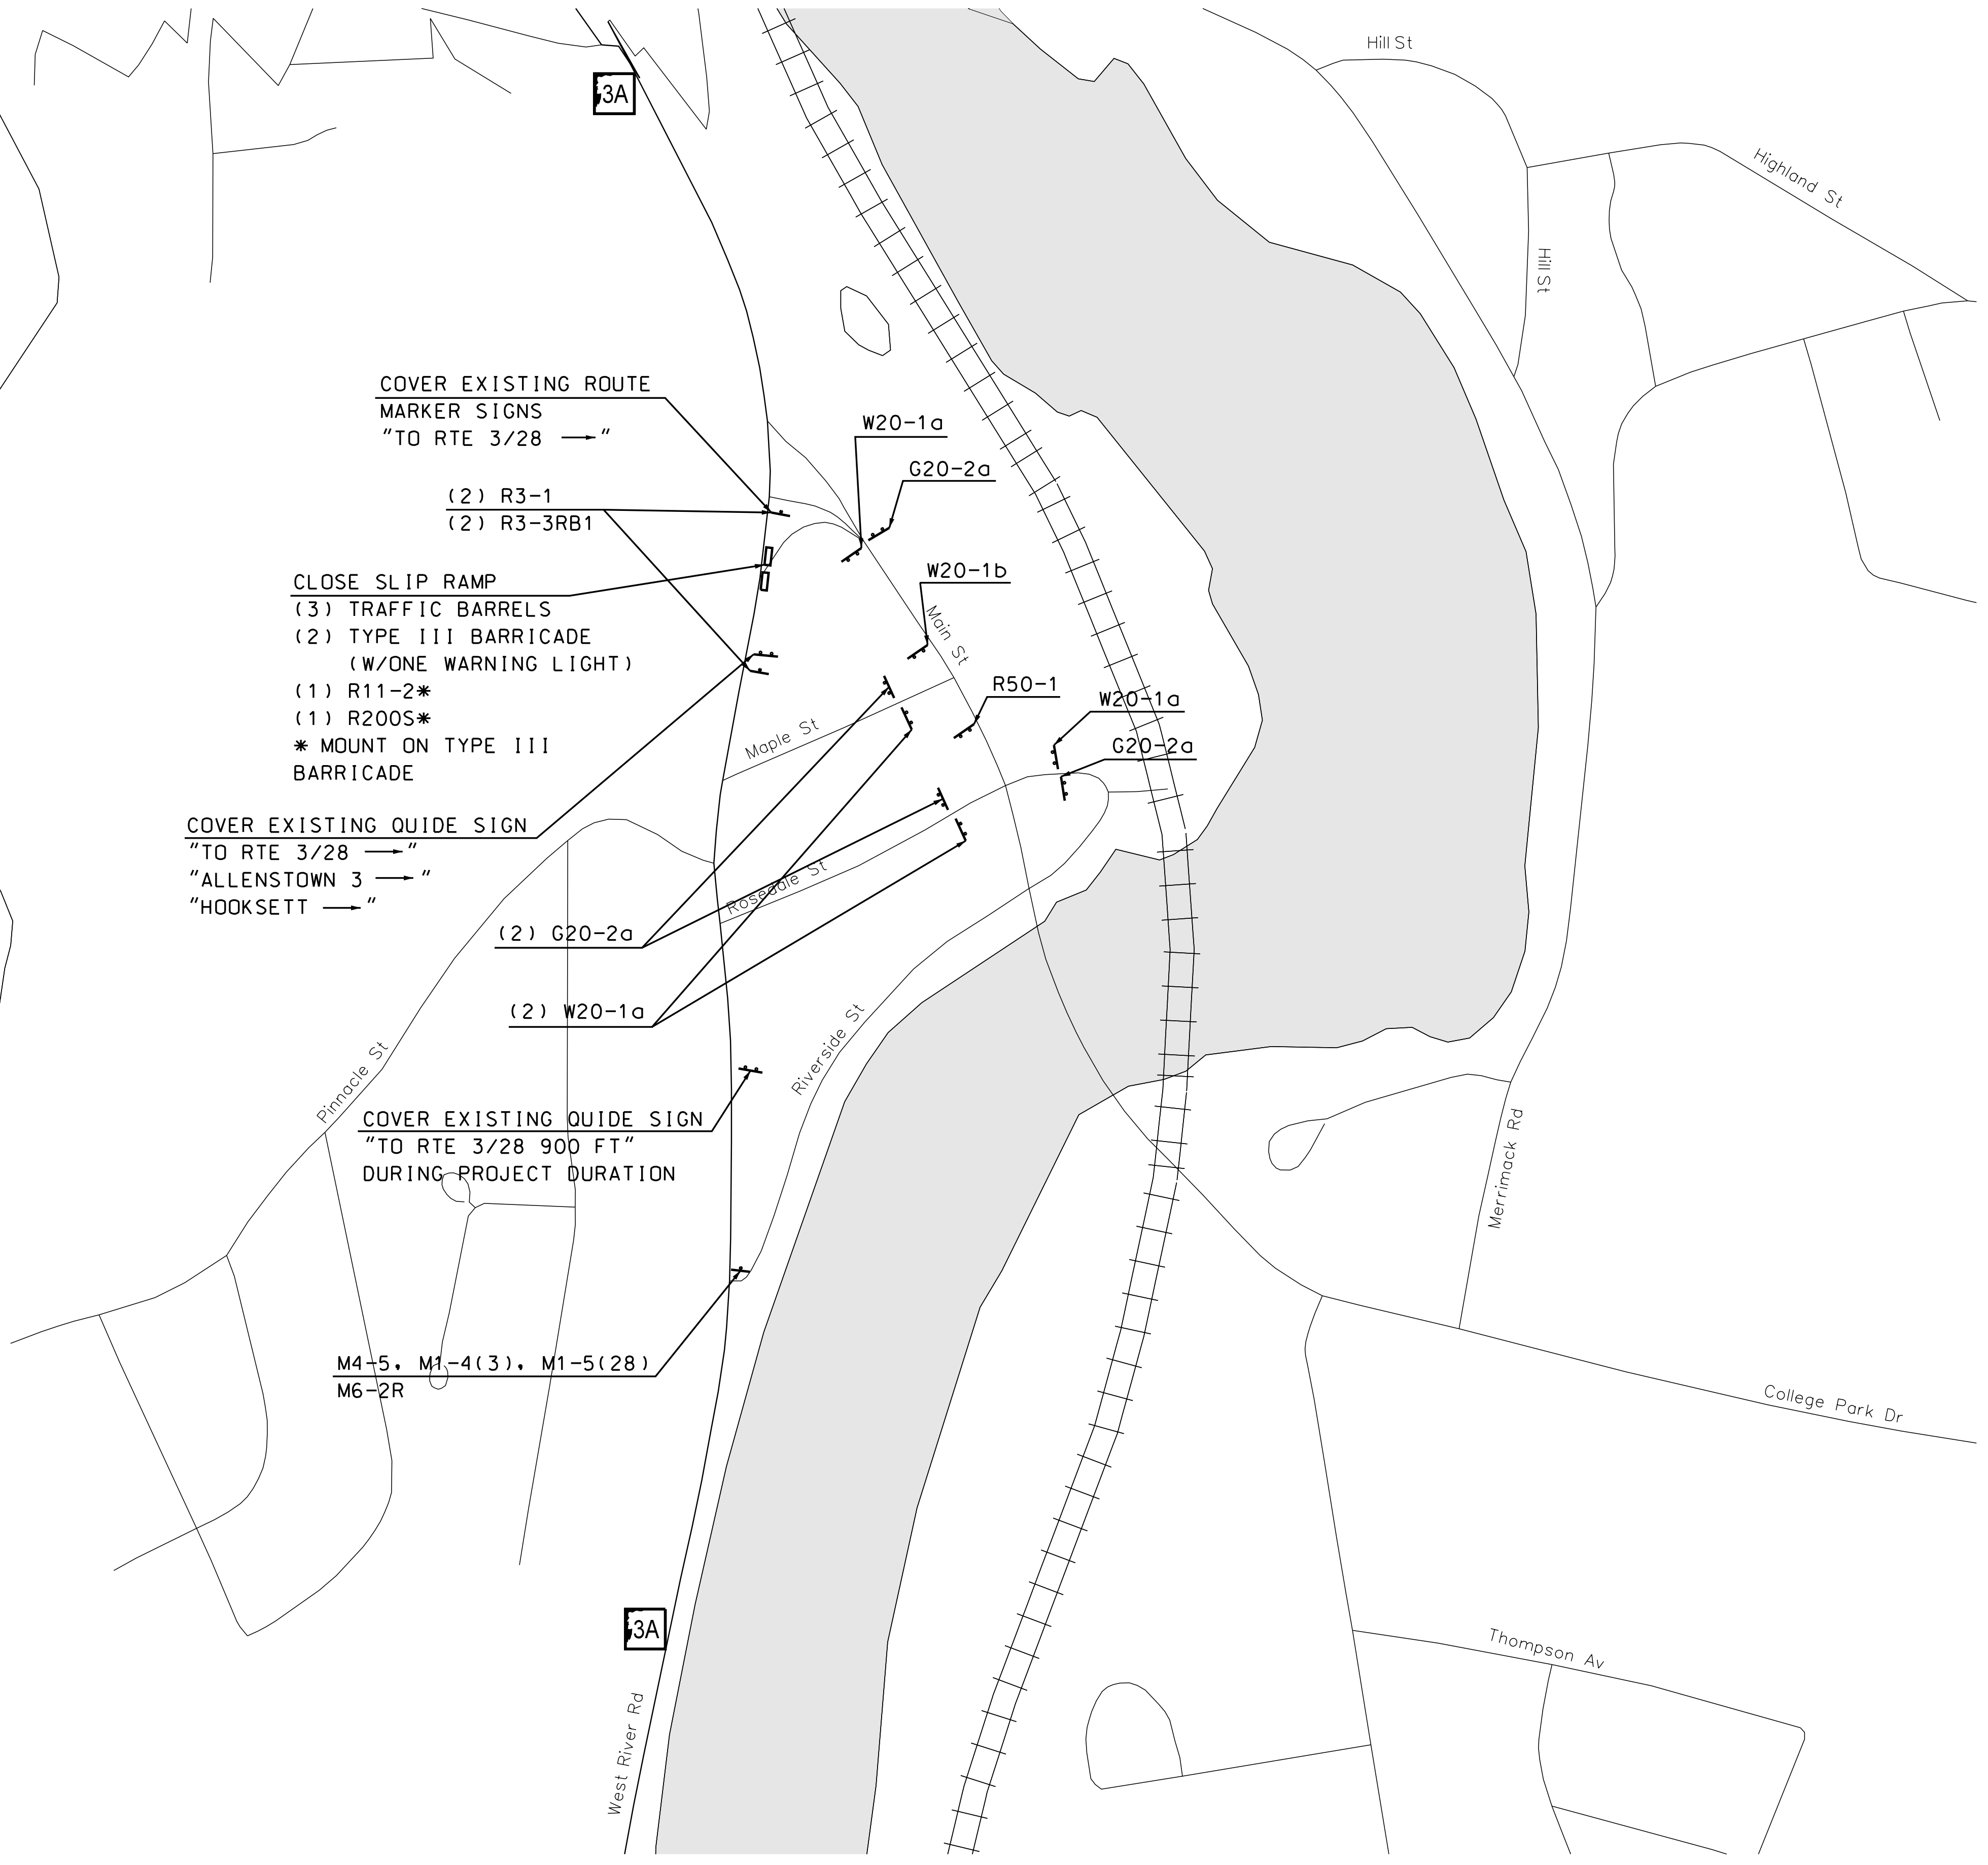


STATE OF NEW HAMPSHIRE									
DEPARTMENT OF TRANSPORTATION * BUREAU OF BRIDGE DESIGN									
TOWN	HOOKSETT	BRIDGE NO.	080/148	STATE PROJECT	28435				
LOCATION MAIN STREET over B&M RR, MERRIMACK RIVER, & RIVERSIDE STREET									
PERMANENT CONSTRUCTION SIGNING (1 OF 3)									
REVISIONS AFTER PROPOSAL		BY	DATE	CHECKED	BY	DATE	BRIDGE SHEET		
		DESIGNED	NHDOT	9/14	CHECKED	---	--- OF ---		
		DRAWN	SMG	9/14	CHECKED	JAT	FILE NUMBER		
		QUANTITIES	---	---	CHECKED	---	126-1-1		
ISSUE DATE		FEDERAL PROJECT NO.		SHEET NO.	TOTAL SHEETS				
REV. DATE		-----		30	42				

SUBDIRECTORY	.DGN LOCATOR	SHEET SCALE
BRC\	28435 PermConSign	AS NOTED

COVER EXISTING INTERSECTION
WARNING SIGN & SUPPLEMENTAL
STREET NAME(S) SIGN

COVER EXISTING GUIDE
SIGN "ALLENSTOWN 2"
"HOOKSETT DISTRICT
COURT"

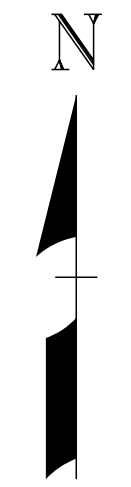

3

28

3A

3A

CS-03

W16-9P(M)
R3-3LB1

R6-1R
R3-2
R3-3LB1

W20-1a

R3-8(13)

G20-2a

R3-7R
COVER EXISTING
LANE USE SIGN

W20-1c

R50-1

W20-1e

R3-7R
COVER EXISTING
LANE USE SIGN

G20-2a

G20-2a

W20-1a

R6-1R
R3-2
R3-3LB1

M4-5, SP-01,
& M6-3

M4-5, SP-02,
& M6-3

M4-5, SP-01
& M6-1L

M4-5, SP-02
& M6-1L

W16-9P(M)
R3-3LB1

Thompson Av

Campus Dr

West River Rd

Riverside St

South Main St

Lafond Av


Pleasant View Dr

Daniel Webster Hwy

Beauchene St



(2) R11-3a(M)
MOUNTED ON 2
U-CHANNEL POSTS
EACH

(2) R11-3a(M)
MOUNTED ON 2
U-CHANNEL POSTS
EACH

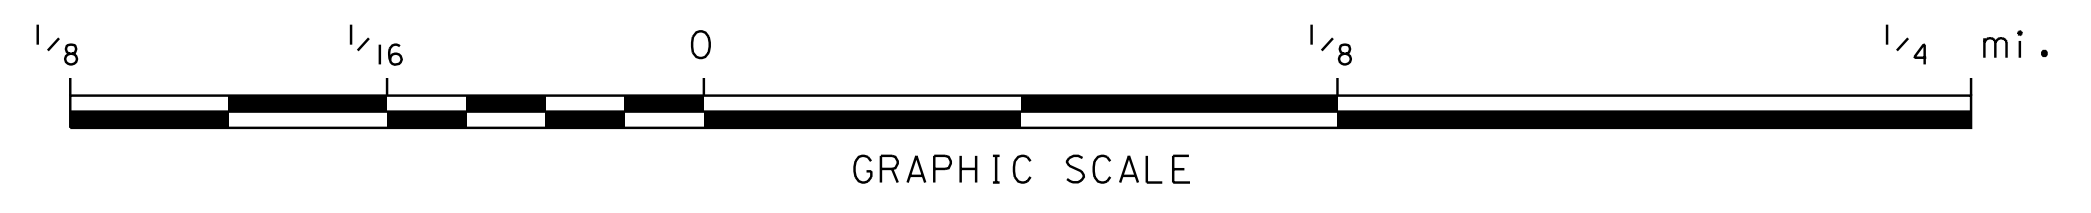



STATE OF NEW HAMPSHIRE									
DEPARTMENT OF TRANSPORTATION * BUREAU OF BRIDGE DESIGN									
TOWN	HOOKSETT	BRIDGE NO.	080/148	STATE PROJECT	28435				
LOCATION MAIN STREET over B&M RR, MERRIMACK RIVER, & RIVERSIDE STREET									
PERMANENT CONSTRUCTION SIGNING (2 OF 3)									
REVISIONS AFTER PROPOSAL		BY	DATE	CHECKED	BY	DATE	BRIDGE SHEET		
		DESIGNED	NHDOT 9/14	CHECKED	---	---	--- OF ---		
		DRAWN	SMG 9/14	CHECKED	JAT	9/14	FILE NUMBER		
		QUANTITIES	---	CHECKED	---	---	126-1-1		
		ISSUE DATE		FEDERAL PROJECT NO.		SHEET NO.	TOTAL SHEETS		
		REV. DATE		-----		31	42		

SUBDIRECTORY	DGN LOCATOR	SHEET SCALE
BRC\	28435 PermConSign	AS NOTED

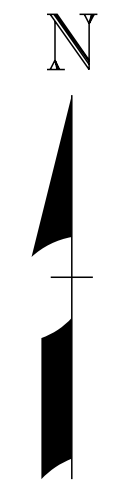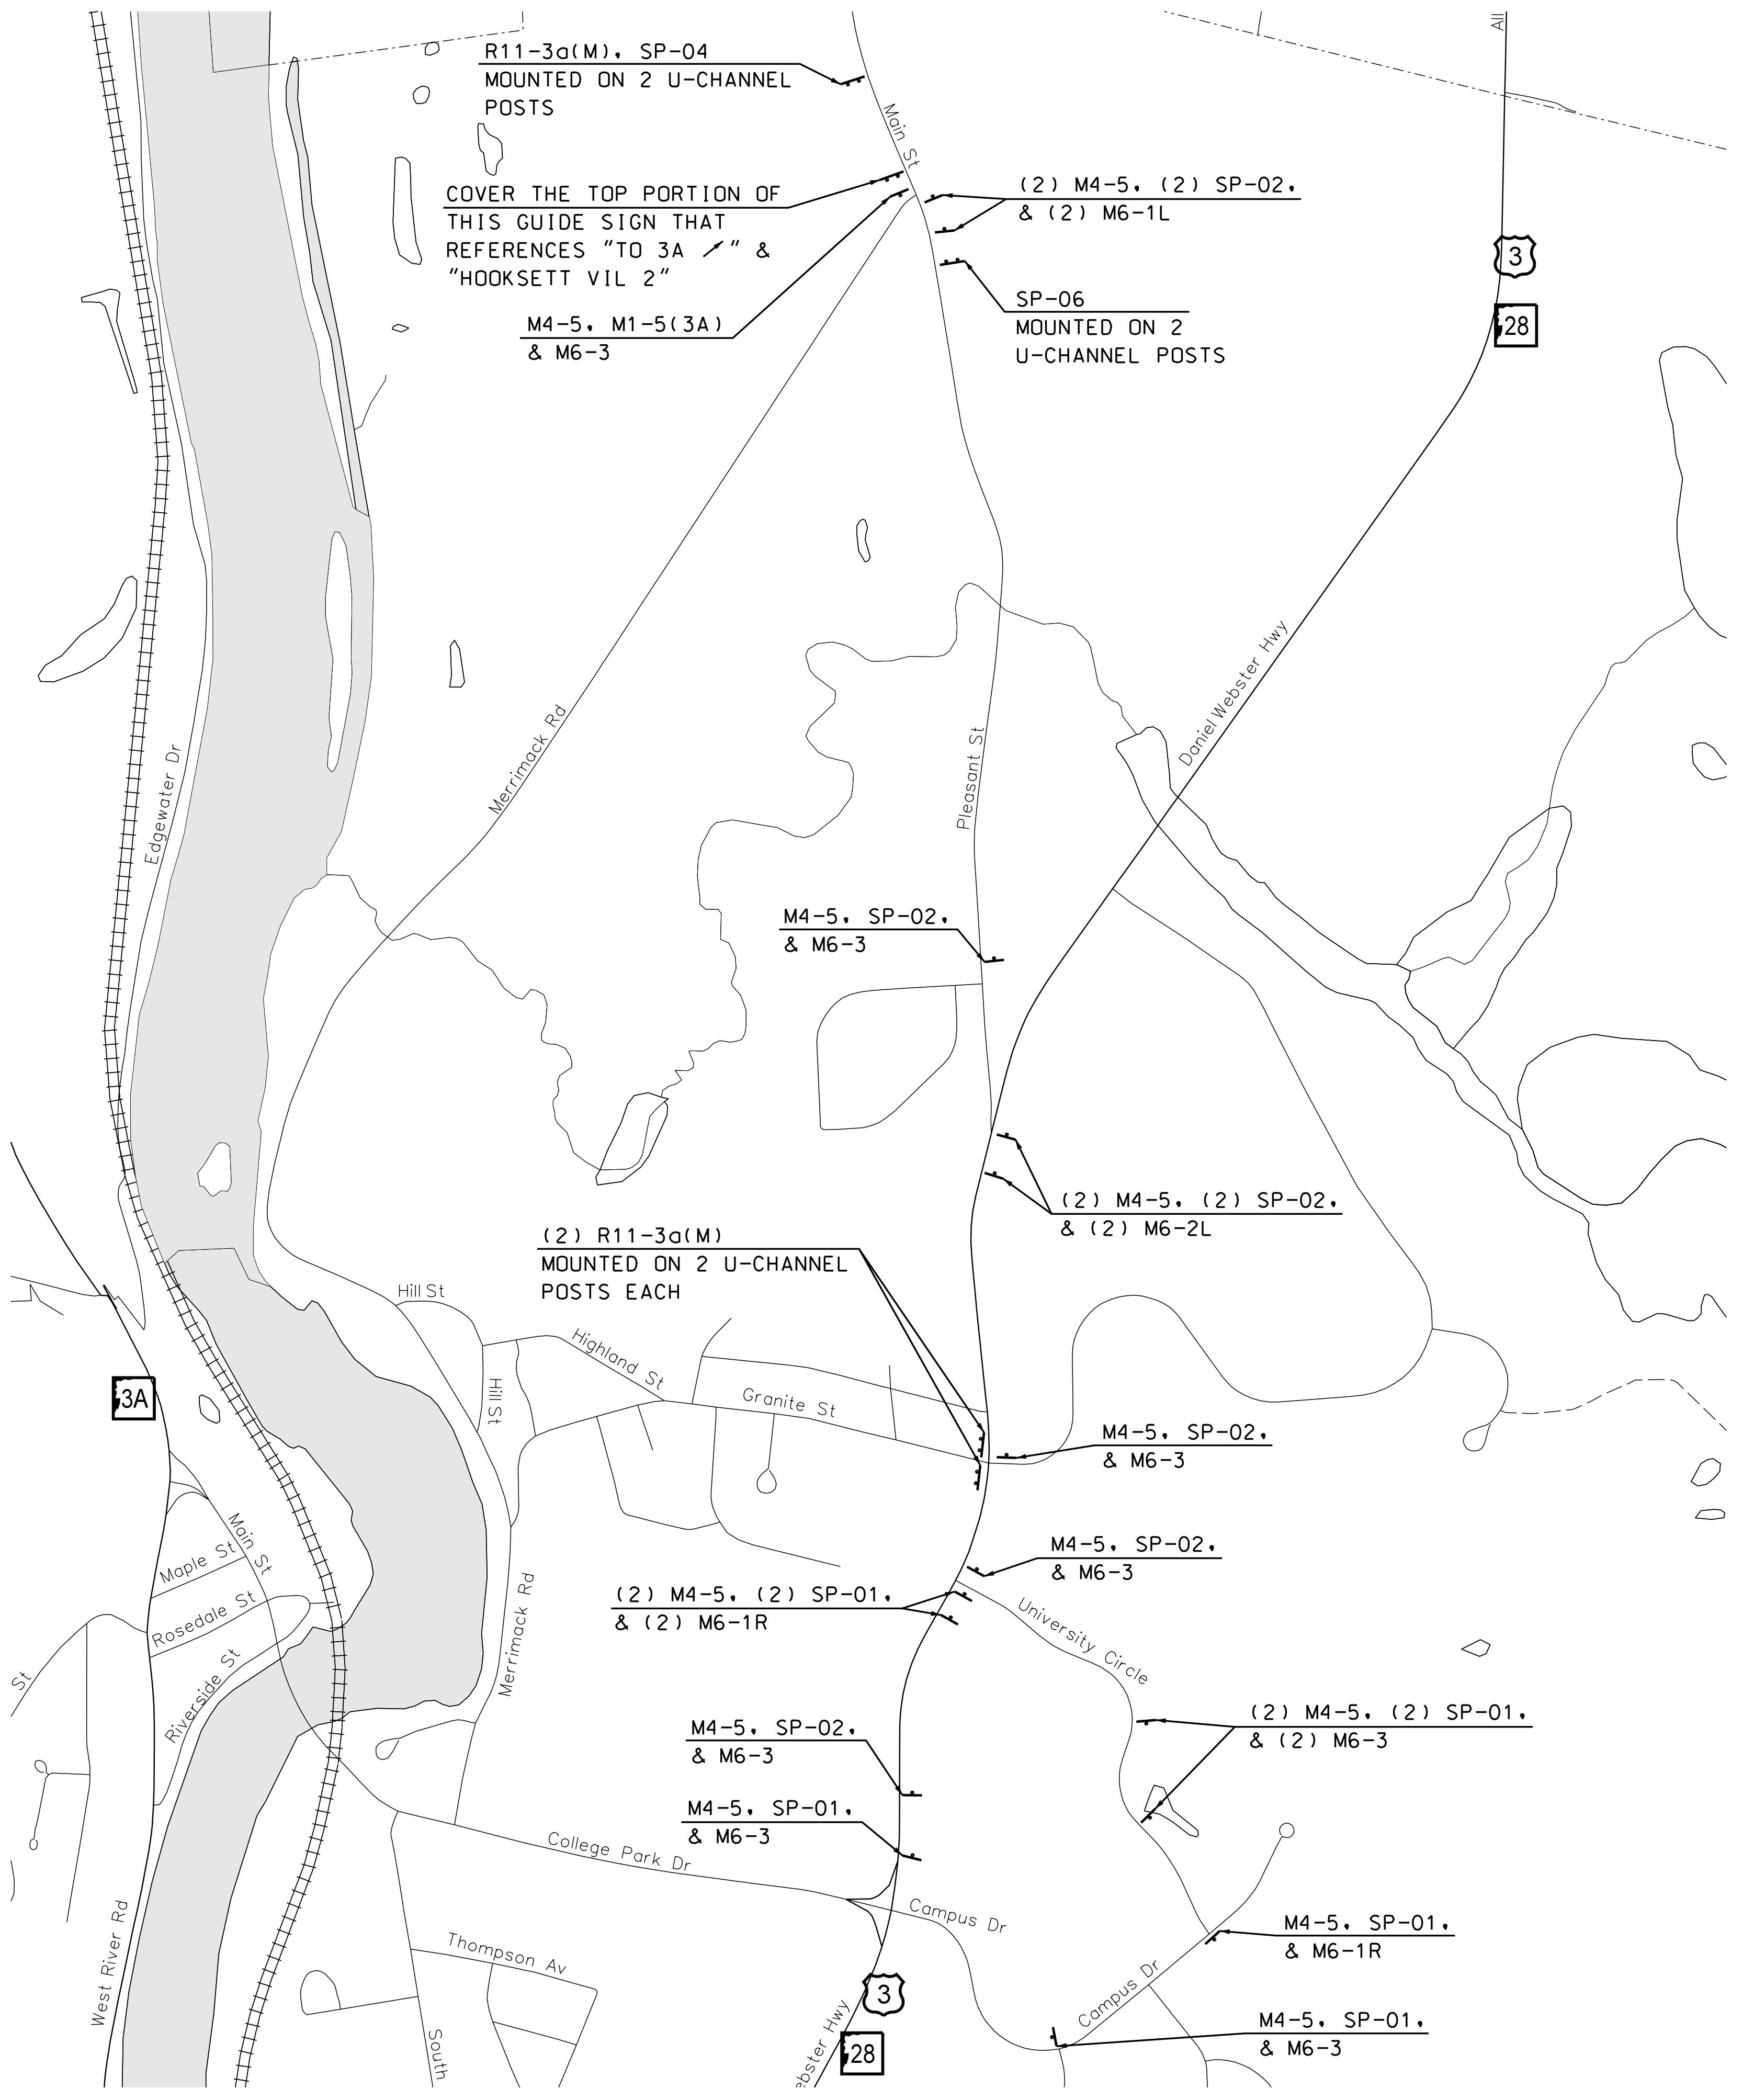

STATE OF NEW HAMPSHIRE									
DEPARTMENT OF TRANSPORTATION * BUREAU OF BRIDGE DESIGN									
TOWN	HOOKSETT	BRIDGE NO.	080/148	STATE PROJECT	28435				
LOCATION MAIN STREET over B&M RR, MERRIMACK RIVER, & RIVERSIDE STREET									
PERMANENT CONSTRUCTION SIGNING (3 OF 3)									
REVISIONS AFTER PROPOSAL		BY	DATE	CHECKED	BY	DATE	BRIDGE SHEET		
		DESIGNED	NHDOT 9/14	CHECKED	---	---	--- OF ---		
		DRAWN	SMG 9/14	CHECKED	JAT	9/14	FILE NUMBER		
		QUANTITIES	---	CHECKED	---	---	126-1-1		
ISSUE DATE		FEDERAL PROJECT NO.		SHEET NO.	TOTAL SHEETS				
REV. DATE		-----		32	42				

SUBDIRECTORY	DGN LOCATOR	SHEET SCALE
BRC\	28435 PermConSign	AS NOTED

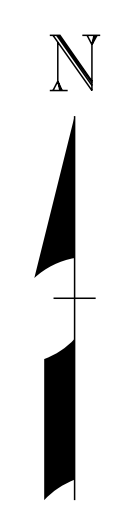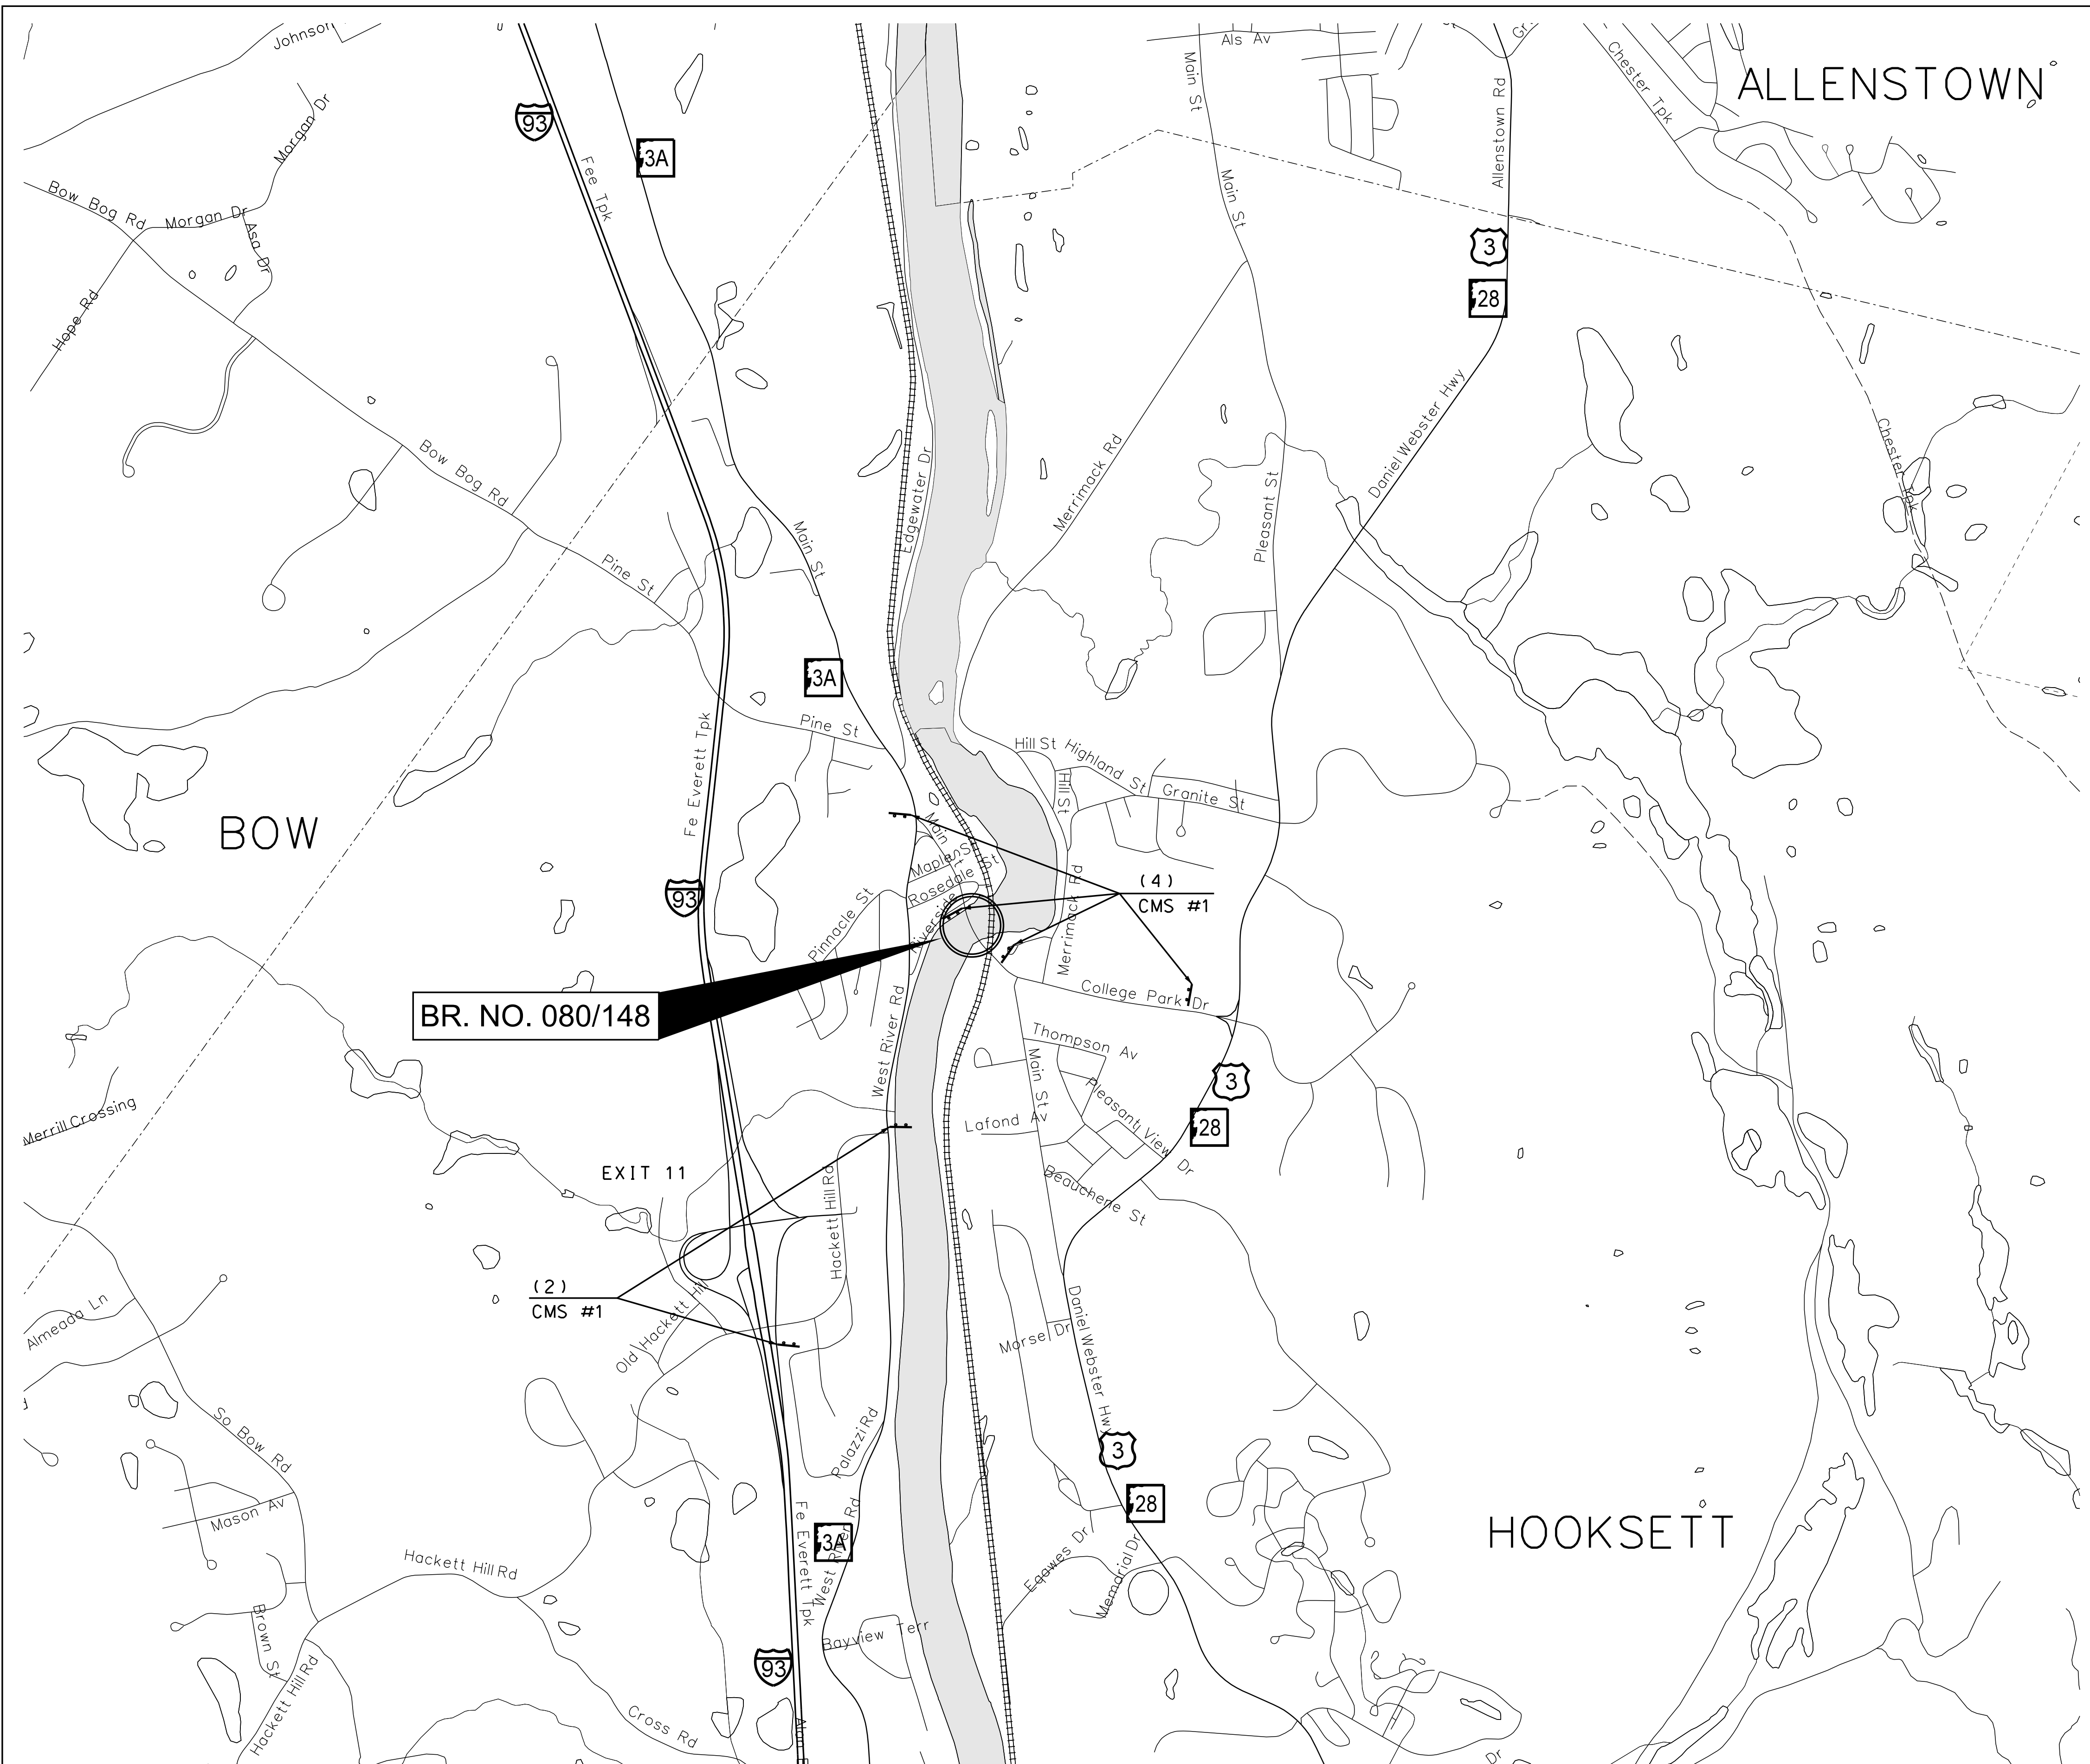

BR. NO. 080/148

CMS #1 (6)

MESSAGE #1 BRIDGE WORK (DATE)

MESSAGE #2 EXPECT SEVERE DELAYS


TO BE PUT IN PLACE 4 WEEKS PRIOR TO START OF PHASED CONSTRUCTION WORK.



GRAPHIC SCALE

STATE OF NEW HAMPSHIRE									
DEPARTMENT OF TRANSPORTATION * BUREAU OF BRIDGE DESIGN									
TOWN	HOOKSETT	BRIDGE NO.	080/148	STATE PROJECT	28435				
LOCATION MAIN STREET over B&M RR, MERRIMACK RIVER, & RIVERSIDE STREET									
CHANGEABLE MESSAGE SIGN (CMS) BOARDS								BRIDGE SHEET	
REVISIONS AFTER PROPOSAL		BY	DATE	CHECKED	BY	DATE	--- OF ---		
		DESIGNED	NHDOT	9/14	CHECKED	---	FILE NUMBER		
		DRAWN	SMG	9/14	CHECKED	JAT	9/14	126-1-1	
		QUANTITIES	---	---	CHECKED	---	TOTAL SHEETS		
ISSUE DATE		FEDERAL PROJECT NO.			SHEET NO.	TOTAL SHEETS			
REV. DATE		-----			33	42			

SUBDIRECTORY	DGN LOCATOR	SHEET SCALE
BRC\	28435 CMSBoard	AS NOTED

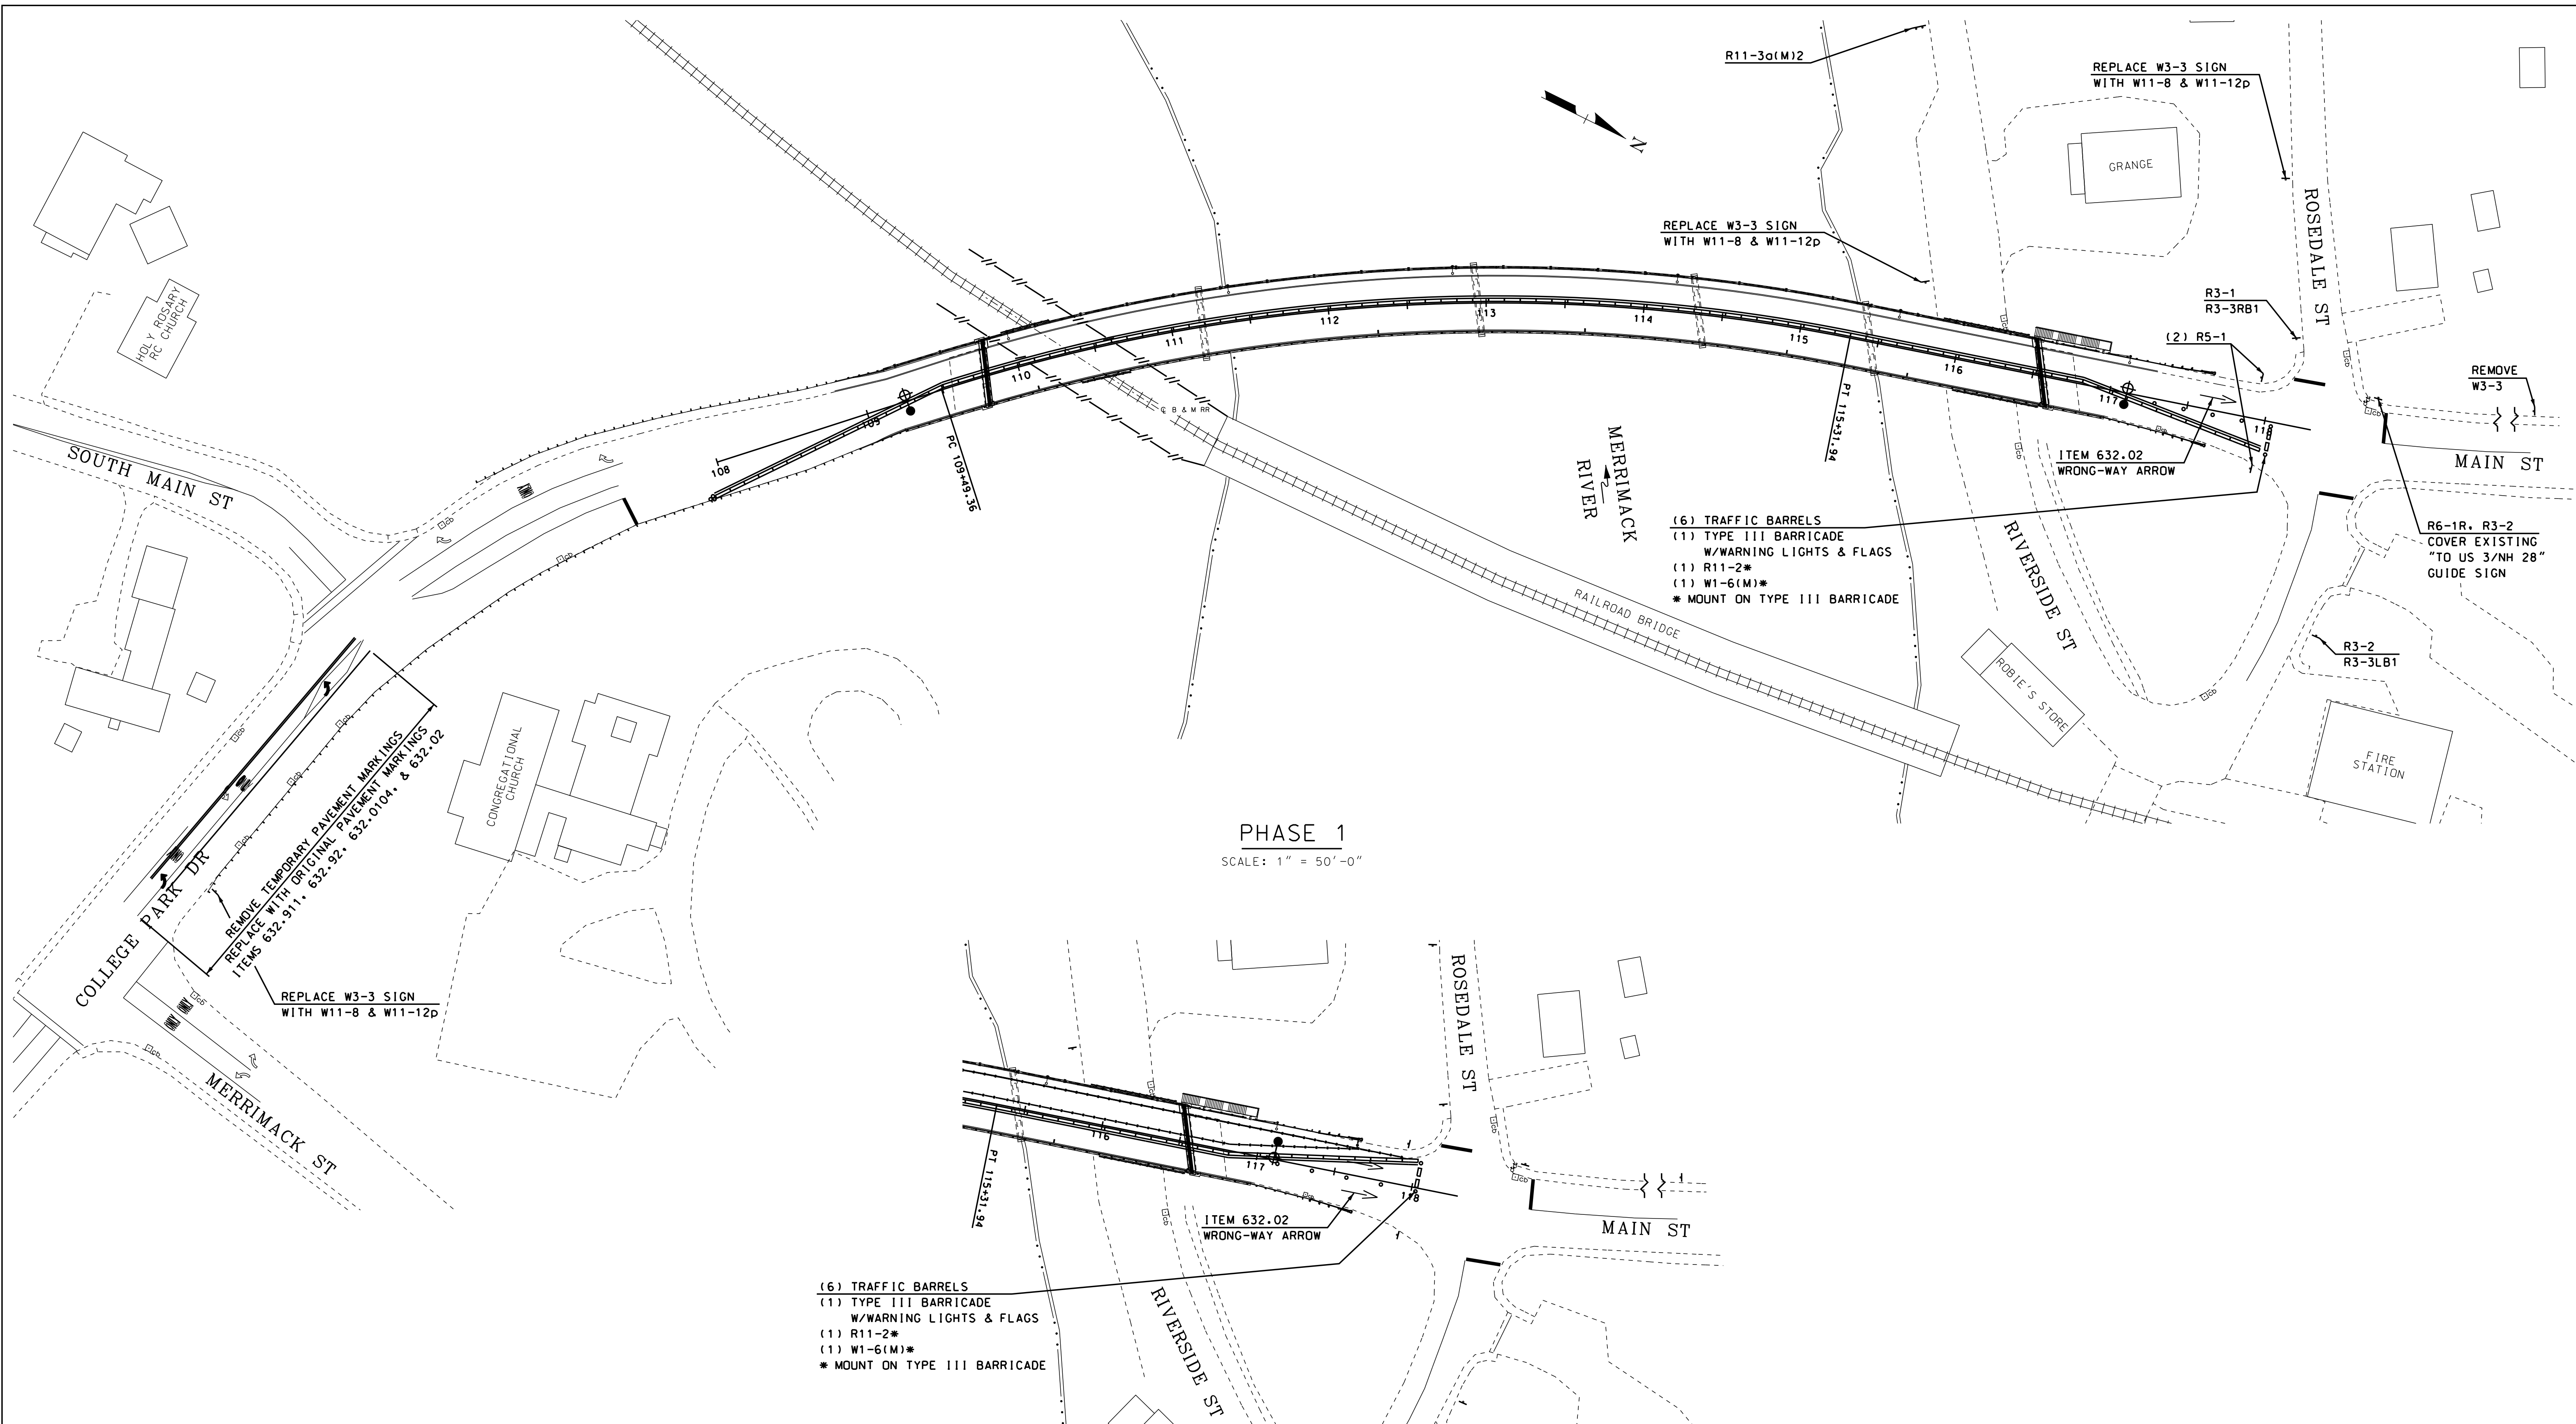

PHASE 1

SCALE: 1" = 50'-0"

- (6) TRAFFIC BARRELS
- (1) TYPE III BARRICADE
- W/WARNING LIGHTS & FLAGS
- (1) R11-2*
- (1) W1-6(M)*
- * MOUNT ON TYPE III BARRICADE


ALL OTHER SIGNAGE FROM PHASE 1 TO REMAIN IN PLACE FOR PHASE 2.

PHASE 2

SCALE: 1" = 50'-0"

STATE OF NEW HAMPSHIRE							
DEPARTMENT OF TRANSPORTATION * BUREAU OF BRIDGE DESIGN							
TOWN	HOOKSETT	BRIDGE NO.	080/148	STATE PROJECT	28435		
LOCATION MAIN STREET over B&M RR, MERRIMACK RIVER, & RIVERSIDE STREET							
CONTINGENCY PHASING PLAN					BRIDGE SHEET		
REVISIONS AFTER PROPOSAL		BY	DATE	CHECKED	BY	DATE	FILE NUMBER
		DESIGNED	JAT	6/14	CHECKED	SMG	8/14
		DRAWN	SMG	6/14	CHECKED	JAT	8/14
		QUANTITIES	SMG	9/14	CHECKED	JAT	9/14
		ISSUE DATE		FEDERAL PROJECT NO.		SHEET NO.	TOTAL SHEETS
		REV. DATE		-----		34	42


SUBDIRECTORY	DGN LOCATOR	SHEET SCALE
BRC\	28435 ContinPhase	AS NOTED

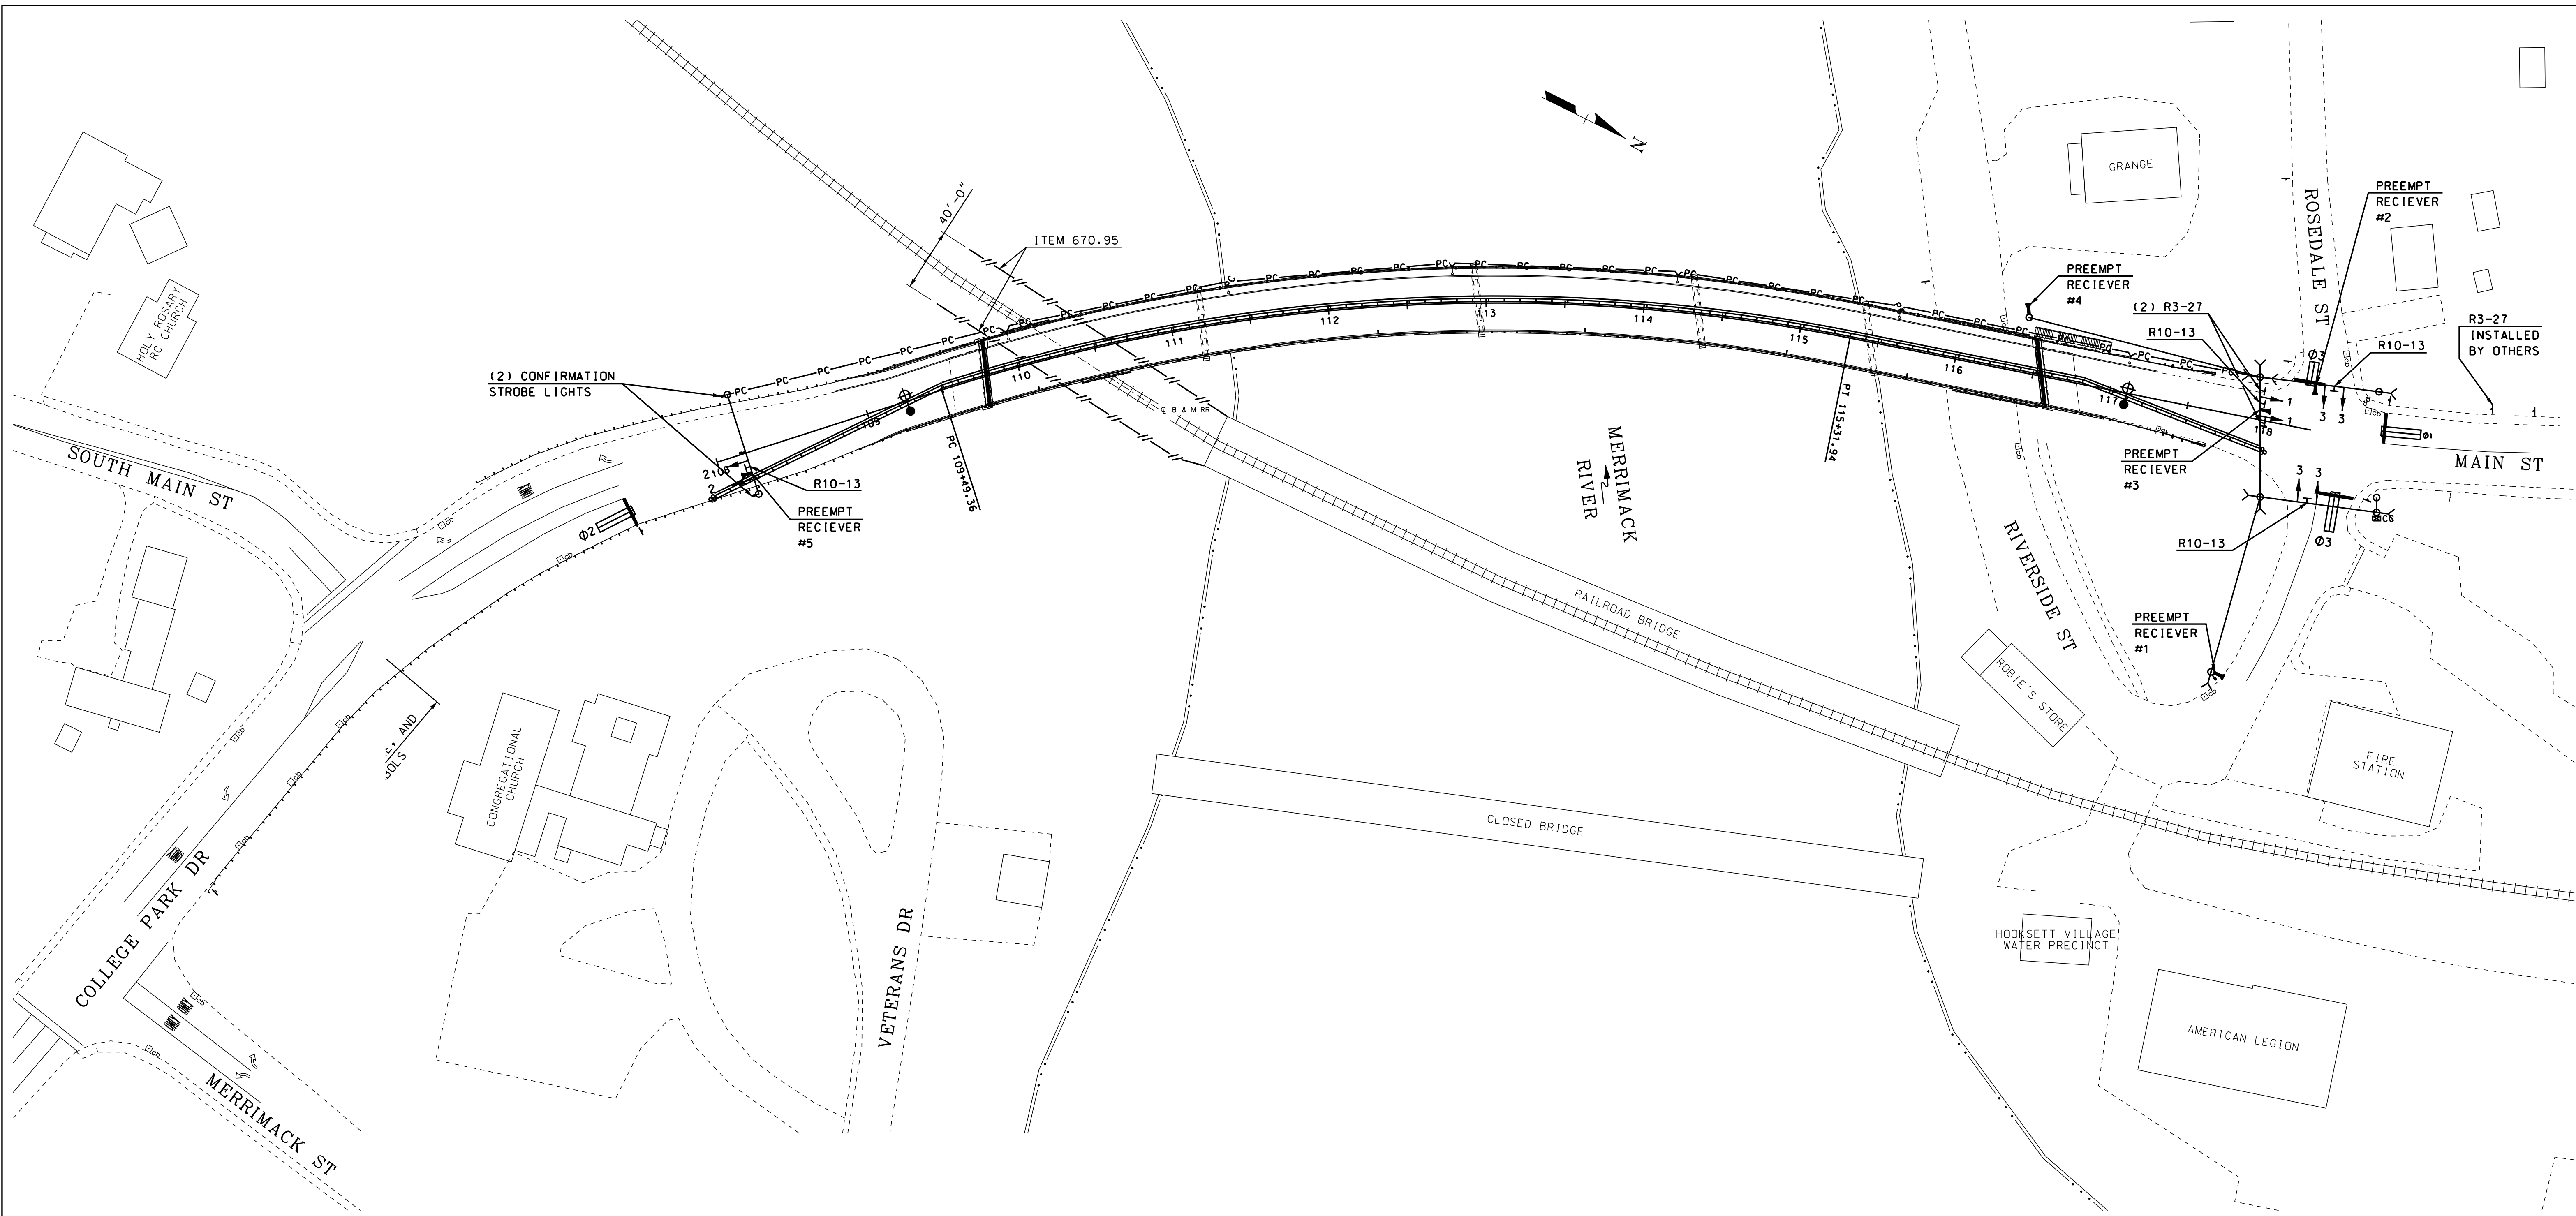

PLAN

SCALE: 1" = 50'-0"


EMERGENCY-VEHICLE ACTIVATION SEQUENCE			
	Φ1	Φ2	Φ3
NON-EMERGENCY OPERATION	SR	FY	FR
MAIN STREET (WEST) Φ1 - ACTIVATED	SR - SG	FY - SY - SR	FR - SY - SR
MAIN STREET (EAST) Φ2 - ACTIVATED	SR	FY	FR - SY - SR
RIVERSIDE STREET Φ3 - ACTIVATED	SR	FY - SY - SR	FR - SG
ROSDALE STREET Φ3 - ACTIVATED	SR	FY - SY - SR	FR - SY - SR

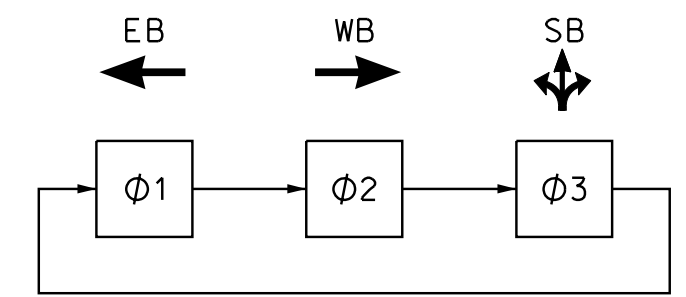

NOTE 1:
THE CONTRACTOR SHALL INSTALL ITEM 616.192 - ALTERATIONS TO TRAFFIC SIGNALS IN CONJUNCTION WITH ITEM 616.161 - TRAFFIC SIGNALS (TEMPORARY) IN PREPARATION TO EXECUTE, IF REQUIRED, THE CONTINGENCY PLAN IN A TIMELY MANNER.

SIGNAL HEADS




ALL LENSES 12" WITH 5" LOUVERED BACK PLATE

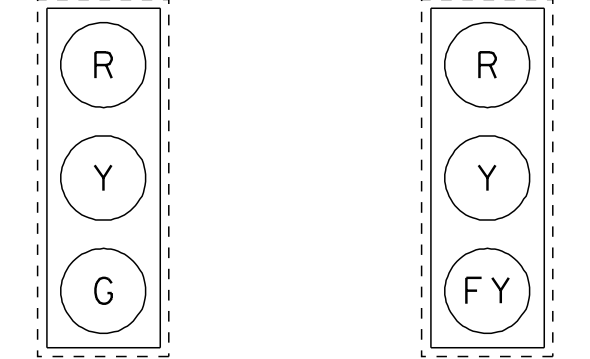

NOTE 2:
ALL GROUND-MOUNTED CONSTRUCTION SIGNS SHOWN ON THIS PLAN SHALL BE INSTALLED BY THE CONTRACTOR AND ALL OVERHEAD SIGNS SHOWN ON THIS PLAN SHALL BE INSTALLED BY THE SIGNAL CONTRACTOR.

STATE OF NEW HAMPSHIRE DEPARTMENT OF TRANSPORTATION * BUREAU OF BRIDGE DESIGN								
TOWN	HOOKSETT	BRIDGE NO.	080/148	STATE PROJECT	28435			
LOCATION MAIN STREET over B&M RR, MERRIMACK RIVER, & RIVERSIDE STREET								
CONTINGENCY SIGNAL PLAN					BRIDGE SHEET			
REVISIONS AFTER PROPOSAL					--- OF ---			
DESIGNED	JAT	DATE	6/14	CHECKED	SMG	DATE	8/14	FILE NUMBER 126-1-1
DRAWN	SMG	DATE	6/14	CHECKED	JAT	DATE	8/14	
QUANTITIES	SMG	DATE	9/14	CHECKED	JAT	DATE	9/14	
ISSUE DATE	FEDERAL PROJECT NO.			SHEET NO.	TOTAL SHEETS			
REV. DATE	-----			35	42			

SUBDIRECTORY	DGN LOCATOR	SHEET SCALE
BRC\	28435 ContinSignal	AS NOTED

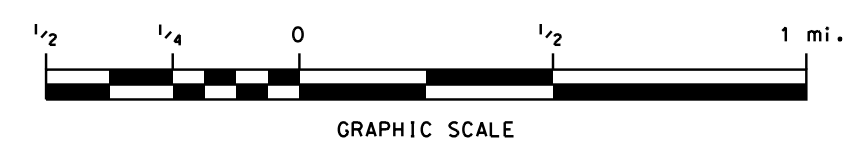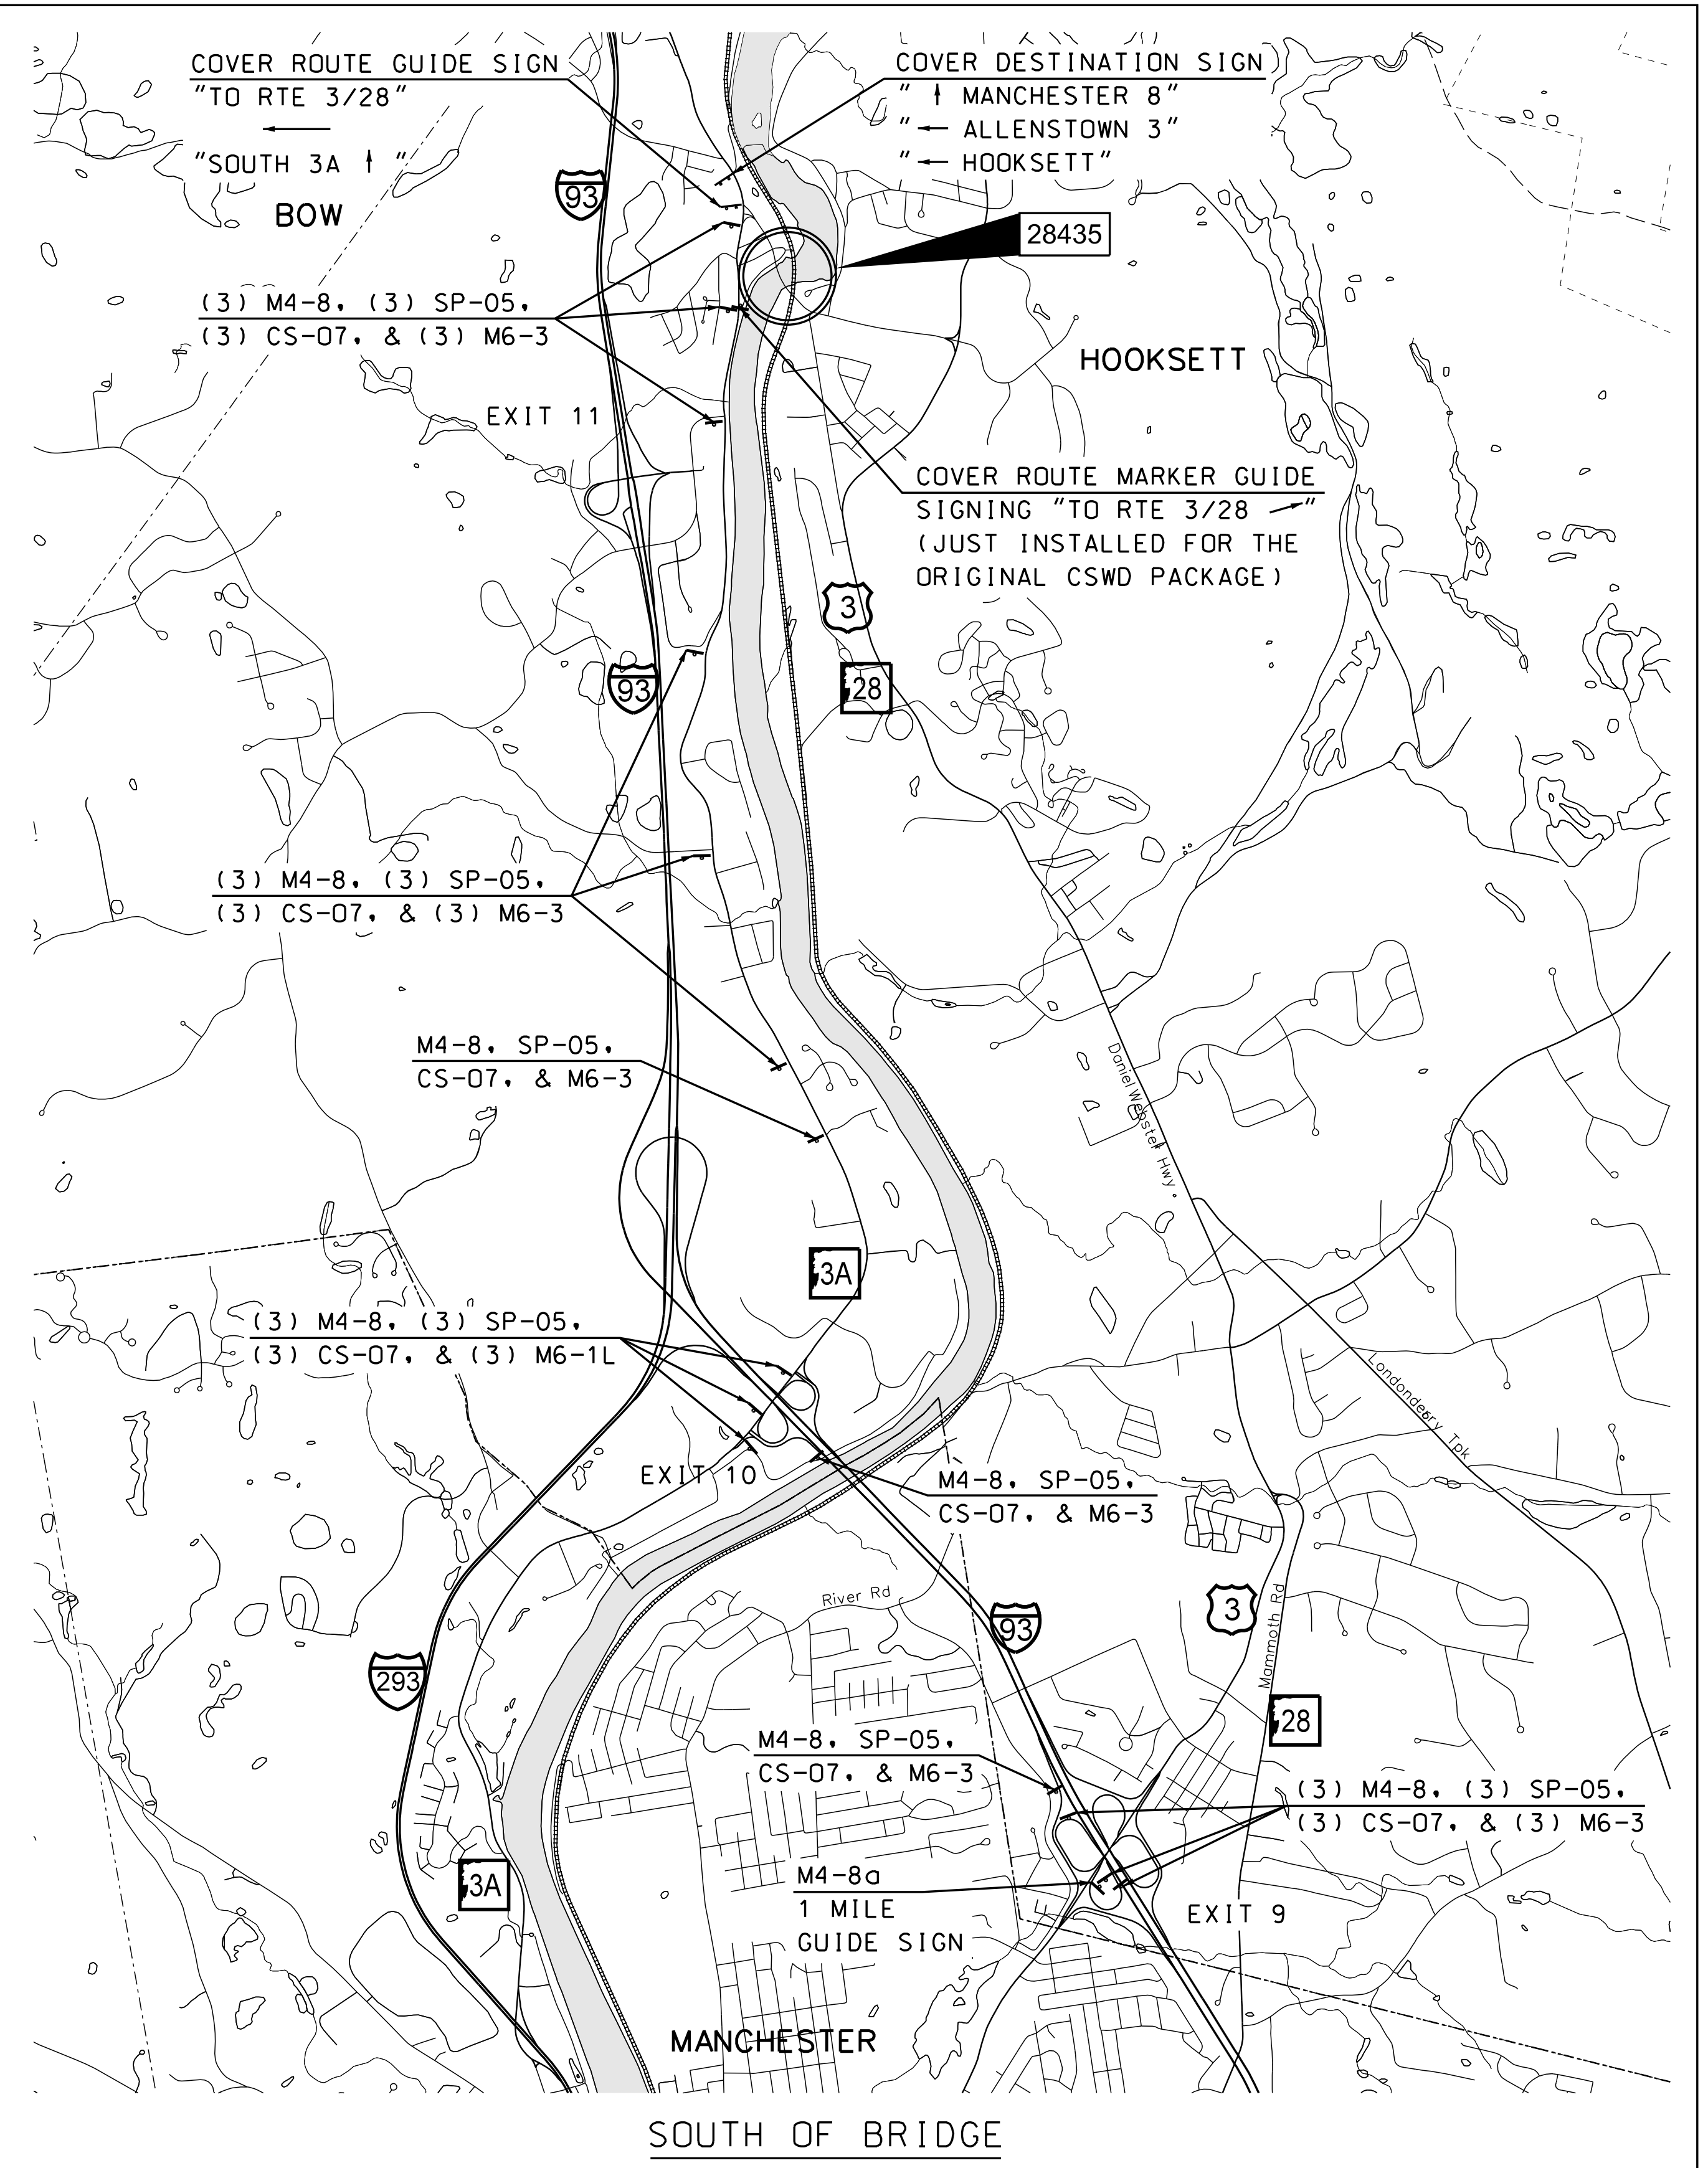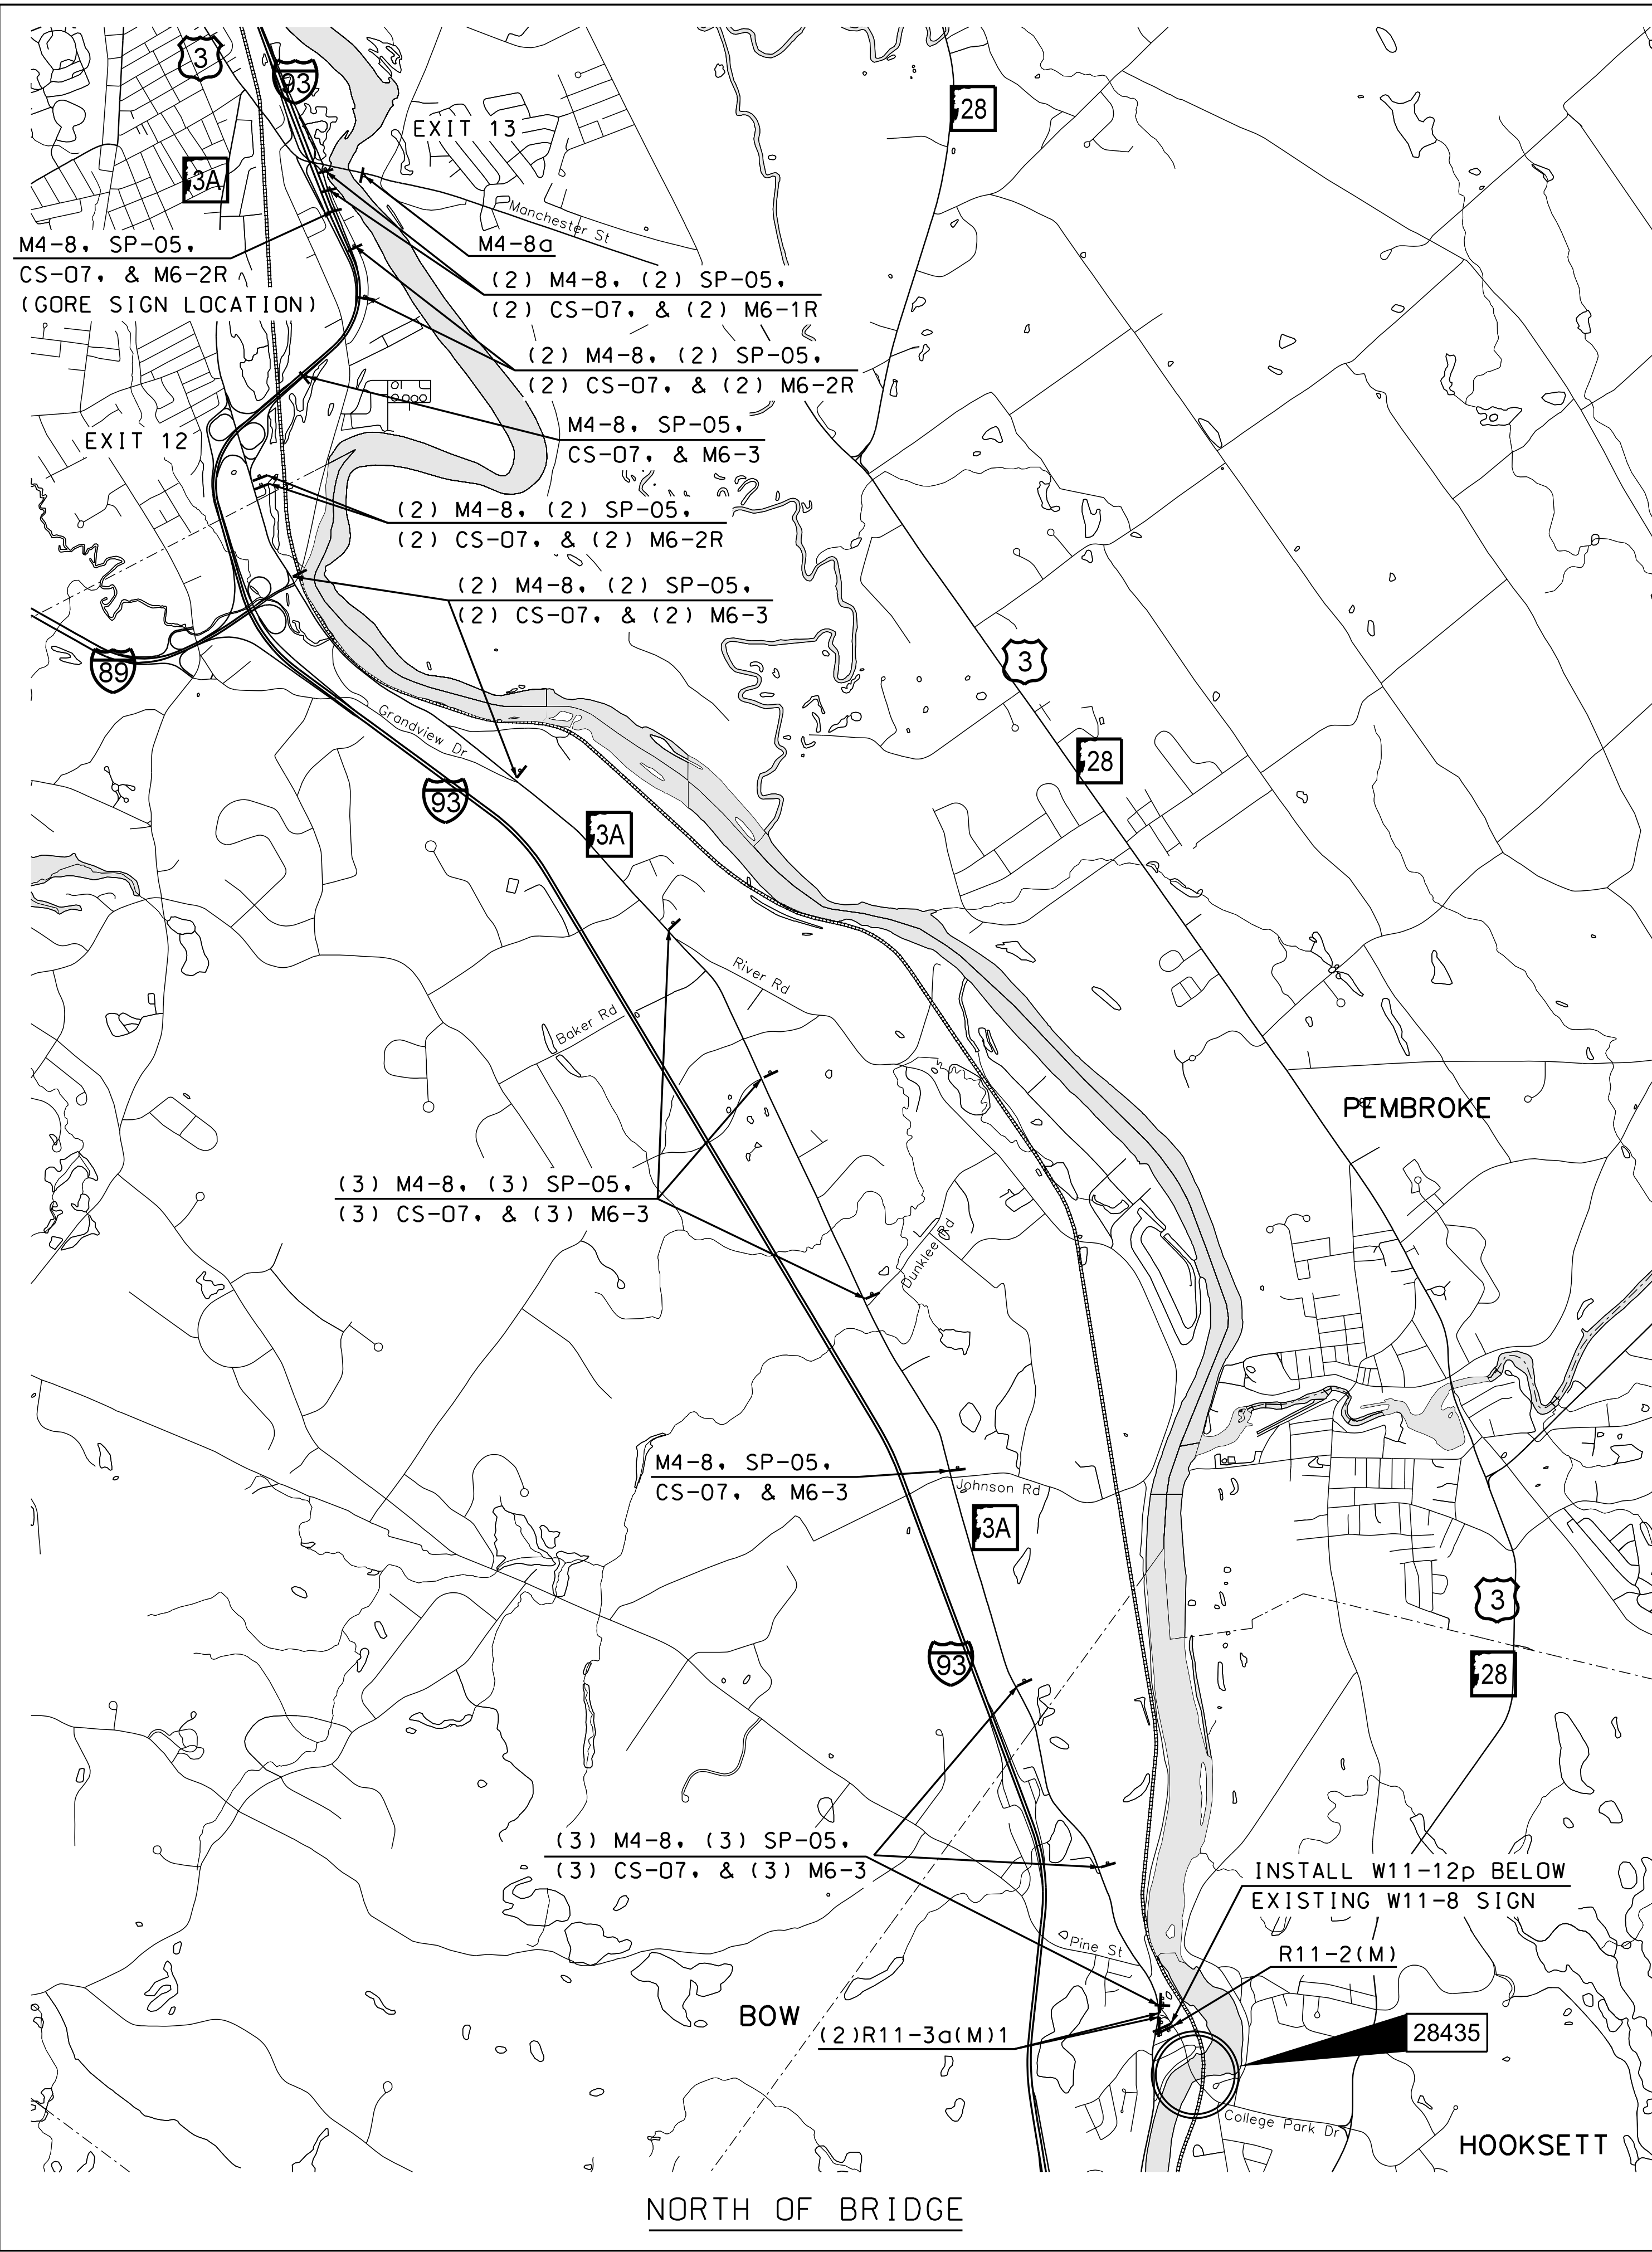

STATE OF NEW HAMPSHIRE					
DEPARTMENT OF TRANSPORTATION * BUREAU OF BRIDGE DESIGN					
TOWN	HOOKSETT	BRIDGE NO.	080/148	STATE PROJECT	28435
LOCATION MAIN STREET over B&M RR, MERRIMACK RIVER, & RIVERSIDE STREET					
CONTINGENCY PLAN DETOUR SIGNS					BRIDGE SHEET
					XX OF 18
DESIGNED	NHDOT	9/14	CHECKED	XXX	XX/XX
DRAWN	SMG	9/14	CHECKED	JAT	9/14
QUANTITIES	XXX	XX/XX	CHECKED	XXX	XX/XX
ISSUE DATE	FEDERAL PROJECT NO.		SHEET NO.		TOTAL SHEETS
REV. DATE	-----		36		42

SUBDIRECTORY	DGN LOCATOR	SHEET SCALE
BRC\	28435 ContiDetour	AS NOTED

ITEM #	IDENTIF	SIGN SIZE		TEXT	TEXT DIMENSIONS			SHIELD SIZE (inch)	ARROW (inch)	NUMERAL (inch)	# SIGNS REQ'D	SIGN AREA (SQ. FT)		POSTS PER SIGN					REMARKS		
		WIDTH (inch)	HEIGHT (inch)		LETTER HEIGHT (inch)							NOM AREA	TOTAL AREA	BREAKAWAY	STEEL I-BEAM	CONCRETE BASE	4" O.D. ALUMINUM	U-CHANNEL GALV			
					UC	LC	CAPS														
615.03	W3-3	30	30								1	6.25	6.25						1	RED, GREEN, BLACK / YELLOW	
615.03	W11-2	30	30								4	6.25	25.00						1	BLACK / YELLOW	
615.06	W16-7pL*	24	12								2	2.00	4.00							* Mount below W11-2 BLACK / YELLOW	
615.06	W16-9p*	24	12								2	2.00	4.00							* Mount below W11-2 BLACK / YELLOW	








GENERAL NOTES

- REFER TO THE 2010 STANDARD SPECIFICATIONS FOR ROAD AND BRIDGE CONSTRUCTION PUBLISHED BY THE NHDOT.
- NOTE NEW REFLECTIVITY REQUIREMENT SIN THE 2010 STANDARD SPECIFICATIONS FOR ROAD AND BRIDGE CONSTRUCTION SECTION 718 PUBLISHED BY THE NHDOT.
- REFER TO THE 2010 STANDARD PLANS FOR ROAD CONSTRUCTION AS PUBLISHED BY THE NHDOT FOR EXACT DETAILS OF PERMANENT SIGNING STANDARDS AND NHDOT SPECIFIC SIGNS.
- REFER TO THE LATEST EDITION OF THE STANDARD HIGHWAY SIGNS MANUAL AS PUBLISHED BY THE USDOT-FHWA FOR EXACT DETAILS OF BORDERS, ETC.

STATE OF NEW HAMPSHIRE
DEPARTMENT OF TRANSPORTATION BUREAU OF TRAFFIC

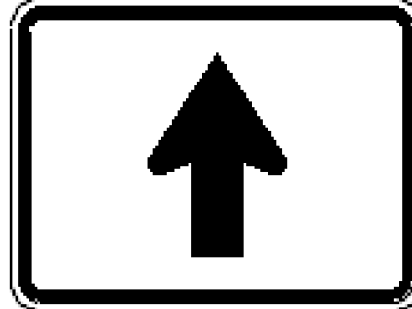SIGN TEXT LAYOUT

SUBDIRECTORY	DGN LOCATOR	EXCEL FILE NAME	STATE PROJECT NO.	FEDERAL PROJECT NO.	SHEET NO.	TOTAL SHEETS
BRC/SIGN	28435 PermSign	S:\ProjectDevelopment\Forms\Project\sgntxt-1.xls	28435	-----	37	42

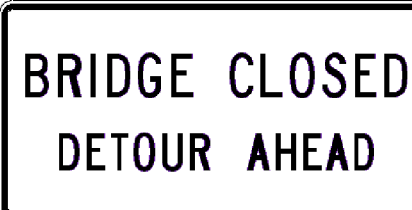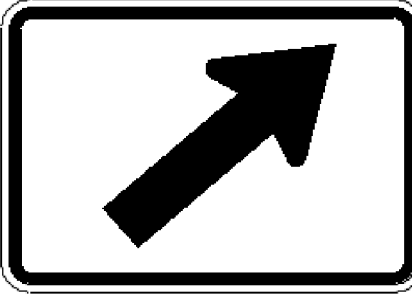ITEM #	IDENT#	SIGN SIZE		TEXT	TEXT DIMENSIONS			SHIELD SIZE (inch)	ARROW (inch)	NUMERAL (inch)	# SIGNS REQ'D	SIGN AREA (SQ. FT.)		POSTS PER SIGN					REMARKS	ITEM #	IDENT#	SIGN SIZE		TEXT	TEXT DIMENSIONS			SHIELD SIZE (inch)	ARROW (inch)	NUMERAL (inch)	# SIGNS REQ'D	SIGN AREA (SQ. FT.)		POSTS PER SIGN					REMARKS
		WIDTH (inch)	HEIGHT (inch)		LETTER HEIGHT (inch)	NOM AREA	TOTAL AREA					BREAKAWAY	STEEL I-BEAM	CONCRETE BASE	4" OD ALUMINUM	U-CHANNEL-GALV.	WIDTH (inch)	HEIGHT (inch)				LETTER HEIGHT (inch)	NOM AREA		TOTAL AREA	BREAKAWAY	STEEL I-BEAM					CONCRETE BASE	4" OD ALUMINUM	U-CHANNEL-GALV.					
		UC	LC		CAPS												UC	LC				CAPS																	
619.1	M6-3	21	15						7x9.8		22	2.19	48.13																										Mount in back of CS-03 BLACK / WHITE
619.1	SP-05	24	24		6C*	6C*					32	4.00	128.00																									Mount in back of CS-03 BLACK / WHITE	
619.1	CS-07	24	12								32	2.00	64.00																										
619.1	CCS-01	60	30								3	12.50	37.50																										
619.1	CCS-02	60	30								2	12.50	25.00																										
619.1	CCS-03	60	30								3	12.50	37.50																										
619.1	M6-2R	21	15						7x14.6 at 42°		5	2.19	10.94																										
GENERAL NOTES																				<p>1. REFER TO THE 2010 STANDARD SPECIFICATIONS FOR ROAD AND BRIDGE CONSTRUCTION PUBLISHED BY THE NHDOT.</p> <p>2. NOTE NEW REFLECTIVITY REQUIREMENTS IN THE 2010 STANDARD SPECIFICATIONS FOR ROAD AND BRIDGE CONSTRUCTION SECTION 718 PUBLISHED BY THE NHDOT.</p> <p>3. REFER TO THE 2010 STANDARD PLANS FOR ROAD CONSTRUCTION AS PUBLISHED BY THE NHDOT FOR EXACT DETAILS OF PERMANENT SIGNING STANDARDS AND NHDOT SPECIFIC SIGNS.</p> <p>4. REFER TO THE LATEST EDITION OF THE STANDARD HIGHWAY SIGNS MANUAL AS PUBLISHED BY THE USDOT-FHWA FOR EXACT DETAILS OF BORDERS, ETC.</p>																			

STATE OF NEW HAMPSHIRE
DEPARTMENT OF TRANSPORTATION BUREAU OF HIGHWAY DESIGN
CONST. SIGN TEXT SHEET
(CONTINGENCY PLAN)

SUBDIRECTORY	.DGN LOCATOR	EXCEL FILE NAME	STATE PROJECT NO.	FEDERAL PROJECT NO.	SHEET NO.	TOTAL SHEETS
BRC/SIGN	28435 ContinSign	S:\ProjectDevelopment\Forms\Project\sgntxt-1.xls	28435	-----	42	42