



# Examples of Weathertightness Remediation Drawings - Detail Design


**Purpose:** These example drawing extracts help convey the levels of presentation and the standard of documentation required by the Ministry for Weathertightness Remediation projects. Reference should also be made to WRP Guide # 2 which lists the deliverables required at the **Detail Design** stage. They are intended to aid architects and designers to understand the expectations of the WRP Panel, in order to aim a smooth review process.

Please note, the drawing images in this guide are examples only and do not represent standardised or Ministry approved details. It is also important to note that the levels of documentation need to be appropriate for the scale and complexity of each project. The drawing extracts have been sourced from several architects and designers across a variety of weathertightness remediation projects at school sites. The images have also been adjusted to suit the format of this example set.

This example set and other key documents such as the Design Report template, Site Specific QA Plan template and the Weathertightness Remediation and Regulatory Strategy are available under the following file-path:  
<https://www.education.govt.nz/school/property-and-transport/maintenance-repairs-security/weathertightness-remediation/>

<b>Contents</b>	Sheet 1
3D Images - Existing and Proposed Works	Sheet 2
3D Images - Location of Key Junctions	Sheet 3
Floor Plan - Demolition Works	Sheet 4
Floor Plan - Proposed Works	Sheet 5
Elevations - Proposed Works	Sheet 6
Elevations - Existing & Proposed Works	Sheet 7
Roof Plan - Proposed Works	Sheet 8
Sections - Proposed Works	Sheet 9
Details	Sheet 10
Details	Sheet 11
Details	Sheet 12

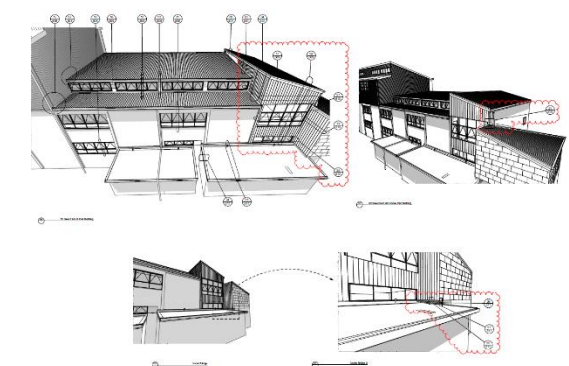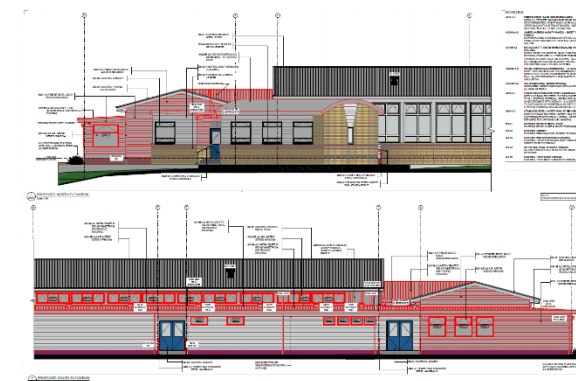

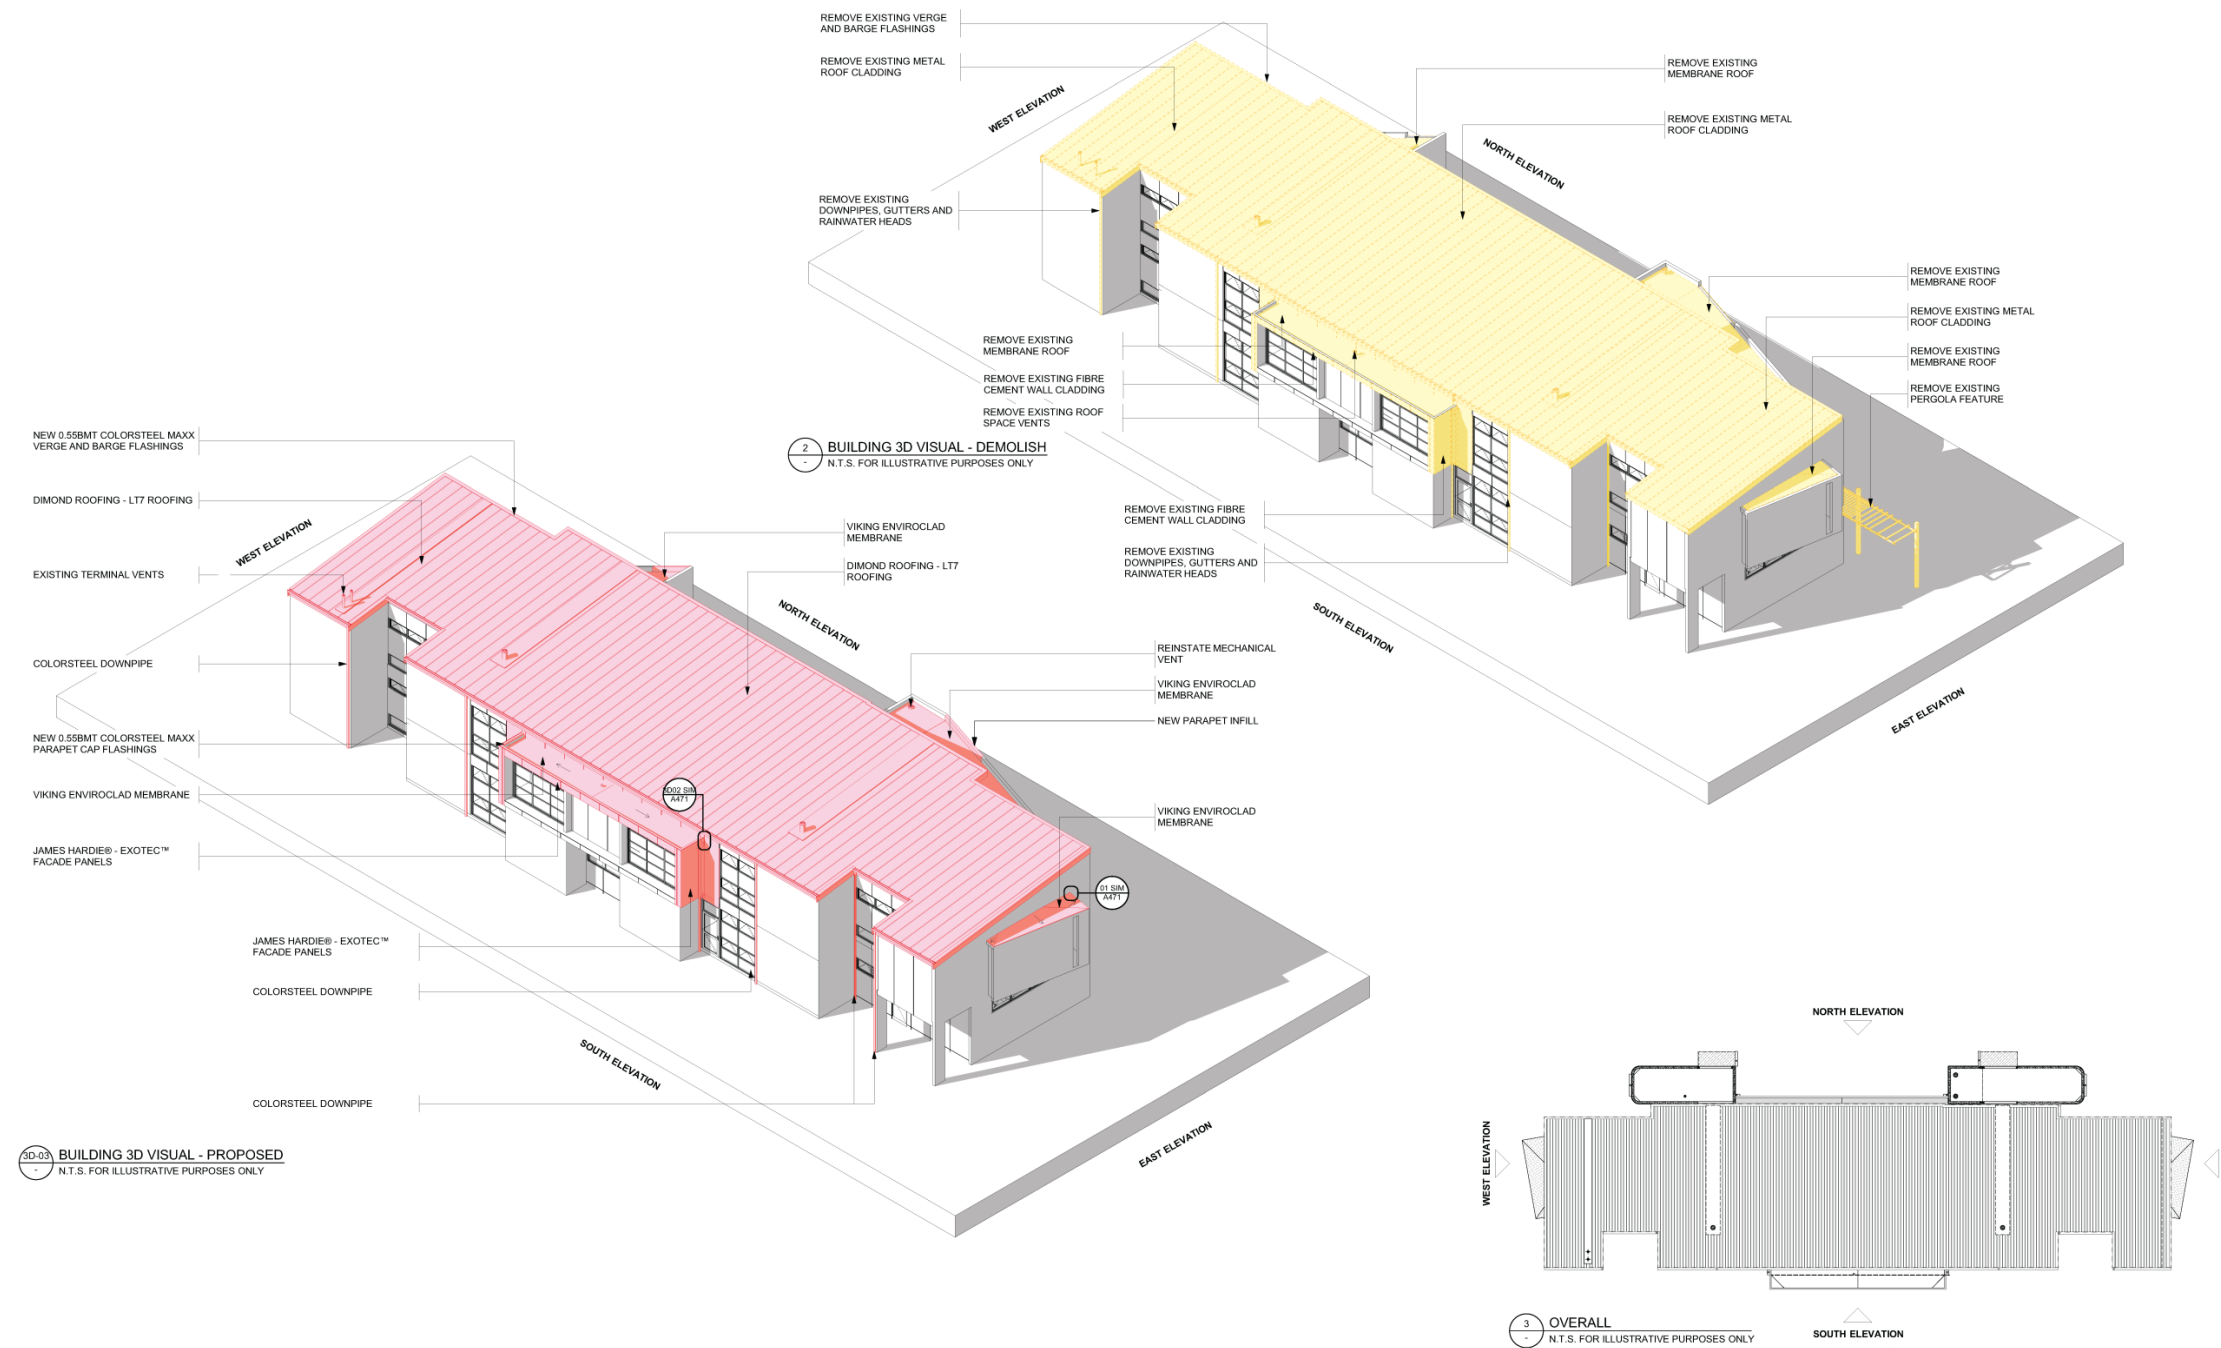

**Notes:**

- The example images on this sheet are provided for the sole purpose of conveying the levels of presentation and standard of documentation required by the Ministry for Weathertightness Remediation projects


**Commentary:**

- 3D images of the existing and proposed building arrangement help to clearly convey the proposed changes and scope of work to the existing building
- 3D images with annotations can also be very effective for communicating the intended scope
- In this example, both the existing and as proposed 3D images are provided on the same sheet. This is an excellent way of clearly identifying the proposed scope of works
- The upper image with yellow shading shows the cladding and roofing areas to be removed. Correspondingly, the lower image shows the as proposed arrangement with red shading for the new cladding and roofing systems
- Sufficient annotations with arrows are also used to clearly define the high-level scope of work
- Whilst not a compulsory requirement, 3D views are very useful in aiding the reviewer to understand buildings which have complex roof and/or envelope forms

## Drawing Example

## 3D Images – Location of Key Junctions

## Sheet 3

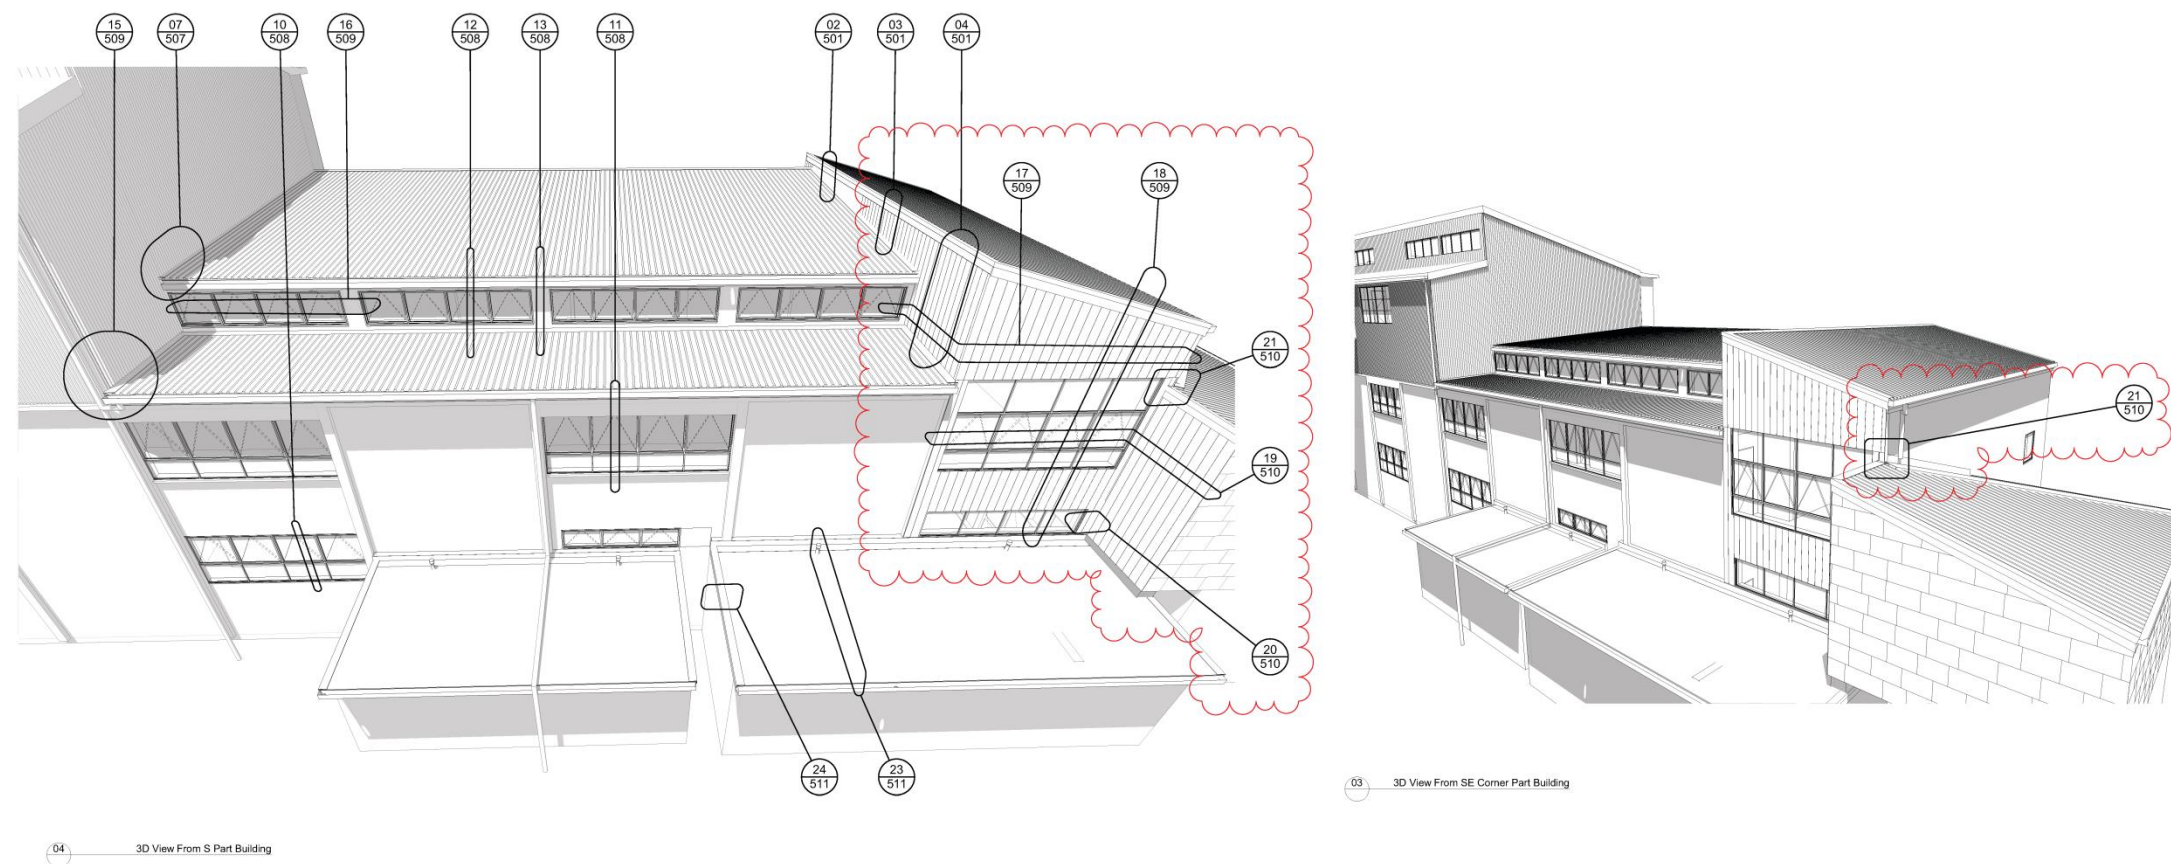

### Notes:


- The example images on this sheet are provided for the sole purpose of conveying the levels of presentation and standard of documentation required by the Ministry for Weathertightness Remediation projects

### Commentary:

- 3D images of the existing and proposed building arrangement help to clearly convey the proposed changes and scope of work to the existing building
- In this example, the images are used to cross-reference detailed drawings, as well as showing difficult junctions in three dimension
- Referencing 3D construction details in this way is a good way to demonstrate to the Reviewer that all complex 3D junctions have been considered and detailed



05 Under Bridge

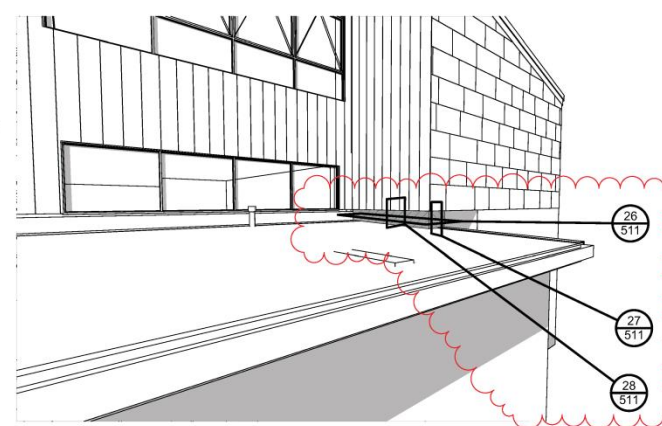


05 Under Bridge 2

# Drawing Example

# Floor Plan – Demolition Works

# Sheet 4

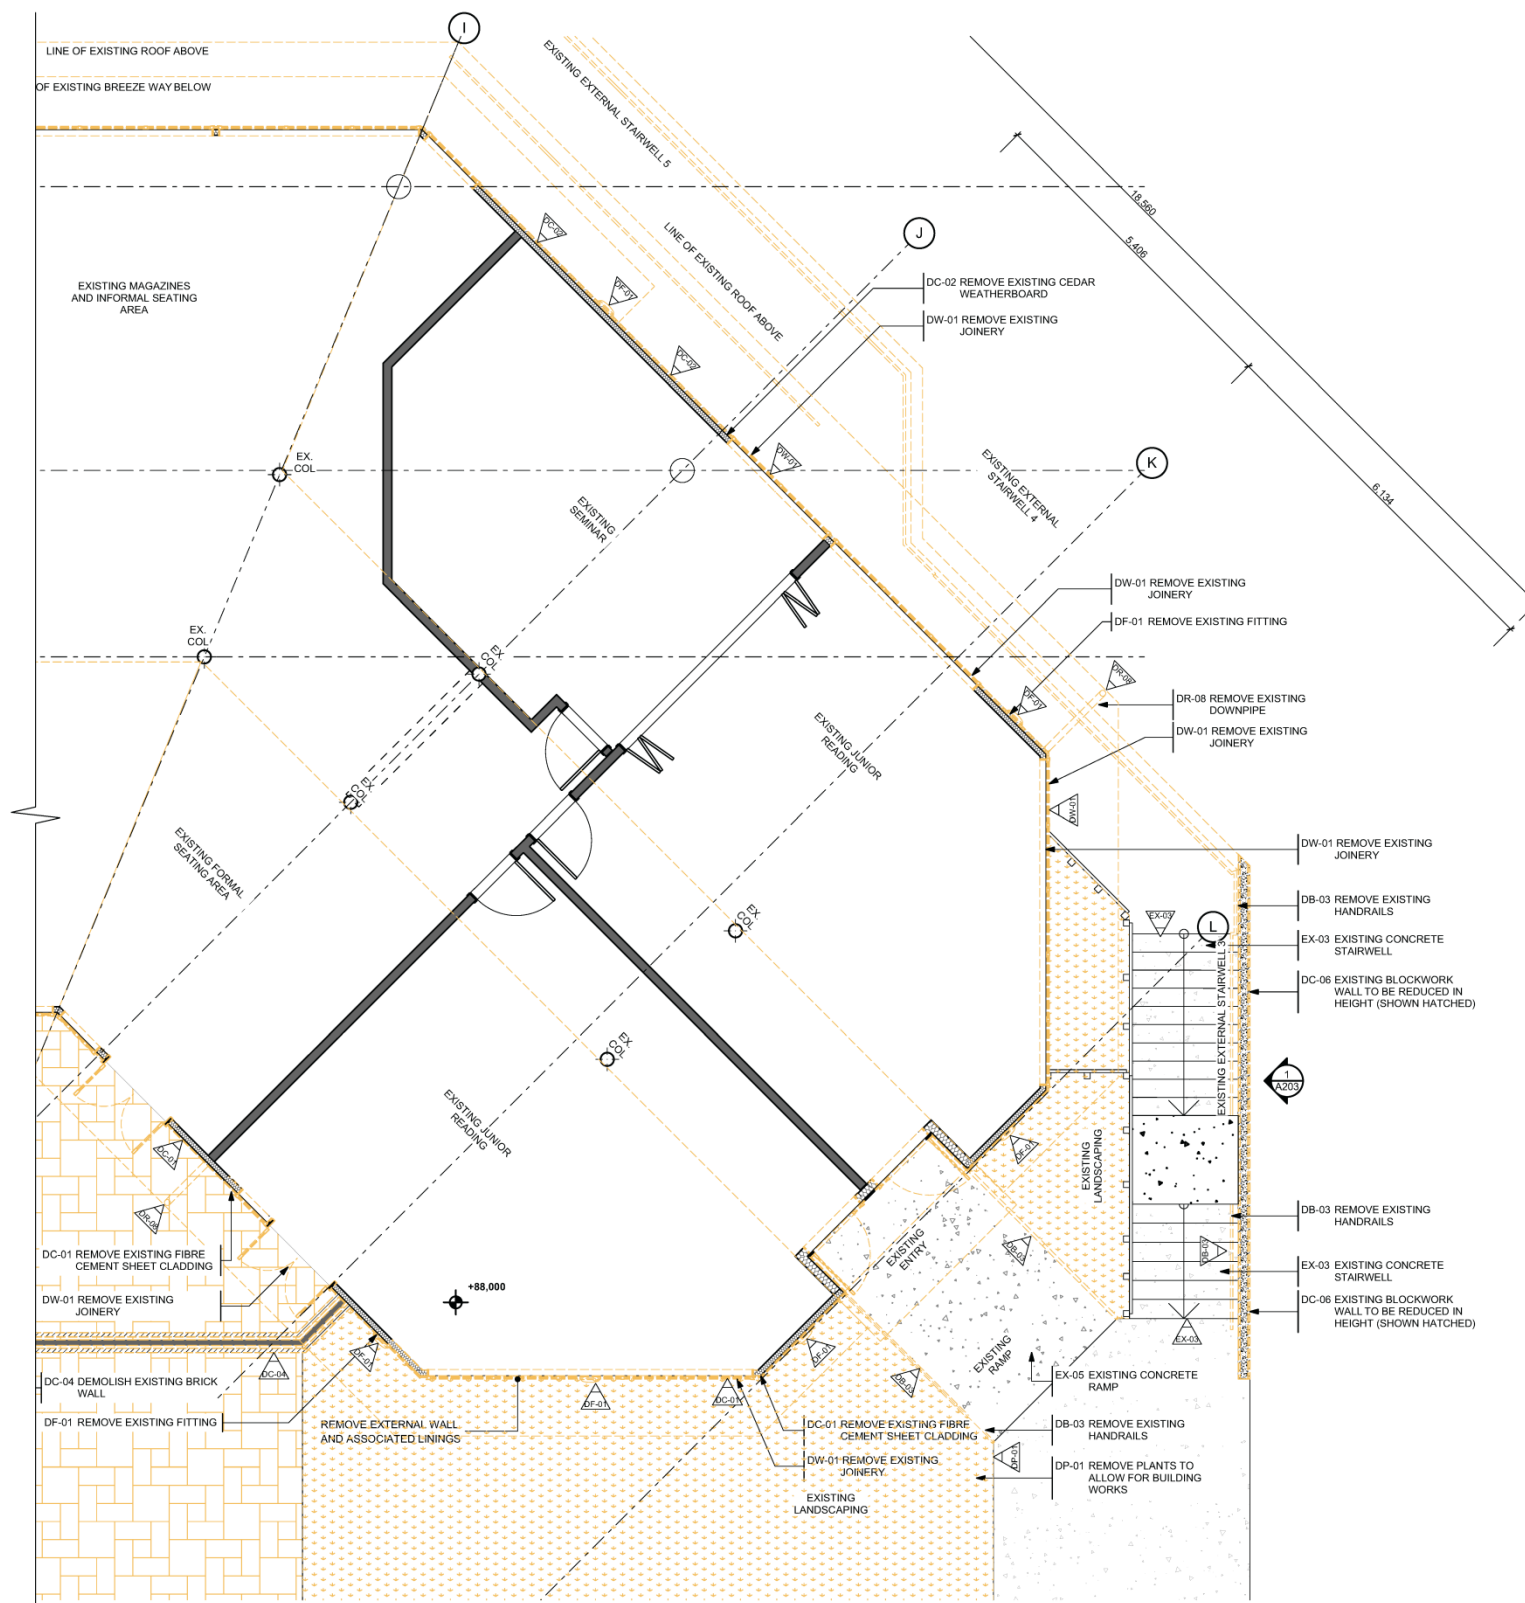

### EXISTING LEGEND

- WALL FINISH/CONSTRUCTION MARKER. REFER TO KEYNOTE LEGEND
- REMOVE AND DISCARD EXISTING BAYWINDOW STRUCTURE AND DEMOLISH CURVED WALL. CUT BACK CONCRETE SLAB TO FORM NEW FLOOR EDGE
- EXISTING LANDSCAPING TO BE REMOVED TO ALLOW FOR CONSTRUCTION WORKS AND REMOVE ALL TANKING TO SOUTH EAST RETAINING WALL
- EXISTING PAVING TO BE REMOVED TO ALLOW FOR CONSTRUCTION WORKS. AREA TO HAVE NEW LANDSCAPING

### NOTES

- 1 ALL EXISTING CLADDING IS TO BE REMOVED AND DISCARDED. REFER ELEVATIONS FOR EXTENT OF EXISTING EXTERIOR CLADDING.
- 2 ALL EXPOSED TIMBER FRAMING IS TO BE INSPECTED FOR DECAY. REMOVE DECAYED TIMBER AND COAT REMAINING TIMBER WITH PROTIM FRAMESAVER TO THE EXTENT DIRECTED BY THE TIMBER REMEDIATION SPECIALIST.
- 3 ALL EXTERNAL WINDOW JOINERY IS TO BE REMOVED AND DISCARDED.
- 4 ALL INTERNAL WALL LININGS ARE TO REMAIN UNLESS OTHERWISE INDICATED OR INSTRUCTED BY THE ENGINEER TO THE CONTRACT.
- 5 ALL EXISTING DOWN PIPES ARE TO BE REMOVED & DISCARDED.
- 6 CHECK ALL DIMENSIONS ON SITE BEFORE COMMENCING WORK
- 7 ALLOW TO PROTECT EXISTING INTERNAL LININGS, FITTINGS AND FIXTURES. IF NECESSARY CAREFULLY REMOVE FITTINGS DURING THE WORK AND REINSTATE UPON COMPLETION.
- 8 THE CONTRACTOR SHALL COMPLY WITH THE RECOMMENDATIONS OF NZS6830P:1999 WHERE THEY ARE APPLICABLE TO THE WORKS.
- 9 ALL DEMOLITION SHALL BE CARRIED OUT IN A CAREFUL MANNER AND IN ACCORDANCE WITH THE 'HEALTH AND SAFETY AT WORK ACT 2015'.
- 10 ALL DEMOLITION WORK TO BE CARRIED OUT IN ACCORDANCE WITH NZBC, WORKSAFE AND LOCAL AUTHORITIES GUIDELINES AND REQUIREMENTS.

### KEYNOTES

- DB-03 REMOVE EXISTING HANDRAILS**  
REMOVE AND DISCARD OF ALL EXISTING EXTERNAL STAIRWELL HANDRAILS
- DC-01 REMOVE EXISTING FIBRE CEMENT SHEET CLADDING**  
REMOVE AND DISCARD EXISTING FIBRE CEMENT SHEET CLADDING, INCLUDING BUILDING WRAP AND FIXINGS
- DC-02 REMOVE EXISTING CEDAR WEATHERBOARD**  
REMOVE AND DISCARD EXISTING CEDAR WEATHERBOARD CLADDING, INCLUDING BUILDING WRAP AND FIXINGS
- DC-03 REMOVE BRICK VENEER CLADDING**  
REMOVE AND DISCARD EXISTING BRICK VENEER CLADDING, INCLUDING BUILDING WRAP AND FIXINGS
- DC-04 DEMOLISH EXISTING BRICK WALL**  
DEMOLISH EXISTING BRICK WALL DOWN TO GROUND LEVEL
- DC-06 EXISTING BLOCKWORK WALL TO BE REDUCED IN HEIGHT (SHOWN HATCHED)**  
EXISTING BLOCKWORK WALL AT EXTERNAL STAIRWELLS TO BE REDUCED IN HEIGHT TO IMPROVE PASSIVE SURVEILLANCE AND SAFETY IN DESIGN (SHOWN HATCHED)
- DF-01 REMOVE EXISTING FITTING**  
REMOVE EXISTING EXTERNAL LIGHT FITTING AND REPLACE WITH NEW. REFER TO ELECTRICAL DRAWINGS FOR FURTHER INFORMATION.
- DP-01 REMOVE PLANTS TO ALLOW FOR BUILDING WORKS**  
REMOVE PLANTS OR PLANTER TO ALLOW FOR CLADDING INSTALLATION. CUT BACK ALL GARDENS FROM WALLS TO ALLOW FOR NEW MOWING STRIP
- DR-08 REMOVE EXISTING DOWNPIPE**  
REMOVE AND DISCARD DOWNPIPE AND FIXINGS
- DW-01 REMOVE EXISTING JOINERY**  
REMOVED AND DISCARDED EXISTING ALUMINIUM WINDOW/DOOR JOINERY
- EX-03 EXISTING CONCRETE STAIRWELL TO REMAIN**
- EX-05 EXISTING CONCRETE RAMP**  
EXTERNAL CONCRETE ACCESSIBLE RAMP TO REMAIN. REMOVE ALL EXISTING HANDRAILS AND ALLOW FOR NEW POWDERCOATED ALUMINIUM HANDRAILS AND UPSTANDS TO COMPLY WITH NZS4121

NOTE:  
THIS DRAWING MUST BE READ IN COLOUR

### Notes:

- The example images on this sheet are provided for the sole purpose of conveying the levels of presentation and standard of documentation required by the Ministry for Weathertightness Remediation projects

### Commentary:


- Ensure floor plans or part-floor plans are provided at 1:50 scale for an A1 sheet or 1:100 for an A3 sheet. In this example, due to the size of the building, the plans have been split into three zones, in order to convey the required information at a legible scale
- Ensure that the drawing clearly delineates between existing and proposed layouts
- Colour is very useful for differentiating between the existing building elements to be demolished or the new construction
- In this example, coloured dashed lines are used to indicate existing elements / components to be removed, including external paving
- Dimensions and section references are important for relevant parts of the building where remediation works are being proposed
- If using keynotes referenced to a specification document, these should be accompanied by a detailed legend on the same drawing sheet for ease of reference for the Reviewer



# Drawing Example

# Elevations – Proposed Works


# Sheet 6

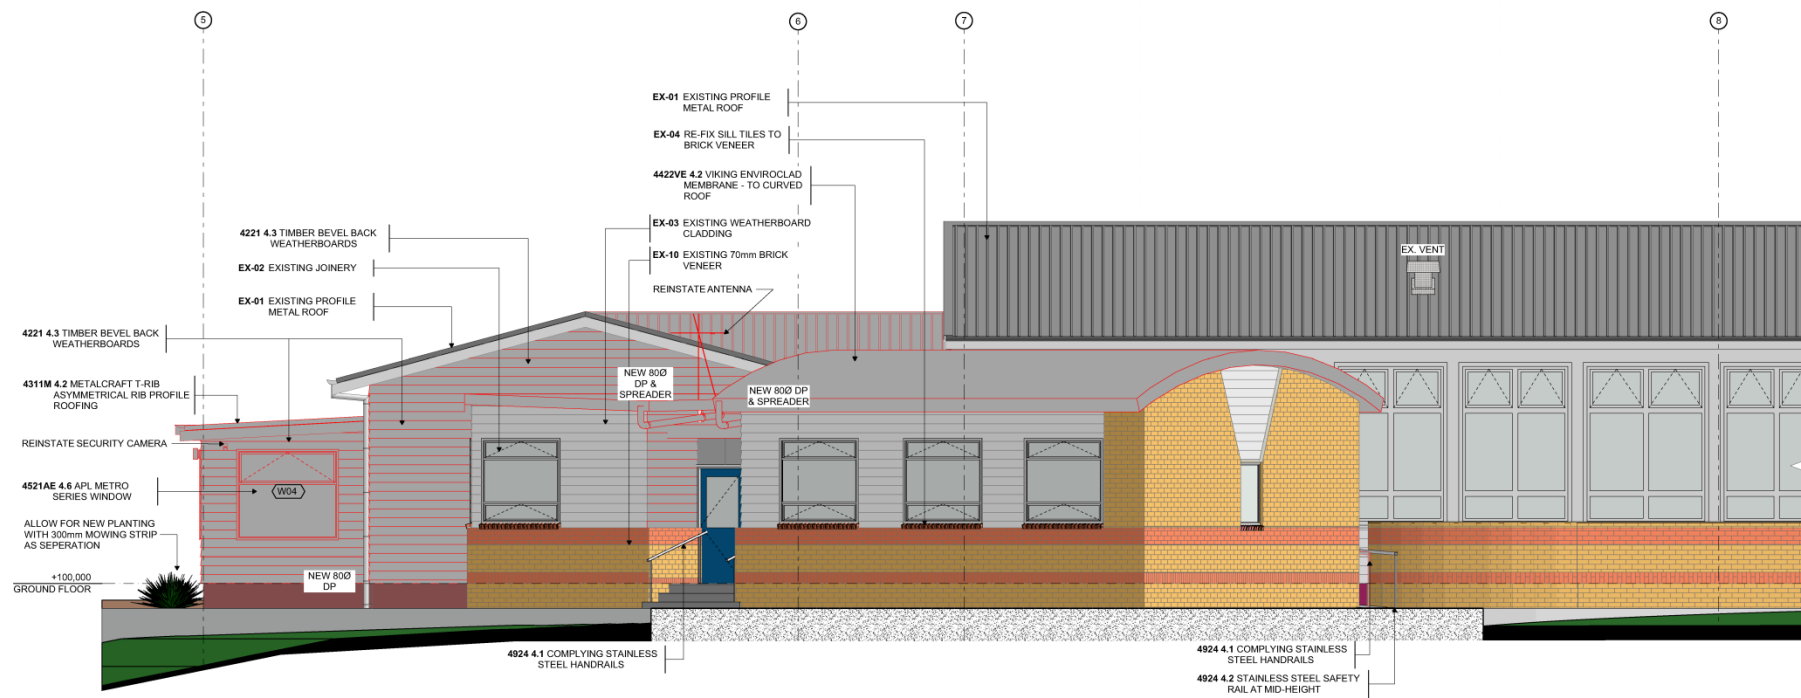

- KEYNOTES**
- 4221 4.3 **TIMBER BEVEL BACK WEATHERBOARDS**  
NEW H3.1 TREATED RADIATA PINE BEVEL-BACK TIMBER WEATHERBOARDS, PAINT FINISH OVER 45x20mm H3.1 VERTICAL CAVITY SYSTEM AT 600 CRS. WEATHERBOARD SIZE AND PROFILE TO MATCH EXISTING
  - 4231HA 4.2 **JAMES HARDIE® AXON™ PANELS - SHEET CLADDING PANELS**  
NEW 9mm JAMES HARDIE® AXON PANEL CLADDING, PAINT FINISH OVER 45x20mm H3.1 VERTICAL CAVITY SYSTEM AT 300 CRS
  - 4311M 4.2 **METALCRAFT T-RIB ASYMMETRICAL RIB PROFILE ROOFING**  
NEW 0.55BMT COLORSTEEL MAXX T-RIB PROFILED METAL ROOFING OVER NEW H1.2 TREATED TIMBER ROOF FRAMING TO NEW FALLS (AS SHOWN). ALLOW FOR NEW R4.0 MAMMOTH CEILING BLANKET. INSTALL NEW 0.55BMT COLORSTEEL MAXX 125 BOX GUTTERS.
  - 4422VE 4.2 **VIKING ENVIROCLAD MEMBRANE - TO CURVED ROOF**  
NEW 1.5mm ENVIROCLAD TPO MEMBRANE ROOFING ON NEW 2x12mm H3.2 FLY SUBSTRATE TO EXISTING CURVED FALL. ALLOW FOR NEW R1.8 PINK BATT'S CLASSIC CEILING INSULATION
  - 4521AE 4.6 **APL RESIDENTIAL SERIES WINDOW**  
NEW METRO SERIES WINDOWS WITH ANODIZED ALUMINIUM FINISH
  - 4924 4.1 **COMPLYING STAINLESS STEEL HANDRAILS**  
NEW 316 STAINLESS STEEL FLOOR MOUNTED HANDRAILS TO ALL EXISTING EXTERNAL STAIRS AT BUILDING ENTRIES, IN ACCORDANCE WITH NZS4121. ALLOW FOR HANDRAILS TO BOTH SIDES OF STAIRWELLS EXCEPT FOR STAIRWELL 5, WHERE HANDRAIL WILL BE MOUNTED TO ONE SIDE ONLY
  - 4924 4.2 **STAINLESS STEEL SAFETY RAIL AT MID-HEIGHT**  
NEW 316 STAINLESS STEEL SAFETY RAIL TO RAMP, IN ACCORDANCE WITH NZS4121. INSTALL AT MID-HEIGHT BETWEEN THE UPSTAND AND HANDRAIL
  - EX-01 **EXISTING PROFILE METAL ROOF**  
EXISTING PROFILE METAL ROOF TO REMAIN
  - EX-02 **EXISTING JOINERY**  
EXISTING WINDOW/DOOR JOINERY TO REMAIN
  - EX-03 **EXISTING WEATHERBOARD CLADDING**  
EXISTING 150x25 BEVELBACK WEATHERBOARD CLADDING DIRECT FIXED TO REMAIN
  - EX-04 **RE-FIX SILL TILES TO BRICK VENEER**  
ALLOW TO RE-FIX SILL TILES TO THE BRICK VENEER WINDOWS
  - EX-10 **EXISTING 70mm BRICK VENEER**  
EXISTING 70mm BRICK VENEER TO REMAIN

1 PROPOSED NORTH ELEVATION  
Scale 1:50

NOTE:  
THIS DRAWING MUST BE READ IN COLOUR

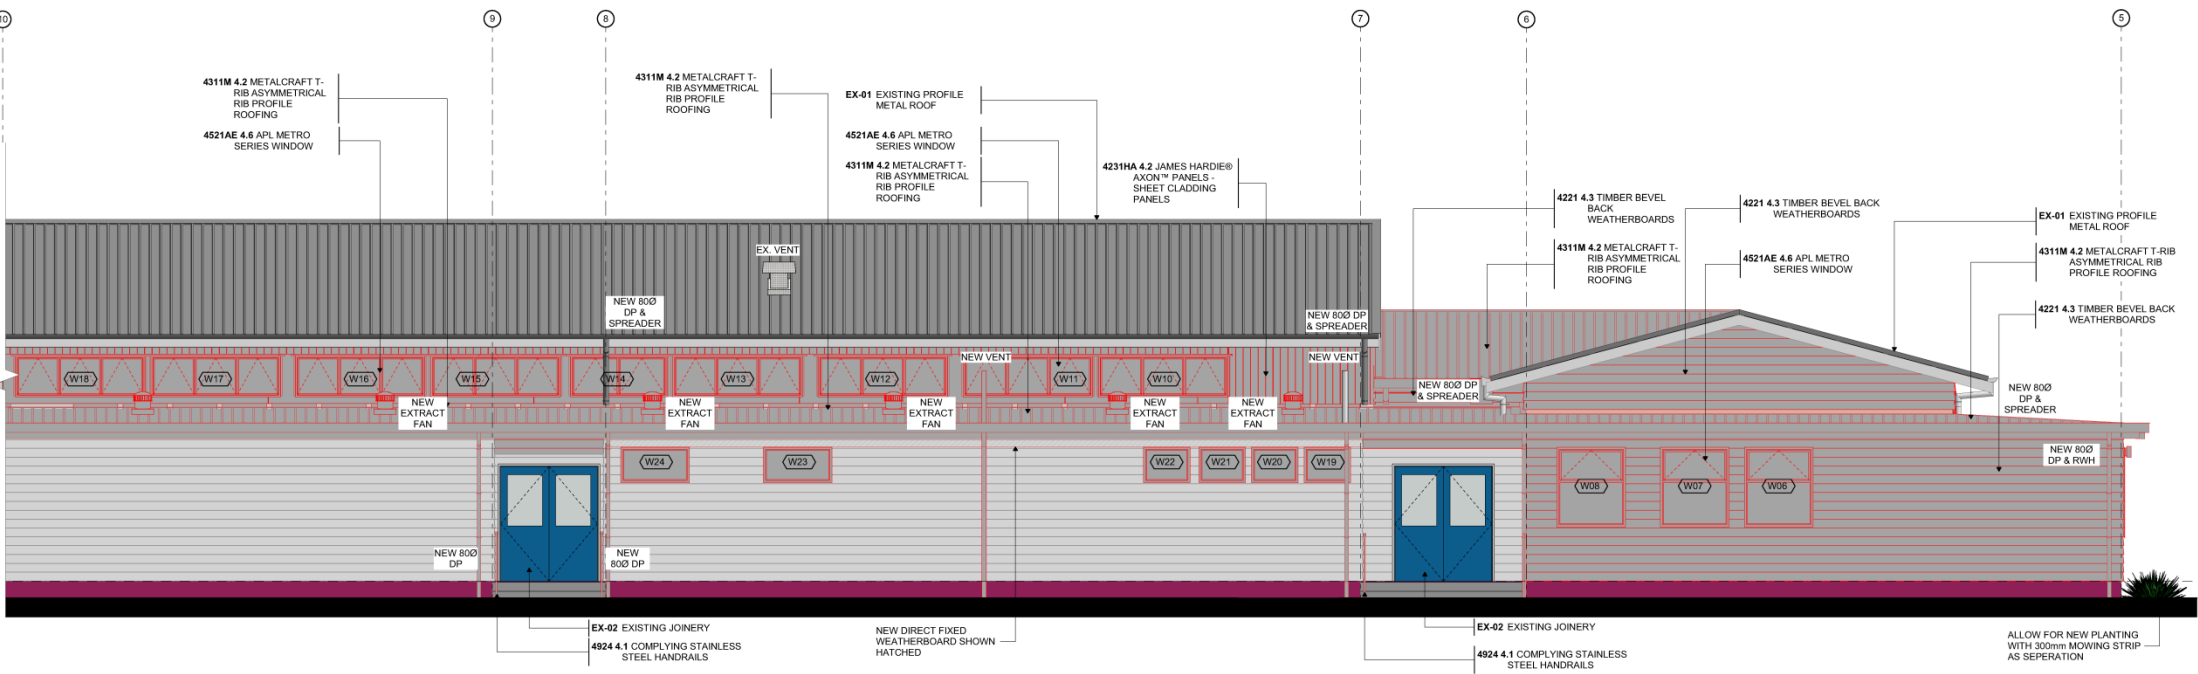


2 PROPOSED SOUTH ELEVATION  
Scale 1:50

- Notes:**
- The example images on this sheet are provided for the sole purpose of conveying the levels of presentation and standard of documentation required by the Ministry for Weathertightness Remediation projects
- Commentary:**
- Ensure floor plans or part-floor plans are provided at 1:50 scale for an A1 sheet or 1:100 for an A3 sheet
  - Ensure that the drawing clearly delineates between existing and proposed layouts
  - In this example, colour shading has been used to clearly show the differing elements and cladding systems
  - The elevations are titled by their orientation which helps to convey the location against the plan

# Drawing Example

# Elevations – Existing and Proposed Works

# Sheet 7

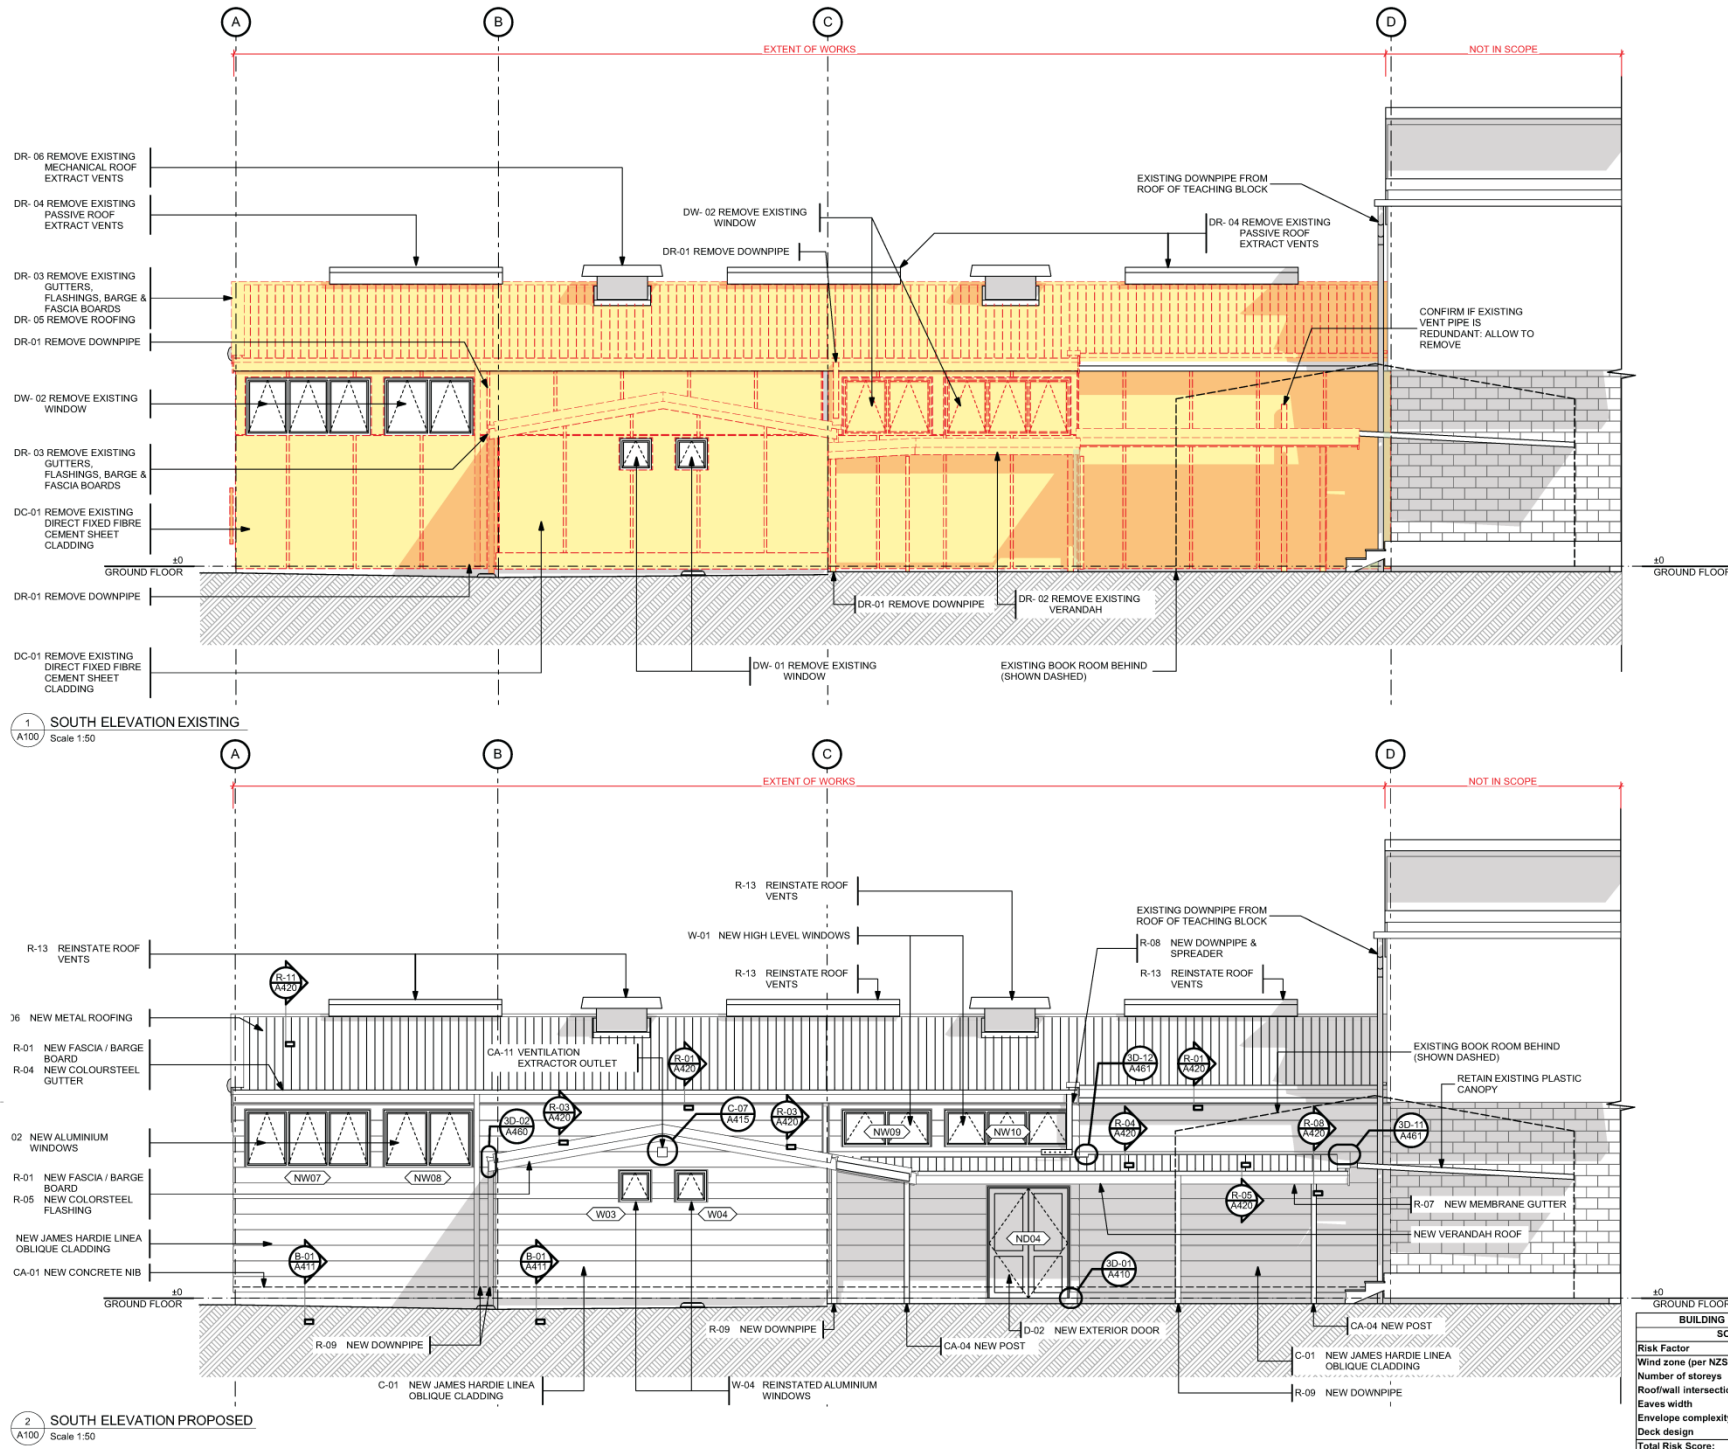

## NOTES

- REFER TO THE MAYNARD MARKS WEATHERTIGHTNESS REMEDIATION REPORT IN CONJUNCTION WITH DRAWINGS.
- ALL DEMOLITION SHALL BE CARRIED OUT IN A CAREFUL MANNER AND IN ACCORDANCE WITH THE "HEALTH AND SAFETY AT WORK (ASBESTOS) REGULATIONS 2016"
- NO REMOVAL OF FIBRE-CEMENT CLADDING IS TO BE UNDERTAKEN WITHOUT AN ASBESTOS REPORT BEING COMMISSIONED, AND THE RECOMMENDATIONS CONTAINED WITHIN THE REPORT ARE

## Keynotes

- C CLADDING**
- C-01 NEW JAMES HARDIE LINEA OBLIQUE CLADDING  
NEW JAMES HARDIE LINEA OBLIQUE CLADDING INSTALLED HORIZONTALLY ON 20mm CAVITY AND 4.5mm JAMES HARDIE RAB BOARD
- CA DETAILS**
- CA-01 NEW CONCRETE NIB  
NEW 25MPA CONCRETE NIB. HEIGHT TO BE DETERMINED BY AVAILABLE GROUND CLEARANCE FROM BOTTOM OF CLADDING (150mm TO PAVED GROUND). SCABBLE SURFACE OF EXISTING CONCRETE & APPLY SIKADUR 32 PRIOR TO POURING NIB
  - CA-04 NEW POST  
NEW 88x88 PROLAM PL8 H3.2 TREATED VERANDAH POST IN STAINLESS STEEL BRACKET. PAINT FINISH
  - CA-11 VENTILATION EXTRACTOR OUTLET  
NEW MANROSE DCT3636 STAINLESS STEEL WEATHERPROOF COWL.

- D DEMOLITION**
- DC-01 REMOVE EXISTING DIRECT FIXED FIBRE CEMENT SHEET CLADDING  
REMOVE AND DISCARD EXISTING DIRECT FIXED FIBRE CEMENT SHEET CLADDING, INCLUDING BUILDING WRAP AND FIXINGS
  - DR-01 REMOVE DOWNPIPE  
REMOVE EXISTING DOWNPIPE
  - DR-02 REMOVE EXISTING VERANDAH  
REMOVE EXISTING VERANDAH ROOFING, POSTS AND INTERNAL GUTTER
  - DR-03 REMOVE EXISTING GUTTERS, FLASHINGS, BARGE & FASCIA BOARDS  
REMOVE EXISTING GUTTERS, FLASHINGS, BARGE & FASCIA BOARDS. PREPARE FOR INSTALLATION OF NEW GUTTERS, FLASHINGS, BARGES & FLASHINGS
  - DR-04 REMOVE EXISTING PASSIVE ROOF EXTRACT VENTS  
CAREFULLY REMOVE EXISTING PASSIVE ROOF EXTRACT VENTS FOR REINSTATEMENT
  - DR-05 REMOVE ROOFING  
REMOVE EXISTING ROOFING SHEETS & UNDERLAY. PREPARE FOR NEW METAL ROOFING
  - DR-06 REMOVE EXISTING MECHANICAL ROOF EXTRACT VENTS  
CAREFULLY REMOVE EXISTING MECHANICAL ROOF EXTRACT VENTS FOR REINSTATEMENT
  - DW-01 REMOVE EXISTING WINDOW  
REMOVE EXISTING WINDOW FOR REFURBISHMENT WITH NEW FRAME TO SUIT PROPOSED CLADDING
  - DW-02 REMOVE EXISTING WINDOW  
REMOVE EXISTING WINDOW FOR REPLACEMENT. PREPARE OPENING FOR NEW WINDOW

- R ROOF**
- R-01 NEW FASCIA / BARGE BOARD  
NEW JAMES HARDIE AXENT FASCIA 230x16mm FIXED THROUGH 5mm EPDM WASHERS TO PROVIDE VENTILATION GAP
  - R-04 NEW COLOURSTEEL 175 BOX GUTTER  
COLORSTEEL ENDURA BOX 175 GUTTER WITH GALVANISED 32x3mm EXTERNAL FIXING BRACKETS AT 900 CRS. PRE-PAINT BRACKETS WITH EPOXY PAINT SYSTEM (RESENE ON LINE SPEC 236 2.2 ULT). FIX BRACKETS THROUGH 5mm NYLON SHIMS TO FORM CONTINUOUS OVERFLOW GAP
  - R-05 NEW COLOURSTEEL FLASHING  
NEW 0.558MT COLORSTEEL ENDURA FLASHINGS FOR TRIANGULAR ROOF. FLASHINGS TO BE NOTCHED AND SCRIBED INTO ROOFING PANS  
- BARGE FLASHING MIN LAP 2 CRESTS  
- RIDGE FLASHING MIN LAP 200mm  
- VERGE FLASHING MIN LAP 200mm
  - R-06 NEW METAL ROOFING  
NEW 0.558MT COLORSTEEL ENDURA TOUGH SECTION METAL ROOFING. LAID OVER NEW COVERTEK 405 ROOF UNDERLAY & GALV SUPPORT MESH. FIXINGS FOR LOW WIND ZONE
  - R-07 NEW 2 PIECE FASCIA / BARGE BOARD  
NEW TWO PIECE 230x16mm JAMES HARDIE AXENT FASCIA FIXED THROUGH 5mm EPDM WASHERS TO PROVIDE VENTILATION GAP
  - R-08 NEW DOWNPIPE & SPREADER  
NEW 100mm COLORSTEEL ENDURA DOWNPIPE AND uPVC SPREADER TO DISCHARGE ONTO LOWER ROOF
  - R-09 NEW DOWNPIPE  
NEW 100mm DIA COLORSTEEL ENDURA DOWNPIPE FIXED WITH MUNZING RINGS
  - R-13 REINSTATE ROOF VENTS  
REINSTATE/REFURBISHED ROOF EXTRACT VENTS

- W JOINERY**
- D-02 NEW EXTERIOR DOOR  
NEW NEW APL METRO SERIES MAGNUM DOORS WITH H3.1 19mm RADIATA PINE REVEALS AND ARCHITRAVES TO MATCH EXISTING. PAINT FINISH
  - W-01 NEW HIGH LEVEL WINDOWS  
NEW HIGH LEVEL WINDOWS TO EXISTING OPENING WITH HIGHER SILL HEIGHT TO ALLOW COMPLIANT APRON FLASHING TO ROOF. ALLOW FOR NEW MANUAL WINDERS
  - W-02 NEW ALUMINIUM WINDOWS  
NEW VANTAGE APL METRO SERIES ALUMINIUM WINDOW TO EXISTING OPENING. WITH H3.1 19mm RADIATA PINE REVEALS AND ARCHITRAVES TO MATCH EXISTING. PAINT FINISH.

## Notes:

- The example images on this sheet are provided for the sole purpose of conveying the levels of presentation and standard of documentation required by the Ministry for Weathertightness Remediation projects


## Commentary:

- Ensure floor plans or part-floor plans are provided at 1:50 scale for an A1 sheet or 1:100 for an A3 sheet
- In this example, both the existing and as proposed elevations are provided on the same sheet. This is an excellent way of clearly identifying the proposed scope of works for ease of comparison
- The yellow shaded area represents existing cladding and other components to be removed
- Use of sun shading in elevations can assist with understanding depth of field and steps in the building façade/ roof
- Ensure that elevations are titled by their orientation which helps to convey the location against the plan
- Dimensions and sufficient annotation are important for relevant parts of the building where remediation works are being proposed
- Provide clear cross-referencing to large scale details and sections

# Drawing Example

# Roof Plan – Proposed Works

# Sheet 8

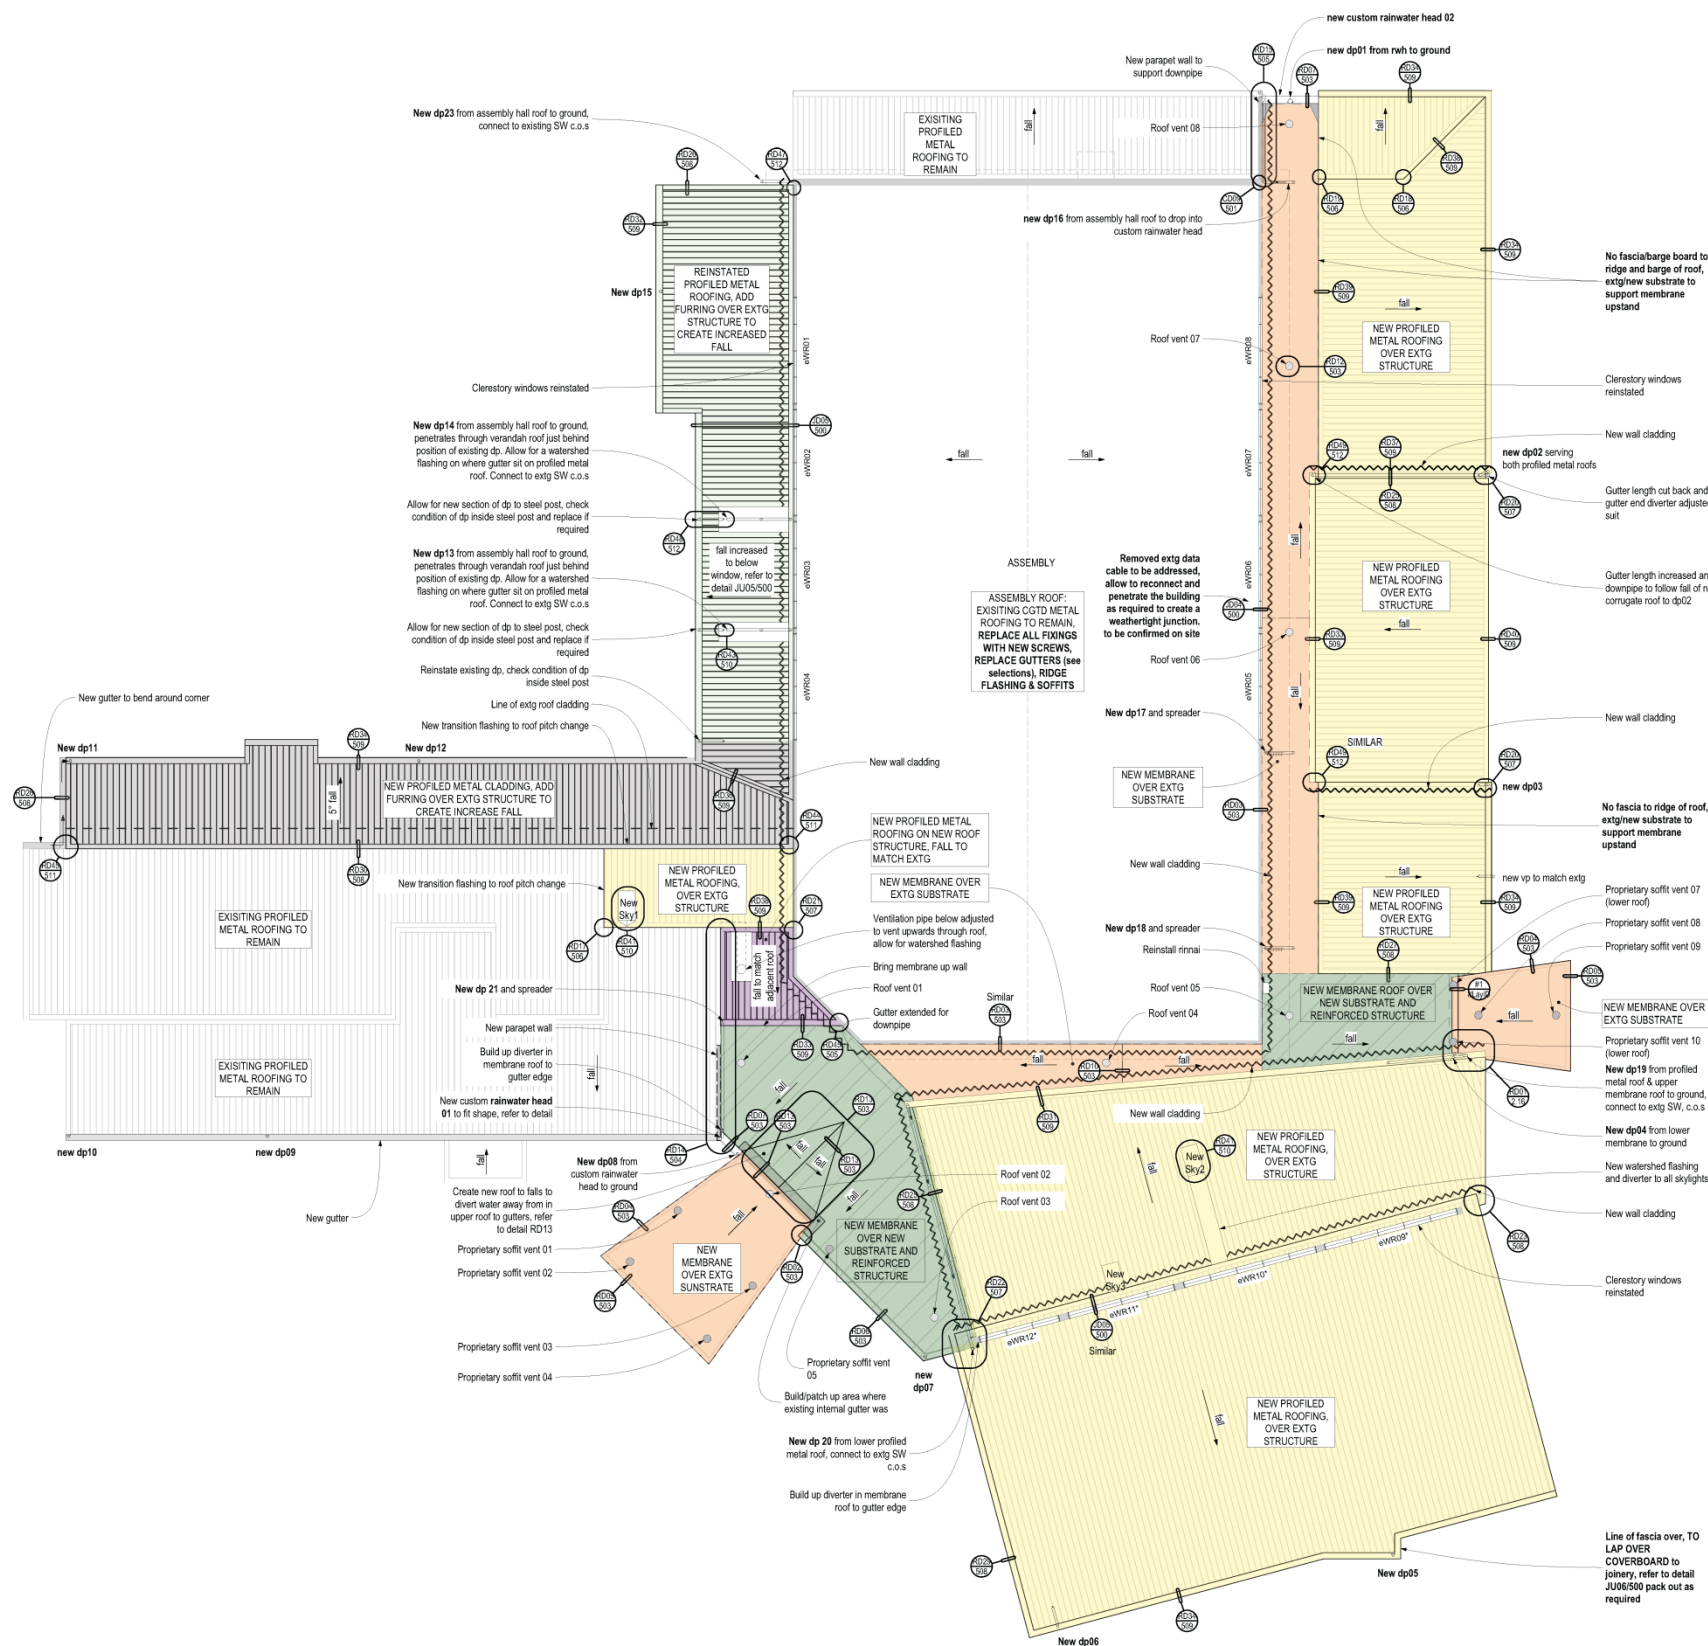

**4311M Metalcraft Profiled Roofing**

- New parapet wall
- Existing corrugated metal roof on existing roof structure

**New Profiled Metal Roofing**

- 0.55 BMT Coloursteel Endura profile to match existing
- Roof cladding on roof underlay, & and safety mesh where required
- Allow for new 0.55 BMT Coloursteel flashings, refer to DWG210 for welded flashing notes
- Allow for new gutters, refer to gutter notes below
- Coloursteel Endura, colour to be confirmed

Installation to comply with current NZ metal roofing and cladding Code of Practice. Allow for expansion joints where length exceeds 12m as per NZ metal roofing and cladding Code of Practice

- New profiled metal roofing to match existing (not corrugate), on existing roof structure.
- New profiled metal roofing to match existing, build up firing on existing roof structure to increase fall, refer to plan for pitch of fall. New roof structure for valley as required
- Reinstated profiled metal roofing, build up firing on existing roof structure to increase fall so there is 110mm spon flashing to reinstated windows, refer to plan for pitch of fall and details
- New profiled metal roofing on new roof structure - fall and structure to match adjacent roof to NZ3604.

**Roof Fixing:** Roof Fixings appropriate for the design loads of site. Allow for specific loadings @ corners & the periphery of the roof where localised pressure factors apply

**Roof Underlay:** REFER TO DWG 210 PROPOSED ELEVATION Notes, 4161 Wraps, Underlays and DPC

Ensure roofing material are cleaned of all metal filings, loose fitting and other contaminants immediately following installation. Swath markings will not be accepted.

**ASSEMBLY ROOF:** Existing corrugated metal roofing to remain, replace all existing fixings with new screws, replace gutter and ridge flashing

**4422VE Viking Enviroclad Membrane (Install strictly in accordance with manufacturers specifications)**

- New membrane on existing roof structure and substrate. Check condition of existing substrate and make good as required
- New membrane and substrate on reinforced existing roof structure. Allow for new intermediate structural elements @ max 400 centres to reinforce existing roof structure (as the roof is currently too sprung and requires additional support)

**Extent of new membrane roof and NEW roof structure:** min 2" fall c.o.s

**Membrane System:** Viking Enviroclad TPO Membrane

**Substrate:** 19mm H3.2 CCA treated CD plywood fix w/s screws, but jointed allow 3mm gap between sheets with tape over

Check condition of existing timber framing

New H3.2 timber framing, allow for airflow between framing for roof ventilation

**Firing:**

- Roof vent 01 Viking Alum Cavity Vent IMV112 Grey
- Soffit vent 01 Manthorpe Circular Soffit Vents - G700 White

**4231HW James Hardie Weatherboard Cladding**

- New fibre cement weatherboard wall cladding, refer to DWG 210 PROPOSED ELEVATIONS

**4550VS Velux Opening and Fixed Skylights**

- New sky 01 New VCM (Manual opening) or FCM (fixed skylight) Velux skylight to replace existing skylights. Sizes tbc on site. Make allowance for manual opening skylight and internal blindscreens. Client to confirm if skylights are only required to be fixed and if internal blindscreens are required

Skylight to fit between existing rafters complete with proprietary flashing kit installed to manufacturers details and specifications, and to comply with NZBC E2/AS1, refer to appendix of spec, for manufacturers installation instructions and to NZBC E2/AS1 figure 55. Note: over flashing shall be continuous and to the ridge. Also provide additional framing to edge of roofing penetration as per NZBC E2/AS1 fig. 21

New 0.55 BMT Coloursteel flashings where required, colour to be selected

NOTE: all roof penetrations/flashings are to be within the scope of work of the roofing contractor

**7411M Metalcraft Roofing Rainwater Spouting System**

- Allow for expansion joints where lengths exceeds 12m, as per NZ metal roofing and cladding Code of Practice

Where downpipe is discharging onto roof below always allow for spreader in accordance with E2/AS1 Fig. 20

Allow to install wire mesh domes to top of all downpipes, and leaf guard mesh to all spoutings and rainwater heads.

Spouting type: Metalcraft 175 Box Gutter

Downpipes: coloursteel, refer to DWG 121 notes for downpipe sizes, colour tbc

Downpipe spreaders: coloursteel or uPVC

Rainwater head: Custom coloursteel prefabricated rainwater head, refer to detail

**Key**

- exist dp existing downpipe
- New dp 01 New downpipe

**Notes:**

- The example images on this sheet are provided for the sole purpose of conveying the levels of presentation and standard of documentation required by the Ministry for Weathertightness Remediation projects

**Commentary:**

- Ensure floor plans or part-floor plans are provided at 1:50 scale for an A1 sheet or 1:100 for an A3 sheet
- Provide clear cross-referencing to large scale details and sections
- In this example all drainage outlets, direction of roof falls and roof pitches are shown together with cross-references for large scale details
- Colour shading has been used to signify the differing roof types as well as differentiating between existing and proposed



# Drawing Example

# Sections – Proposed Works


# Sheet 9

**Notes:**

- The example images on this sheet are provided for the sole purpose of conveying the levels of presentation and standard of documentation required by the Ministry for Weathertightness Remediation projects

**Commentary:**


- Ensure section or part-sections are provided at no smaller than 1:50 scale for an A1 sheet or 1:100 for an A3 sheet
- Provide clear cross-referencing to large scale details
- Colour or shading is very useful for differentiating between the existing based building and elements to be demolished or to identify new construction.
- In this example, both existing and proposed elements are annotated. The red hatching in this drawing shows the new roof cladding system

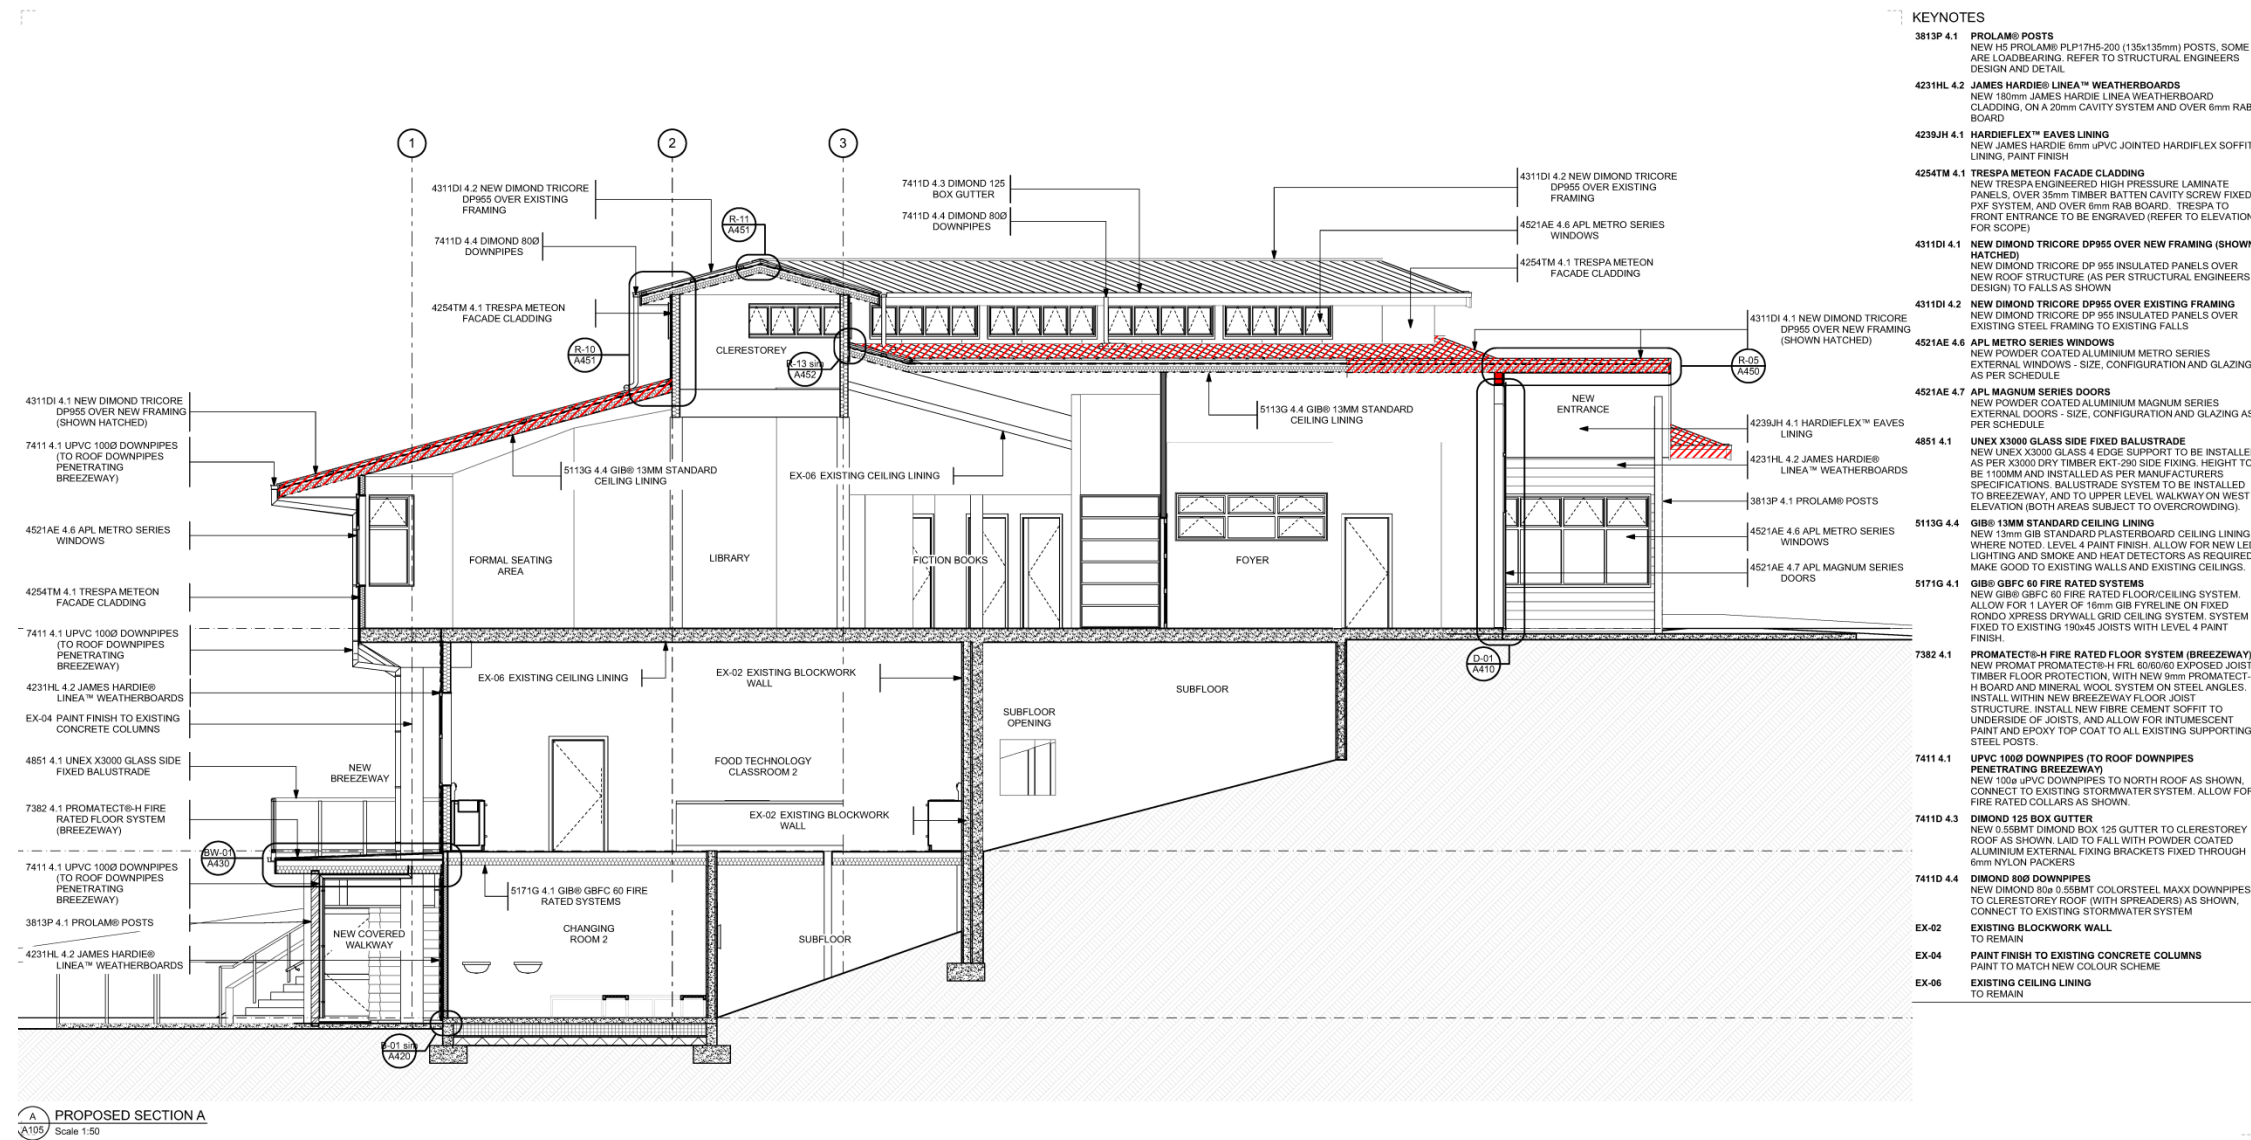

# Drawing Example

# Details

# Sheet 10

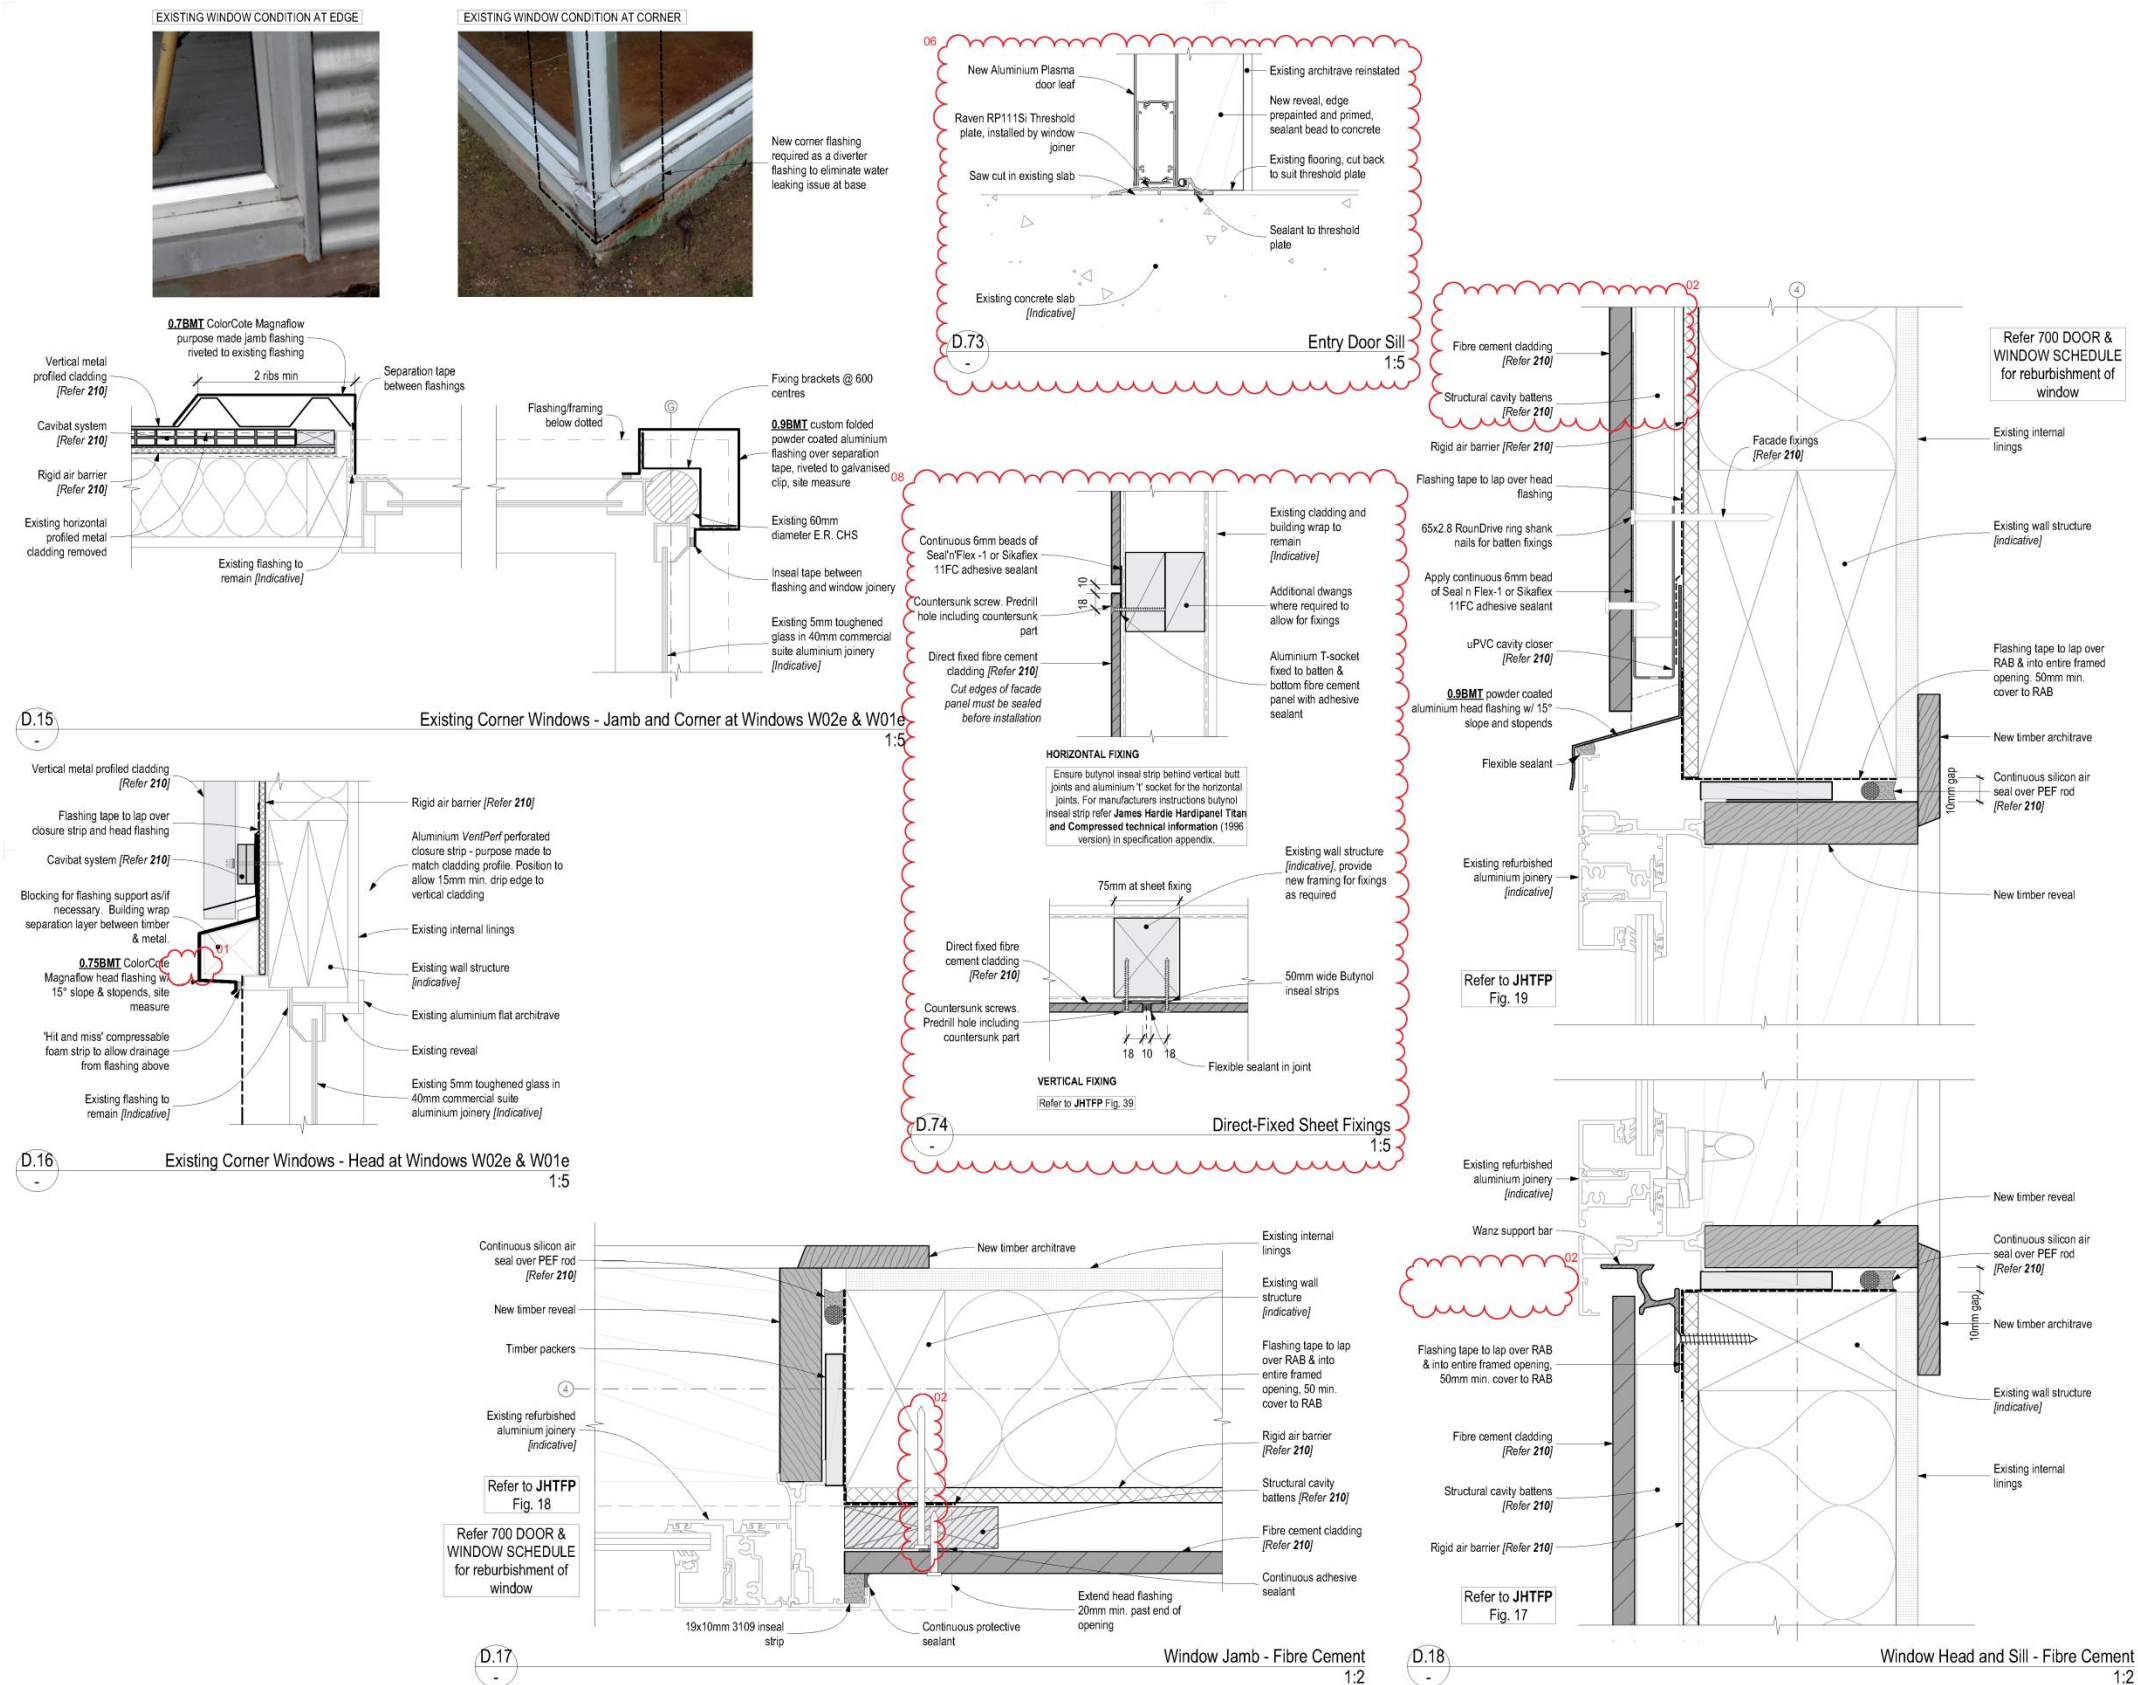

**Notes:**

- The example images on this sheet are provided for the sole purpose of conveying the levels of presentation and standard of documentation required by the Ministry for Weathertightness Remediation projects


**Commentary:**

- Details should be at large scale such as 1:2 or 1:5 so that these are clear for document reviewers such as the WRP and Council, and for the Contractor on site
- All window and door joinery details should be drawn at 1:2 @ A1 scale (1:4 or 1:5 @ A3) and clearly showing, notating and dimensioning all flashings, airseals, tapes, packers etc.
- Where various layers of underlays and tapes are used, it is important to provide separation between the linework so each layer can be clearly differentiated
- This example has inset photo images of the existing as-built condition to assist with communication
- Any drawing changes should be clearly indicated using revision clouds – in this example red clouds have been used
- In this example, existing building elements have been shown in a light grey colour, whilst new elements are shown in black to clearly differentiate


# Drawing Example

# 3D Details



# Sheet 11

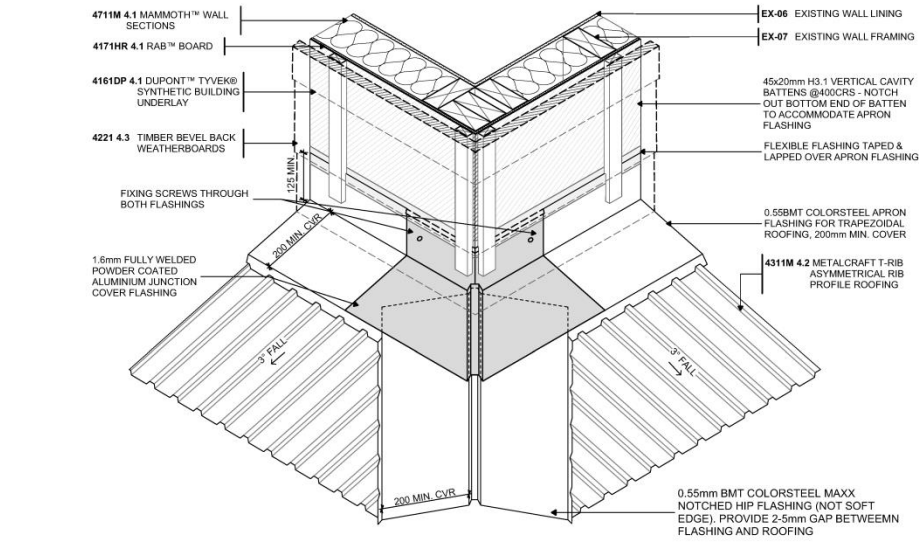

3D5 HIP/APRON FLASHING JUNCTION AT EXTERNAL CORNER  
A121 / Scale N.T.S.

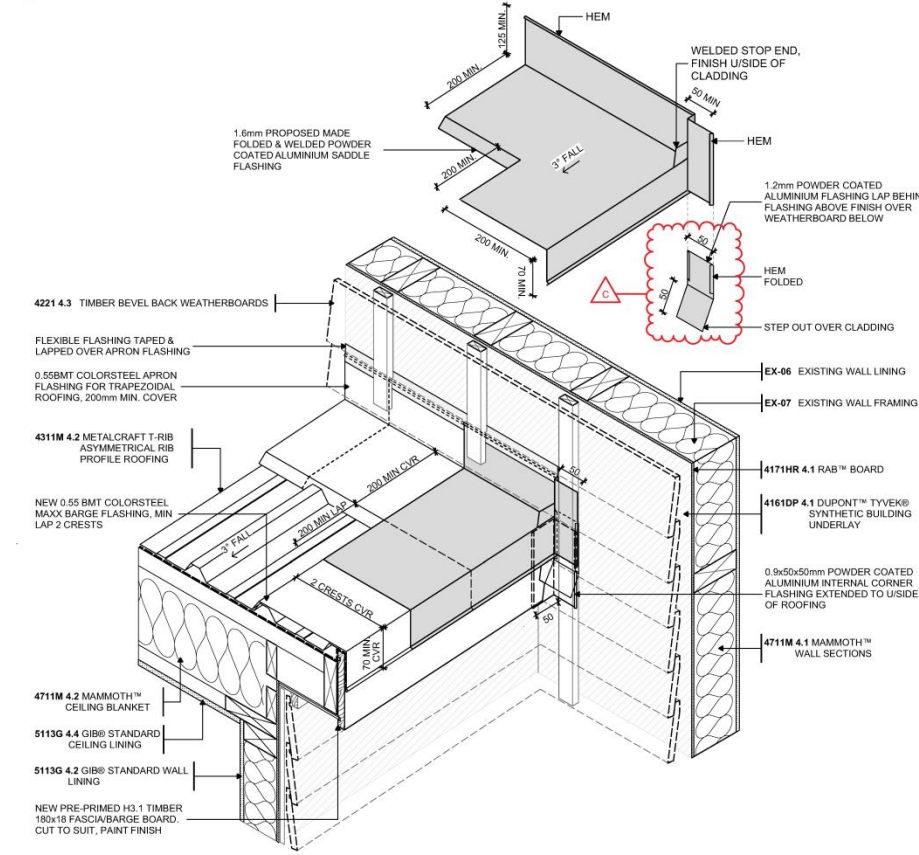

3D6 BARGE WEATHERBOARD DETAIL  
A103 / Scale N.T.S.

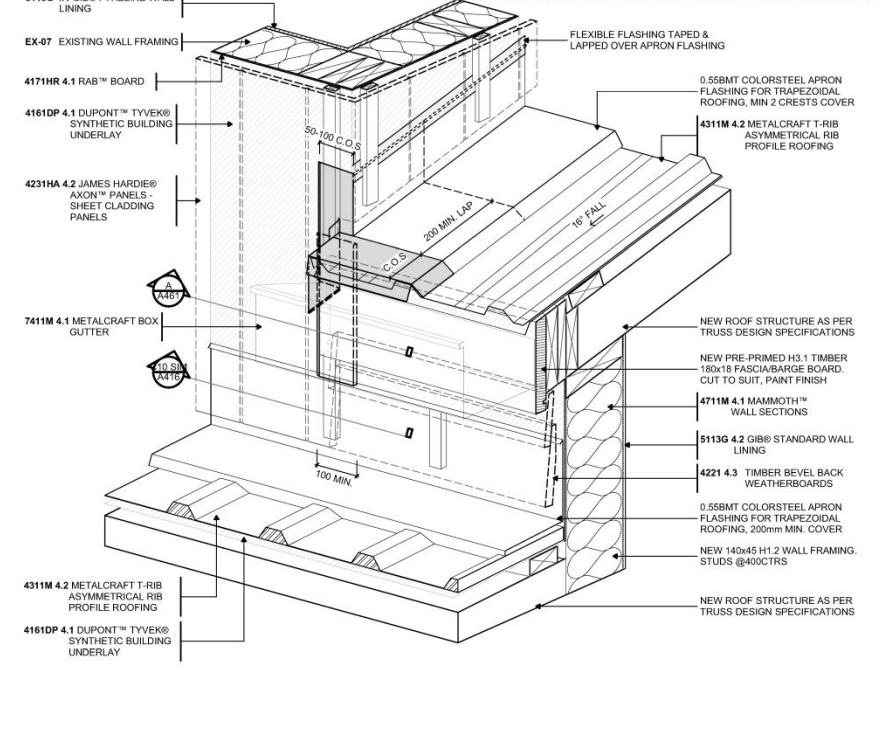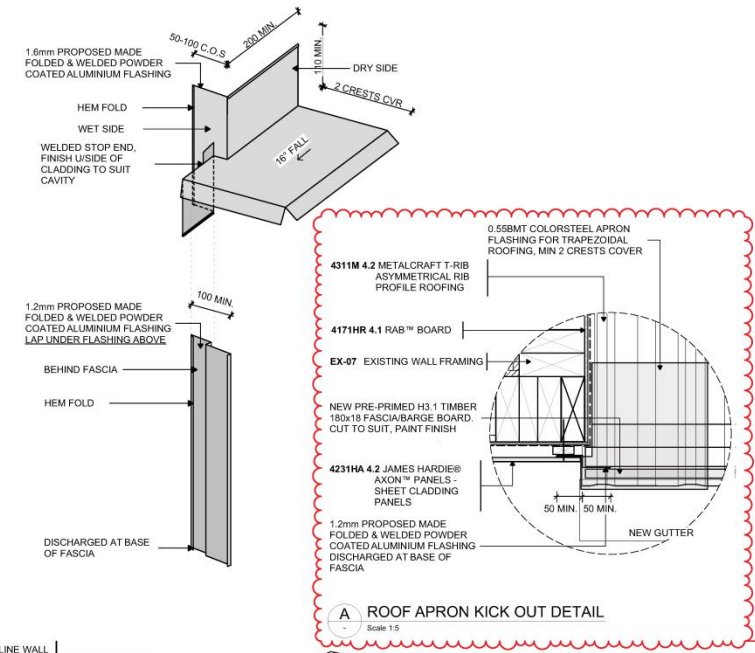

3D7 ROOF APRON KICK OUT DETAIL  
A121 / Scale N.T.S.

**KEYNOTES**







4161DP 4.1	DUPONT™ TYVEK® SYNTHETIC BUILDING UNDERLAY NEW TYVEK BUILDING WRAP - ALL LAPS TAPED AND SEALED
4171HR 4.1	RAB™ BOARD NEW JAMES HARDIE® 6mm RIGID AIR BARRIER WITH BUILDING WRAP OVER
4221 4.3	TIMBER BEVEL BACK WEATHERBOARDS NEW H3.2 TREATED RADATA PINE BEVEL BACK TIMBER WEATHERBOARDS, PAINT FINISH OVER 45x20mm H3.1 VERTICAL CAVITY SYSTEM AT 600 CRS. WEATHERBOARD SIZE AND PROFILE TO MATCH EXISTING
4231HA 4.2	JAMES HARDIE® AXON™ PANELS - SHEET CLADDING PANELS NEW 9mm JAMES HARDIE® AXON PANEL CLADDING, PAINT FINISH OVER 45x20mm H3.1 VERTICAL CAVITY SYSTEM AT 300 CRS
4311M 4.2	METALCRAFT T-RIB ASYMMETRICAL RIB PROFILE ROOFING NEW 0.55BMT COLORSTEEL MAXX T-RIB PROFILED METAL ROOFING OVER NEW H1.2 TREATED TIMBER ROOF FRAMING TO NEW FALLS (AS SHOWN). ALLOW FOR NEW R4.0 MAMMOTH CEILING BLANKET. INSTALL NEW 0.55BMT COLORSTEEL MAXX 125 BOX GUTTERS
4711M 4.1	MAMMOTH™ WALL SECTIONS R2.5 MAMMOTH WALL SECTIONS (80mm WALL FRAMING) / R2.8 MAMMOTH WALL SECTIONS (140mm WALL FRAMING)
4711M 4.2	MAMMOTH™ CEILING BLANKET R4.0 MAMMOTH CEILING SECTIONS (240mm THICKNESS)
5113G 4.1	GIB® FYRELINE WALL LINING NEW 13mm GIB® FYRELINE TO SPECIFIED FIRE RATED SYSTEMS
5113G 4.2	GIB® STANDARD WALL LINING NEW 13mm GIB® STANDARD WALL LINING WHERE NOTED, LEVEL 4 PAINT FINISH. REPLACE WALL FRAMING TO DAMAGED AREAS
5113G 4.4	GIB® STANDARD CEILING LINING NEW 13mm GIB® STANDARD CEILING LINING WHERE NOTED, LEVEL 4 PAINT FINISH. WITH GIB RONDO SUSPENDED METAL CEILING GRID SYSTEM IF REQUIRED
7411M 4.1	METALCRAFT BOX GUTTER NEW 0.55BMT COLORSTEEL MAXX 125 BOX GUTTERS WITH GALVANISED 32x3mm INTERNAL FIXING BRACKETS @450CRS, FIX BRACKETS THROUGH 6mm NYLON SHIMA TO FORM CONTINUOUS OVERFLOW GAP
EX-06	EXISTING WALL LINING EXISTING WALL LINING TO REMAIN
EX-07	EXISTING WALL FRAMING EXISTING WALL FRAMING TO REMAIN, NEW STUDS AS REQUIRED TO PROVIDE SUPPORT FOR BATTENS

- Notes:**
- The example images on this sheet are provided for the sole purpose of conveying the levels of presentation and standard of documentation required by the Ministry for Weathertightness Remediation projects
- Commentary:**
- Details should be at sufficient scale so that these are clear for document reviewers such as the WRP and Council, and for the Contractor on site
  - This example provides exploded 3D views of all complex junctions to help reviewer and contractors understand the proposed assembly
  - In this example, the custom welded flashings are shown in context (to demonstrate how they interface with surrounding building elements), and also shown separately so the custom flashing can be clearly described and dimensioned
  - Most commonly used architectural software programmes have the ability to model details three dimensionally in this manner, however it is also acceptable to provide quality hand sketched 3D details
  - 3D details should be project specific – scanning in details from documents such as E2/AS1 or the Roofing Code of Practice is generally not acceptable because they do not show the specific situation. The exception to this is for typical details such as pipe penetrations or expansion laps

# Drawing Example

# Details

# Sheet 12

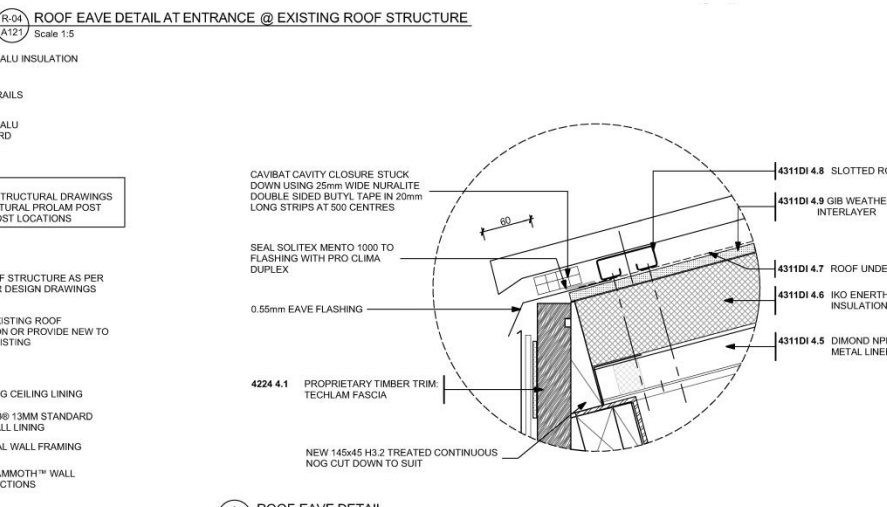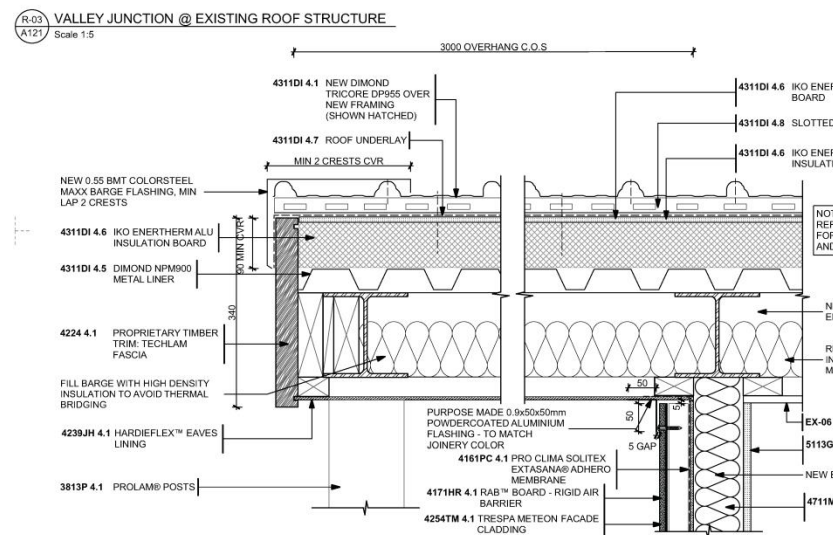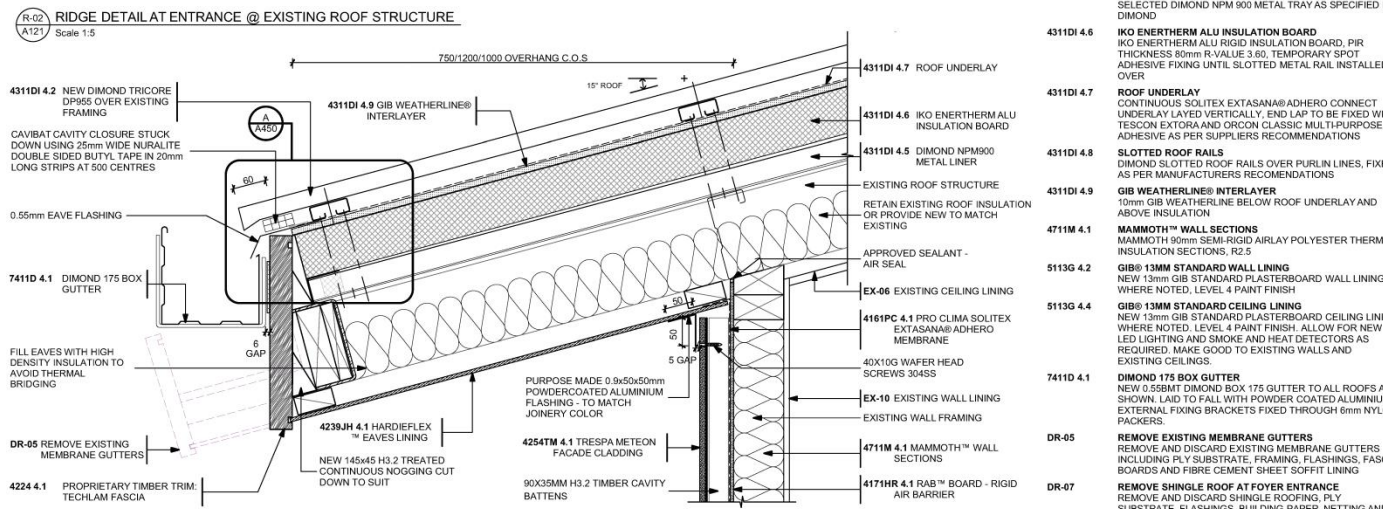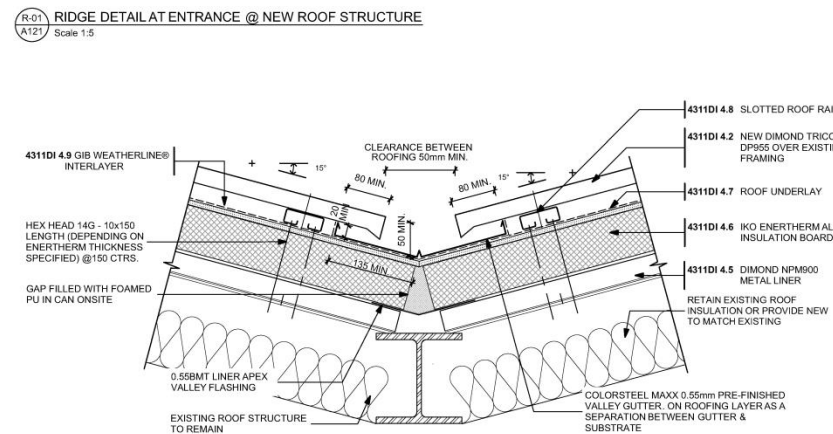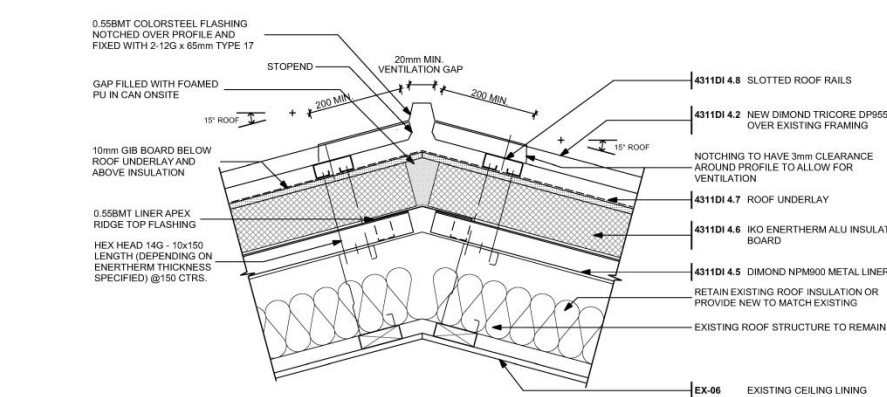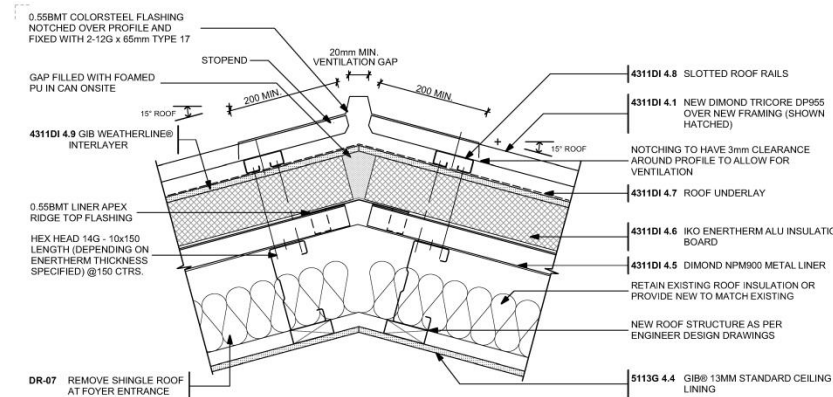

**KEYNOTES**

- 3813P 4.1 **PROLAM® POSTS**  
NEW H5 PROLAM® PL 017H5-200 (135x135mm) POSTS. SOME ARE LOADBEARING. REFER TO STRUCTURAL ENGINEERS DESIGN AND DETAIL.
- 4161PC 4.1 **PRO CLIMA SOLITEX EXTASANA® ADHERO MEMBRANE**  
NEW PRO CLIMA SOLITEX EXTASANA® ADHERO PEEL AND STICK WALL PROTECTION MEMBRANE - ALL LAPS TAPED AND SEALED.
- 4171HR 4.1 **RAB™ BOARD - RIGID AIR BARRIER**  
NEW JAMES HARDIE 6mm RIGID AIR BARRIER WITH BUILDING WRAP OVER.
- 4224 4.1 **PROPRIETARY TIMBER TRIM: TECHLAM FASCIA**  
NEW H3.2 TECHLAM LAMINATED FASCIA/BARGE BOARDS 34x40mm.
- 4239JH 4.1 **HARDIFLEX™ EAVES LINING**  
NEW JAMES HARDIE 6mm uPVC JOINTED HARDIFLEX SOFFIT LINING. PAINT FINISH.
- 4254TM 4.1 **TRESPA METEON FACADE CLADDING**  
NEW TRESPA ENGINEERED HIGH PRESSURE LAMINATE PANELS. OVER 35mm TIMBER BATTEN CAVITY SCREW FIXED PAF SYSTEM. AND OVER 6mm RAB BOARD. TRESPA TO FRONT ENTRANCE TO BE ENGRAVED (REFER TO ELEVATION FOR SCOPE).
- 4311DI 4.1 **NEW DIMOND TRICORE DP955 OVER NEW FRAMING (SHOWN HATCHED)**  
NEW DIMOND TRICORE DP 955 INSULATED PANELS OVER NEW ROOF STRUCTURE (AS PER STRUCTURAL ENGINEERS DESIGN) TO FALLS AS SHOWN.
- 4311DI 4.2 **NEW DIMOND TRICORE DP955 OVER EXISTING FRAMING**  
NEW DIMOND TRICORE DP 955 INSULATED PANELS OVER EXISTING STEEL FRAMING TO EXISTING FALLS.
- 4311DI 4.5 **DIMOND NPM900 METAL LINER**  
SELECTED DIMOND NPM 900 METAL TRAY AS SPECIFIED BY DIMOND.
- 4311DI 4.6 **IKO ENERTHERMALU INSULATION BOARD**  
IKO ENERTHERMALU RIGID INSULATION BOARD, PIR THICKNESS 80mm R-VALUE 3.60. TEMPORARY SPOT ADHESIVE FIXING UNTIL SLOTTED METAL RAIL INSTALLED OVER.
- 4311DI 4.7 **ROOF UNDERLAY**  
CONTINUOUS SOLITEX EXTASANA® ADHERO CONNECT UNDERLAY LAYED VERTICALLY. END LAP TO BE FIXED WITH TESCOTON EXTORA AND ORCON CLASSIC MULTIPURPOSE ADHESIVE AS PER SUPPLIERS RECOMMENDATIONS.
- 4311DI 4.8 **SLOTTED ROOF RAILS**  
DIMOND SLOTTED ROOF RAILS OVER PURLIN LINES. FIXED AS PER MANUFACTURERS RECOMMENDATIONS.
- 4311DI 4.9 **GIB WEATHERLINE® INTERLAYER**  
10mm GIB WEATHERLINE BELOW ROOF UNDERLAY AND ABOVE INSULATION.
- 4711M 4.1 **MAMMOTH™ WALL SECTIONS**  
MAMMOTH 90mm SEMI-RIGID AIRLAY POLYESTER THERMAL INSULATION SECTIONS. R2.5.
- 5113G 4.2 **GIB® 13MM STANDARD WALL LINING**  
NEW 13mm GIB STANDARD PLASTERBOARD WALL LINING WHERE NOTED. LEVEL 4 PAINT FINISH.
- 5113G 4.4 **GIB® 13MM STANDARD CEILING LINING**  
NEW 13mm GIB STANDARD PLASTERBOARD CEILING LINING WHERE NOTED. LEVEL 4 PAINT FINISH. ALLOW FOR NEW LED LIGHTING AND SMOKE AND HEAT DETECTORS AS REQUIRED. MAKE GOOD TO EXISTING WALLS AND EXISTING CEILINGS.
- 7411D 4.1 **DIMOND 175 BOX GUTTER**  
NEW 0.55BMT DIMOND BOX 175 GUTTER TO ALL ROOFS AS SHOWN. LAD TO FALL WITH POWDER COATED ALUMINIUM EXTERNAL FIXING BRACKETS FIXED THROUGH 6mm NYLON PACKERS.
- DR-05 **REMOVE EXISTING MEMBRANE GUTTERS**  
REMOVE AND DISCARD EXISTING MEMBRANE GUTTERS INCLUDING PLY SUBSTRATE, FRAMING, FLASHINGS, FASCIA BOARDS AND FIBRE CEMENT SHEET SOFFIT LINING.
- DR-07 **REMOVE SHINGLE ROOF AT FOYER ENTRANCE**  
REMOVE AND DISCARD SHINGLE ROOFING, PLY SUBSTRATE, FLASHINGS, BUILDING PAPER, NETTING AND EXISTING ROOF FRAMING DOWN TO WALL TOP PLATE LEVEL. INCLUDING CEILING LININGS.
- EX-06 **EXISTING CEILING LINING**  
TO REMAIN.
- EX-10 **EXISTING WALL LINING**  
TO REMAIN.

**Notes:**

- The example images on this sheet are provided for the sole purpose of conveying the levels of presentation and standard of documentation required by the Ministry for Weathertightness Remediation projects

**Commentary:**

- Details should be at large scale such as 1:2 or 1:5 so that these are clear for document reviewers such as the WRP and Council, and for the Contractor on site
- In this example, a particularly complex area around the eave flashing has been blown up to a larger scale to adequately convey the detail